




DRAWING NUMBER: MD-216-49PQ-EG-CV-GAD-1632 REV D01

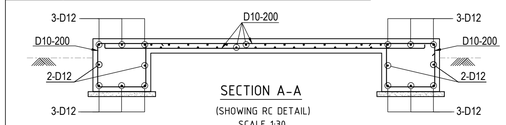


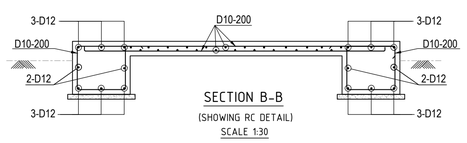


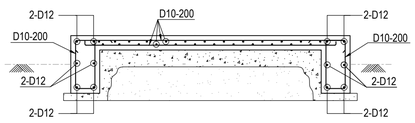


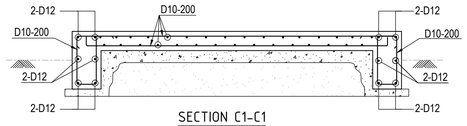


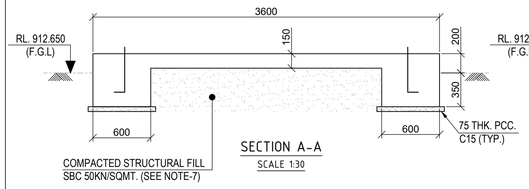


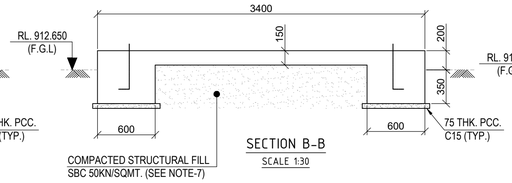


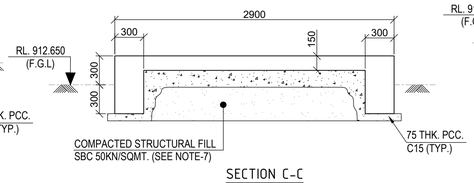


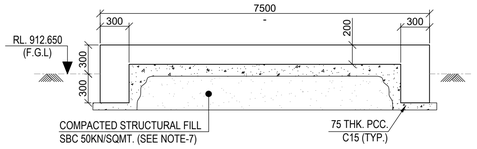


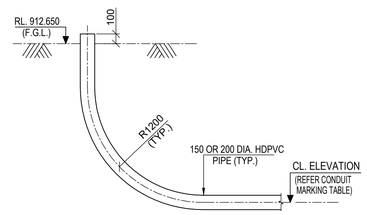


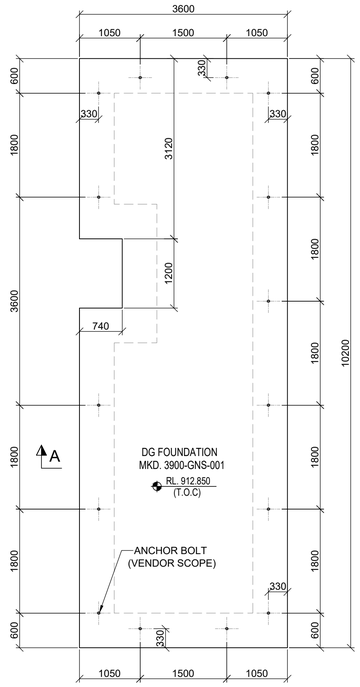


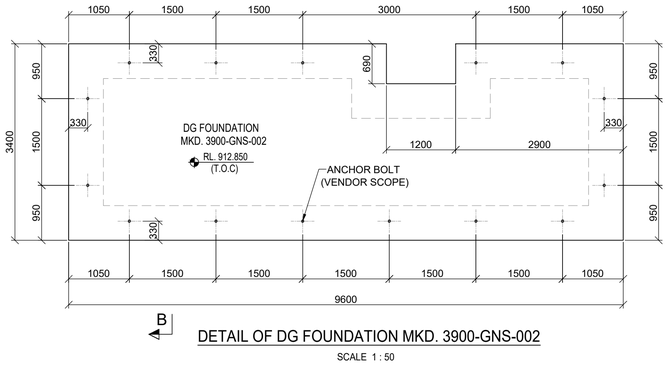


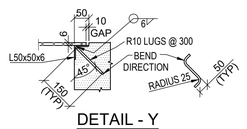


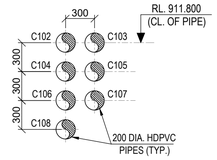


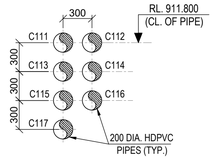


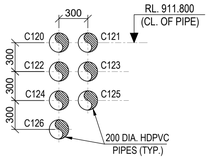


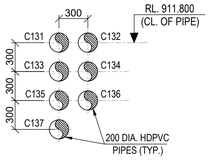


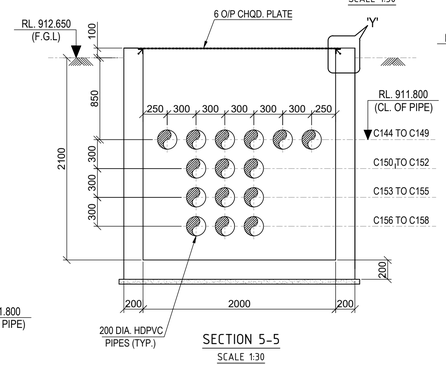


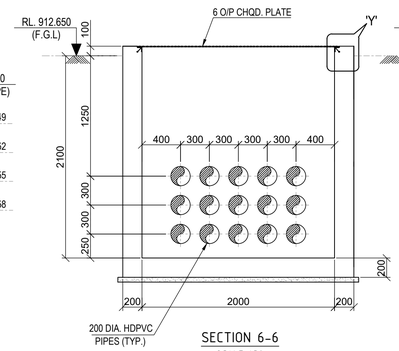


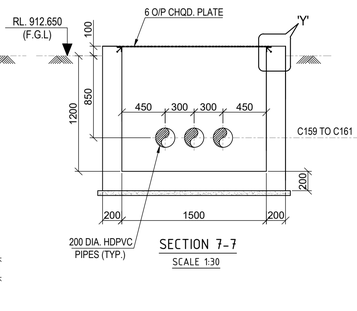


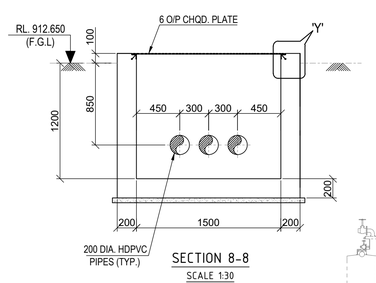


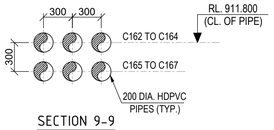


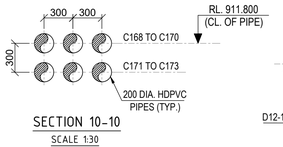

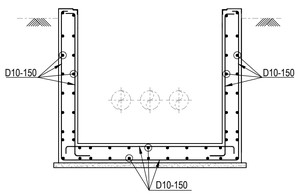

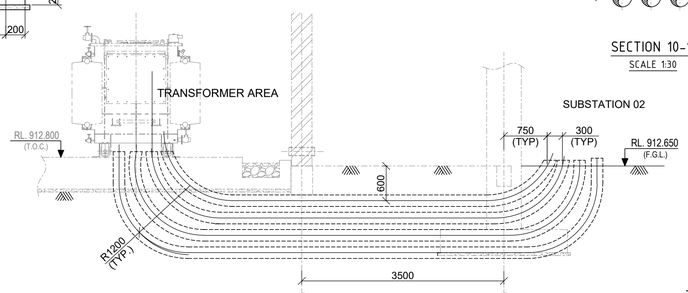

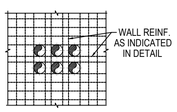

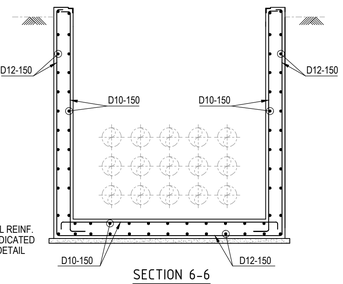

LEGENDS :-

R.L. - REDUCED LEVEL
CL. - CENTRE LINE
T.O.C. - TOP OF CONCRETE
TYP. - TYPICAL
T.O.G. - TOP OF GROUT
B.O.F. - BOTTOM OF FOUNDATION
F.G.L. - FINISHED GROUND LEVEL.
F.F.L. - FINISHED FLOOR LEVEL.
P.C.C - PLAIN CEMENT CONCRETE
DET. - DETAIL
FDN. - FOUNDATION
THK. - THICK
R.C.C. - REINFORCED CEMENT CONCRETE
MKD. - MARKED
CHQD. - CHEQUERED
DIA. - DIAMETER

NOTES:-

1. ALL DIMENSIONS ARE IN MILLIMETRES AND LEVELS AND CO-ORDINATES ARE IN METRES UNLESS OTHERWISE STATED.
2. NET SAFE BEARING CAPACITY OF SOIL AT BOTTOM OF FOUNDATION IS CONSIDERED AS 50 KN/ SQM.
3. GRADE OF CONCRETE SHALL BE C35 (35Mpa) FOR FOUNDATION, C30 (30Mpa) FOR GRADE SLAB & C15 (15Mpa) FOR BLINDING CONCRETE.
4. GRADE OF REINFORCEMENT SHALL BE DEFORMED BAR 420 MPa (GRADE 60) - ASTM A615/A615M.
5. CLEAR COVER TO REINFORCEMENT SHALL BE SLAB = 25 MM.
6. FOR STANDARD REINFORCEMENT DETAIL & GENERAL NOTES FOR CIVIL WORKS REFER DRAWING NO. MD-216-1000-EG-CV-DED-1005 & 1001.
7. STRUCTURAL FILL SHALL CONFORM TO PROVISIONS OF DOCUMENT MD-216-1000-EG-CV-MST-1698.
8. THIS DRAWING SHALL READ IN CONJUNCTION WITH DRAWING NO. MD-216-49PQ-EG-CV-GAD-1631.
9. FOR THE DETAILS OF EDGE THICKENING, RE-ENTRANT REABR, REFER DRAWING NO. MD-101-SMEM-EG-ST-DST-0002 & 0004.

DOCUMENT NUMBER	REFERENCE DOCUMENTS	REV	DATE	REVISION DESCRIPTION	DRN	CHK	ENG	APP	EMP
MD-216-49PQ-EG-HV-LAD-V552-1003	HVAC EQUIPMENTS & DUCTS								
	PREFABRICATED SUBSTATION # 2 SHHET-1								
MD-216-49PQ-EG-CV-GAD-1631	PROCESS PLANT SUBSTATION 02 AND TRANSFORMER AREA	D01	14/03/2023	AS-BUILT	SYA	SJM	AVG	AG	
	LAYOUT & DETAIL OF GRADE SLAB & ELECTRICAL CONDUITS	C02	21/06/2021	ISSUED FOR CONSTRUCTION & REVISED AS MARKED C02	SYA	SJM	AVG	AG	
MD-216-49PQ-EG-EL-LAD-1014	CABLE ROUTE LAYOUT - SUBSTATION-2	C01	06/05/2021	ISSUED FOR CONSTRUCTION	AMJ	SJM	AVG	AG	
MD-216-49PQ-EG-CV-GAD-1613	PROCESS PLANT SUBSTATION 02 : DETAIL OF TRANSFORMER AREA	A02	08/04/2021	REVISED AS PER EMPLOYER COMMENTS	AMJ	SJM	AVG	AG	
MD-216-49PQ-EG-CV-GAD-1611	PROCESS PLANT SUBSTATION 02 : LAYOUT OF FOUNDATIONS			DATED 05/04/2021 & REVISED AS MKD. A02					
MD-216-1000-EG-ST-CRT-1001	CIVIL, STRUCTURAL & ARCHITECTURAL - DESIGN CRITERIA	A01	06/03/2021	ISSUED FOR REVIEW	AMJ	SJM	AVG	AG	

RESERVED FOR VENDOR LOGO AND DRAWING NUMBER

LARSEN & TOUBRO
This drawing is the property of LARSEN & TOUBRO and must not be passed on to any person or body not authorized by us to receive it nor be copied or otherwise made use either in full or in part by such person or body without our prior permission in writing.

Outotec
The content of these documents are the sole property of Outotec Oyj. Any rights not expressly granted herein are reserved. Reproduction, transfer or distribution of part or all of the contents in any form without prior written permission of Outotec is prohibited.

MA'ADEN معادن
Saudi Arabian Mining Company شركة معادن العربية السعودية
This document and the information contained herein is Ma'aden proprietary know-how. This document or any part thereof should not be reproduced, stored in a retrieval system or transmitted by any means, electronic or otherwise, or divulged without prior written permission of Ma'aden.

LARSEN & TOUBRO DRAWING NUMBER	019045_950_C_G_24611_002		REVISION 4
OUTOTEC DRAWING NUMBER	900707__GAU01__WD01__MTL01__45095	DOCUMENT ID	REVISION
		OU100717977	4

DRAWN	AMJ	02/03/2021	MANSOURAH - MASSARAH GOLD PROJECT
CHECKED	SJM	03/03/2021	GENERAL ARRANGEMENT DRAWING
ENGINEER	AVG	02/03/2021	POWER DISTRIBUTION PROCESS PLANT SUBSTATION 02
APPROVED	AG	06/03/2021	LAYOUT & DETAIL OF GRADE SLAB & ELECTRICAL CONDUITS
EMPLOYER			
SCALE	1:50, 1:20	A1	DRAWING NUMBER: MD-216-49PQ-EG-CV-GAD-1632 REV: D01