
DRAWING NUMBER: MD-216-49PQ-EG-CV-GAD-1633 | REV: D01

CONDUIT MARKING TABLE	
CONDUIT TAG	CL. OF ELEVATION
C104	RL. 911.400
C105	RL. 910.750
C106	RL. 911.400
C107	RL. 911.100
C108	RL. 910.800
C109	RL. 910.500
C110	RL. 911.400
C111	RL. 911.100
C112	RL. 910.800
C113	RL. 911.400
C114	RL. 910.750
C115	RL. 911.400
C116	RL. 911.100
C117	RL. 910.800
C118	RL. 910.500
C119	RL. 911.400
C120	RL. 911.100
C121	RL. 910.800
C122	RL. 911.400
C123	RL. 910.750
C124	RL. 911.400
C125	RL. 911.100

CONDUIT MARKING TABLE	
CONDUIT TAG	CL. OF ELEVATION
C126	RL. 910.800
C127	RL. 910.500
C128	RL. 911.400
C129	RL. 911.100
C130	RL. 910.800
C131	RL. 911.400
C132	RL. 910.750
C133	RL. 911.400
C134	RL. 911.100
C135	RL. 910.800
C136	RL. 910.500
C137	RL. 911.400
C138	RL. 911.100
C139	RL. 910.800
C140	RL. 911.400
C141	RL. 911.400
C142	RL. 911.400
C143	RL. 911.100
C144	RL. 911.100
C145	RL. 911.400
C146	RL. 911.400
C147	RL. 911.400

CONDUIT MARKING TABLE	
CONDUIT TAG	CL. OF ELEVATION
C148	RL. 911.400
C149	RL. 911.100
C150	RL. 911.100
C151	RL. 911.100
C152	RL. 910.800
C153	RL. 910.800
C153A	RL. 910.800
C170	RL. 911.400
C171	RL.911.400
C172	RL. 911.400
C173	RL. 911.400
C174	RL. 911.400
C175	RL. 911.100
C176	RL. 911.100
C177	RL. 911.100
C178	RL. 911.100
C179	RL. 911.100
C180	RL. 911.400
C181	RL. 911.400
C182	RL. 911.400
C183	RL. 911.400
C184	RL. 911.400


CONDUIT MARKING TABLE	
CONDUIT TAG	CL. OF ELEVATION
C185	RL. 911.100
C186	RL. 911.100
C187	RL. 911.100
C188	RL. 911.100
C189	RL. 911.100
C190	RL. 911.400
C191	RL. 911.400
C192	RL. 911.400
C193	RL. 911.100
C194	RL. 911.100
C195	RL. 911.100

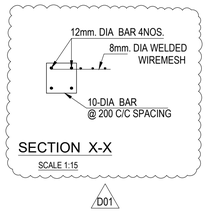

SECTION X-X

SCALE 1:15

D01

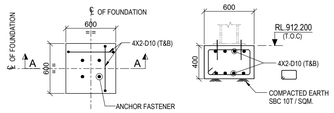


TYP. DETAIL OF FOUNDATION MKD. P1 FOR CABLE TRAY SUPPORT

(12 NOS. REQUIRED)

(SCALE - 1:25


SECTION Y-Y

(SCALE - 1:25)

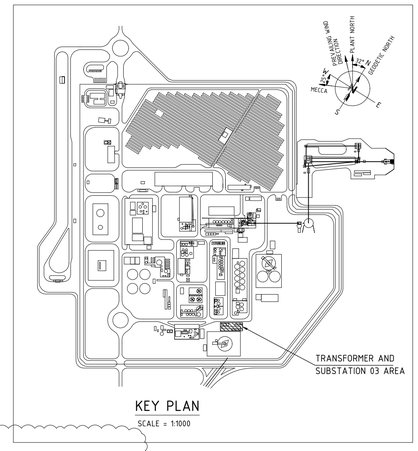

KEY PLAN

SCALE = 1:1000

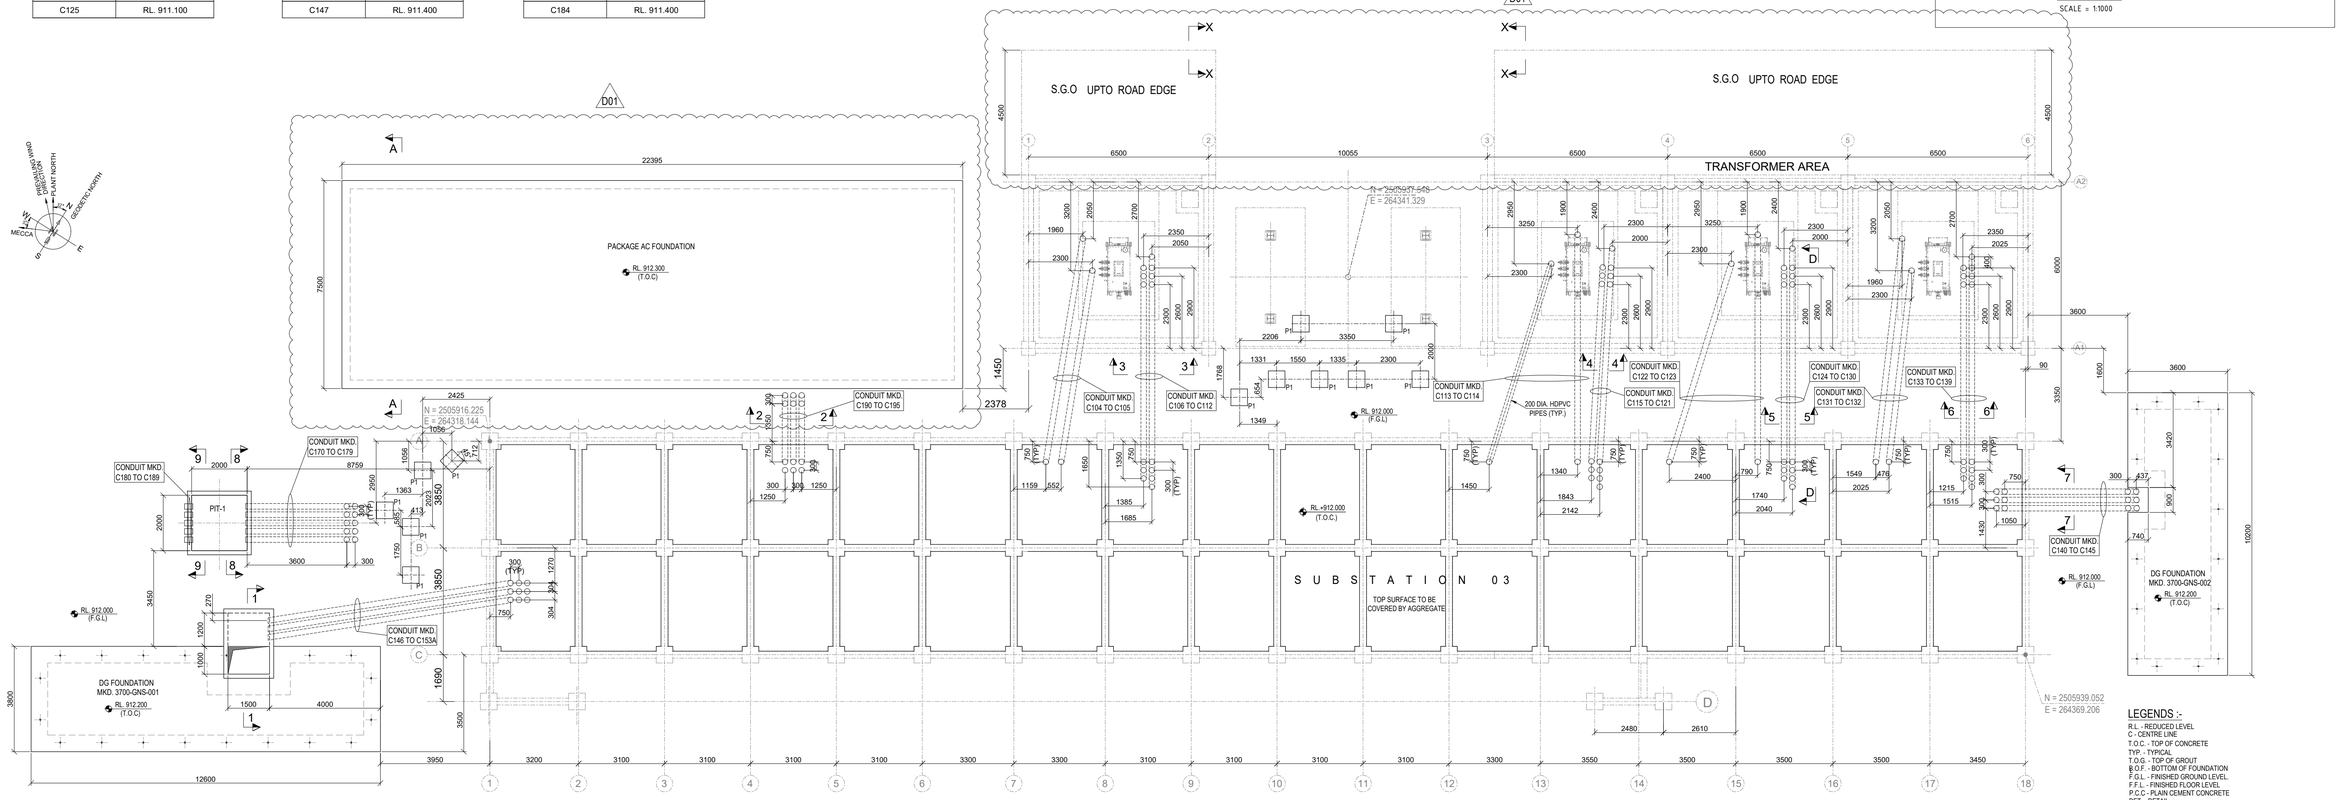

LAYOUT OF GRADE SLAB & ELECTRICAL CONDUITS

SCALE 1 : 75

LEGENDS :-

R.L - REDUCED LEVEL
℄ - CENTRE LINE
T.O.C - TOP OF CONCRETE
TYP - TYPICAL
T.O.G. - TOP OF GROUT
B.O.F. - BOTTOM OF FOUNDATION
F.G.L - FINISHED GROUND LEVEL
F.F.L - FINISHED FLOOR LEVEL
P.C.C - PLAIN CEMENT CONCRETE
DET. - DETAIL
FDN. - FOUNDATION
THK. - THICK
R.C.C - REINFORCED CEMENT CONCRETE
MKD. - MARKED

NOTES:-

1. ALL DIMENSIONS ARE IN MILLIMETRES AND LEVELS AND CO-ORDINATES ARE IN METRES UNLESS OTHERWISE STATED.
2. NET SAFE BEARING CAPACITY OF SOIL AT BOTTOM OF FOUNDATION IS CONSIDERED AS 50 KN/ SQM.
3. GRADE OF CONCRETE SHALL BE C35 (35Mpa) FOR FOUNDATION, C30 (30Mpa) FOR GRADE SLAB & C15 (15Mpa) FOR BLINDING CONCRETE.
4. GRADE OF REINFORCEMENT SHALL BE DEFORMED BAR 420 MPa (GRADE 60) - ASTM A615/A615M.
5. CLEAR COVER TO REINFORCEMENT SHALL BE SLAB = 25 MM.
6. FOR STANDARD REINFORCEMENT DETAIL & GENERAL NOTES FOR CIVIL WORKS REFER DRAWING NO. MD-216-1000-EG-CV-DED-1005 & 1001.
7. STRUCTURAL FILL SHALL CONFORM TO PROVISIONS OF DOCUMENT MD-216-1000-EG-CV-MST-1698.
8. THIS DRG SHALL BE READ IN CONJUNCTION WITH DRG NO. MD-216-49PQ-EG-CV-GAD-1634.
9. FOR DETAILS OF SLAB EDGE THICKENING AND RE-ENTRANT REBARS REFER MD-101-SMEM-EG-ST-DST-002 AND MD-101-SMEM-EG-ST-DST-007. FOR DETAILS OF SLAB JOINTS REFER MD-216-1000-EG-CV-DED-1002.

DOCUMENT NUMBER	REFERENCE DOCUMENTS	REV	DATE	REVISION DESCRIPTION	DRN	CHK	ENG	APP	EMP
MD-216-49PQ-EG-CV-GAD-1634	PROCESS PLANT SUBSTATION 03 AND TRANSFORMER AREA	D01	26/06/2023	AS-BUILT (D01)	SYA	SJM	AVG	AG	
	LAYOUT & DETAIL OF GRADE SLAB & ELECTRICAL CONDUITS	C02	11/08/2021	ISSUED FOR CONSTRUCTION & REVISED AS MARKED (C02)	SYA	SJM	AVG	AG	
MD-216-49PQ-EG-EL-LAD-1015	CABLE ROUTE LAYOUT - SUBSTATION-3	C01	06/05/2021	ISSUED FOR CONSTRUCTION	AMJ	SJM	AVG	AG	
MD-216-49PQ-EG-CV-GAD-1610	DETAIL OF TRANSFORMER AREA	A02	08/04/2021	REVISED AS PER EMPLOYER COMMENTS	AMJ	SJM	AVG	AG	
MD-216-49PQ-EG-CV-GAD-1607	LAYOUT OF FOUNDATIONS			DATED 29/03/2021 & REVISED AS MKD. (A02)					
MD-216-1000-EG-ST-CRT-1001	CIVIL, STRUCTURAL & ARCHITECTURAL - DESIGN CRITERIA	A01	03/03/2021	ISSUED FOR REVIEW	AMJ	SJM	AVG	AG	

RESERVED FOR VENDOR LOGO AND DRAWING NUMBER

LARSEN & TOUBRO

This drawing is the property of LARSEN & TOUBRO and must not be passed on to any person or body not authorized by us to receive it nor be copied or otherwise made use either in full or in part by such person or body without our prior permission in writing.

Outotec

The content of these documents are the sole property of Outotec Oy. Any rights not expressly granted herein are reserved. Reproduction, transfer or distribution of part or all of the contents in any form without prior written permission of Outotec is prohibited.

MA'ADEN معادن Saudi Arabian Mining Company

This document and the information contained herein is Ma'aden proprietary know-how. This document or any part thereof should not be reproduced, stored in a retrieval system or transmitted by any means, electronic or otherwise, or divulged without prior written permission of Ma'aden.

LARSEN & TOUBRO DRAWING NUMBER			REVISION
019045_950_C_G_24612_001			4
OUTOTEC DRAWING NUMBER		DOCUMENT ID	REVISION
900707__GAU01__WD01_MTL01__45096		OU100717978	4
DRAWN	AMJ	25/02/2021	MANSOURAH - MASSARAH GOLD PROJECT
CHECKED	SJM	26/02/2021	GENERAL ARRANGEMENT DRAWING
ENGINEER	AVG	25/02/2021	POWER DISTRIBUTION PROCESS PLANT SUBSTATION 03
APPROVED	AG	03/03/2021	LAYOUT & DETAIL OF GRADE SLAB & ELECTRICAL CONDUITS
EMPLOYER			
SCALE 1:20, 1:30, 1:50, 1:75	A0	DRAWING NUMBER: MD - 216 - 49PQ - EG - CV - GAD - 1633	REV: D01