


DRAWING NUMBER: MD-216-49PQ-EG-CV-GAD-1635 | REV: D01

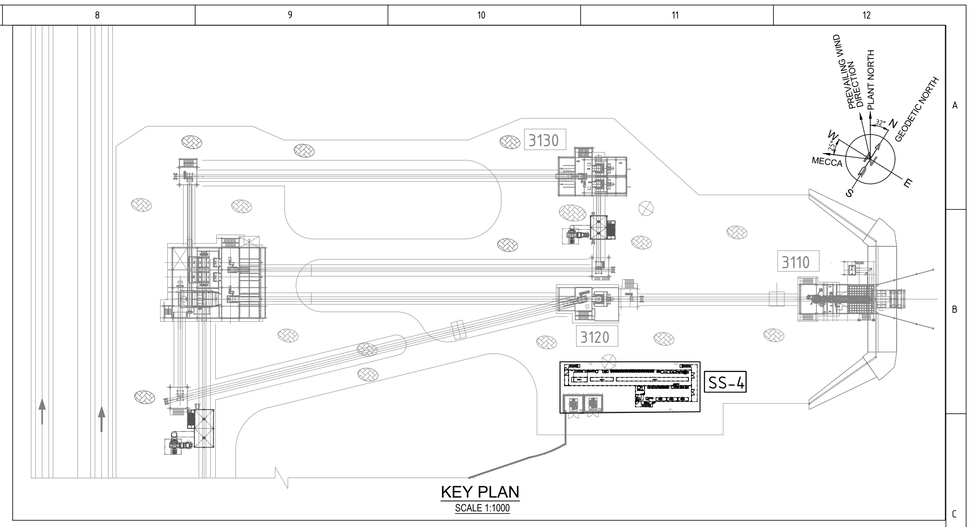

KEY PLAN
SCALE 1:1000

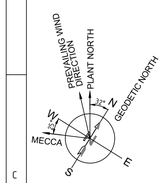

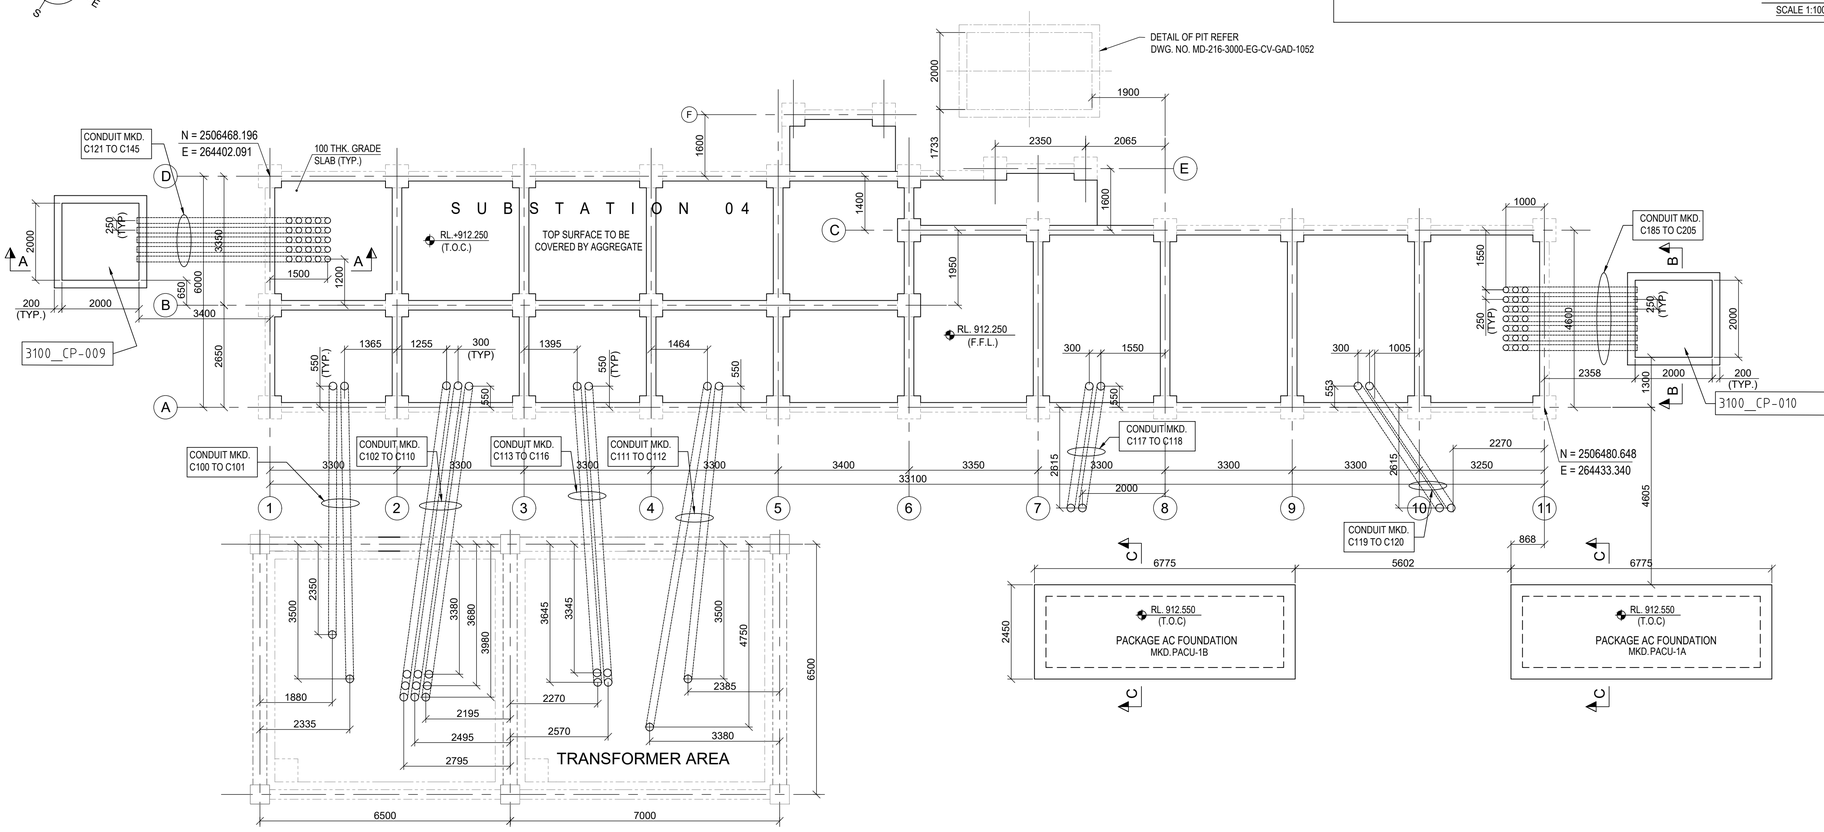

LAYOUT OF GRADE SLAB & ELECTRICAL CONDUITS
SCALE 1:75

LEGENDS :-

R.L. - REDUCED LEVEL
C - CENTRE LINE
T.O.C. - TOP OF CONCRETE
TYP. - TYPICAL
T.O.G. - TOP OF GROUT
B.O.F. - BOTTOM OF FOUNDATION
F.G.L. - FINISHED GROUND LEVEL.
F.F.L. - FINISHED FLOOR LEVEL
P.C.C - PLAIN CEMENT CONCRETE
DET. - DETAIL
FDN. - FOUNDATION
THK. - THICK
R.C.C. - REINFORCED CEMENT CONCRETE
MKD. - MARKED
DRG. - DRAWING

NOTES:-

1. ALL DIMENSIONS ARE IN MILLIMETRES AND LEVELS AND CO-ORDINATES ARE IN METRES UNLESS OTHERWISE STATED.
2. NET SAFE BEARING CAPACITY OF SOIL AT BOTTOM OF FOUNDATION IS CONSIDERED AS 50 KN/ SQM.
3. GRADE OF CONCRETE SHALL BE C35 (35Mpa) FOR FOUNDATION, C30 (30Mpa) FOR GRADE SLAB & C15 (15Mpa) FOR BLINDING CONCRETE.
4. GRADE OF REINFORCEMENT SHALL BE DEFORMED BAR 420 MPa (GRADE 60) - ASTM A615/A615M.
5. CLEAR COVER TO REINFORCEMENT SHALL BE SLAB = 25 MM.
6. FOR STANDARD REINFORCEMENT DETAIL & GENERAL NOTES FOR CIVIL WORKS REFER DRAWING NO. MD-216-1000-EG-CV-DED-1005 & 1001.
7. STRUCTURAL FILL SHALL CONFORM TO PROVISIONS OF DOCUMENT MD-216-1000-EG-CV-MST-1698.
8. THIS DRG SHALL BE READ IN CONJUNCTION WITH DRG NO. MD-216-49PQ-EG-CV-GAD-1636.
9. FOR DETAILS OF SLAB EDGE THICKENING AND RE-ENTRANT REBARS REFER MD-101-SMEM-EG-ST-DST-002 AND MD-101-SMEM-EG-ST-DST-007. FOR DETAILS OF SLAB JOINTS REFER MD-216-1000-EG-CV-DED-1002.

DOCUMENT NUMBER	REFERENCE DOCUMENTS	REV	DATE	REVISION DESCRIPTION	DRN	CHK	ENG	APP	EMP
		D01	14/03/2023	AS-BUILT	AMJ	SJM	AVG	AG	
MD-216-3000-EG-CV-GAD-1052	CRUSHER AREA PULL PIT LAYOUT-LAYOUT & DETAILS	C01	06/05/2021	ISSUED FOR CONSTRUCTION	AMJ	SJM	AVG	AG	
MD-216-3100-EG-EL-LAD-1032	CABLE ROUTE LAYOUT - SUBSTATION-04	A02	08/04/2021	REVISED AS PER EMPLOYER COMMENTS	AMJ	SJM	AVG	AG	
MD-216-49PQ-EG-CV-GAD-1609	DETAIL OF TRANSFORMER AREA			DATED 29/03/2021 & REVISED AS MKD. A02					
MD-216-49PQ-EG-CV-GAD-1605	LAYOUT OF FOUNDATIONS								
MD-216-1000-EG-ST-CRT-1001	CIVIL, STRUCTURAL & ARCHITECTURAL - DESIGN CRITERIA	A01	03/03/2021	ISSUED FOR REVIEW	ABS	SJM	AVG	AG	

RESERVED FOR VENDOR LOGO AND DRAWING NUMBER

LARSEN & TOUBRO

This drawing is the property of LARSEN & TOUBRO and must not be passed on to any person or body not authorized by us to receive it nor be copied or otherwise made use either in full or in part by such person or body without our prior permission in writing.

Outotec

The content of these documents are the sole property of Outotec Oyj. Any rights not expressly granted herein are reserved. Reproduction, transfer or distribution of part or all of the contents in any form without prior written permission of Outotec is prohibited.

MA'ADEN معادن
Saudi Arabian Mining Company شركة التعدين العربية السعودية

This document and the information contained herein is Ma'aden proprietary know-how. This document or any part thereof should not be reproduced, stored in a retrieval system or transmitted by any means, electronic or otherwise, or divulged without prior written permission of Ma'aden.

LARSEN & TOUBRO DRAWING NUMBER: 019045_950_C_G_24613_001 | REVISION: 3
OUTOTEC DRAWING NUMBER: 900707__GAU01__WD01__MTL01__45098 | DOCUMENT ID: 0U100717980 | REVISION: 3

DRAWN	ABS	24/02/2021
CHECKED	SJM	25/02/2021
ENGINEER	AVG	24/02/2021
APPROVED	AG	03/03/2021
EMPLOYER		
SCALE	1:75	A1

MANSOURAH - MASSARAH GOLD PROJECT
GENERAL ARRANGEMENT DRAWING
PROCESS PLANT SUBSTATION 04
LAYOUT & DET. OF GRADE SLAB & ELECTRICAL CONDUITS

DRAWING NUMBER: MD-216-49PQ-EG-CV-GAD-1635 | REV: D01