
DRAWING NUMBER: MD-216-49PQ-EG-CV-GAD-1636 | REV: D01


CONDUIT MARKING TABLE	
CONDUIT TAG	CL. ELEVATION
C100	+911.400
C101	+910.750
C102	+911.400
C103	+911.100
C104	+910.800
C105	+911.400
C106	+911.100
C107	+910.800
C108	+911.400
C109	+911.100
C110	+910.800
C111	+911.400
C112	+910.750
C113	+910.750
C114	+910.450
C115	+910.750
C116	+910.450
C117	+911.400
C118	+911.400
C119	+911.400
C120	+911.400
C121	+911.425
C122	+911.425
C123	+911.425
C124	+911.425
C125	+911.425
C126	+911.175
C127	+911.175
C128	+911.175
C129	+911.175
C130	+911.175
C131	+910.925
C132	+910.925
C133	+910.925
C134	+910.925
C135	+910.925
C136	+910.675
C137	+910.675
C138	+910.675
C139	+910.675
C140	+910.675
C141	+910.425
C142	+910.425
C143	+910.425
C144	+910.425
C145	+910.425

CONDUIT MARKING TABLE	
CONDUIT TAG	CL. ELEVATION
C185	+911.425
C186	+911.425
C187	+911.425
C188	+911.425
C189	+911.425
C190	+911.425
C191	+911.425
C192	+911.175
C193	+911.175
C194	+911.175
C195	+911.175
C196	+911.175
C197	+911.175
C198	+911.175
C199	+910.925
C200	+910.925
C201	+910.925
C202	+910.925
C203	+910.925
C204	+910.925
C205	+910.925

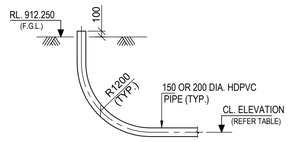


TYP. DET. OF CONDUIT

SCALE 1:50

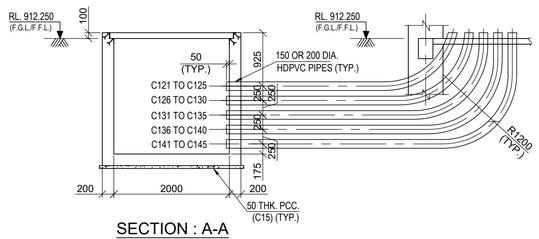


SECTION : A-A

SCALE 1:50

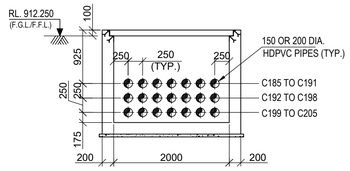


SECTION : B-B

SCALE 1:50

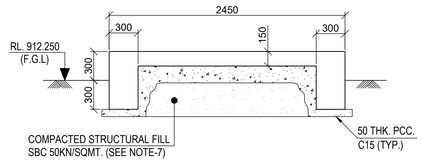

SECTION : C-C

SCALE 1:30

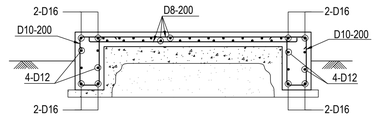

SECTION : C-C

(RC. DETAILS)

SCALE 1:30

LEGENDS :-

R.L. - REDUCED LEVEL
CL. - CENTRE LINE
T.O.C. - TOP OF CONCRETE
T.O.G. - TOP OF GROUT
TYP. - TYPICAL
F.G.L. - FINISHED GROUND LEVEL
F.F.L. - FINISHED FLOOR LEVEL
B.O.F. - BOTTOM OF FOUNDATION
MKD. - MARKED
THK. - THICK
R.C. - REINFORCED CONCRETE
P.C.C - PLAIN CEMENT CONCRETE
FDN. - FOUNDATION
DET. - DETAIL
COL. - COLUMN
DIA. - DIAMETER
R - RADIUS
HDPVC - HIGH DENSITY POLYVINYL CHLORIDE

NOTES:-

1. ALL DIMENSIONS ARE IN MILLIMETRES AND LEVELS AND CO-ORDINATES ARE IN METRES UNLESS OTHERWISE STATED.
2. NET SAFE BEARING CAPACITY OF SOIL AT BOTTOM OF FOUNDATION IS CONSIDERED AS 50 KN/ SQM.
3. GRADE OF CONCRETE SHALL BE C35 (35Mpa) FOR FOUNDATION, C30 (30Mpa) FOR GRADE SLAB & C15 (15Mpa) FOR BLINDING CONCRETE.
4. GRADE OF REINFORCEMENT SHALL BE DEFORMED BAR 420 MPa (GRADE 60) - ASTM A615/A615M.
5. CLEAR COVER TO REINFORCEMENT SHALL BE SLAB = 25 MM.
6. FOR STANDARD REINFORCEMENT DETAIL & GENERAL NOTES FOR CIVIL WORKS REFER DRAWING NO. MD-216-1000-EG-CV-DED-1005 & 1001.
7. STRUCTURAL FILL SHALL CONFORM TO PROVISIONS OF DOCUMENT MD-216-1000-EG-CV-MST-1698.
8. THIS DRG SHALL BE READ IN CONJUNCTION WITH DRG NO. MD-216-49PQ-EG-CV-GAD-1635.
9. FOR DETAILS OF SLAB EDGE THICKENING AND RE-ENTRANT REBARS REFER MD-101-SMEM-EG-ST-DST-002 AND MD-101-SMEM-EG-ST-DST-007. FOR DETAILS OF SLAB JOINTS REFER MD-216-1000-EG-CV-DED-1002.

DOCUMENT NUMBER	REFERENCE DOCUMENTS	REV	DATE	REVISION DESCRIPTION	DRN	CHK	ENG	APP	EMP
MD-216-49PQ-EG-CV-GAD-1635	LAYOUT & DET. OF GRADE SLAB & ELECTRICAL CONDUITS - SS 04								
MD-216-3000-EG-CV-GAD-1052	CRUSHER AREA PULL PIT LAYOUT-LAYOUT & DETAILS	D01	14/03/2023	AS-BUILT	AMJ	SJM	AVG	AG	
MD-216-3100-EG-EL-LAD-1032	CABLE ROUTE LAYOUT - SUBSTATION-04	C01	06/05/2021	ISSUED FOR CONSTRUCTION	AMJ	SJM	AVG	AG	
MD-216-49PQ-EG-CV-GAD-1609	DETAIL OF TRANSFORMER AREA	A02	08/04/2021	REVISED AS PER EMPLOYER COMMENTS	AMJ	SJM	AVG	AG	
MD-216-49PQ-EG-CV-GAD-1605	LAYOUT OF FOUNDATIONS			DATED 29/03/2021 & REVISED AS MKD. (A02)					
MD-216-1000-EG-ST-CRT-1001	CIVIL, STRUCTURAL & ARCHITECTURAL - DESIGN CRITERIA	A01	03/03/2021	ISSUED FOR REVIEW	ABS	SJM	AVG	AG	

RESERVED FOR VENDOR LOGO AND DRAWING NUMBER

LARSEN & TOUBRO

This drawing is the property of LARSEN & TOUBRO and must not be passed on to any person or body not authorized by us to receive it nor be copied or otherwise made use either in full or in part by such person or body without our prior permission in writing.

Outotec

The content of these documents are the sole property of Outotec Oyj. Any rights not expressly granted herein are reserved. Reproduction, transfer or distribution of part or all of the contents in any form without prior written permission of Outotec is prohibited.

MA'ADEN معادن
Saudi Arabian Mining Company شركة التعدين العربية السعودية

This document and the information contained herein is Ma'aden proprietary know-how. This document or any part thereof should not be reproduced, stored in a retrieval system or transmitted by any means, electronic or otherwise, or divulged without prior written permission of Ma'aden.

LARSEN & TOUBRO DRAWING NUMBER: 019045_950_C_G_24613_002 | REVISION: 3

OUTOTEC DRAWING NUMBER: 900707__GAU01__WD01__MTL01__45099 | DOCUMENT ID: OU100717981 | REVISION: 3

DRAWN	ABS	24/02/2021
CHECKED	SJM	25/02/2021
ENGINEER	AVG	24/02/2021
APPROVED	AG	03/03/2021
EMPLOYER		
SCALE	1:50, 1:20	A1

MANSOURAH - MASSARAH GOLD PROJECT
GENERAL ARRANGEMENT DRAWING
PROCESS PLANT SUBSTATION 04
LAYOUT & DET. OF GRADE SLAB & ELECTRICAL CONDUITS

DRAWING NUMBER: MD-216-49PQ-EG-CV-GAD-1636 | REV: D01