
DRAWING NUMBER: MD-216-49PQ-EG-CV-GAD-1637 | REV: D01


CONDUIT MARKING TABLE		
CONDUIT TAG	CL. OF ELEVATION	DIA. OF CONDUIT
C017	RL. 913.300	200
C018	RL. 914.400	200
C019	RL. 914.100	200
C020	RL. 913.800	200
C021	RL. 914.400	200
C022	RL. 914.100	200
C023	RL. 913.800	200
C024	RL. 914.400	150
C034	RL. 914.650	200
C035	RL. 914.650	200
C036	RL. 914.650	200
C037	RL. 914.650	200

CONDUIT MARKING TABLE		
CONDUIT TAG	CL. OF ELEVATION	DIA. OF CONDUIT
C038	RL. 914.350	200
C039	RL. 914.350	200
C040	RL. 914.350	200
C041	RL. 914.350	200
C050	RL. 914.400	200
C051	RL. 914.400	200
C052	RL. 914.400	200
C053	RL. 914.400	200
C053a	RL. 914.400	200
C054	RL. 914.100	200
C055	RL. 914.100	200
C056	RL. 914.100	200

CONDUIT MARKING TABLE		
CONDUIT TAG	CL. OF ELEVATION	DIA. OF CONDUIT
C057	RL. 914.100	200
C057a	RL. 914.100	200
C058	RL. 913.800	200
C059	RL. 913.800	200
C060	RL. 913.800	200
C061	RL. 913.800	200
C061a	RL. 913.800	200
C070	RL. 914.400	200
C071	RL. 914.400	200
C072	RL. 914.100	200
C073	RL. 914.100	200

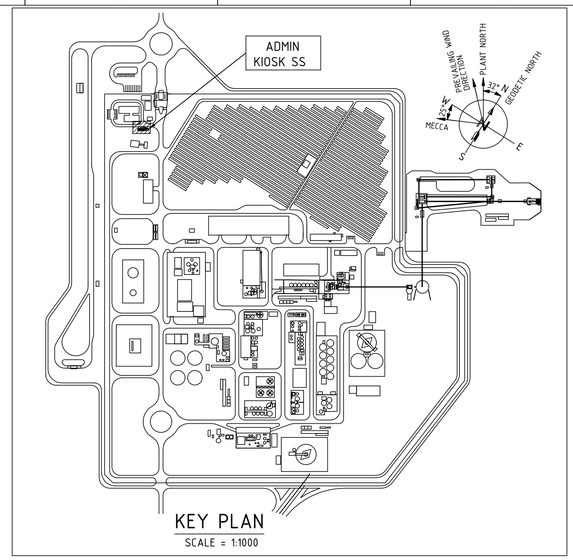

KEY PLAN
SCALE = 1:1000

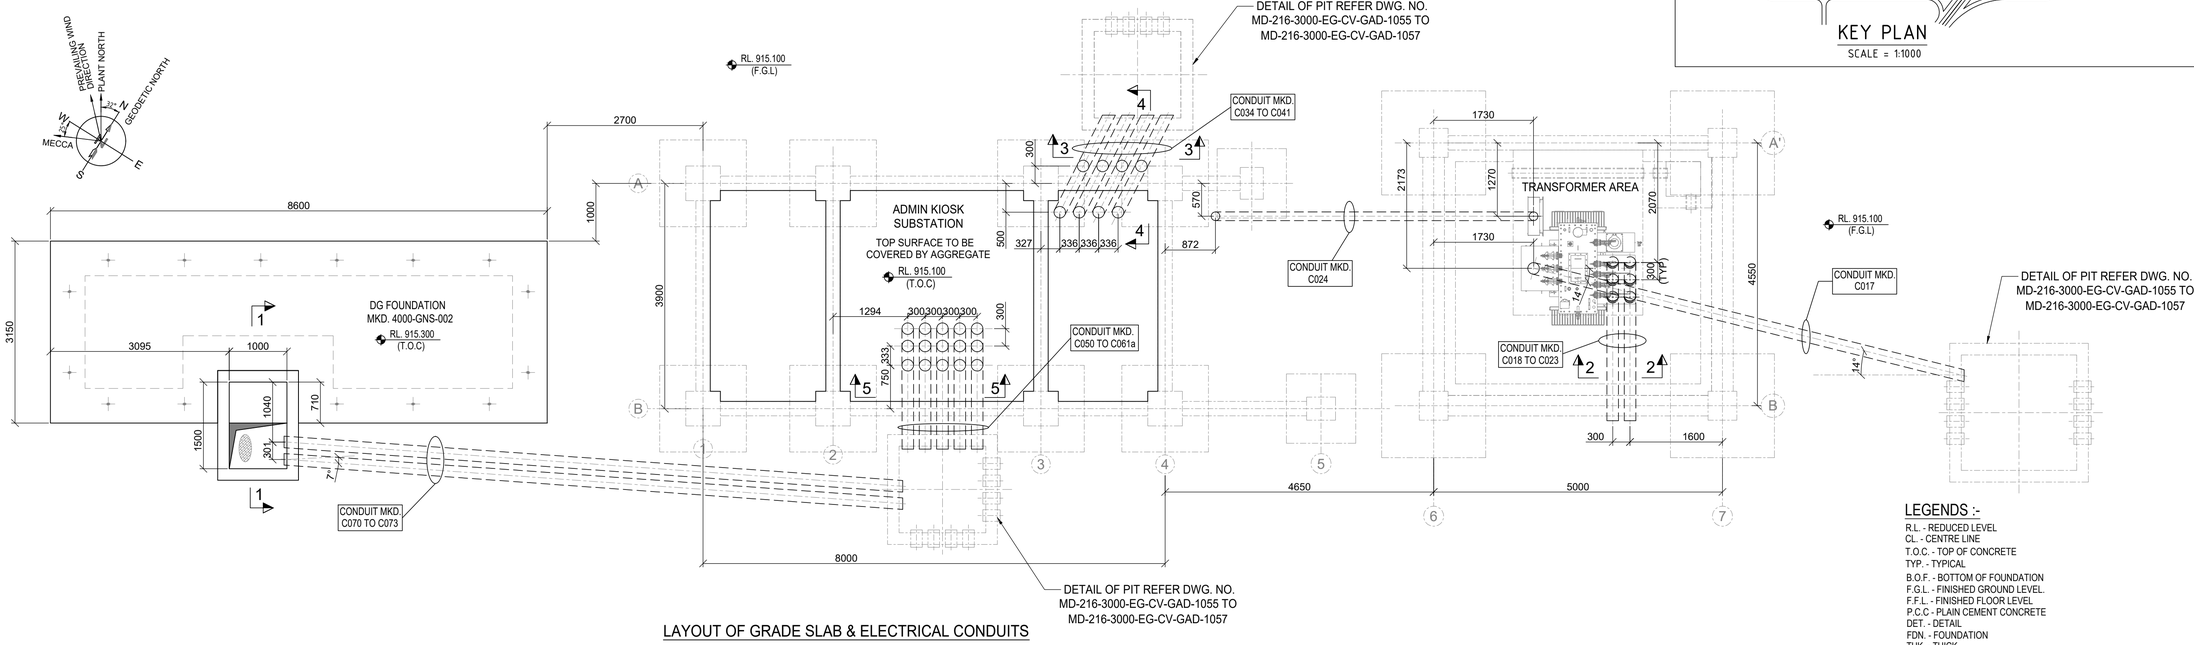

LAYOUT OF GRADE SLAB & ELECTRICAL CONDUITS
SCALE 1 : 50

LEGENDS :-

R.L. - REDUCED LEVEL
CL. - CENTRE LINE
T.O.C. - TOP OF CONCRETE
TYP. - TYPICAL
B.O.F. - BOTTOM OF FOUNDATION
F.G.L. - FINISHED GROUND LEVEL.
F.F.L. - FINISHED FLOOR LEVEL
P.C.C - PLAIN CEMENT CONCRETE
DET. - DETAIL
FDN. - FOUNDATION
THK. - THICK
R.C.C - REINFORCED CEMENT CONCRETE
MKD. - MARKED
DWG. - DRAWING

NOTES:-

1. ALL DIMENSIONS ARE IN MILLIMETRES AND LEVELS AND CO-ORDINATES ARE IN METRES UNLESS OTHERWISE STATED.
2. NET SAFE BEARING CAPACITY OF SOIL AT BOTTOM OF FOUNDATION IS CONSIDERED AS 50 KN/ SQM.
3. GRADE OF CONCRETE SHALL BE C35 (35Mpa) FOR FOUNDATION, C30 (30Mpa) FOR GRADE SLAB & C15 (15Mpa) FOR BLINDING CONCRETE.
4. GRADE OF REINFORCEMENT SHALL BE DEFORMED BAR 420 MPa (GRADE 60) - ASTM A615/A615M.
5. CLEAR COVER TO REINFORCEMENT SHALL BE SLAB = 25 MM.
6. FOR STANDARD REINFORCEMENT DETAIL & GENERAL NOTES FOR CIVIL WORKS REFER DRAWING NO. MD-216-1000-EG-CV-DED-1005 & 1001.
7. STRUCTURAL FILL SHALL CONFORM TO PROVISIONS OF DOCUMENT MD-216-1000-EG-CV-MST-1698.

DOCUMENT NUMBER	REFERENCE DOCUMENTS			REVISION DESCRIPTION	DRN	CHK	ENG	APP	EMP
MD-216-49PQ-EG-CV-GAD-1638	POWER DISTRIBUTION : ADMIN KIOSK								
	DETAIL OF GRADE SLAB & ELECTRICAL CONDUITS								
MD-216-4000-EG-EL-GAD-V565-1002	NON PROCESS AREA BUILDINGS-								
	400 V DG SET ADMINISTRATION KIOSK AREA								
MD-216-4000-EG-EL-LAD-1018	ADMIN KIOSK : CABLE ROUTE LAYOUT-EMBEDDED PART								
MD-216-49PQ-EG-CV-GAD-1628	POWER DISTRIBUTION:ADMIN KIOSK SS.								
	DETAIL OF TRANSFORMER AREA	D01	14/03/2023	AS-BUILT	AMJ	SJM	AVG	AG	
MD-216-49PQ-EG-CV-GAD-1627	POWER DISTRIBUTION:ADMIN KIOSK SS.	C01	03/05/2021	ISSUED FOR CONSTRUCTION & REVISED AS PER	AMJ	SJM	AVG	AG	
	LAYOUT & DETAILS OF FOUNDATIONS			EMPLOYER COMMENTS DATED 18/04/2021					
MD-216-1000-EG-ST-CRT-1001	CIVIL,STRUCTURAL AND ARCHITECTURAL DESIGN CRITERIA	A01	20/03/2021	ISSUED FOR REVIEW	AMJ	SJM	AVG	AG	

RESERVED FOR VENDOR LOGO AND DRAWING NUMBER

LARSEN & TOUBRO

This drawing is the property of LARSEN & TOUBRO and must not be passed on to any person or body not authorized by us to receive it nor be copied or otherwise made use either in full or in part by such person or body without our prior permission in writing.

Outotec

The content of these documents are the sole property of Outotec Oyj. Any rights not expressly granted herein are reserved. Reproduction, transfer or distribution of part or all of the contents in any form without prior written permission of Outotec is prohibited.

MA'ADEN معادن
Saudi Arabian Mining Company شركة التعدين العربية السعودية

This document and the information contained herein is Ma'aden proprietary know-how. This document or any part thereof should not be reproduced, stored in a retrieval system or transmitted by any means, electronic or otherwise, or divulged without prior written permission of Ma'aden.

LARSEN & TOUBRO DRAWING NUMBER: 019045_950_C_G_24648_001 | REVISION: 2
OUTOTEC DRAWING NUMBER: 900707__GAU01__WD01__MTL01__45101 | DOCUMENT ID: OU100718545 | REVISION: 2

DRAWN	AMJ	11/03/2021
CHECKED	SJM	12/03/2021
ENGINEER	AVG	11/03/2021
APPROVED	AG	20/03/2021
EMPLOYER		
SCALE	1:75, 1:25 & 1:15	A1

MANSOURAH - MASSARAH GOLD PROJECT
GENERAL ARRANGEMENT DRAWING
POWER DISTRIBUTION : ADMIN KIOSK
LAYOUT & DETAIL OF GRADE SLAB & ELECTRICAL CONDUITS

DRAWING NUMBER: MD-216-49PQ-EG-CV-GAD-1637 | REV: D01