


DRAWING NUMBER MD - 216 - 49PQ- EG - CV - GAD - 1638 REV D01

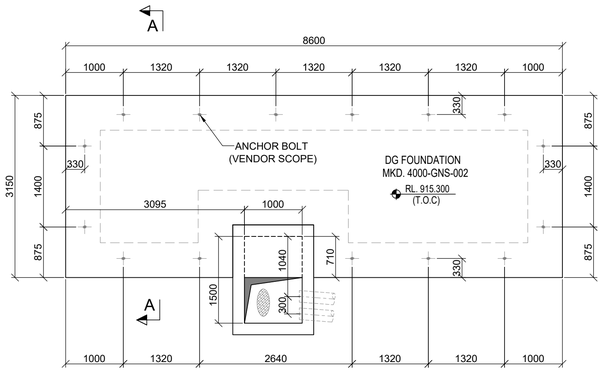



DETAIL OF DG FOUNDATION MKD. 4000-GNS-002


SCALE 1 : 50

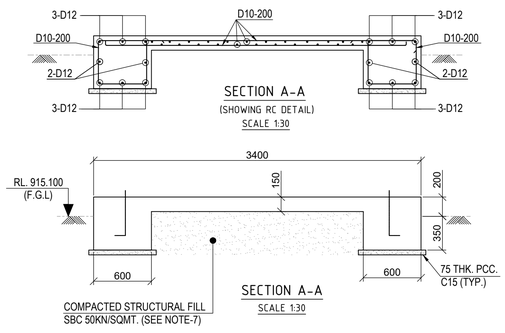


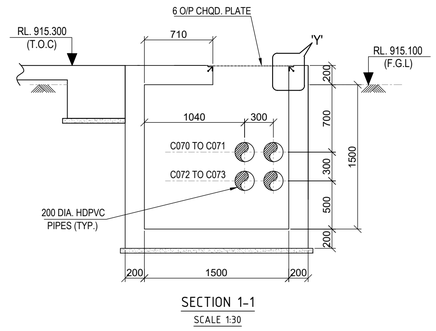


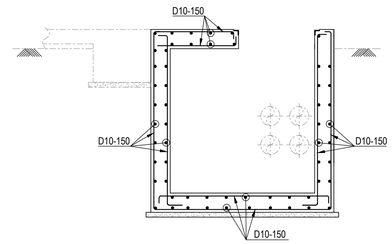


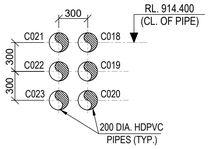

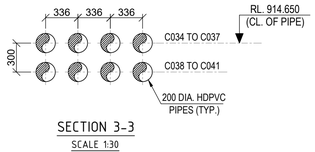

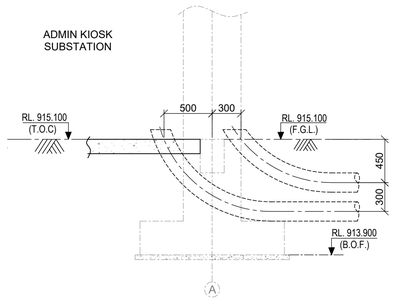


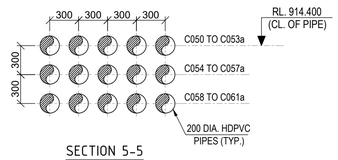

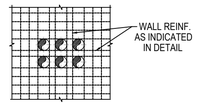


TYP. DETAIL OF WALL REINF. NEAR PIPES

SCALE 1:50

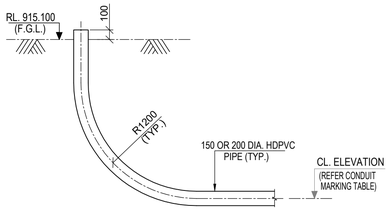

TYP. DET. OF CONDUIT

SCALE 1:30

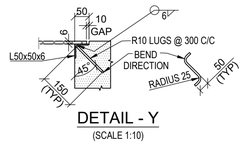

DETAIL - Y

(SCALE 1:10)

LEGENDS :-

R.L. - REDUCED LEVEL
CL. - CENTRE LINE
T.O.C. - TOP OF CONCRETE
TYP. - TYPICAL
T.O.G. - TOP OF GROUT
B.O.F. - BOTTOM OF FOUNDATION
F.G.L. - FINISHED GROUND LEVEL.
F.F.L. - FINISHED FLOOR LEVEL
P.C.C - PLAIN CEMENT CONCRETE
DET. - DETAIL
FDN. - FOUNDATION
THK. - THICK
R.C.C - REINFORCED CEMENT CONCRETE
MKD. - MARKED
CHQD. - CHEQUERED

NOTES:-

1. ALL DIMENSIONS ARE IN MILLIMETRES AND LEVELS AND CO-ORDINATES ARE IN METRES UNLESS OTHERWISE STATED.
2. NET SAFE BEARING CAPACITY OF SOIL AT BOTTOM OF FOUNDATION IS CONSIDERED AS 50 KN/ SQM.
3. GRADE OF CONCRETE SHALL BE C35 (35Mpa) FOR FOUNDATION, C30 (30Mpa) FOR GRADE SLAB & C15 (15Mpa) FOR BLINDING CONCRETE.
4. GRADE OF REINFORCEMENT SHALL BE DEFORMED BAR 420 MPa (GRADE 60) - ASTM A615/A615M.
5. CLEAR COVER TO REINFORCEMENT SHALL BE SLAB = 25 MM.
6. FOR STANDARD REINFORCEMENT DETAIL & GENERAL NOTES FOR CIVIL WORKS REFER DRAWING NO. MD-216-1000-EG-CV-DED-1005 & 1001.
7. STRUCTURAL FILL SHALL CONFORM TO PROVISIONS OF DOCUMENT MD-216-1000-EG-CV-MST-1698.

DOCUMENT NUMBER	REFERENCE DOCUMENTS			REVISION DESCRIPTION	DRN	CHK	ENG	APP	EMP
MD-216-49PQ-EG-CV-GAD-1637	POWER DISTRIBUTION : ADMIN KIOSK								
	LAYOUT & DETAIL OF GRADE SLAB & ELECTRICAL CONDUITS								
MD-216-4000-EG-EL-GAD-V565-1002	NON PROCESS AREA BUILDINGS-								
	400 V DG SET ADMINISTRATION KIOSK AREA								
MD-216-4000-EG-EL-LAD-1018	ADMIN KIOSK : CABLE ROUTE LAYOUT-EMBEDDED PART								
MD-216-49PQ-EG-CV-GAD-1628	POWER DISTRIBUTION:ADMIN KIOSK SS.								
	DETAIL OF TRANSFORMER AREA	D01	14/03/2023	AS-BUILT	AMJ	SJM	AVG	AG	
MD-216-49PQ-EG-CV-GAD-1627	POWER DISTRIBUTION:ADMIN KIOSK SS.	C01	03/05/2021	ISSUED FOR CONSTRUCTION & REVISED AS PER EMPLOYER	AMJ	SJM	AVG	AG	
	LAYOUT & DETAILS OF FOUNDATIONS			COMMENTS DATED 18/04/2021 & REVISED AS MKD.					
MD-216-1000-EG-ST-CRT-1001	CIVIL,STRUCTURAL AND ARCHITECTURAL DESIGN CRITERIA	A01	20/03/2021	ISSUED FOR REVIEW	AMJ	SJM	AVG	AG	

RESERVED FOR VENDOR LOGO AND DRAWING NUMBER

LARSEN & TOUBRO

This drawing is the property of LARSEN & TOUBRO and must not be passed on to any person or body not authorized by us to receive it nor be copied or otherwise made use either in full or in part by such person or body without our prior permission in writing.

Outotec

The content of these documents are the sole property of Outotec Oyj. Any rights not expressly granted herein are reserved. Reproduction, transfer or distribution of part or all of the contents in any form without prior written permission of Outotec is prohibited.

MA'ADEN معادن
Saudi Arabian Mining Company شركة التعدين العربية السعودية

This document and the information contained herein is Ma'aden proprietary know-how. This document or any part thereof should not be reproduced, stored in a retrieval system or transmitted by any means, electronic or otherwise, or divulged without prior written permission of Ma'aden.

LARSEN & TOUBRO DRAWING NUMBER	019045_950_C_G_24648_002	REVISION 2
OUTOTEC DRAWING NUMBER	900707 __GAU01 __WD01__MTL01 __45102	DOCUMENT ID OU100718546 / REVISION 2

DRAWN	AMJ	11/03/2021
CHECKED	SJM	12/03/2021
ENGINEER	AVG	11/03/2021
APPROVED	AG	20/03/2021
EMPLOYER		
SCALE	1:75, 1:25 & 1:15	A1

MANSOURAH - MASSARAH GOLD PROJECT
GENERAL ARRANGEMENT DRAWING
POWER DISTRIBUTION : ADMIN KIOSK
DETAIL OF GRADE SLAB & ELECTRICAL CONDUITS

DRAWING NUMBER MD - 216 - 49PQ- EG - CV - GAD - 1638 REV D01