

DRAWING NUMBER MD-216-49PQ-EG-CV-GAD-1641 REV D01

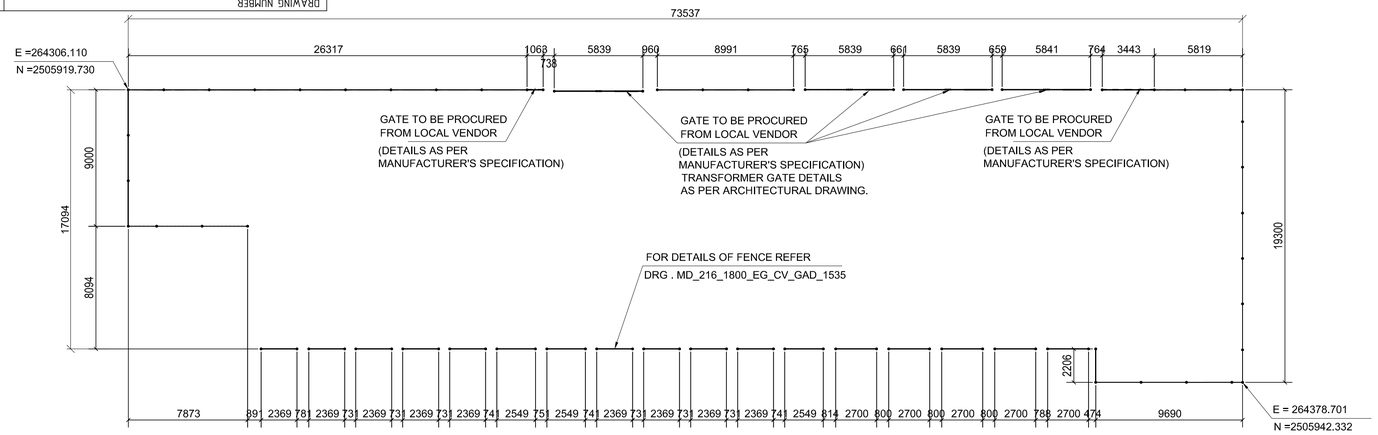


SUBSTATION-3 DEMARCATION FENCE

SCALE 1:200

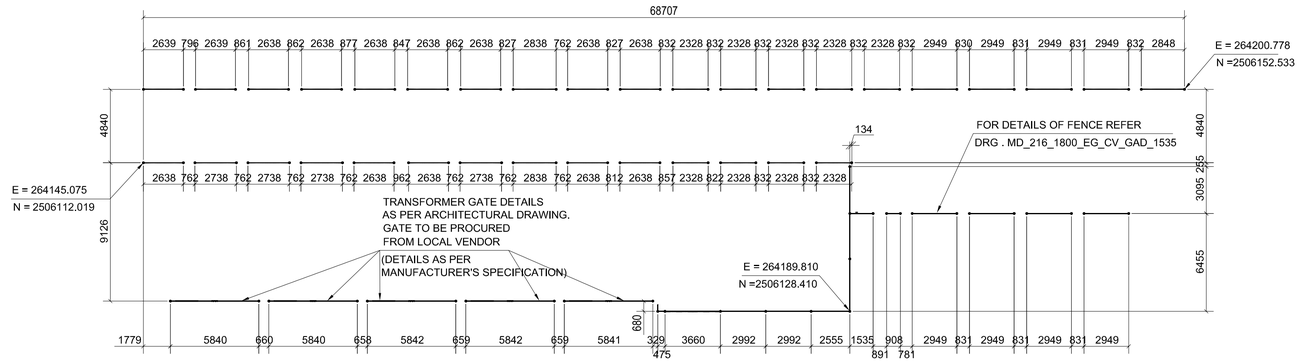


SUBSTATION-1 DEMARCATION FENCE

SCALE 1:200

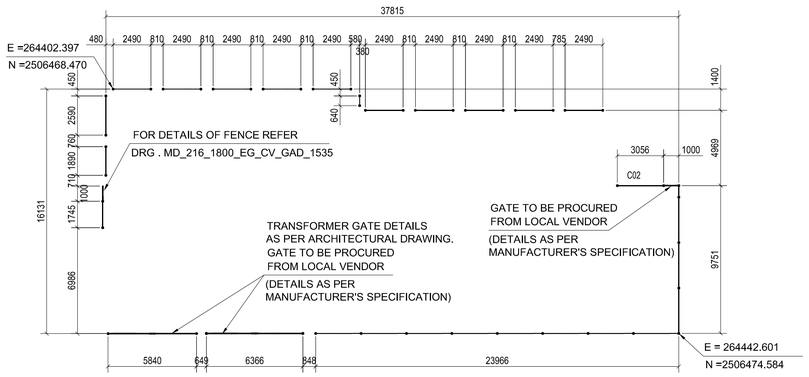

SUBSTATION-4 DEMARCATION FENCE

SCALE 1:200

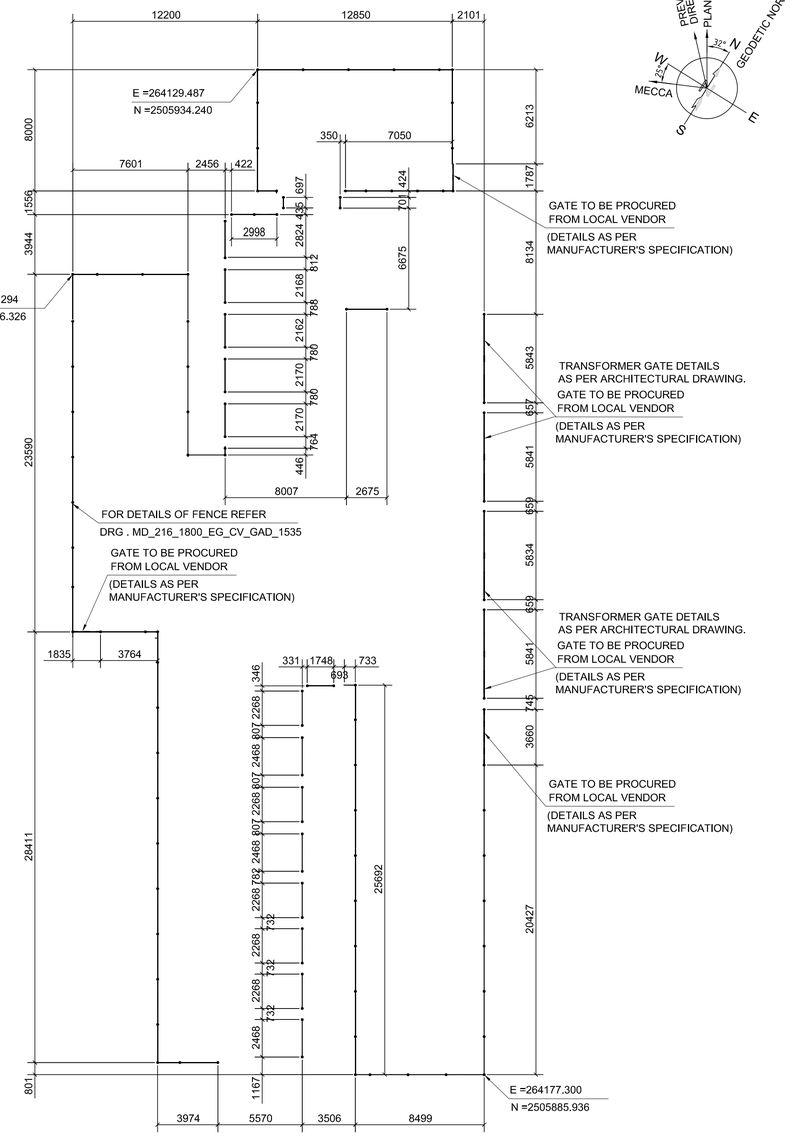

SUBSTATION-2 DEMARCATION FENCE

SCALE 1:200

NOTES :-

1. ALL DIMENSION ARE IN MILLMETRE UNLESS OTHERWISE NOTED.
2. ALL COORDINATES ARE IN METRE.
3. FOR OTHER NOTES REFER DRAWING NO. MD-216-1800-EG-CV-GAD-1535.
4. GATE POST AND FOUNDATION DETAILS SHALL BE AS PER GATE SUPPLIERS REQUIREMENT.

DOCUMENT NUMBER	REFERENCE DOCUMENTS	REV	DATE	REVISION DESCRIPTION	DRN	CHK	ENG	APP	EMP
		D01	17/05/2023	AS-BUILT	SUP	SJM	AVG	AG	
MD-216-1800-EG-CV-GAD-1535	SECURITY SYSTEM-MINING BOUNDARY OVERALL PERIMETER FENCE, PLAN, SECTIONS & DETAILS	C02	27/12/2021	ISSUED FOR CONSTRUCTION AND REVISED AS MARKED. C02	SUP	SJM	AVG	AG	
MD-216-3100-EG-EL-LAD-1032	CABLE ROUTE LAYOUT - SUBSTATION-4								
MD-216-49PQ-EG-EL-LAD-1035	CABLE ROUTE LAYOUT - SUBSTATION-3	C01	28/10/2021	ISSUED FOR CONSTRUCTION, REVISED AS PER EMPLOYER	SUP	SJM	AVG	AG	
MD-216-49PQ-EG-EL-LAD-1014	CABLE ROUTE LAYOUT - SUBSTATION-2			COMMENTS DATED 30/06/21 AS MARKED					
MD-216-49PQ-EG-EL-LAD-1013	CABLE ROUTE LAYOUT - SUBSTATION-1	A01	28/05/2021	ISSUED FOR APPROVAL	SUP	SJM	AVG	AG	

RESERVED FOR VENDOR LOGO AND DRAWING NUMBER

LARSEN & TOUBRO

This drawing is the property of LARSEN & TOUBRO and must not be passed on to any person or body not authorized by us to receive it nor be copied or otherwise made use either in full or in part by such person or body without our prior permission in writing.

Outotec

The content of these documents are the sole property of Outotec Oyj. Any rights not expressly granted herein are reserved. Reproduction, transfer or distribution of part or all of the contents in any form without prior written permission of Outotec is prohibited.

MA'ADEN معادن Saudi Arabian Mining Company شركة التعدين العربية السعودية

This document and the information contained herein is Ma'aden proprietary know-how. This document or any part thereof should not be reproduced, stored in a retrieval system or transmitted by any means, electronic or otherwise, or divulged without prior written permission of Ma'aden.

LARSEN & TOUBRO DRAWING NUMBER: 019045_950_C_G_24685_001 — REVISION: 3

OUTOTEC DRAWING NUMBER: 900707 __GAU01 __WD01__MTL01 __45105 — DOCUMENT ID: OU100724240 — REVISION: 3

DRAWN	SUP	19/05/2021
CHECKED	SJM	25/05/2021
ENGINEER	AVG	20/05/2021
APPROVED	AG	28/05/2021
EMPLOYER		
SCALE	1:200	A1

MANSOURAH - MASSARAH GOLD PROJECT
GENERAL ARRANGEMENT DRAWING
SUBSTATION 1,2,3 &4
DEMARCATION FENCE LAYOUT

DRAWING NUMBER: MD-216-49PQ-EG-CV-GAD-1641 — REV: D01