


DRAWING NUMBER
MD-216-3830-EG-CV-GAD-1422
REV
D01

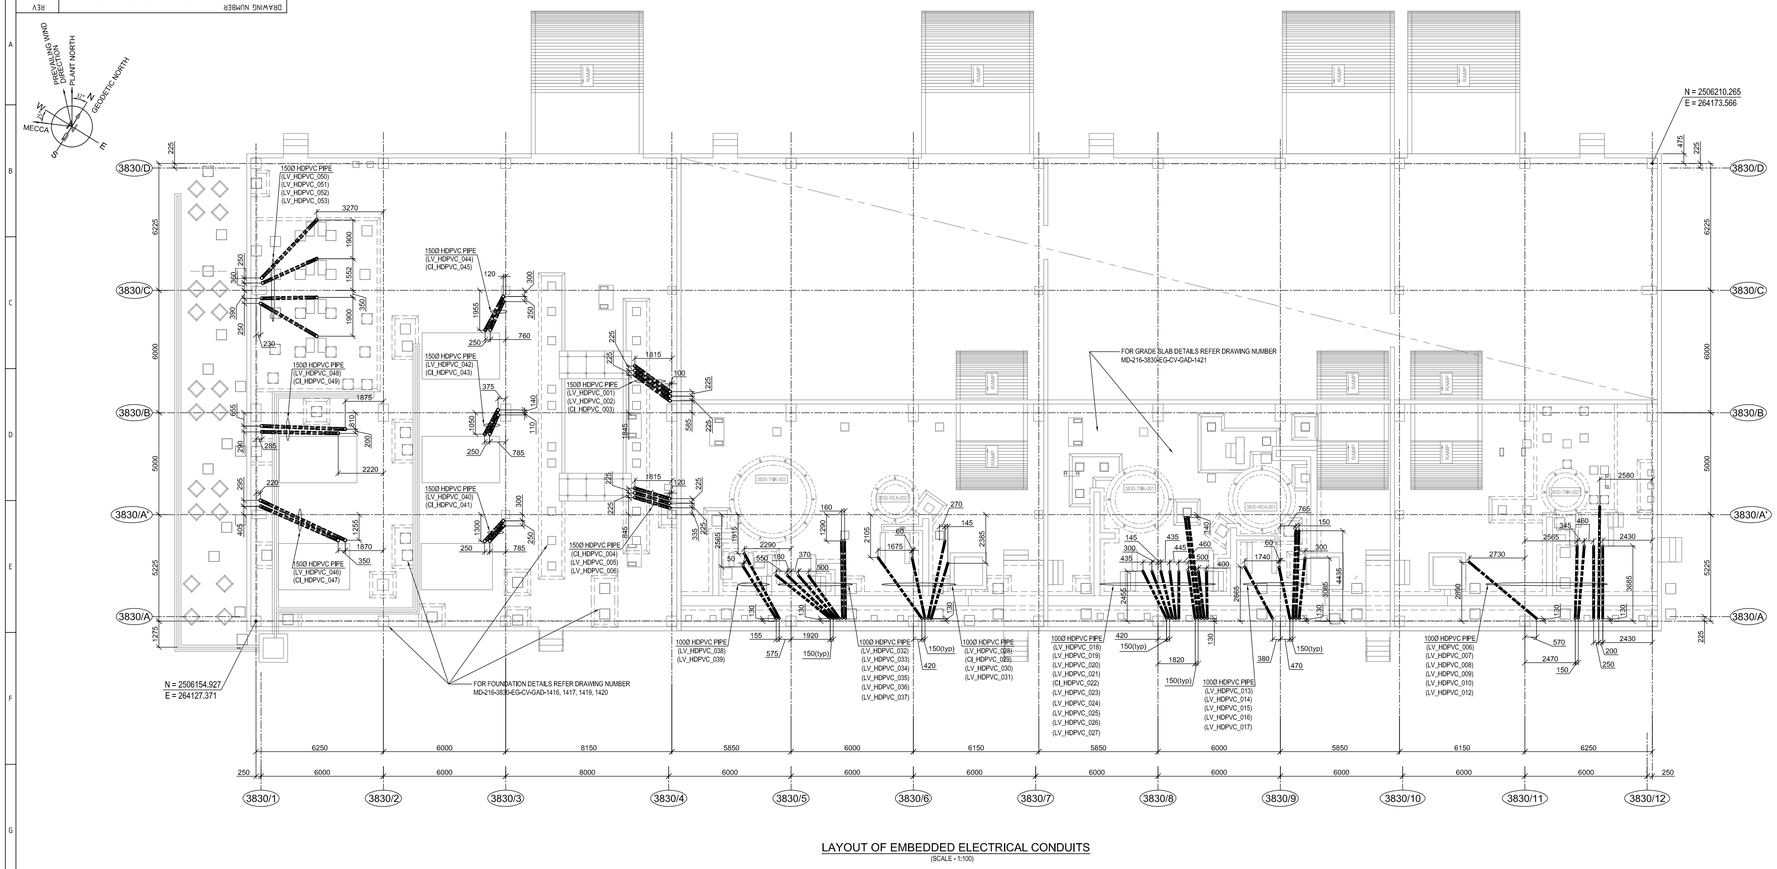

LAYOUT OF EMBEDDED ELECTRICAL CONDUITS
(SCALE - 1:100)

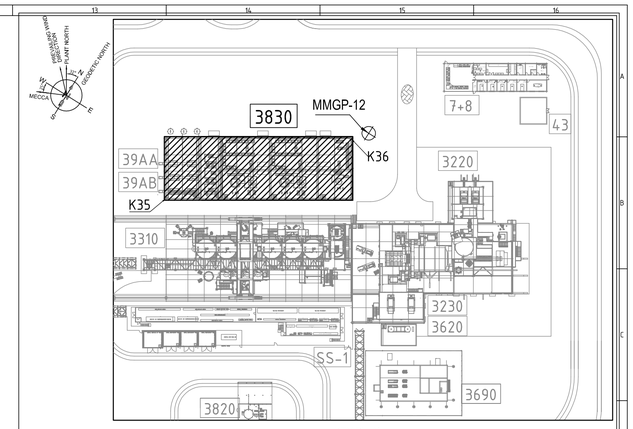

KEY PLAN
(SCALE- 1:750)

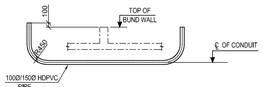

TYPICAL DETAIL OF CONDUIT
SCALE 1:50

SCHEDULE OF CONDUIT

CONDUIT MKD.	ELEVATION AT Ç OF CONDUIT
LV_HDPVC_001	RL 912.770
LV_HDPVC_002	RL 912.770
CI_HDPVC_003	RL 912.770
CI_HDPVC_004	RL 912.950
LV_HDPVC_005	RL 912.950
LV_HDPVC_006	RL 912.950
LV_HDPVC_006	RL 912.435
LV_HDPVC_007	RL 912.435
LV_HDPVC_008	RL 912.435
LV_HDPVC_009	RL 912.435
LV_HDPVC_010	RL 912.435
LV_HDPVC_012	RL 912.435
LV_HDPVC_013	RL 912.435
LV_HDPVC_014	RL 912.435
LV_HDPVC_015	RL 912.435
LV_HDPVC_016	RL 912.435
LV_HDPVC_017	RL 912.435
LV_HDPVC_018	RL 912.435
LV_HDPVC_019	RL 912.435
LV_HDPVC_020	RL 912.435
LV_HDPVC_021	RL 912.435
CI_HDPVC_022	RL 912.435
LV_HDPVC_023	RL 912.435
LV_HDPVC_024	RL 912.435
LV_HDPVC_025	RL 912.435
LV_HDPVC_026	RL 912.435
LV_HDPVC_027	RL 912.435

SCHEDULE OF CONDUIT

CONDUIT MKD.	ELEVATION AT Ç OF CONDUIT
LV_HDPVC_028	RL 912.435
CI_HDPVC_029	RL 912.435
LV_HDPVC_030	RL 912.435
LV_HDPVC_031	RL 912.950
LV_HDPVC_032	RL 912.435
LV_HDPVC_033	RL 912.435
LV_HDPVC_034	RL 912.435
LV_HDPVC_035	RL 912.435
LV_HDPVC_036	RL 912.435
LV_HDPVC_037	RL 912.435
LV_HDPVC_038	RL 912.435
LV_HDPVC_039	RL 912.435
LV_HDPVC_040	RL 912.950
CI_HDPVC_041	RL 912.950
LV_HDPVC_042	RL 912.950
CI_HDPVC_043	RL 912.950
LV_HDPVC_044	RL 912.950
CI_HDPVC_045	RL 912.950
LV_HDPVC_046	RL 912.950
CI_HDPVC_047	RL 912.950
LV_HDPVC_048	RL 912.950
CI_HDPVC_049	RL 912.950
LV_HDPVC_050	RL 912.950
LV_HDPVC_051	RL 912.950
LV_HDPVC_052	RL 912.950
LV_HDPVC_052	RL 912.950

LEGEND :-
R.L. - REDUCED LEVEL
I.L. - INVERT LEVEL
Ç - CENTRE LINE
Ø - DIAMETER
R - RADIUS
MKD. - MARKED

NOTES:-
1. ALL DIMENSIONS ARE IN MILLIMETRES AND LEVELS AND CO-ORDINATES ARE IN METRES UNLESS OTHERWISE STATED.
2. THIS DRAWING IS TO BE READ IN CONJUNCTION WITH DRAWING NO- MD-216-3830-EG-CV-GAD-1421.

DOCUMENT NUMBER	REFERENCE DOCUMENTS	REV	DATE	REVISION DESCRIPTION	DRN	CHK	ENG	APP	EMP
MD-216-3830-EG-CV-GAD-1421	REAGENTS-GA & DETAILS OF GRADE SLAB								
MD-216-3830-EG-CV-GAD-1420	REAGENTS-FLOTATION REAGENTS BLDG. GA & DET. OF FDN.								
MD-216-3830-EG-CV-GAD-1419	REAGENTS-FLOTATION REAGENTS BLDG. GA & DET. OF FDN.								
MD-216-3830-EG-CV-GAD-1417	REAGENTS-FDN. DETAILS FOR 3830-TNK-001,002, 3830-REA-001								
MD-216-3830-EG-CV-GAD-1416	REAGENTS-FDN. DETAILS FOR 3830-TNK-003, 3830-REA-002								
MD-216-3830-EG-EL-LAD-1006	REAGENTS-FLOTATION CABLE ROUTE LAYOUT-EMBEDDED PART								

DOCUMENT NUMBER	REFERENCE DOCUMENTS	REV	DATE	REVISION DESCRIPTION	DRN	CHK	ENG	APP	EMP
		D01	03/07/2023	AS - BUILT	SYA	SJM	SOR	AG	
		C01	20/04/2021	ISSUED FOR CONSTRUCTION & REVISED AS PER EMPLOYER COMMENTS ON 06/04/2021	SYA	SJM	SOR	AG	
		A01	20/03/2021	ISSUED FOR REVIEW	SYA	SJM	SOR	AG	

RESERVED FOR VENDOR LOGO AND DRAWING NUMBER

LARSEN & TOUBRO

This drawing is the property of LARSEN & TOUBRO and must not be passed on to any person or body not authorised by us to receive it nor be copied or otherwise made use either in full or in part by such person or body without our prior permission in writing.

Outotec

The content of these documents are the sole property of Outotec Oyj. Any rights not expressly granted herein are reserved. Reproduction, transfer or distribution of part or all of the contents in any form without prior written permission of Outotec is prohibited.

MA'ADEN معادن
Saudi Arabian Mining Company شركة معادن العربية السعودية

This document and the information contained herein is Ma'aden proprietary know-how. This document or any part thereof should not be reproduced, stored in a retrieval system or transmitted by any means, electronic or otherwise, or divulged without prior written permission of Ma'aden.

LARSEN & TOUBRO DRAWING NUMBER: 019045_450_C_G_24562_002 — REVISION: 2
OUTOTEC DRAWING NUMBER: 900707 __ GAU01 __ AA02_ MTL01 __38334 — DOCUMENT ID: OU100704163 — REVISION: 2

DRAWN	SYA	18/03/2021
CHECKED	SJM	19/03/2021
ENGINEER	SOR	18/03/2021
APPROVED	AG	20/03/2021
EMPLOYER		
SCALE	1:100, 1:50	A0

MANSOURAH - MASSARAH GOLD PROJECT
GENERAL ARRANGEMENT DRAWING
REAGENTS - FLOTATION REAGENTS EQUIPMENT
LAYOUT & DETAIL OF EMBEDDED CONDUITS

DRAWING NUMBER: MD - 216 - 3830 - EG - CV - GAD - 1422 — REV: D01

MA'ADEN معادن
Saudi Arabian Mining Company شركة التعدين العربية السعودية

Mansourah Massarah Gold Project
Comment Resolution Log Sheet / Compliance Report

Outotec
LARSEN & TOUBRO

PROJECT: MANSOURAH MASSARAH GOLD PROJECT **PROJECT NO.: 216**

STAGE: 4 - PROJECT EXECUTION. **REVIEW LOG DOC. NO. & REV.:**

ACONEX REF. NO. & DATE: BECHTEL-WTRAN-010167, 19 April 2021

STATUS CODE: A - APPROVED, C - APPROVED WITH COMMENTS, R - REVISE & RESUBMIT & O - OTHERS (INFORMATION, REFERENCE, REVIEWED)

DOCUMENT NUMBER	Area / Title	Comment No.	PMC/PMT COMMENT DATE: 19 April 2021	Comment by	EPC Response DATE: 20 April 2021	Status	Remarks
			General Comments (cc)				
MD-216-3830-EG-CV-GAD-1422-A01	3830	1	Please add reference drawings for foundation and slab	Mr. Doron Golan Bechtel	Reference drawing nos. incorporated	Closed	
MD-216-3830-EG-CV-GAD-1422-A01	3830	2	for foundation details, refer to drawing numbers MD-216-3830-EG-CV-GAD-1416~1420	Mr. Doron Golan Bechtel	Stated drawing nos. mentioned	Closed	
MD-216-3830-EG-CV-GAD-1422-A01	3830	3	for grade slab details, refer drawing number MD-216-3830-EG-CV-GAD-1421	Mr. Doron Golan Bechtel	Stated drawing nos. mentioned	Closed	