MD - 216 - 6000 - EG - CV - GAD - 1533
DRAWING NUMBER
D01
REV

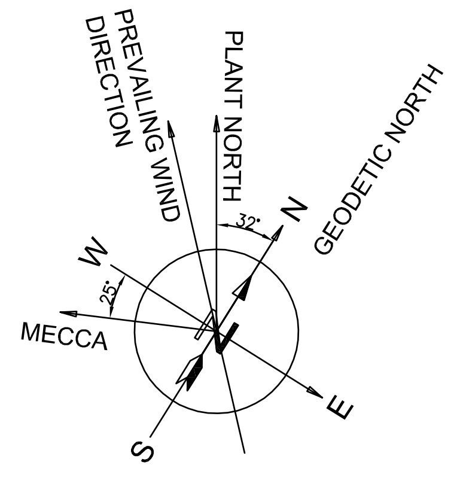

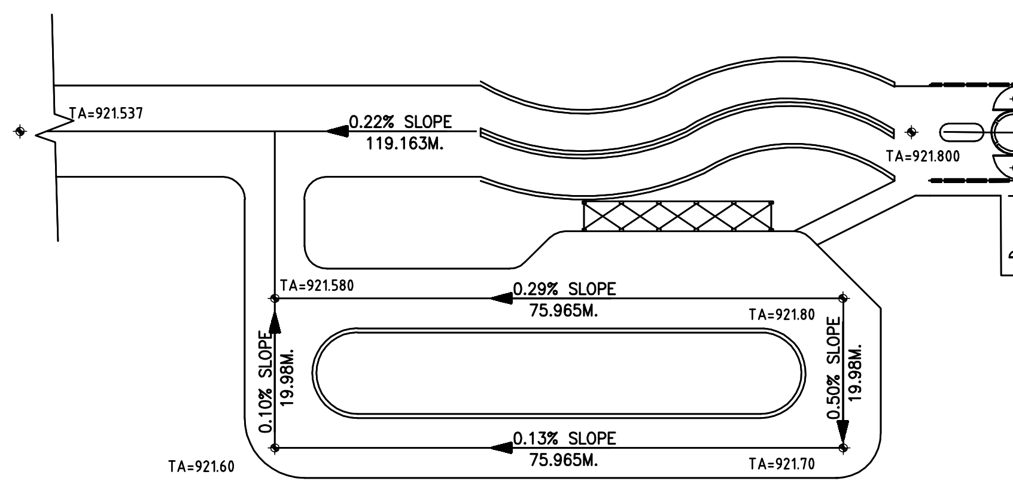

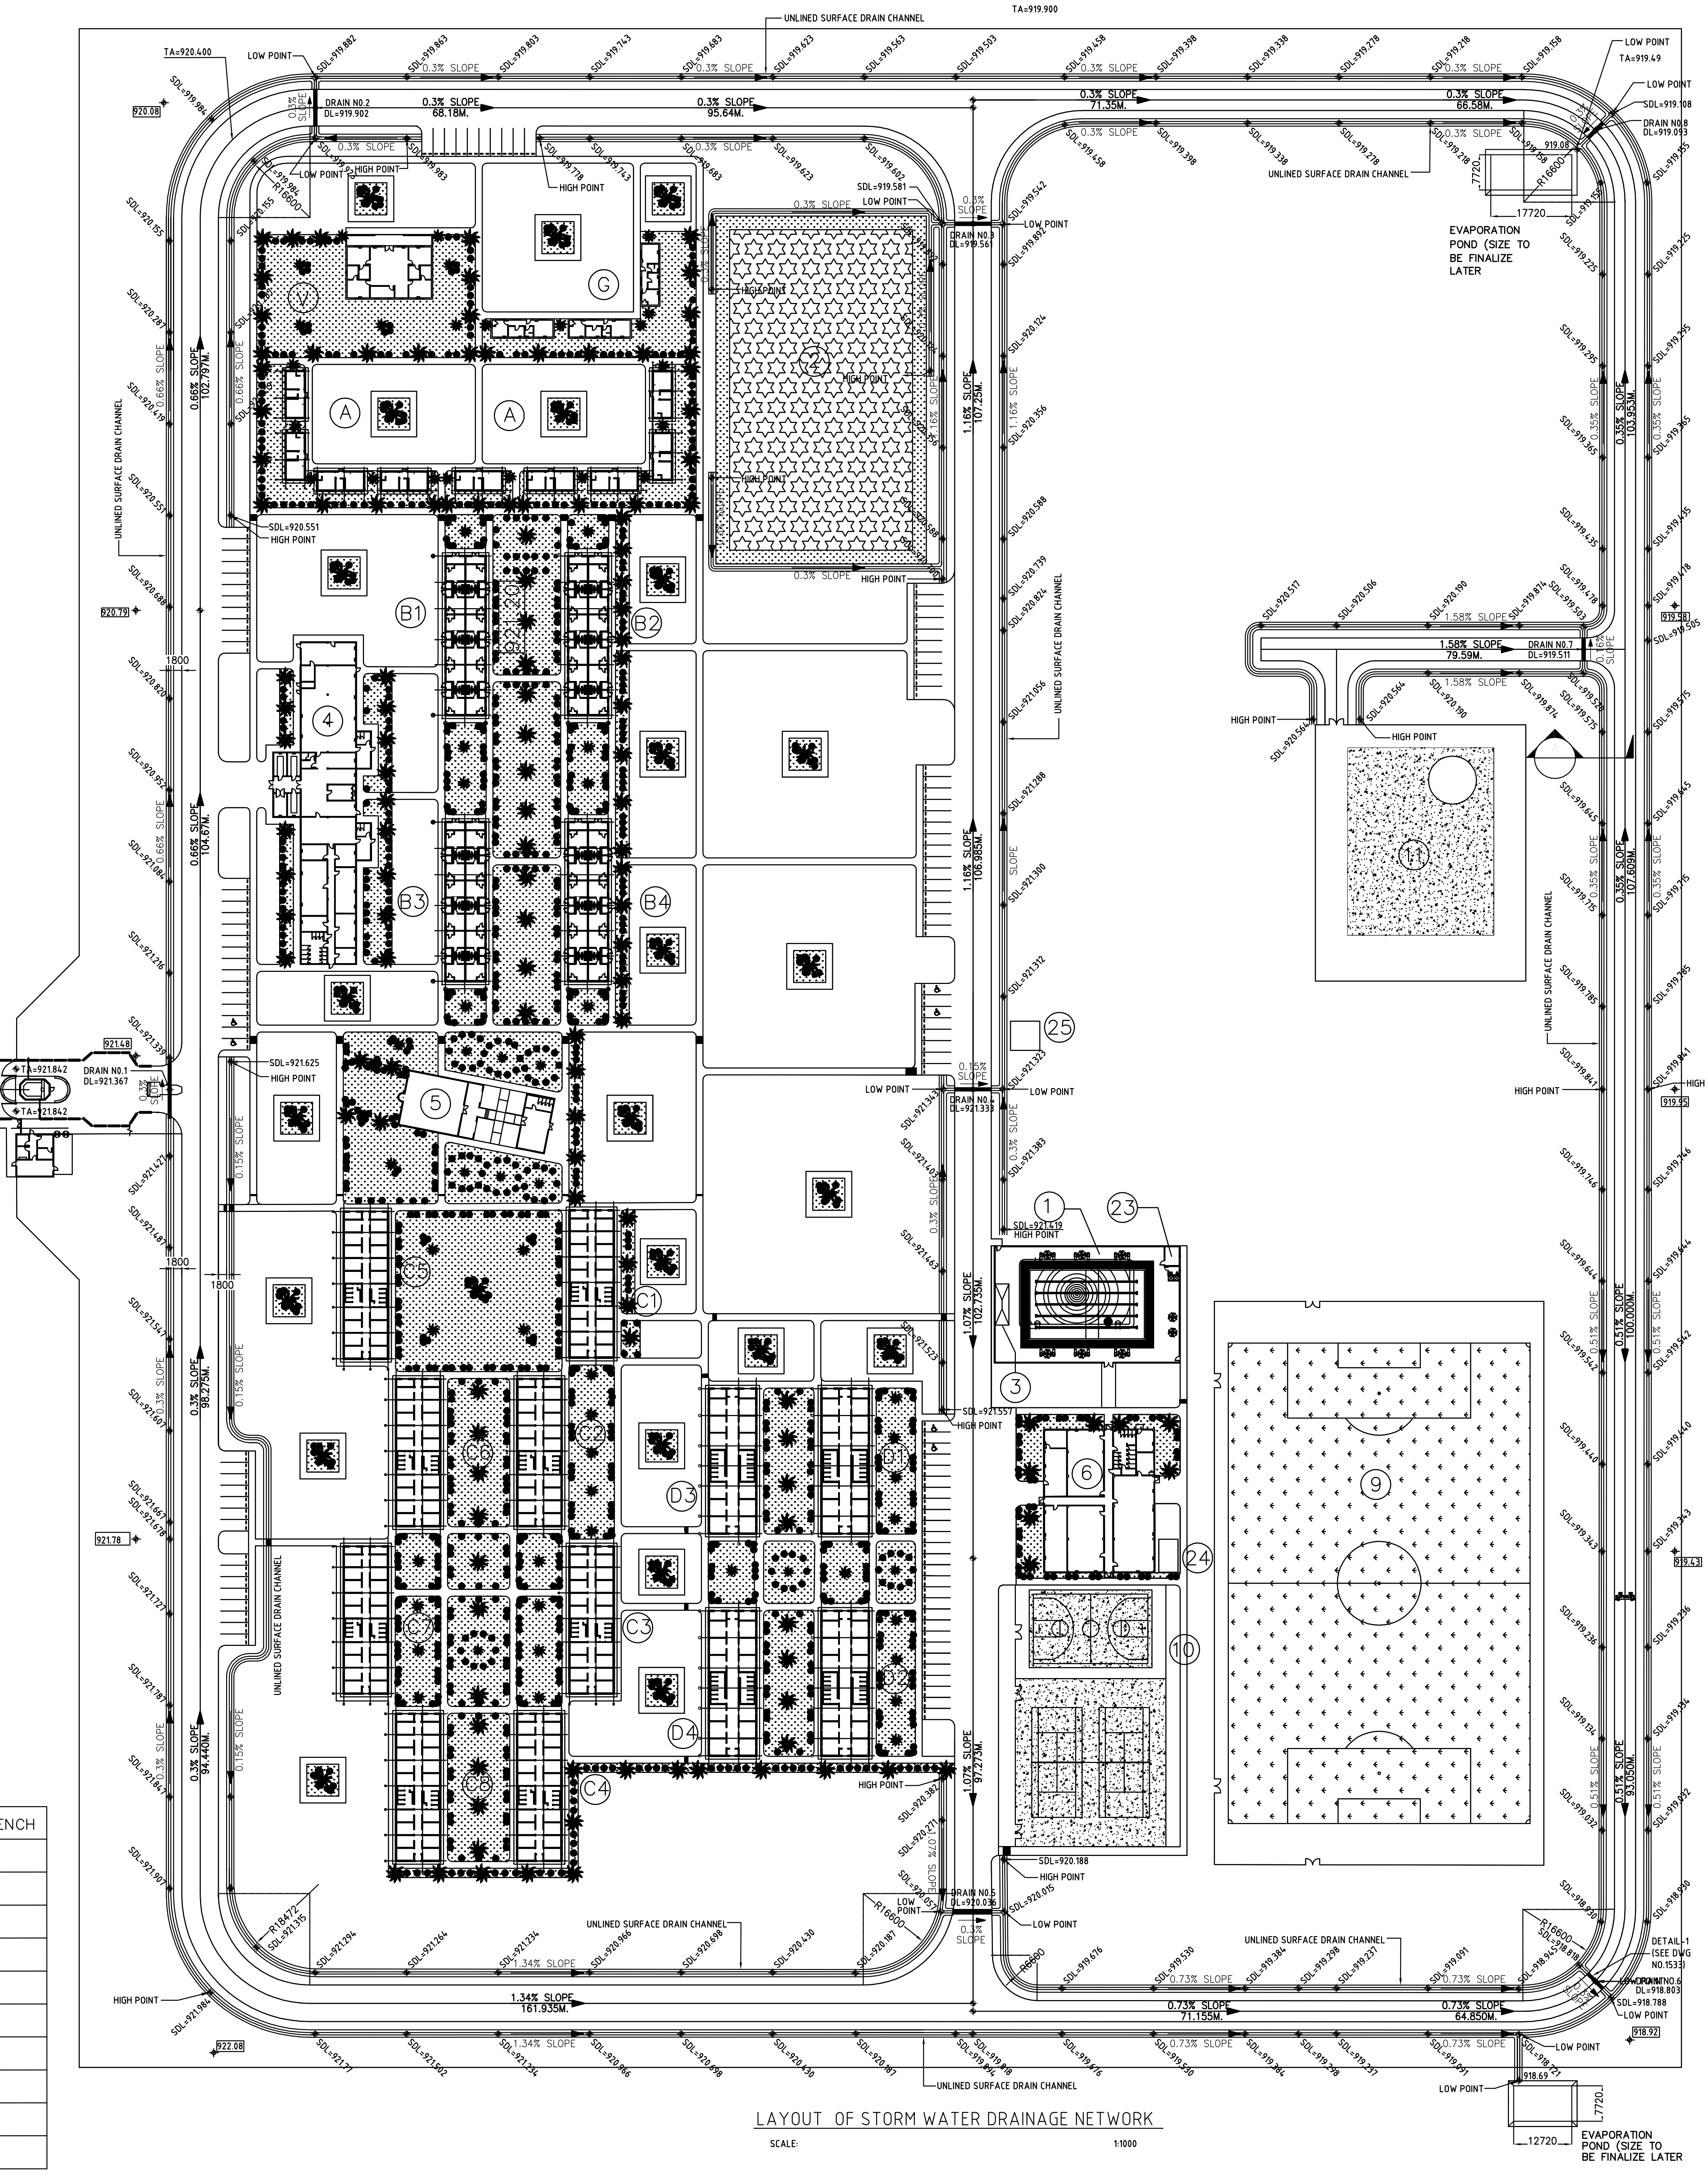

LAYOUT OF STORM WATER DRAINAGE NETWORK
SCALE: 1:1000

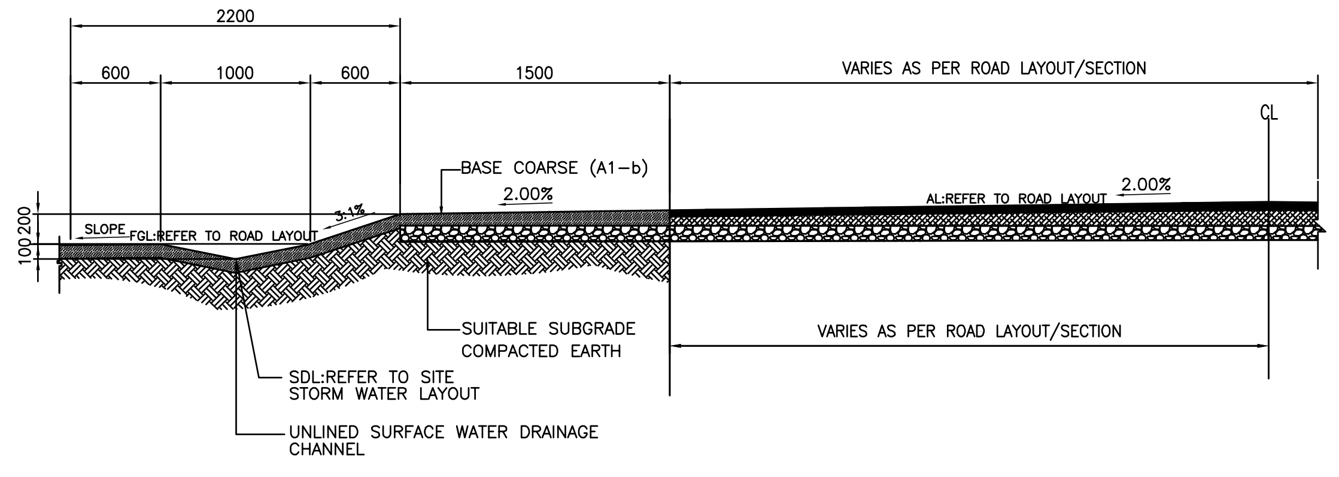
2200
600
1000
600
1500
VARIES AS PER ROAD LAYOUT/SECTION
CL
BASE COARSE (A1-b)
2.00%
SLOPE
FGL:REFER TO ROAD LAYOUT
3.1%
AL:REFER TO ROAD LAYOUT
2.00%
100
200
SUITABLE SUBGRADE COMPACTED EARTH
SDL:REFER TO SITE STORM WATER LAYOUT
UNLINED SURFACE WATER DRAINAGE CHANNEL
VARIES AS PER ROAD LAYOUT/SECTION

TYPICAL SURFACE DRAIN WATER SECTION-A
SCALE 1:50

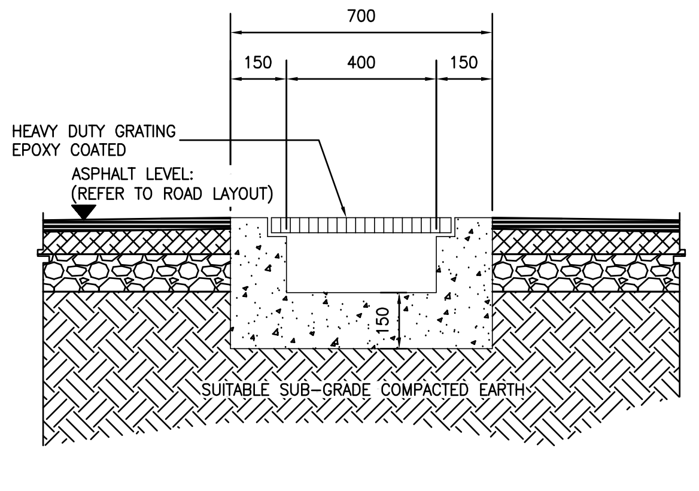
700
150
400
150
HEAVY DUTY GRATING EPOXY COATED
ASPHALT LEVEL: (REFER TO ROAD LAYOUT)
150
SUITABLE SUB-GRADE COMPACTED EARTH

TRENCH TYPICAL DETAIL-1 SECTION
SCALE 1:20

LEGEND:-

‒ ‒ ‒	ROAD CENTRELINE
—×—	FENCE
000.00	FINISHED GROUND LEVEL(FGL)
TA=000.00	TOP OF ASPHALT
N 2508261.799 E 263293.131	ROAD/CURB COORDINATES
▤	SURFACE DRAIN
SDL=000.00	SURFACE DRAIN TOP LEVEL
0.73% SLOPE	SURFACE DRAIN SLOPE
0.73% SLOPE 71.155M.	ROAD ASPHALT SLOPE
AL	ASPHALT LEVEL
FGL	FINISHED GROUND LEVEL
SDL	SURFACE DRAIN LEVEL
CL	ROAD CENTER LINE

NOTES:-

1. ALL DIMENSIONS ARE IN MILLIMETRES UNLESS OTHERWISE NOTED.
2. ALL CO-ORDINATES ARE IN METRES.

SN.	DESCRIPTION	SLOPE IN %	SURFACE DRAIN LEVEL OF TRENCH
1	DRAIN NO.1	0.30	921.367
2	DRAIN NO.2	0.30	919.902
3	DRAIN NO.3	0.30	919.561
4	DRAIN NO.4	0.15	921.333
5	DRAIN NO.5	0.30	920.036
6	DRAIN NO.6	0.30	918.083
7	EVAPORATION POND	–	918.69
8	DRAIN NO.7	0.16	919.511
9	DRAIN NO.8	0.30	919.093
10	EVAPORATION POND	–	919.08

DOCUMENT NUMBER	REFERENCE DOCUMENTS	REV	DATE	REVISION DESCRIPTION	DRN	CHK	ENG	APP	EMP
		D01	22/05/2023	AS-BUILT	-	AVG	-	SJM	-
		C01	20/06/2020	ISSUED FOR CONSTRUCTION	-	AVG	-	SJM	-
MD-216-6000-EG-CV-GAD-1533	OVERALL LAYOUT PLAN	A01	25/05/2020	ISSUED FOR APPROVAL	-	AVG	-	SJM	-

DESIGNER:
مكتب الخليج للاستشارات الهندسة
الخبر، المملكة العربية السعودية
GULF CONSULT
ARCHITECTS AND ENGINEERS

DRAWING NUMBER						REVISION
CIVIL-PAV-031						0
DATE	19/05/2020	DATE	20/05/2020	DATE	21/05/2020	
DRAWN	RAN	CHECKED	NILO	APPROVED	SHAU	

LARSEN & TOUBRO DRAWING NUMBER: 019045_910_C_G_24238_001 — REVISION 2
OUTOTEC DRAWING NUMBER: 900707 __GAU01 __AN03 __MTL01 __60076 — DOCUMENT ID: OU100676792 — REVISION 2

LARSEN & TOUBRO

This drawing is the property of LARSEN & TOUBRO and must not be passed on to any person or body not authorized by us to receive it nor be copied or otherwise made use either in full or in part by such person or body without our prior permission in writing.

Outotec

The content of these documents are the sole property of Outotec Oyj. Any rights not expressly granted herein are reserved. Reproduction, transfer or distribution of part or all of the contents in any form without prior written permission of Outotec is prohibited.

MA'ADEN معادن
Saudi Arabian Mining Company شركة التعدين العربية السعودية

This document and the information contained herein is Ma'aden proprietary know-how. This document or any part thereof should not be reproduced, stored in a retrieval system or transmitted by any means, electronic or otherwise, or divulged without prior written permission of Ma'aden.

DRAWN	-	-
CHECKED	AVG	22/05/2020
ENGINEER	-	-
APPROVED	SJM	25/05/2020
EMPLOYER		
SCALE	1:1000	A1

MANSOURAH - MASSARAH GOLD PROJECT
GENERAL ARRANGEMENT DRAWING
PERMANENT ACCOMMODATION VILLAGE
LAYOUT & DETAILS OF STORM WATER DRAINAGE NETWORK

DRAWING NUMBER: MD - 216 - 6000 - EG - CV - GAD - 1533
REV: D01