

DRAWING NUMBER MD-216-6000-EG-CV-GAD-1534 REV D01

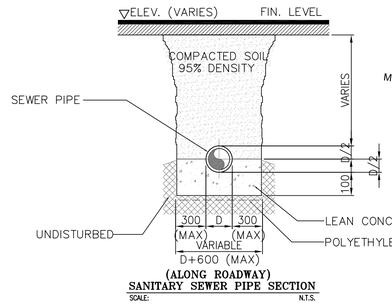



(ALONG ROADWAY) SANITARY SEWER PIPE SECTION
SCALE: N.T.S.

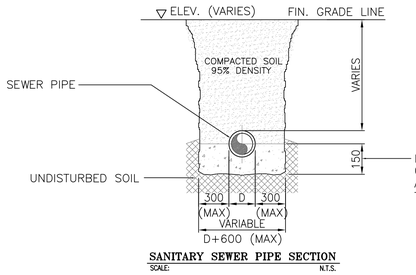

SANITARY SEWER PIPE SECTION
SCALE: N.T.S.

DETAIL OF SANITARY SEWER LINE BELOW GROUND LEVEL
SCALE: N.T.S.

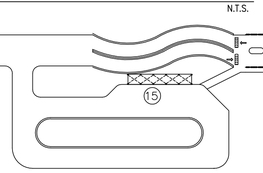

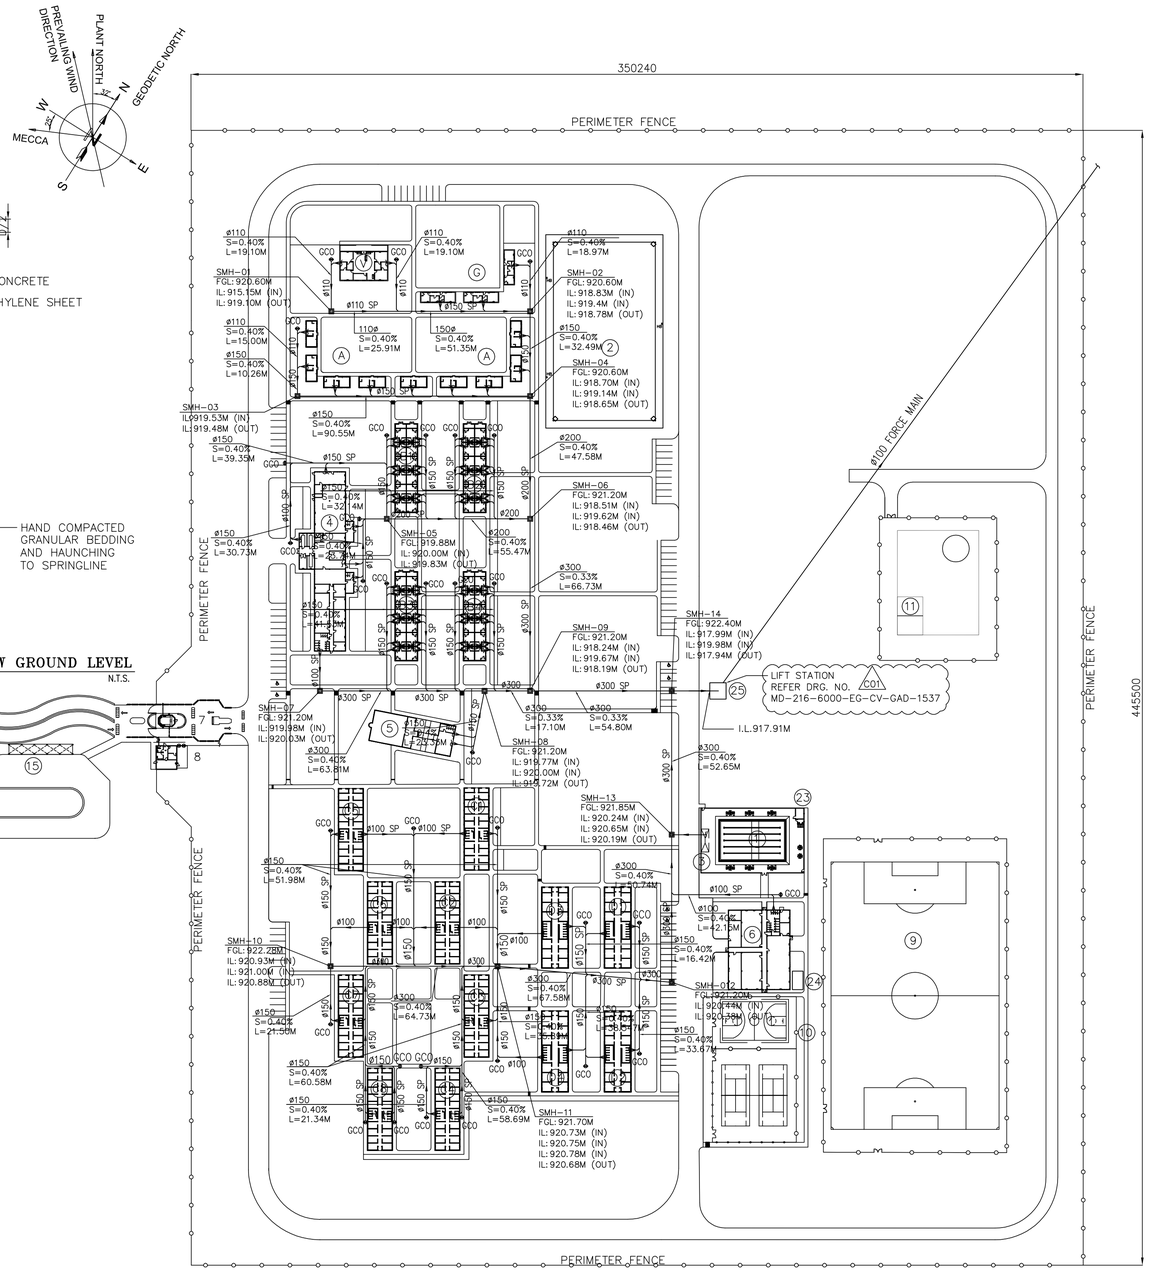

LAYOUT OF SEWERAGE NETWORK
SCALE: 1:1200

SEWER MANHOLE SCHEDULE								
MANHOLE NO.	GROUND LEVEL	PIPE LENGHT (M)	PIPE DIAMETER (MM)	INVERT LEVEL				MANHOLE DEPTH (M)	MANHOLE SIZE
				INLET 1	INLET 2	INLET 3	OUTLET		
SMH-01	920.60	25.91	110.0	919.15	–	–	919.10	1.50	800x800
SMH-02	920.60	51.35	150.0	–	919.40	918.83	918.78	1.82	800x800
SMH-03	920.76	00.0	110.0	919.53	–	–	919.48	1.28	800x800
SMH-04	920.60	90.55	150.0	–	918.70	919.14	918.65	1.95	800x800
SMH-05	921.20	00.0	150.0	919.88	920.00	–	919.83	1.37	800x800
SMH-06	921.20	55.45	200.0	–	918.51	919.62	918.46	2.74	800x800
SMH-07	921.20	00.0	110.0	920.03	–	–	919.98	1.22	800x800
SMH-08	921.20	63.81	300.0	–	919.77	920.00	919.72	1.48	800x800
SMH-09	921.20	17.10	300.0	918.24	919.67	–	918.19	3.01	800x800
SMH-10	922.28	00.0	150.0	920.93	–	921.00	920.88	1.40	800x800
SMH-11	921.70	64.73	300.0	920.78	920.73	920.75	920.68	1.02	800x800
SMH-12	921.30	67.58	300.0	920.44	–	–	920.38	0.92	800x800
SMH-13	921.85	50.74	300.0	–	920.24	920.65	920.19	1.66	800x800
SMH-14	922.40	52.65	300.0	–	917.99	919.98	917.94	4.46	800x800
LIFT STATION	922.37	8.2	300.0	–	917.91	–	–	–	

NOTES:

1. ALL DIMENSIONS ARE IN MILLIMETRES UNLESS OTHERWISE NOTED.
2. ALL CO-ORDINATES ARE IN METRES.
3. INLETS NOZZLES 1, 2 & 3 ARE 90°, 180° AND 270° WITH THE OUTLET NOZZLE RESPECTIVELY.
4. THE LOWEST INLET NOZZLE SHALL BE 50MM HIGHER THAN THE OUTLET NOZZLE.
5. THIS DRAWING SHALL BE READ IN CONJUNCTION WITH OVERALL LAYOUT DRAWING NO.-MD-216-6000-EG-CV-GAD-1535

LEGEND:

	SEWER MANHOLE
	GROUND CLEANOUT
	SEWER PIPELINE
GCO	GROUND CLEANOUT
SMH	SEWER MANHOLE
SP	SEWER PIPE
I.E.	INVERT ELEVATION

DOCUMENT NUMBER	REFERENCE DOCUMENTS	REV	DATE	REVISION DESCRIPTION	DRN	CHK	ENG	APP	EMP
		D01	22/05/2023	AS-BUILT	- -	AVG	- -	SJM	
		C01	20/06/2020	ISSUED FOR CONSTRUCTION AND REVISED AS PER EMPLOYER COMMENTS ON 19.06.2020.	- -	AVG	- -	SJM	
MD-216-6000-EG-CV-GAD-1535	OVERALL LAYOUT	A01	25/05/2020	ISSUED FOR APPROVAL	- -	AVG	- -	SJM	

مكتب الخليج للاستشارات الهندسية
الغير المنلكة العربية السعودية

GULF CONSULT
ARCHITECTS AND ENGINEERS

DRAWING NUMBER					REVISION
ME-PAV-SS-PL-001					0
DATE	19/5/2020	DATE	20/5/2020	DATE	21/5/2020
DRAWN	RAFI	CHECKED	NILO	APPROVED	SHAU

LARSEN & TOUBRO DRAWING NUMBER		REVISION
019045_910_C_G_24239_001		2
OUTOTEC DRAWING NUMBER	DOCUMENT ID	REVISION
900707 _GAU01 _AN03_MTL01 _60077	OU100676793	2

LARSEN & TOUBRO

This drawing is the property of LARSEN & TOUBRO and must not be passed on to any person or body not authorized by us to receive it nor be copied or otherwise made use either in full or in part by such person or body without our prior permission in writing.

Outotec

The content of these documents are the sole property of Outotec Oyj. Any rights not expressly granted herein are reserved. Reproduction, transfer or distribution of part or all of the contents in any form without prior written permission of Outotec is prohibited.

MA'ADEN معادن
Saudi Arabian Mining Company شركة التعدين العربية السعودية

This document and the information contained herein is Ma'aden proprietary know-how. This document or any part thereof should not be reproduced, stored in a retrieval system or transmitted by any means, electronic or otherwise, or divulged without prior written permission of Ma'aden.

DRAWN			
CHECKED	AVG	22/05/2020	
ENGINEER			
APPROVED	SJM	25/05/2020	
EMPLOYER			
SCALE	1:1200	A1	

MANSOURAH - MASSARAH GOLD PROJECT
GENERAL ARRANGEMENT DRAWING
PERMANENT ACCOMMODATION VILLAGE
LAYOUT & DETAILS OF SEWERAGE NETWORK

DRAWING NUMBER	REV
MD-216-6000-EG-CV-GAD-1534	D01