

DRAWING NUMBER MD-216-6000-EG-CV-GAD-1537 REV D01

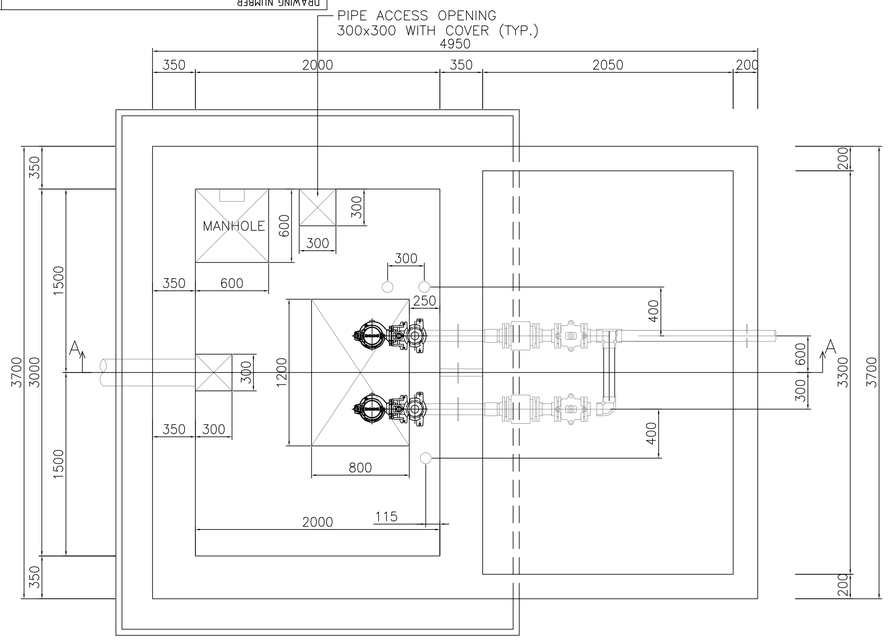

FOUNDATION LAYOUT
SCALE 1:50

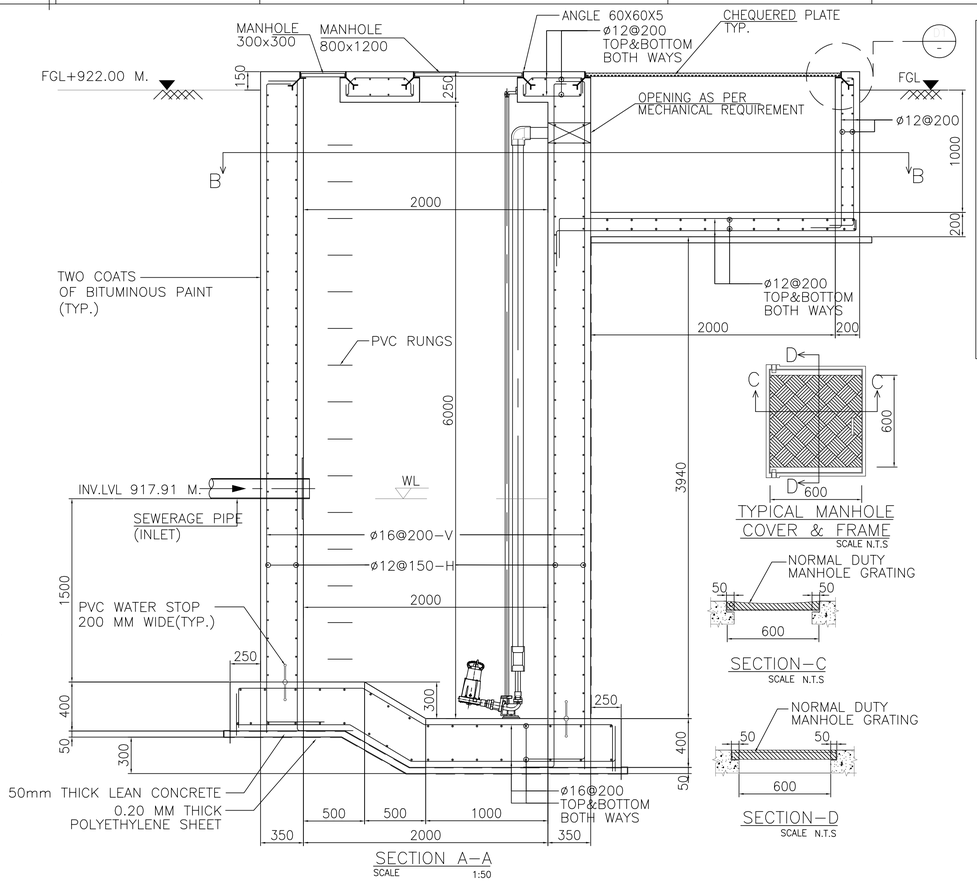


SECTION A–A
SCALE 1:50

TYPICAL MANHOLE COVER & FRAME
SCALE N.T.S

SECTION–C
SCALE N.T.S

SECTION–D
SCALE N.T.S

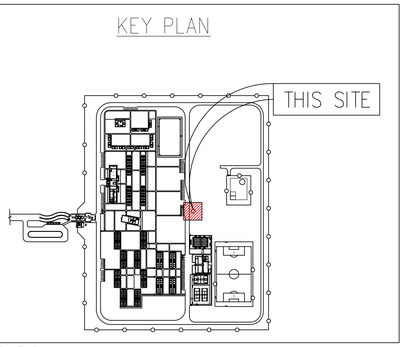


LEGENDS

TYP.	– TYPICAL
INV. LVL.	– INVERT LEVEL
FGL	– FINISH GRADE LEVEL
WL	– WATER LEVEL
H	–HORIZONTAL
V	–VERTICAL
ø	–DIAMETER
PVC	–POLYVINYL CHLORIDE
N.T.S	–NOT TO SCALE
REIN.	–REINFORCEMENT
DWG.	–DRAWING


BOTTOM REINFORCEMENT ———
TOP REINFORCEMENT - - - - - -

NOTES


1. ALL DIMENSIONS ARE IN MILLIMETRES AND LEVELS AND CO–ORDINATES ARE IN METRES UNLESS OTHERWISE NOTED.
2. THE MATERIAL FOR WASTE WATER FORCE MAIN LINES AS INDICATED ON THE DRAWING SHALL BE RTRP.
3. THRUST BLOCKS SHALL BE PROVIDED ON BENDS, TEES, ELBOWS OR AT EVERY CHANGE IN DIRECTION FOR ALL PRESSURE MAINS. THRUST BLOCKS SHALL BE AS PER DETAIL ON SEPARATE DWG.
4. TEMPORARY WOODEN SUPPORTS SHALL BE PROVIDED AT EVERY CHANGE OF DIRECTION PRIOR TO HYDRO TESTING.
5. CONTRACTOR SHALL VERIFY THE ACTUAL LOCATION AND SIZE OF INTERFACES AND PROVIDE ALL NECESSARY MATERIALS FOR MAKING THE CONNECTIONS.
6. FOR PUMPS : ONE DUTY/ ONE STANDBY.
   LIFT STATION SHALL HAVE ODOR CONTROL SYSTEM

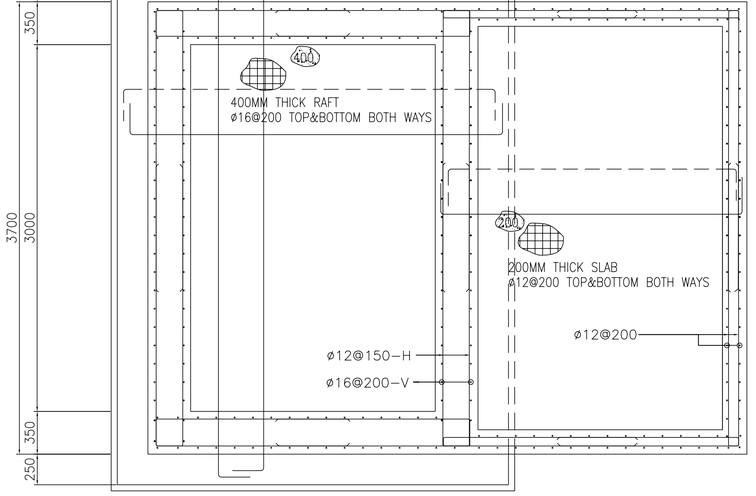


SECTION B–B
SCALE 1:50

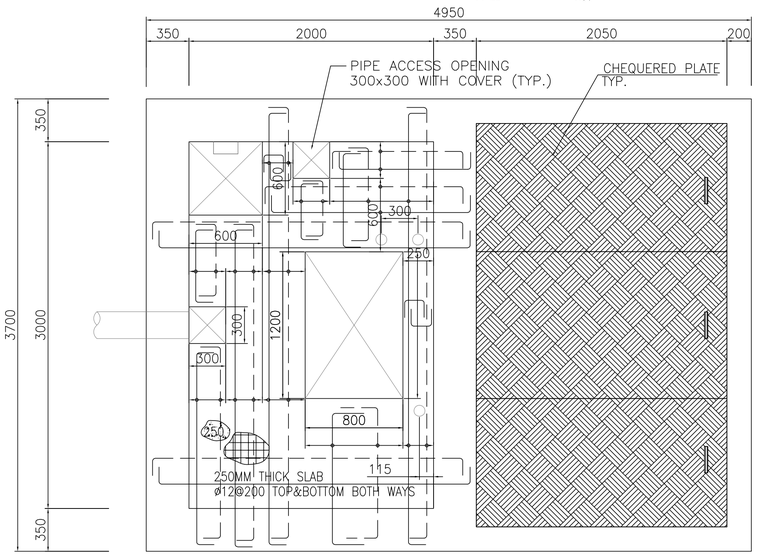


ROOF PLAN
SCALE 1:50

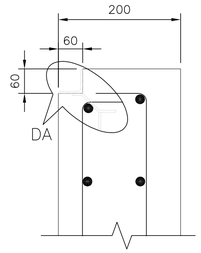

DETAIL–D1
SCALE N.T.S

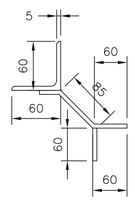

DETAIL–DA

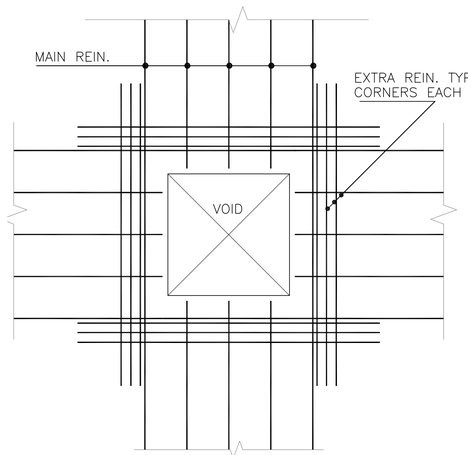

NOTE: EXTRA REINFORCEMENT SHOULD BE SAME SIZE AS MAIN REINFORCEMENT

TYP. EDGE SLAB OPENING REIN. DETAILS
SCALE: NTS

DOCUMENT NUMBER	REFERENCE DOCUMENTS	REV	DATE	REVISION DESCRIPTION	DRN	CHK	ENG	APP	EMP
		D01	23/05/2023	AS-BUILT	-	AVG	-	SJM	
		C01	02/12/2020	ISSUED FOR CONSTRUCTION	-	AVG	-	SJM	
MD-216-6000-EG-CV-GAD-1534	LAYOUT & DETAILS OF SEWERAGE NETWORK	A01	07/10/2020	ISSUED FOR APPROVAL	-	AVG	-	SJM	

مكتب الخليج للاستشارات الهندسية
GULF CONSULT
ARCHITECTS AND ENGINEERS

LARSEN & TOUBRO

This drawing is the property of LARSEN & TOUBRO and must not be passed on to any person or body not authorized by us to receive it nor be copied or otherwise made use either in full or in part by such person or body without our prior permission in writing.

Outotec

The content of these documents are the sole property of Outotec Oyj. Any rights not expressly granted herein are reserved. Reproduction, transfer or distribution of part or all of the contents in any form without prior written permission of Outotec is prohibited.

MA'ADEN معادن
Saudi Arabian Mining Company شركة التعدين العربية السعودية

This document and the information contained herein is Ma'aden proprietary know-how. This document or any part thereof should not be reproduced, stored in a retrieval system or transmitted by any means, electronic or otherwise, or divulged without prior written permission of Ma'aden.

DRAWING NUMBER	ME-PAV-SS-PL-001-002	REVISION	1
DATE	20/09/2020	DATE	21/09/2020	DATE	22/09/2020
DRAWN	RAFI	CHECKED	NILO	APPROVED	SHAU

LARSEN & TOUBRO DRAWING NUMBER	O19045_910_C_G_24234_003		REVISION 2
OUTOTEC DRAWING NUMBER	900707 _GAU01 _AN03_MTL01 _60079	DOCUMENT ID OU100680966	REVISION 2

DRAWN			
CHECKED	AVG	03/10/2020	
ENGINEER			
APPROVED	SJM	05/10/2020	
EMPLOYER			
SCALE	1:50	A1	

MANSOURAH - MASSARAH GOLD PROJECT
GENERAL ARRANGEMENT DRAWING
PERMANENT ACCOMMODATION VILLAGE
SITE SEWER LIFTING PIT DETAILS

DRAWING NUMBER MD-216-6000-EG-CV-GAD-1537 REV D01