


REV	DRAWING NUMBER
D01	MD-216-49W1-EG-CV-DED-1031

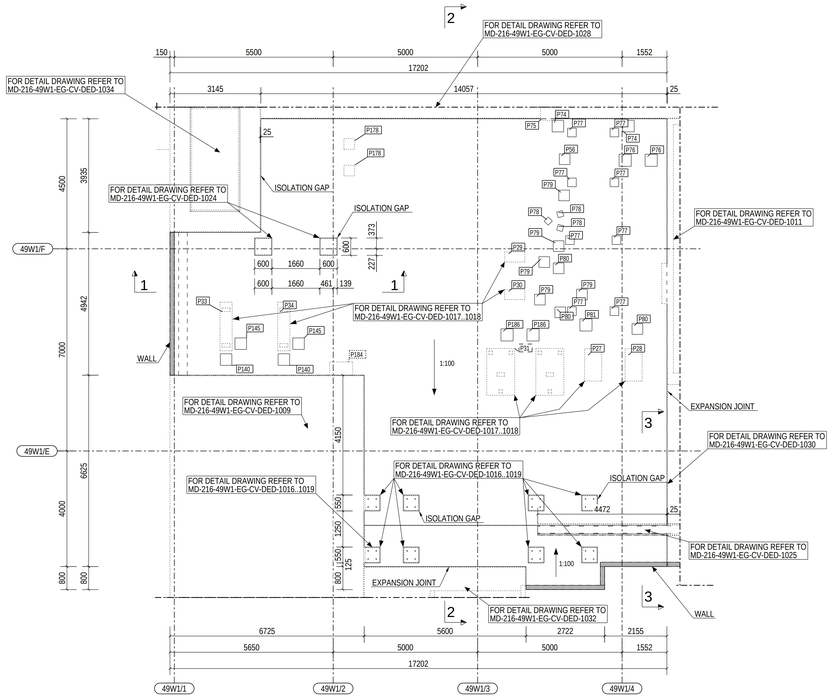


DIMENSION DRAWING
(SCALE 1:75)

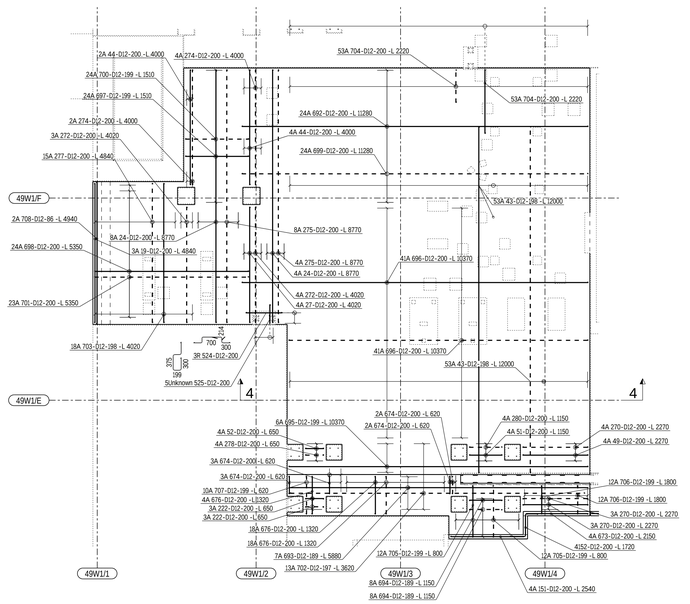


GRADE SLAB (EDGE & STARTER BARS)
(SCALE 1:75)

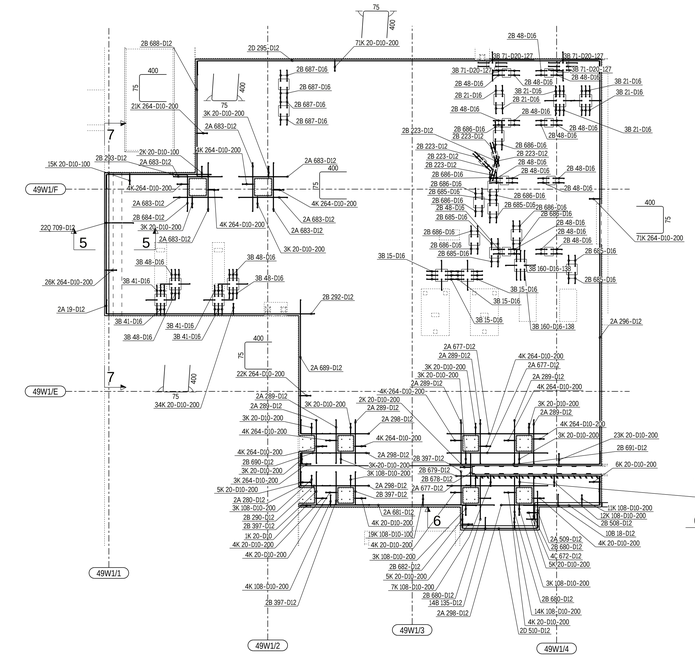


GRADE SLAB (EDGE & STARTER BARS)
(SCALE 1:75)

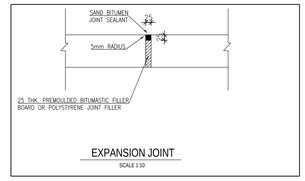

EXPANSION JOINT
SCALE 1:10

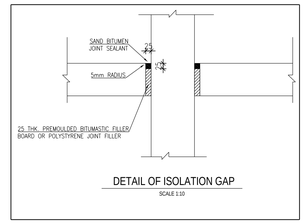


DETAIL OF ISOLATION GAP
SCALE 1:10

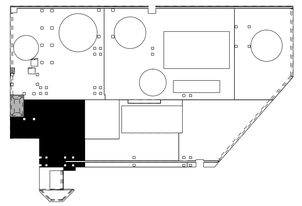


CONCRETE INFORMATION	
Concretes used	C35
Concrete cover 1	50±10mm

LEGEND:
R.L - REDUCED LEVEL
T.O.C. - TOP OF CONCRETE
B.O.F. - BOTTOM OF FOUNDATION
F.G.L. - FINISHED GROUND LEVEL
P.C.C. - PLAIN CEMENT CONCRETE
TYP - TYPICAL
MKD - MARKED
CL - CENTER LINE
BOTTOM REINF. (B)
TOP REINF. (T)
SBC - SAFE BEARING CAPACITY
MIN. - MINIMUM
REF. - REFERED
GA - GENERAL ARRANGEMENT
DWG. - DRAWING
R.C.C. - REINFORCED CEMENT CONCRETE


NOTES:
1. ALL DIMENSIONS ARE IN MILLIMETRES AND LEVELS ARE IN METRES UNLESS OTHERWISE STATED
2. GRADE OF CONCRETE SHALL BE C35 (35MPa) UNLESS NOTED OTHERWISE & C15 (15MPa) FOR BUNDING CONCRETE.
3. GRADE OF REINFORCEMENT SHALL BE DEFORMED BAR ASTM A615-GRADE 60 (fy=420MPa)
4. CLEAR COVER TO MAIN REINFORCEMENT SHALL BE AS FOLLOWS:
a) FOUNDATION: 75 mm (BOTTOM & SIDE)
b) FOUNDATION: 50 mm (TOP)
c) COLUMN & PEDESTAL: 50 mm
5. MINIMUM LAP LENGTHS OF REINFORCEMENT SHALL BE 40XBAR DIAMETER
6. FOR STANDARD REINFORCEMENT DETAILS & GENERAL NOTES FOR CIVIL WORKS REFER TO DRAWING NUMBER MD-216-1000-EG-CV-DED-1005 & 1001
7. ANCHOR BOLTS AND EMBEDDED STEELWORK SHALL BE HOT DIP GALVANIZED
8. T.O.C. & TOP OF SCREED TOLERANCE SHALL BE WITHIN +/- 10MM OF DESIGN LEVEL
9. NET SAFE BEARING CAPACITY OF SOIL AT BOTTOM OF FOUNDATION IS CONSIDERED AS 375 KN/SQ.M.
10. REBARS CAN BE MOVED LOCALLY BY +/- 25mm TO AVOID INTERFERENCE WITH EMBEDDED PARTS

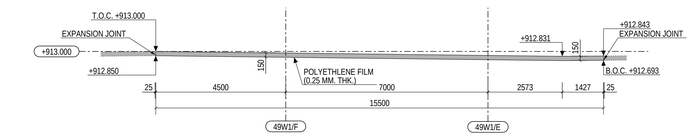


SECTION : 2 - 2
(SCALE 1:75)

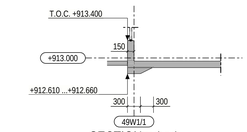


SECTION : 1 - 1
(SCALE 1:50)

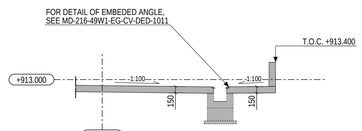


SECTION : 3 - 3
(SCALE 1:50)

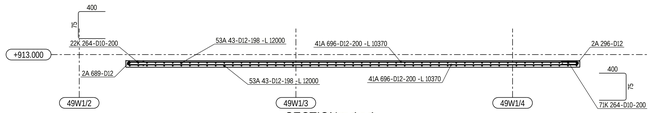


SECTION : 4 - 4
(SCALE 1:50)

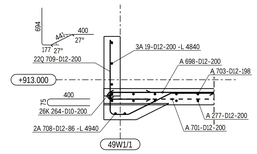

SECTION : 5 - 5
(SCALE 1:20)

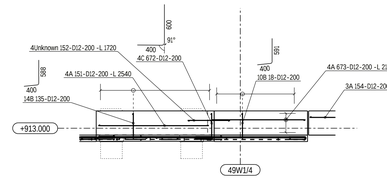


SECTION : 6 - 6
(SCALE 1:50)

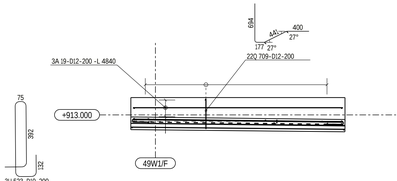

SECTION : 7 - 7
(SCALE 1:50)

KEYPLAN

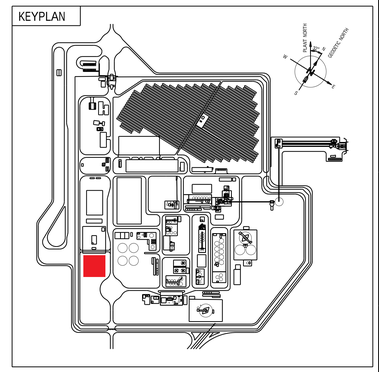

MD-216-49W1-EG-CV-DED-1034	CONTAINER PLATFORM AND STAIRS										
MD-216-49W1-EG-CV-DED-1025	DRAIN CANALS	MD-216-49W1-EG-CV-DED-1032	RAMP								
MD-216-49W1-EG-CV-DED-1018	EQUIPMENT FOUNDATION PUMPS 2	MD-216-49W1-EG-CV-DED-1019	PIPERACK FOUNDATION 2	D01	29.01.2024	AS-BUILT	JonRen	MauNot	NamWu	LuiPiz	
MD-216-49W1-EG-CV-GAD-1003	1-2/1A-E GENERAL ARRANGEMENT DRAWING	MD-216-49W1-EG-CV-DED-1017	EQUIPMENT FOUNDATION PUMPS 1	C01	01.03.2022	ISSUED FOR CONSTRUCTION	JonRen	MauNot	NamWu	LuiPiz	
MD-216-49W1-EG-CV-GAD-1001	1-8/E-J GENERAL ARRANGEMENT DRAWING	MD-216-49W1-EG-CV-GAD-1002	7-12/D-J GENERAL ARRANGEMENT DRAWING	A01	15.02.2022	ISSUED FOR APPROVAL	AbdDus	MauNot	NamWu	LuiPiz	
DOCUMENT NUMBER	REFERENCE DOCUMENTS	DOCUMENT NUMBER	REFERENCE DOCUMENTS	REV	DATE	REVISION DESCRIPTION	DRN	CHK	ENG	APP	EMP

RESERVED FOR VENDOR LOGO AND DRAWING NUMBER

LARSEN & TOUBRO

This drawing is the property of LARSEN & TOUBRO and must not be passed on to any person or body not authorized by us to receive it or be copied or otherwise made use either in full or in part by such person or body without our prior permission in writing.

Outotec

The content of these documents are the sole property of Outotec Oy. Any rights not expressly granted herein are reserved. Reproduction, transfer or distribution of part or all of the contents in any form without prior written permission of Outotec is prohibited.

MA'ADEN معادن
Saudi Arabian Mining Company شركة معادن العربية السعودية

This document and the information contained herein is Ma'aden proprietary know-how. This document or any part thereof should not be reproduced, stored in a retrieval system or transmitted by any means, electronic or otherwise, or divulged without prior written permission of Ma'aden.

LARSEN & TOUBRO DRAWING NUMBER	019045_080_C_D_24892_031
REVISION	2
OUTOTEC DRAWING NUMBER	900707_GAU01_AG11_CTB01_49031
DOCUMENT ID	OU100741885
REVISION	2

DRAWN	AbdDus	15.02.2022
CHECKED	MauNot	15.02.2022
ENGINEER	NamWu	15.02.2022
APPROVED	LuiPiz	15.02.2022
EMPLOYER		
SCALE	1:75	A0

MANSOURAH - MASSARAH GOLD PROJECT
49W1 RAW WATER TREATMENT PLANT
SLAB SECTOR GL D-G/1-4
DETAIL AND REINFORCEMENT DRAWING

DRAWING NUMBER: MD-216-49W1-EG-CV-DED-1031
REV: D01

Tekla Structures