DRAWING NUMBER MD-216-49W1-EG-CV-DED-1033 REV D01

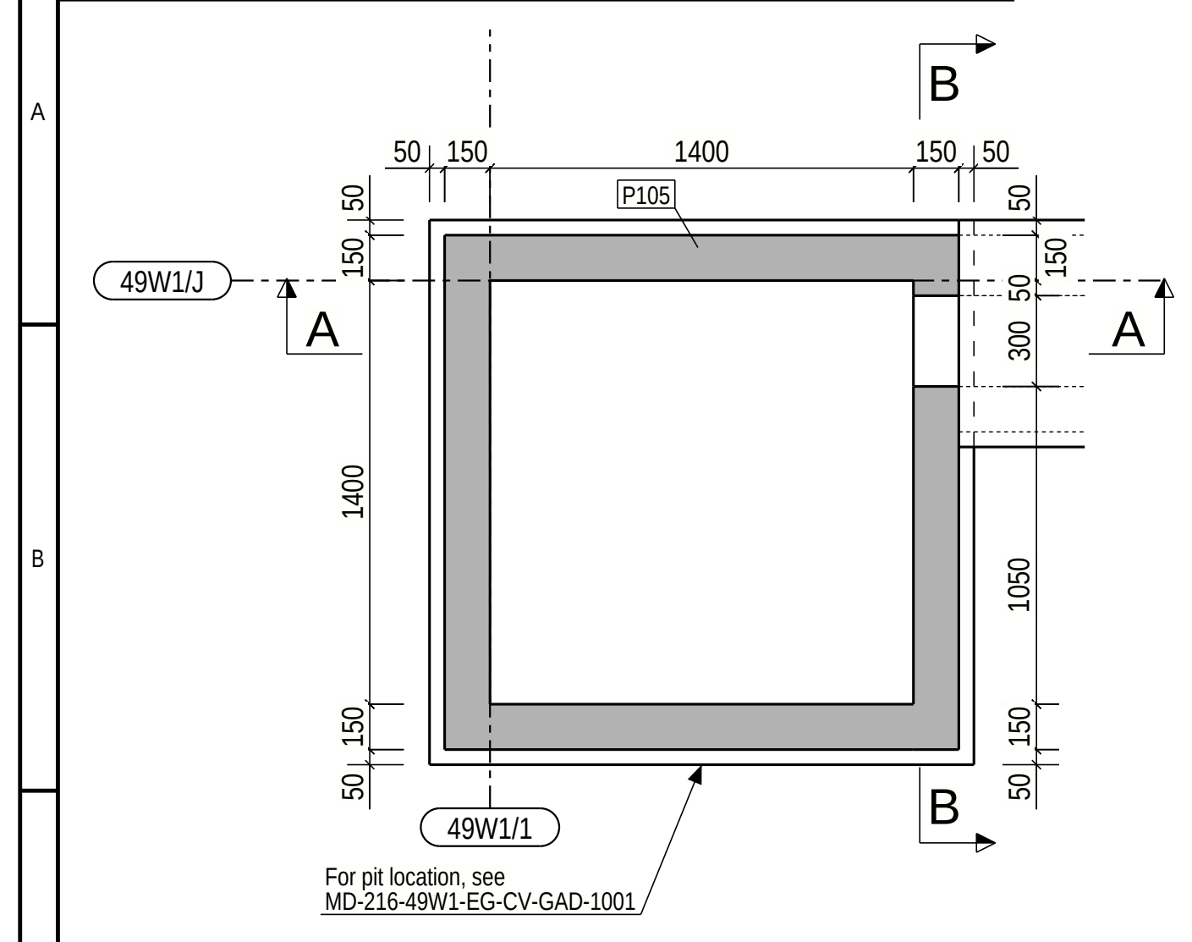

PIT P105 DIMENSION
1:25

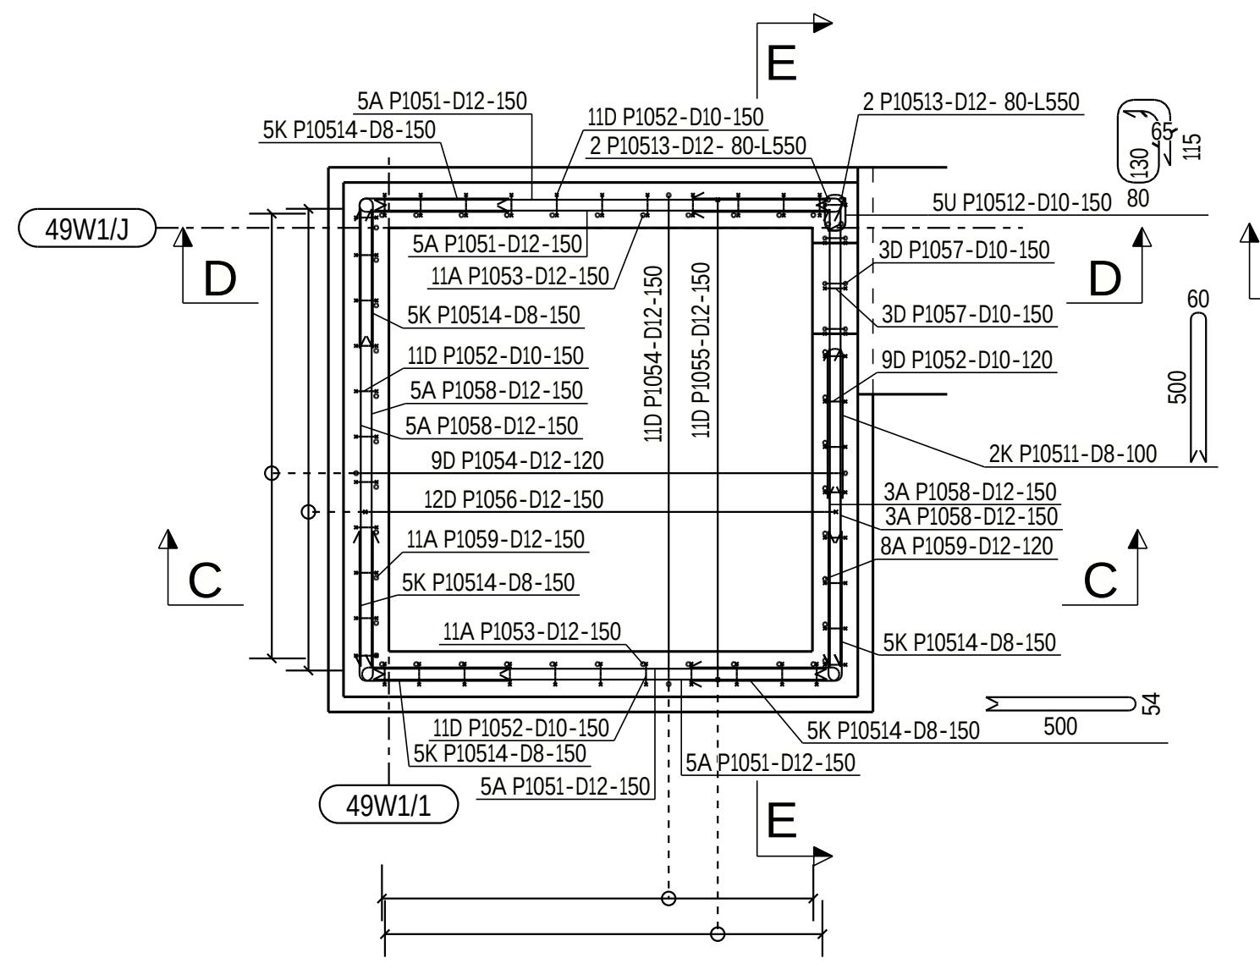

PIT P105 REINFORCEMENT
1:25

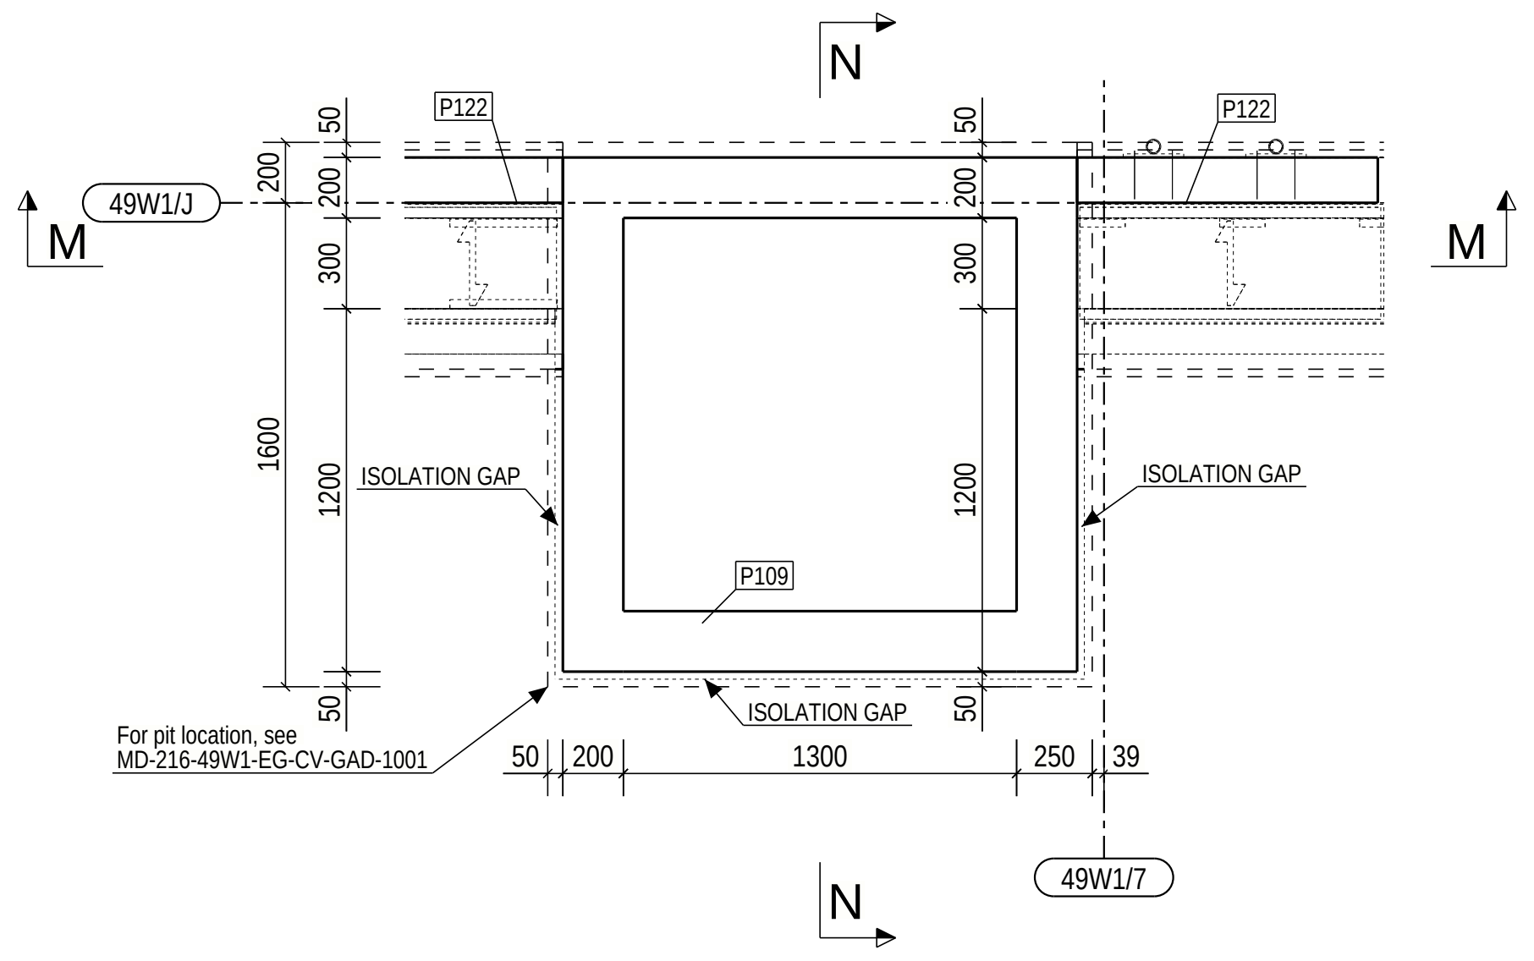

PIT P109 DIMENSION
1:25

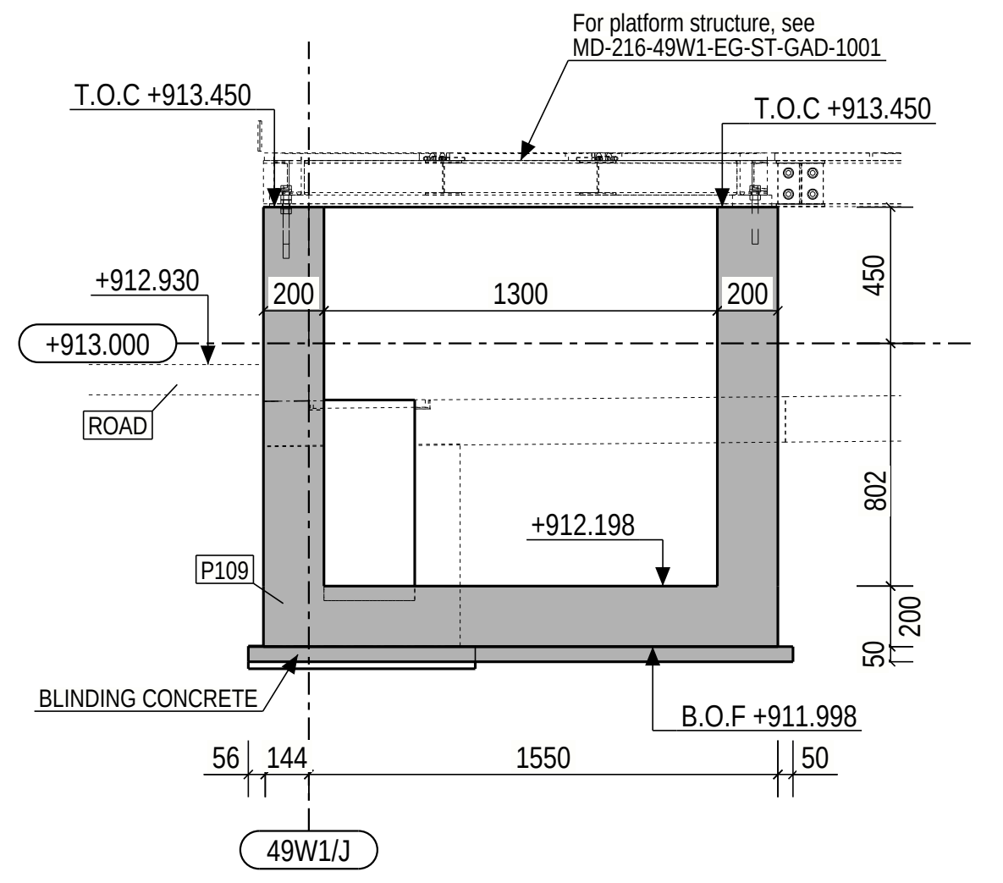

SECTION : N - N
(SCALE 1:25)

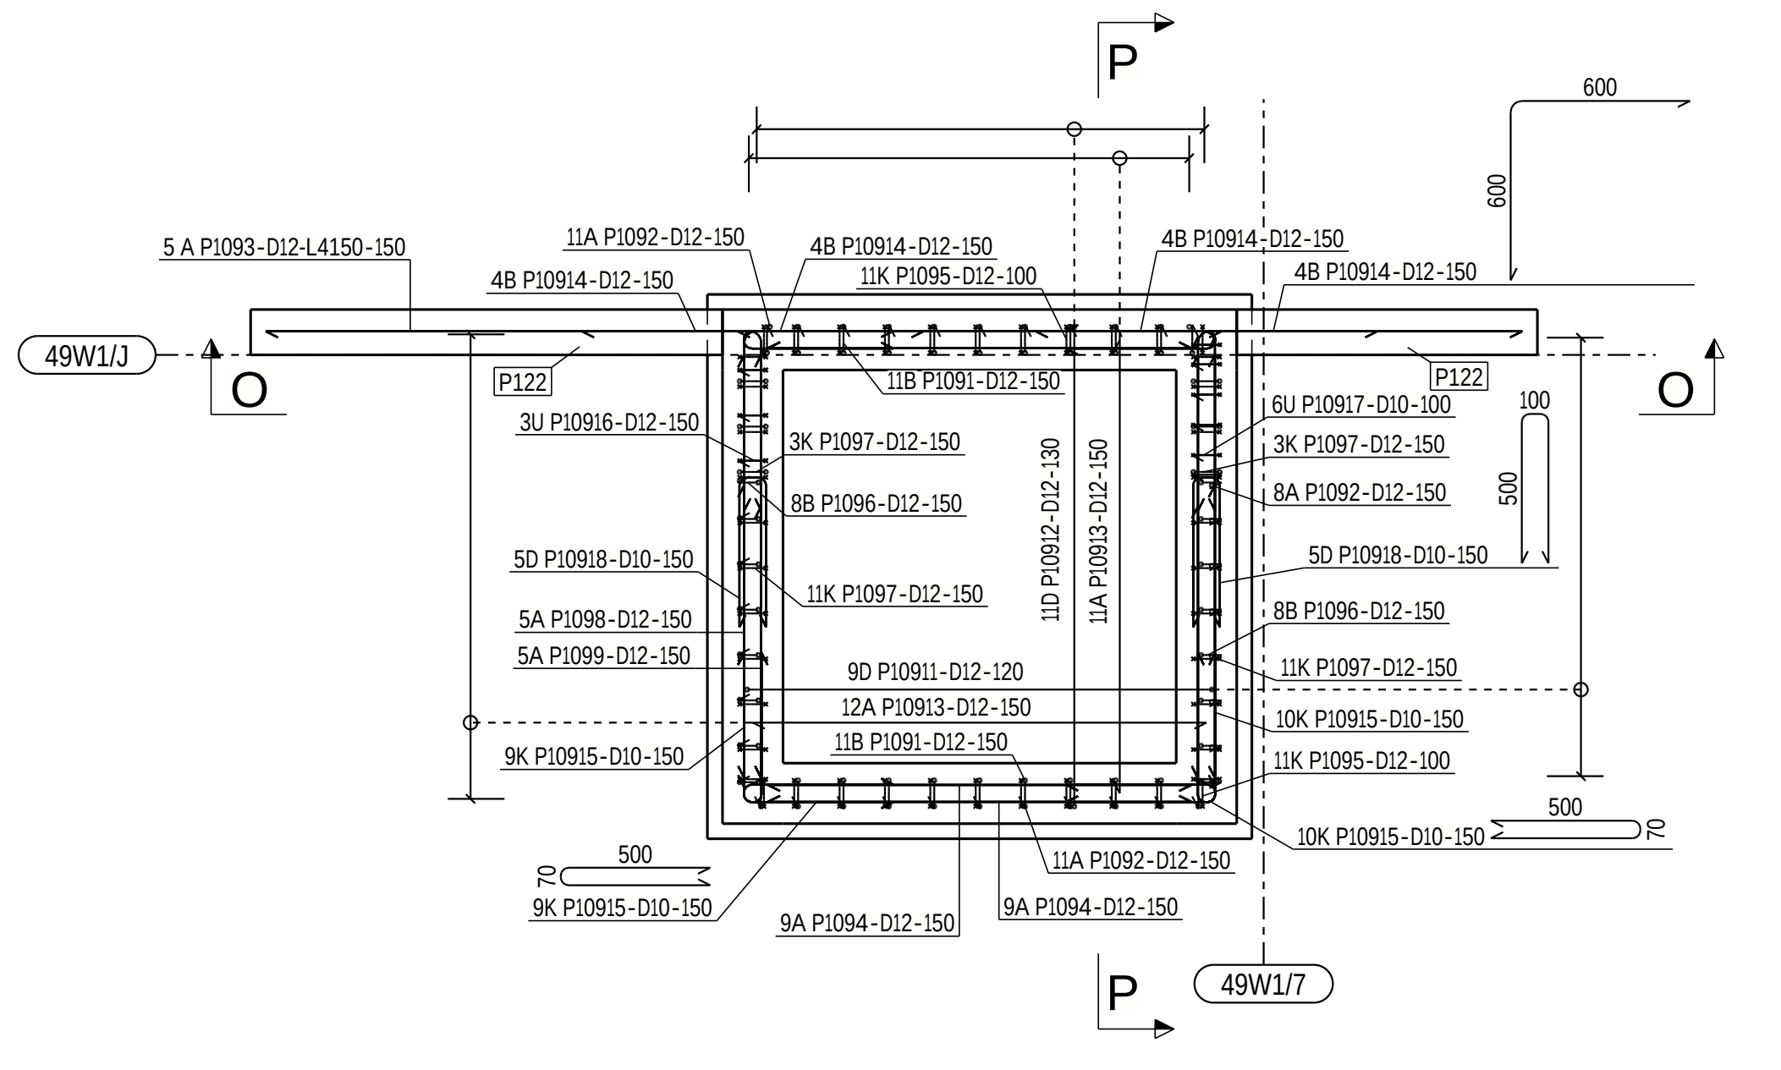

PIT P109 REINFORCEMENT
1:25

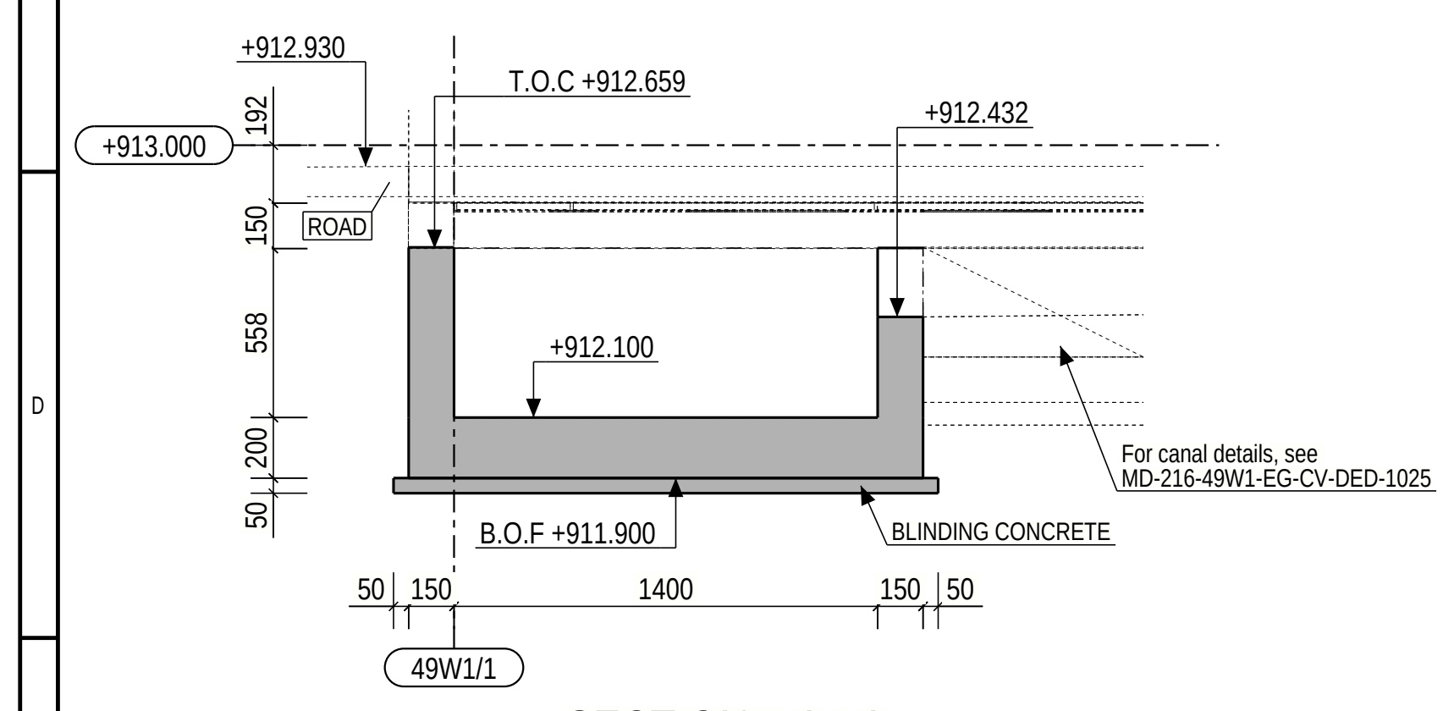

SECTION : A - A
(SCALE 1:25)

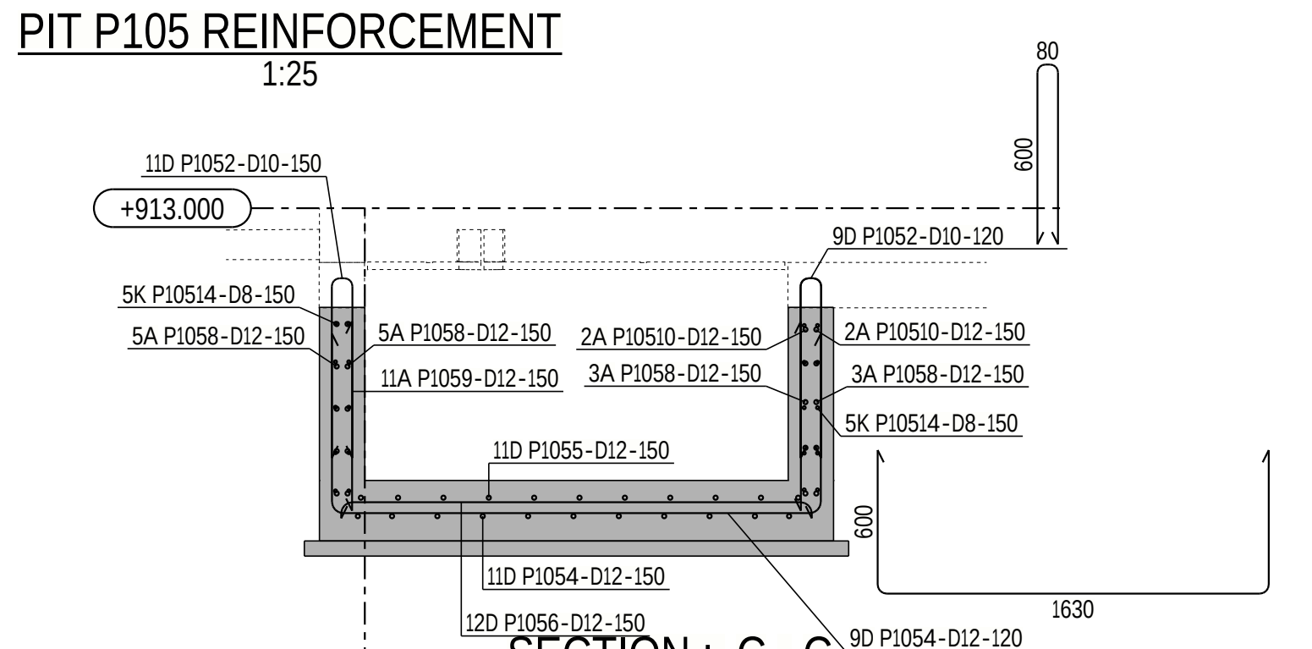

SECTION : C - C
(SCALE 1:25)

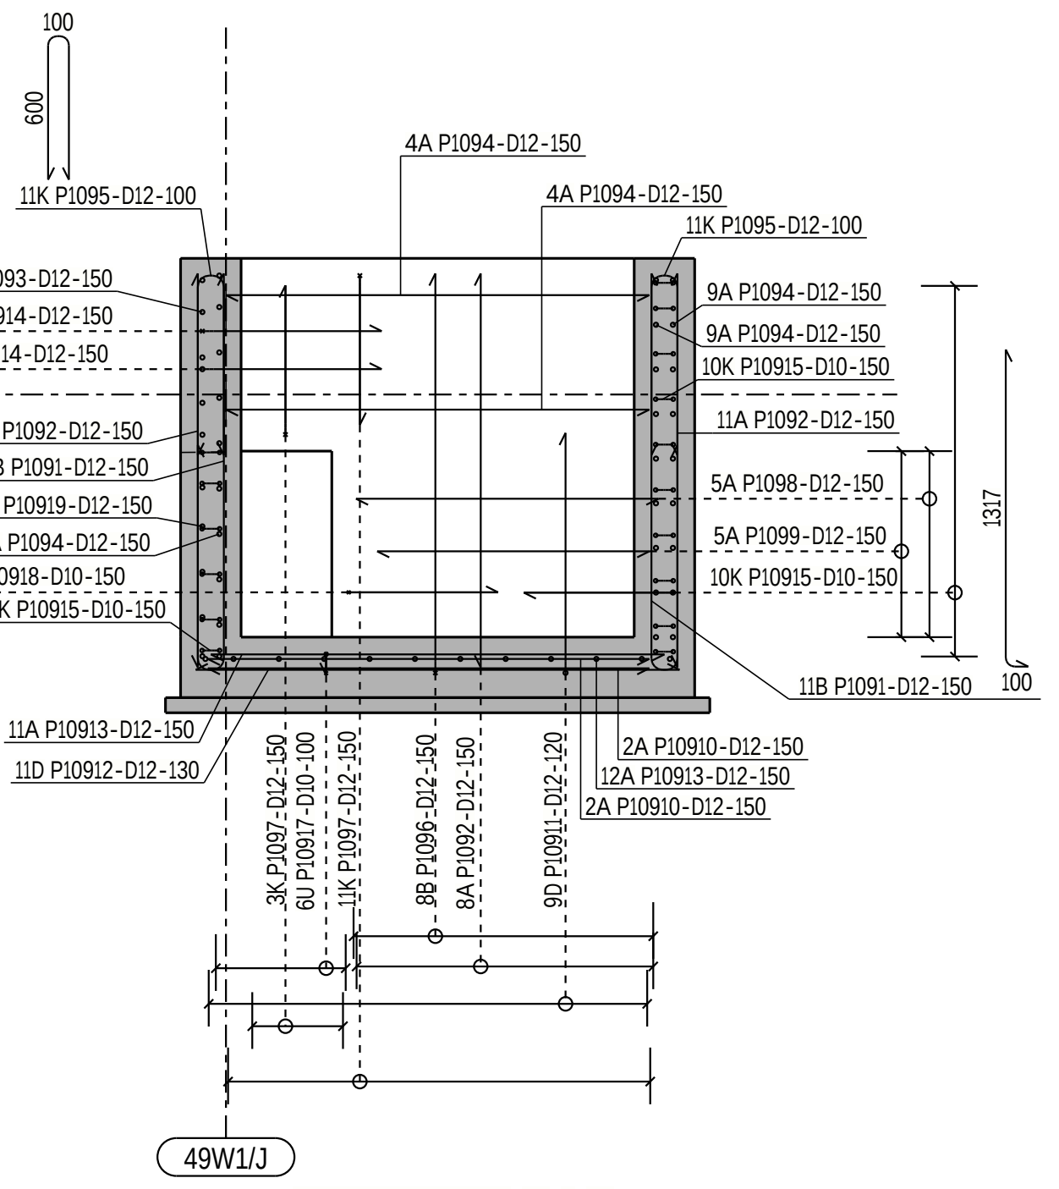

SECTION : P - P
(SCALE 1:25)

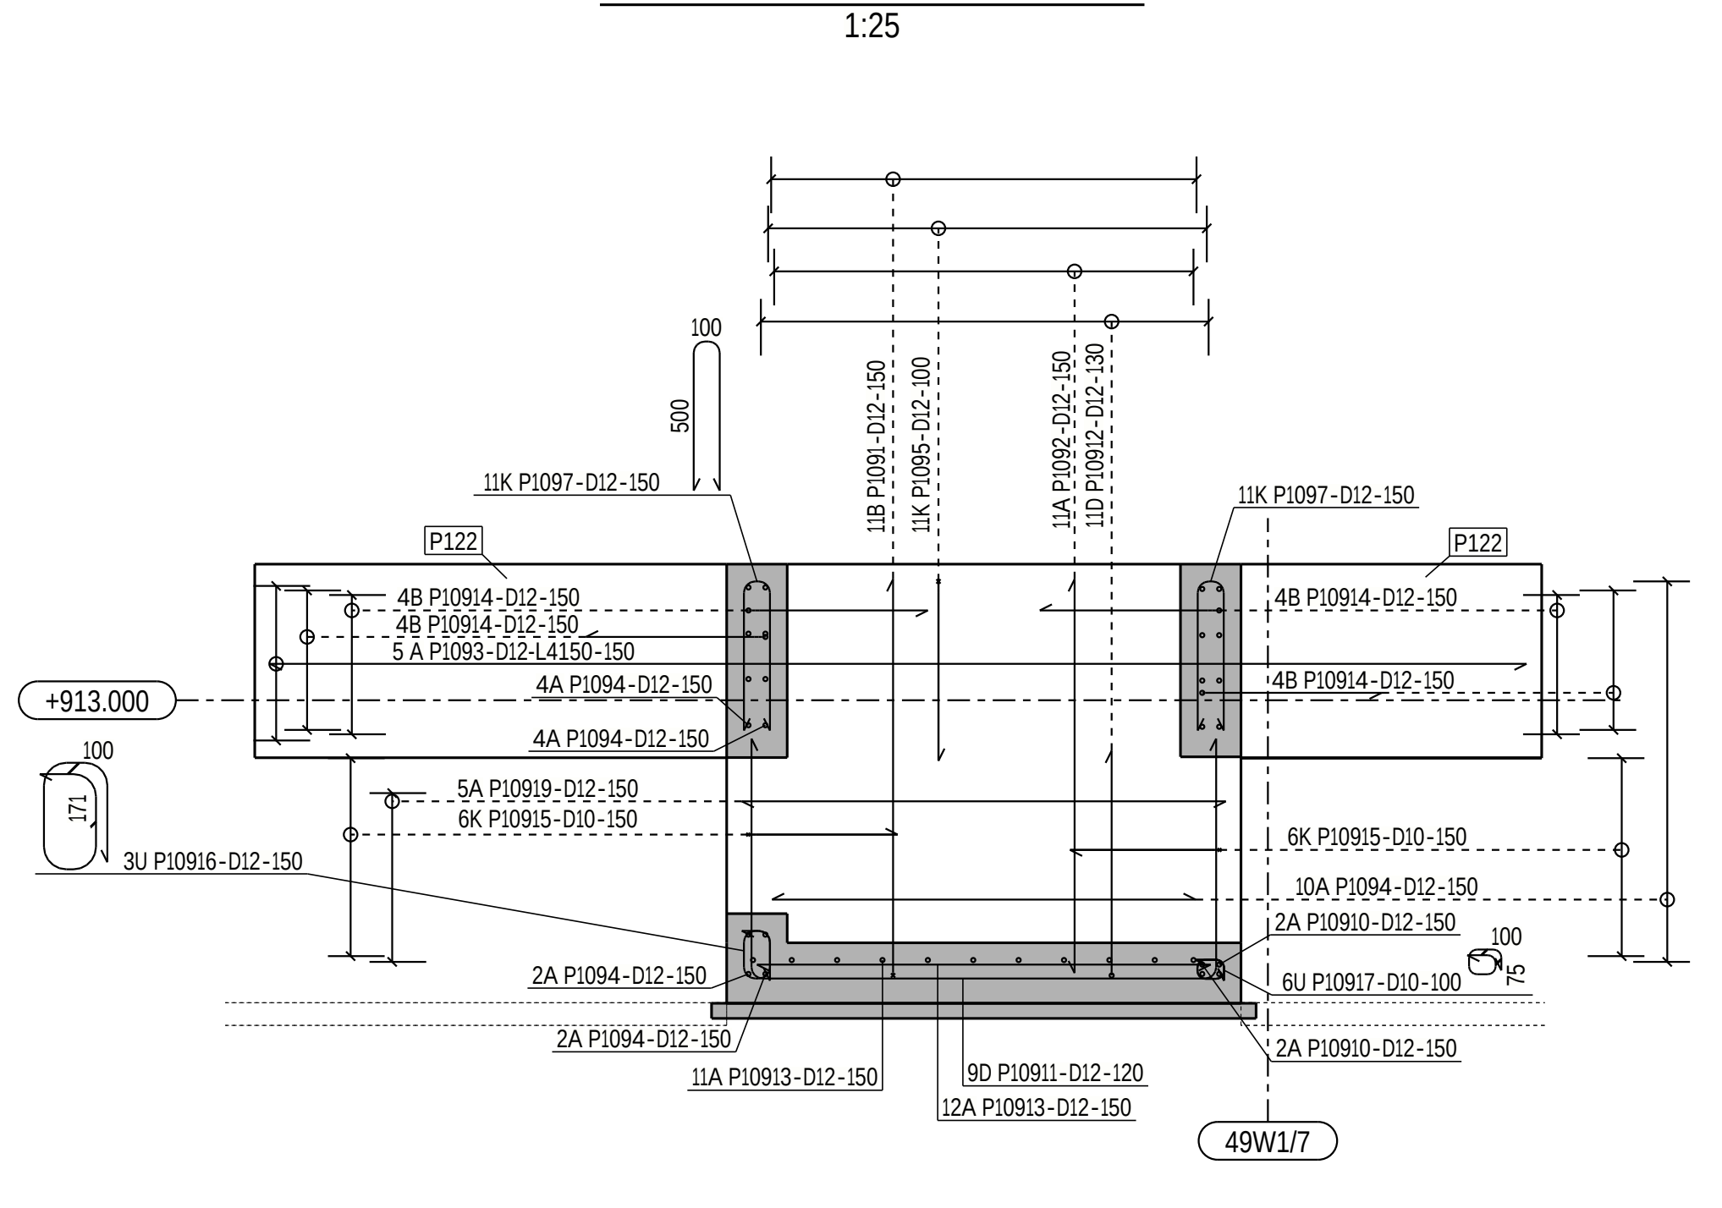

SECTION : O - O
(SCALE 1:25)

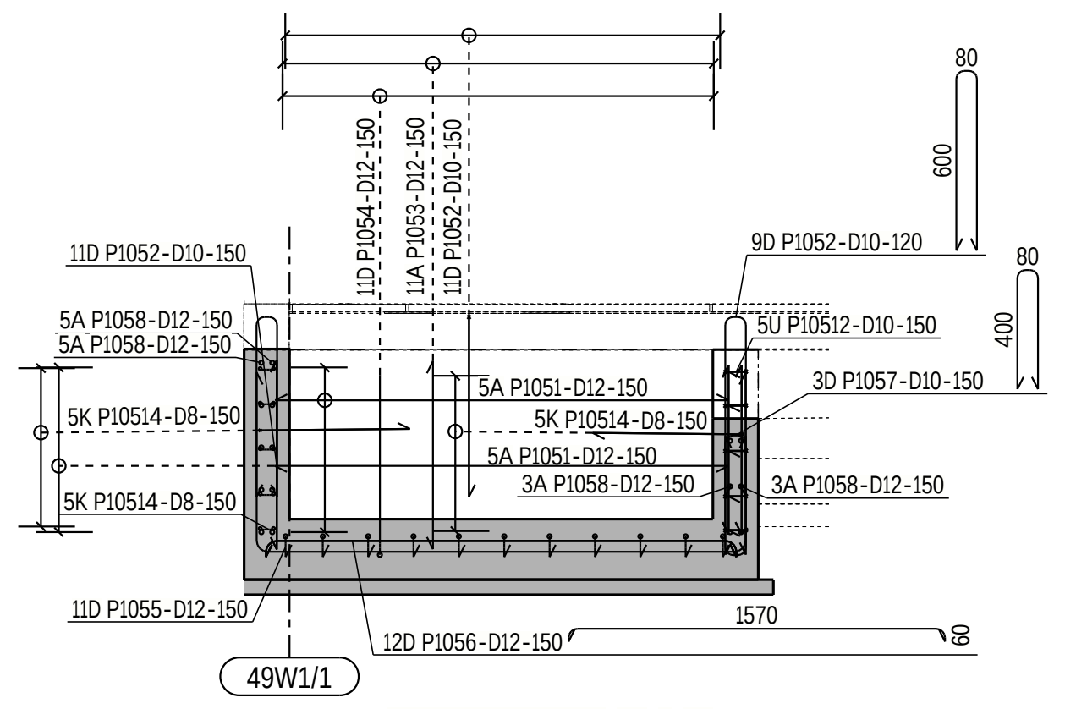

SECTION : D - D
(SCALE 1:25)

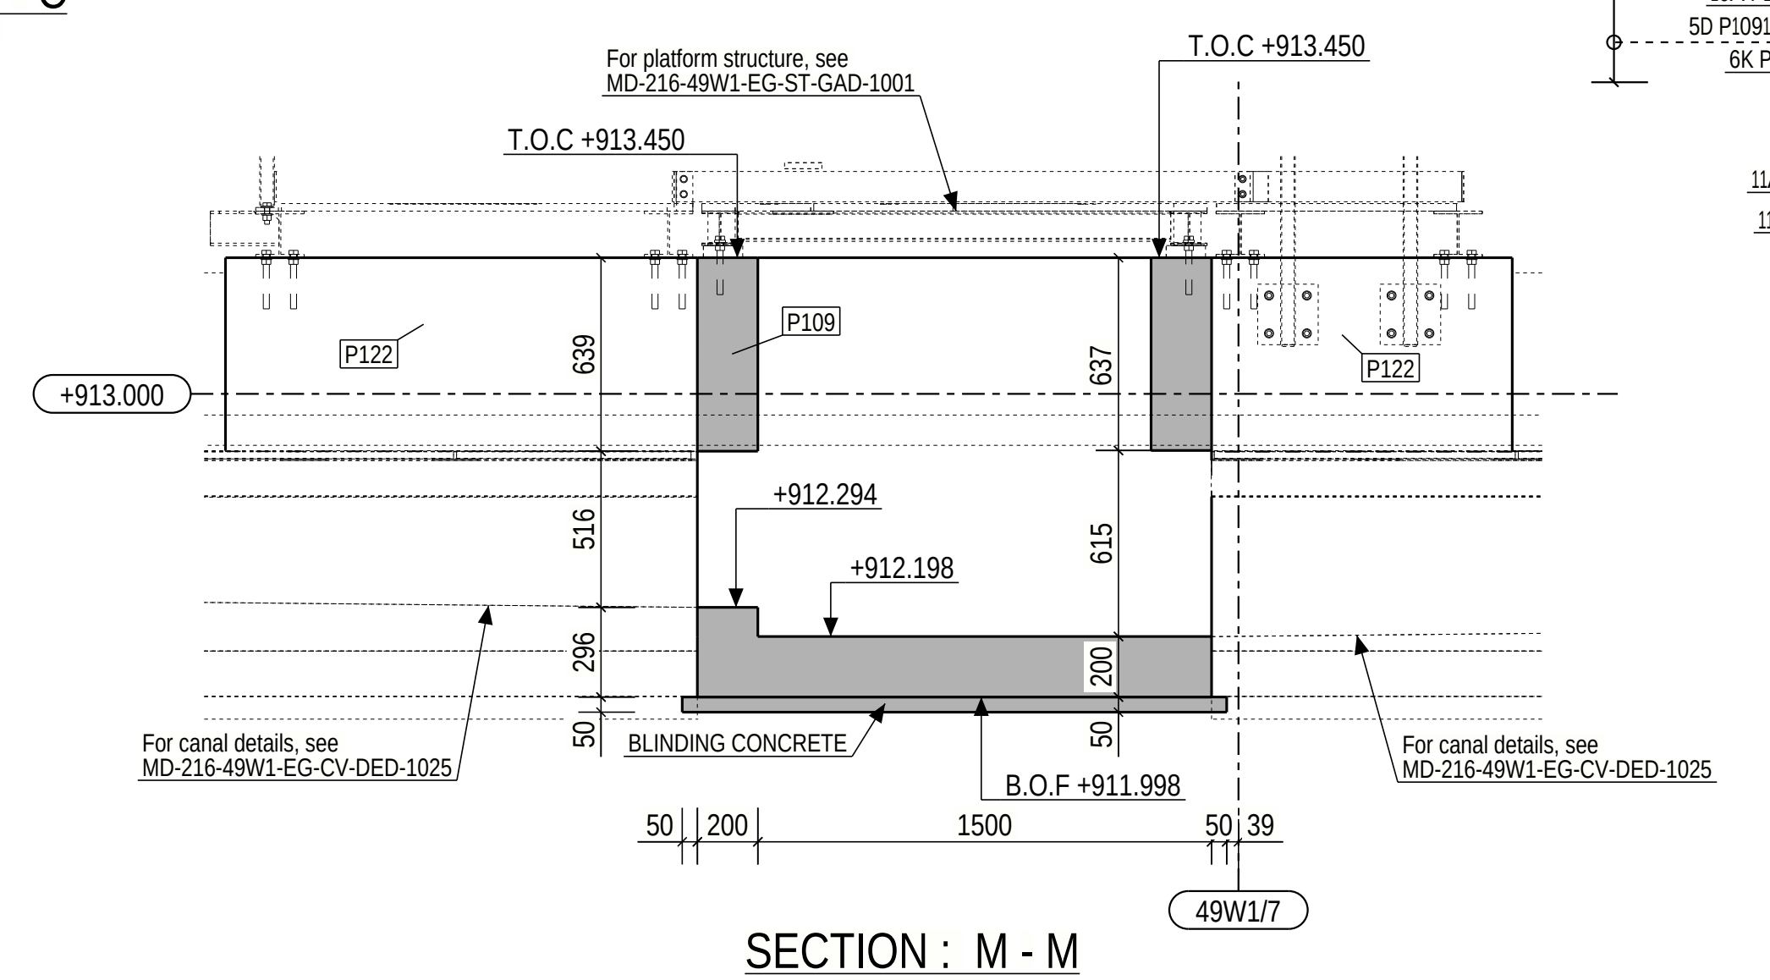
For platform structure, see MD-216-49W1-EG-ST-GAD-1001
T.O.C +913.450
T.O.C +913.450
+913.000
P122
P109
P122
+912.294
+912.198
BLINDING CONCRETE
B.O.F +911.998
For canal details, see MD-216-49W1-CV-DED-1025
For canal details, see MD-216-49W1-CV-DED-1025
1500
49W1/7

SECTION : M - M
(SCALE 1:25)

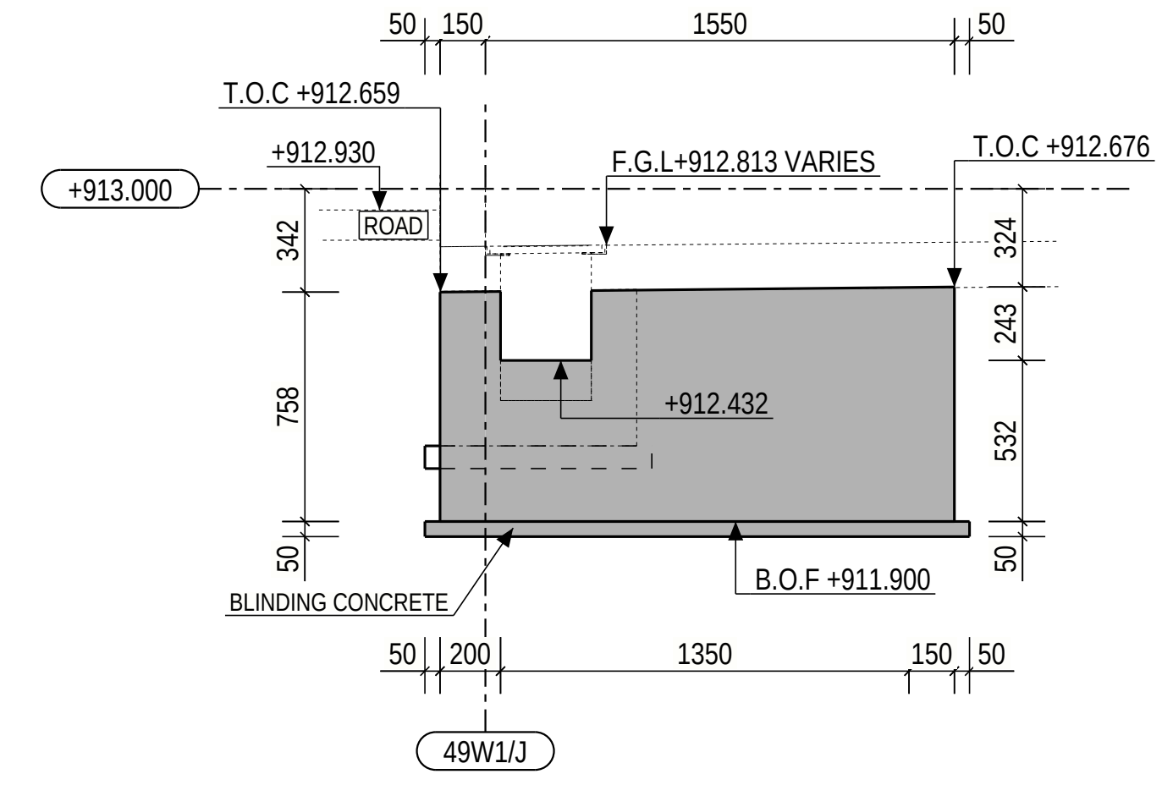

SECTION : B - B
(SCALE 1:25)

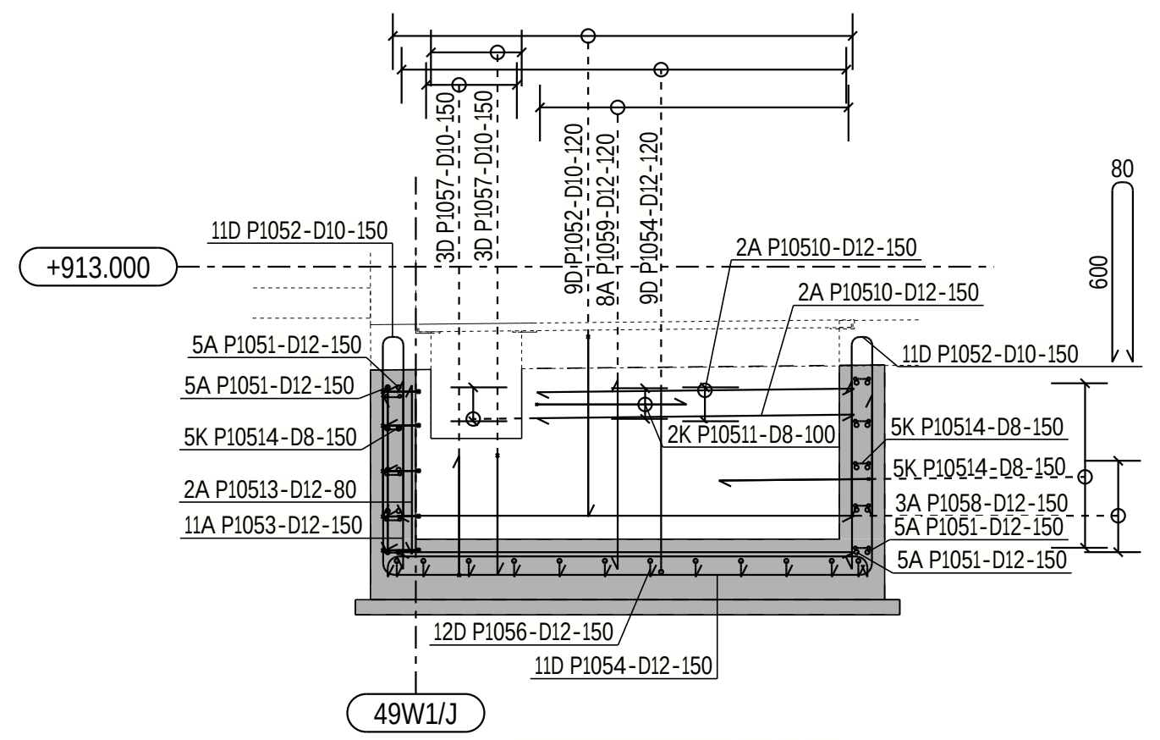

SECTION : E - E
(SCALE 1:25)

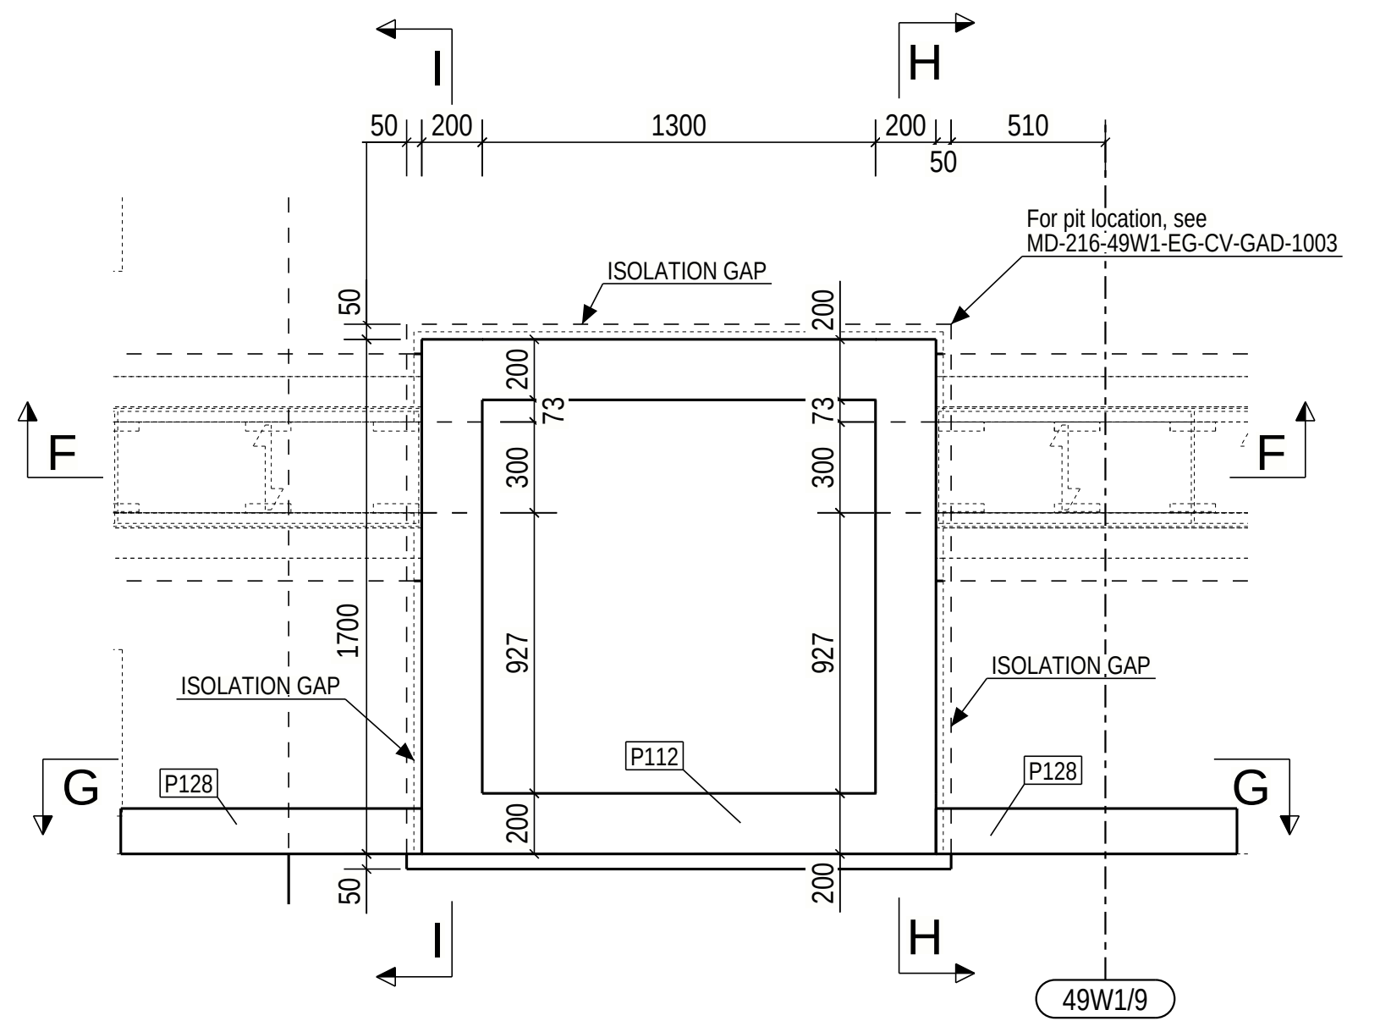

PIT P112 DIMENSION
1:25

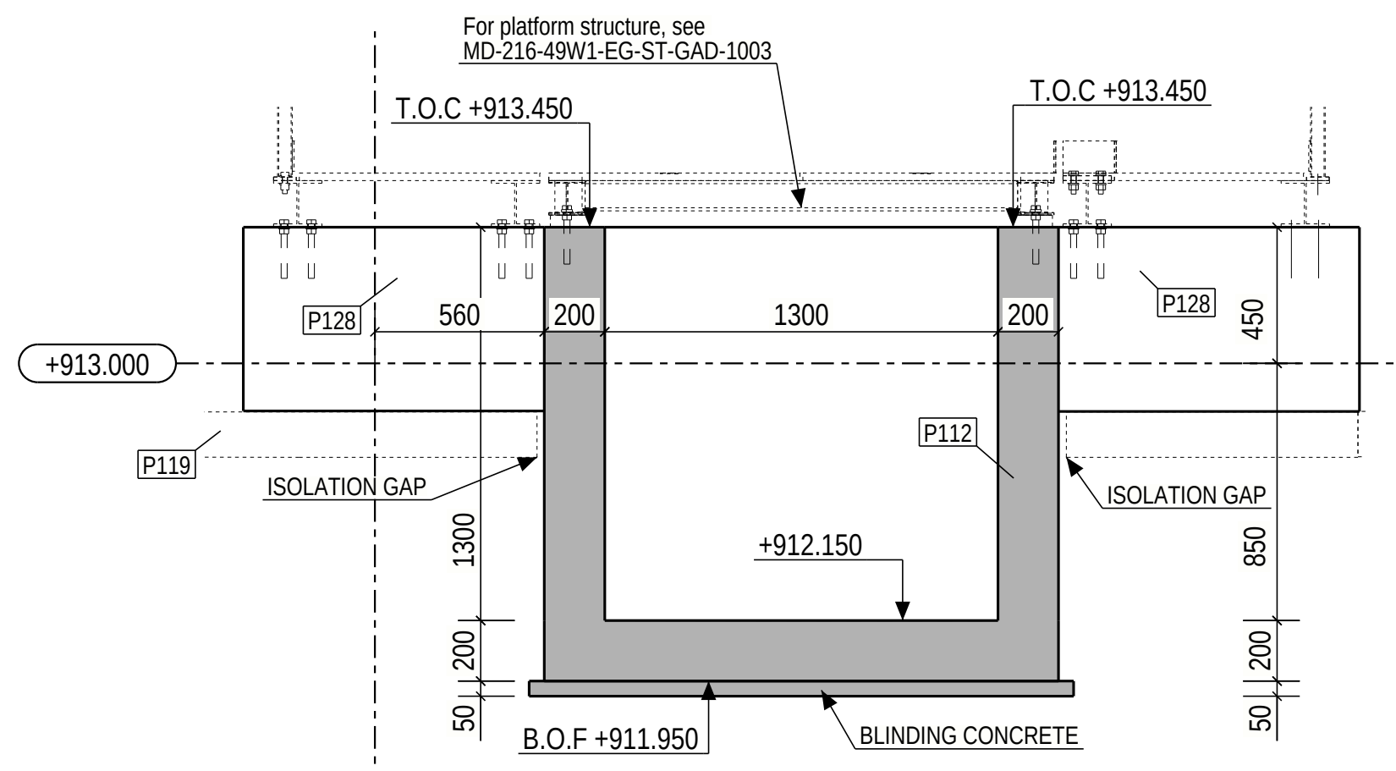

SECTION : G - G
(SCALE 1:25)

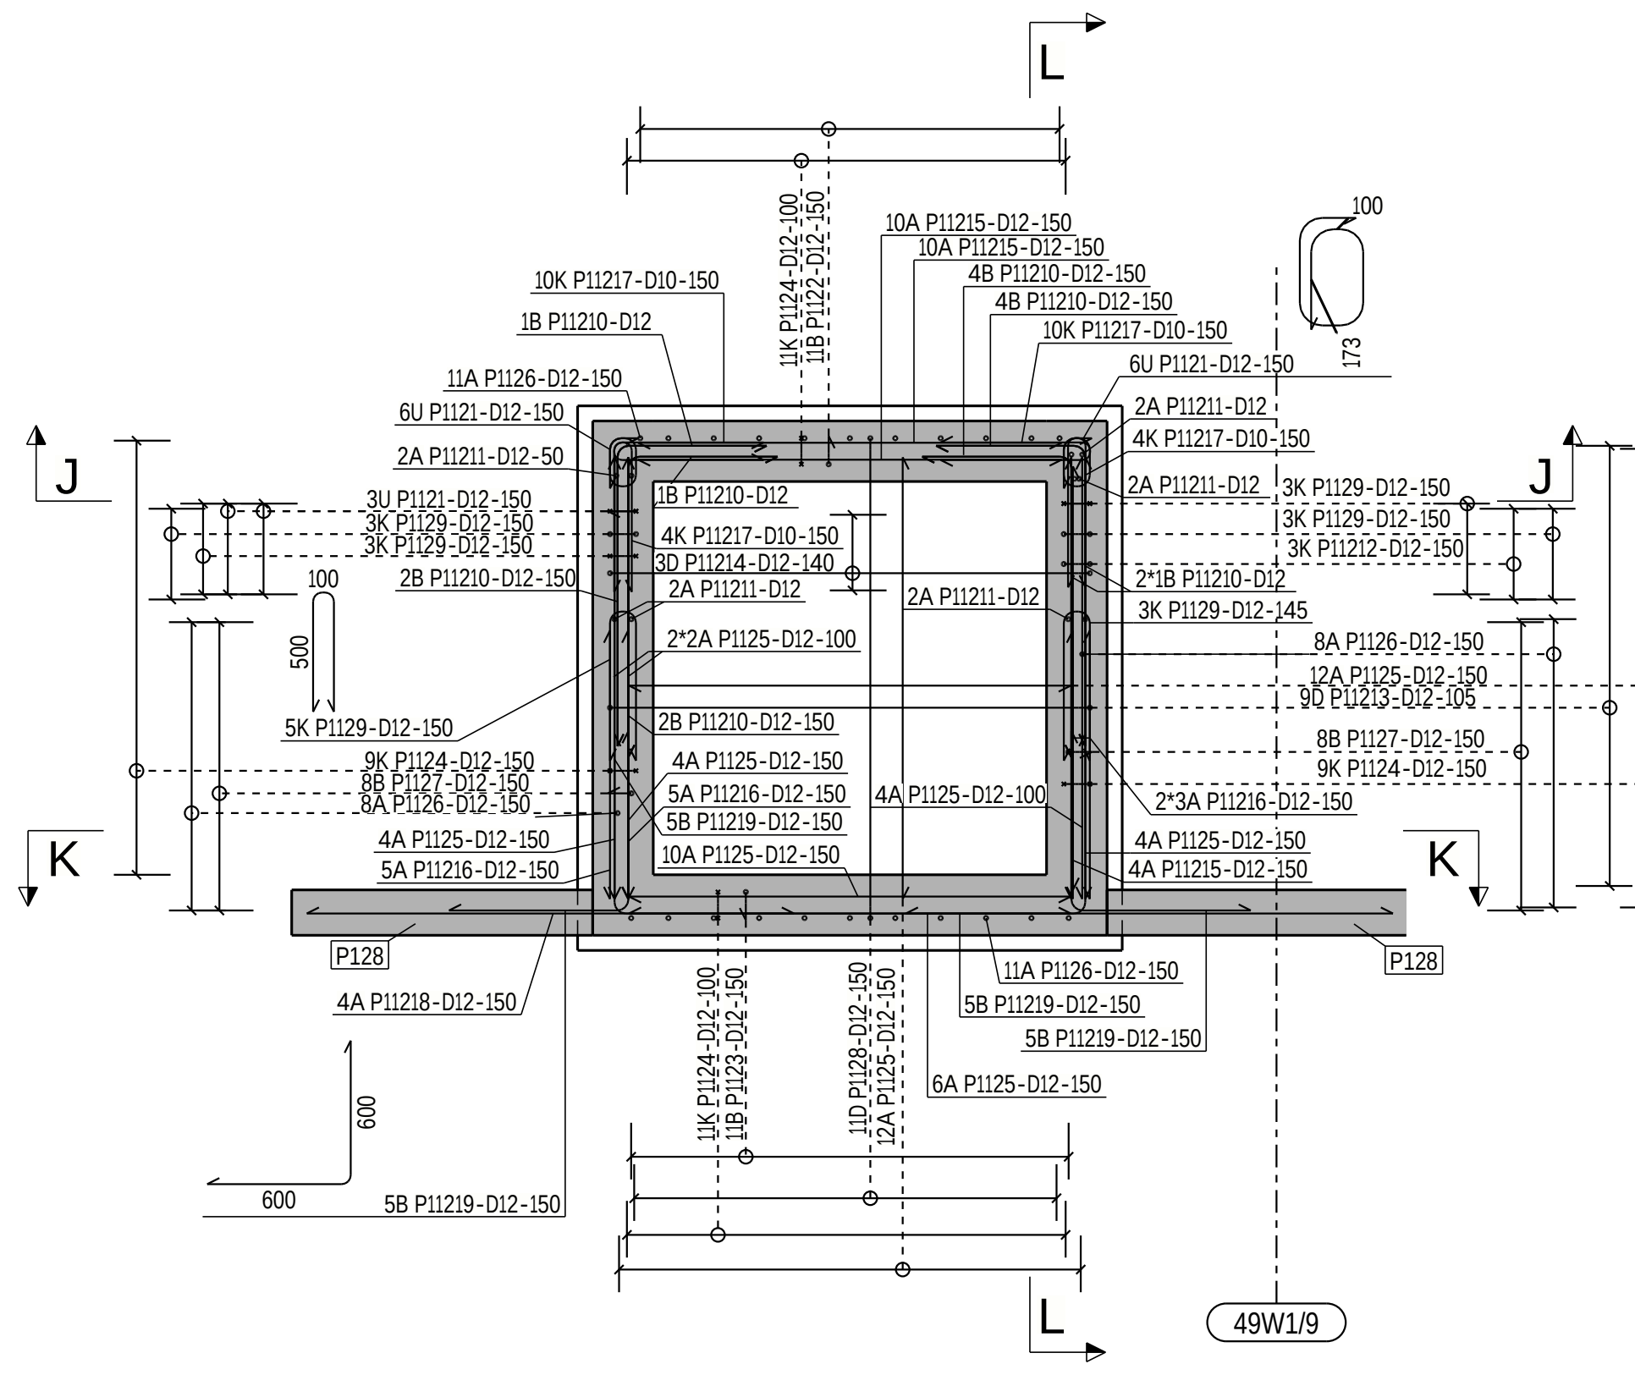

PIT P112 REINFORCEMENT
1:25

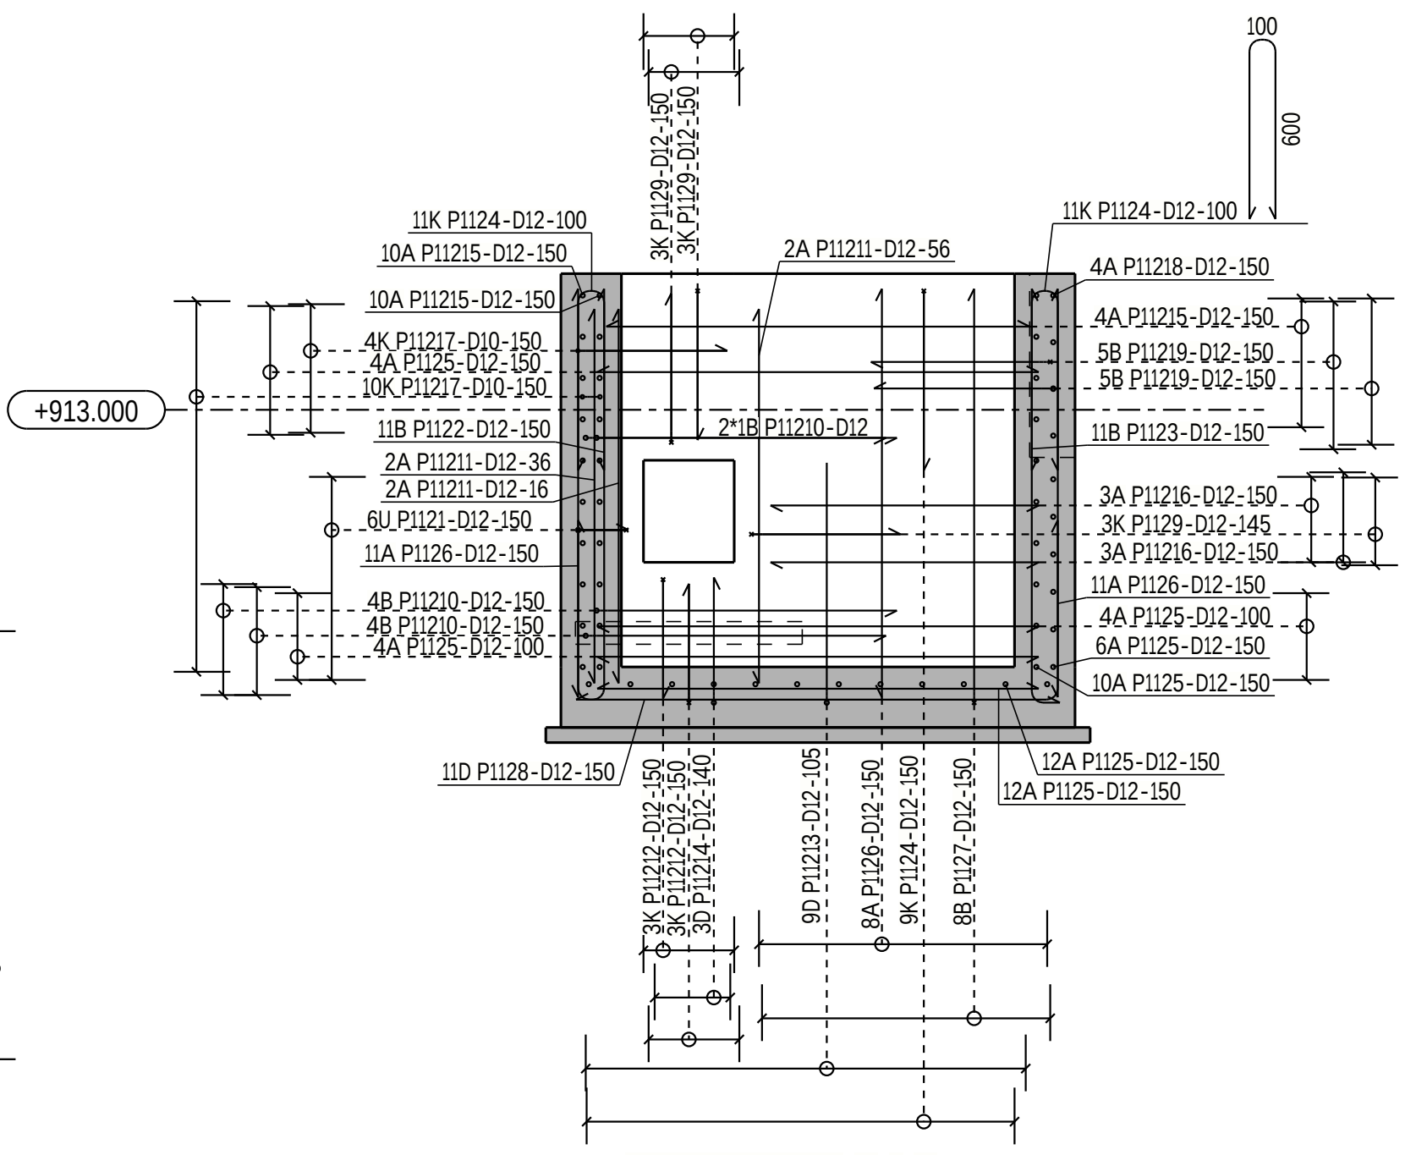

SECTION : L - L
(SCALE 1:25)

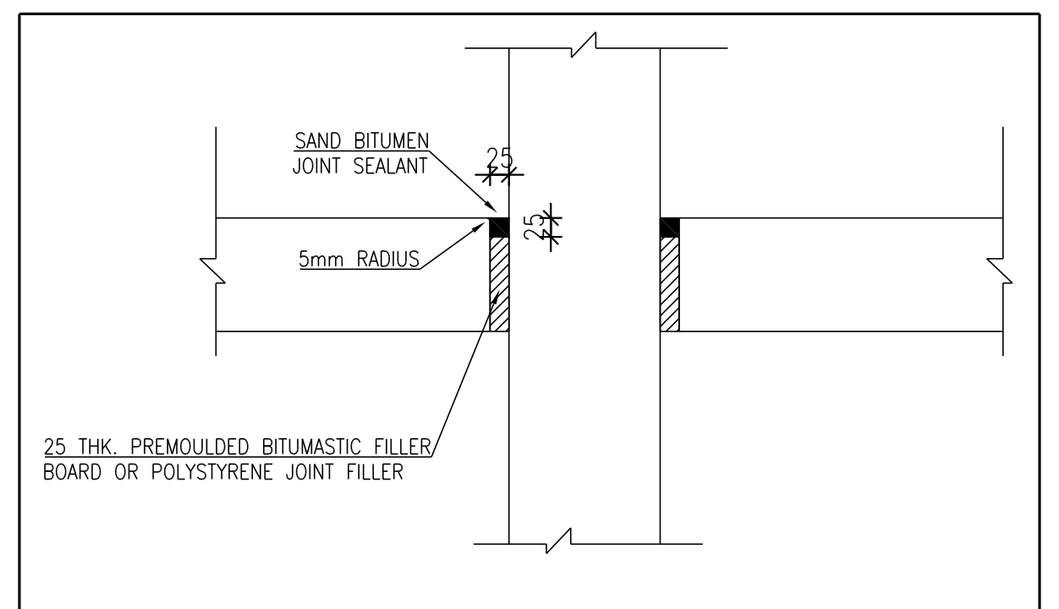
SAND, BITUMEN JOINT SEALANT
5mm RADIUS
25 THK. PREMOULDED BITUMASTIC FILLER BOARD OR POLYSTYRENE JOINT FILLER

DETAIL OF ISOLATION GAP

SCALE 1:10

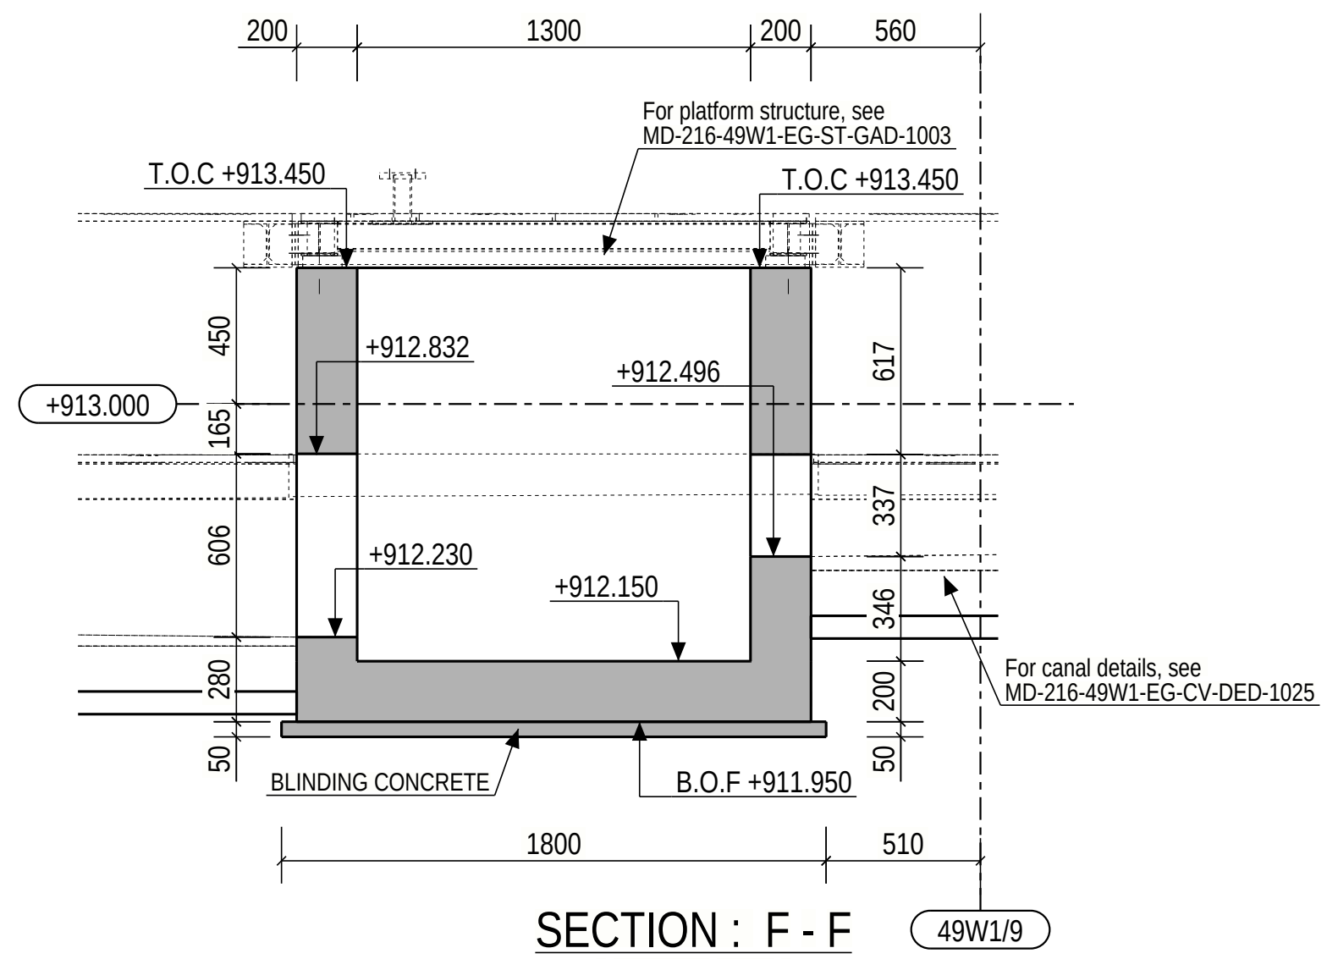

SECTION : F - F
(SCALE 1:25)

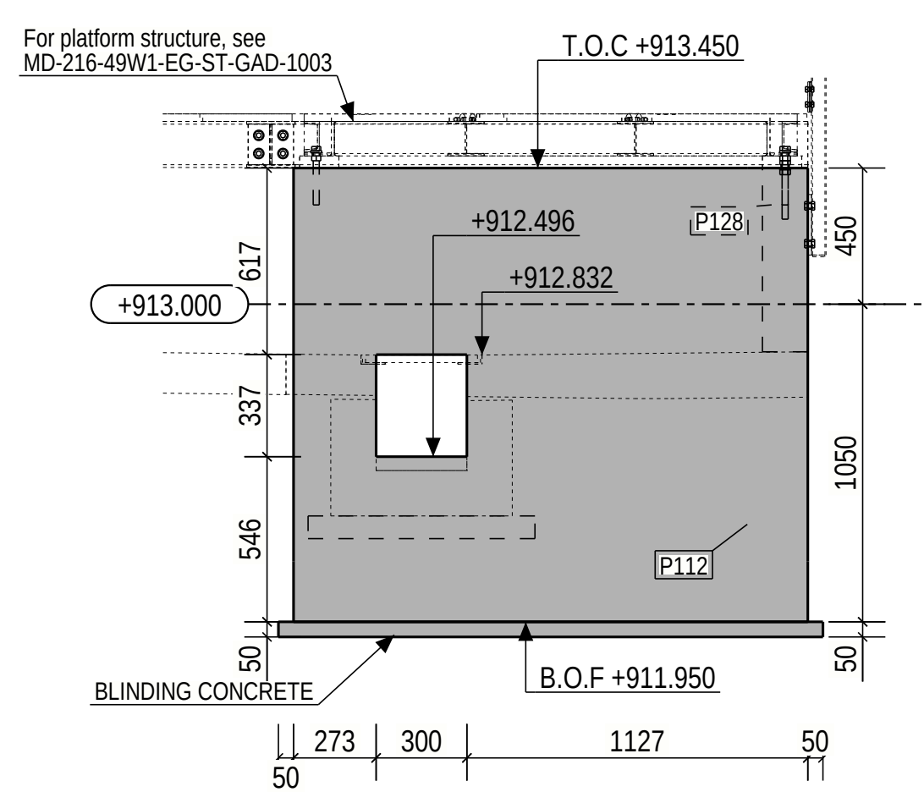

SECTION : H - H
(SCALE 1:25)

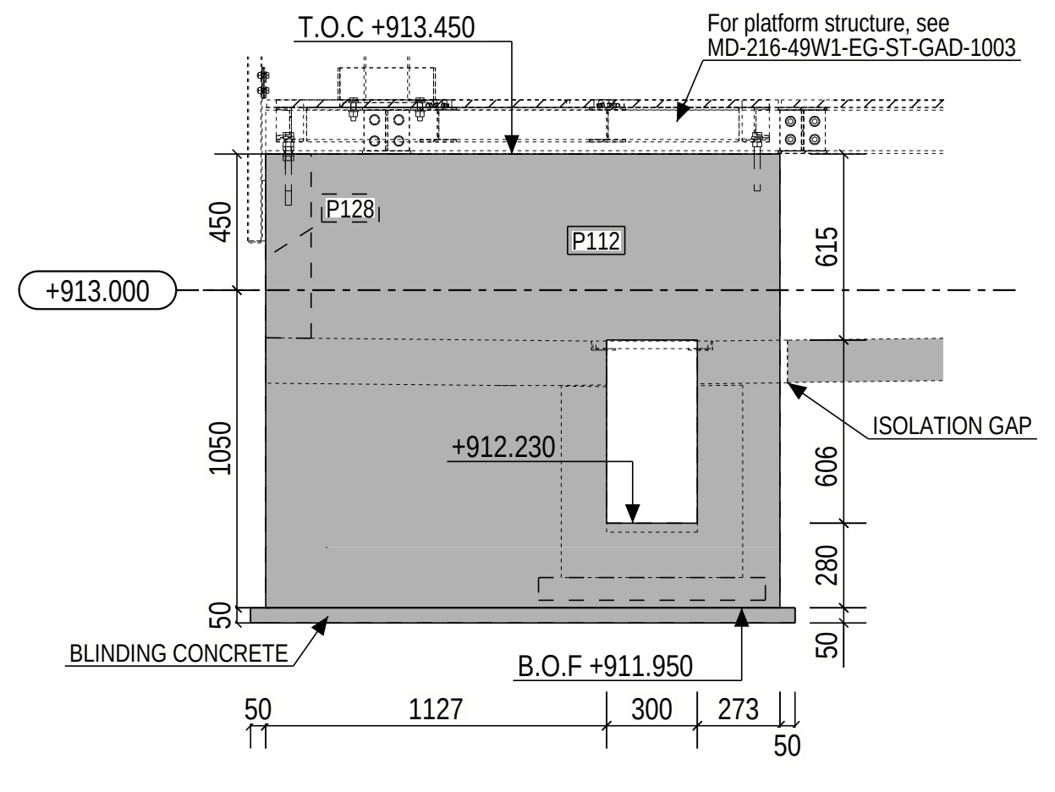

SECTION : I - I
(SCALE 1:25)

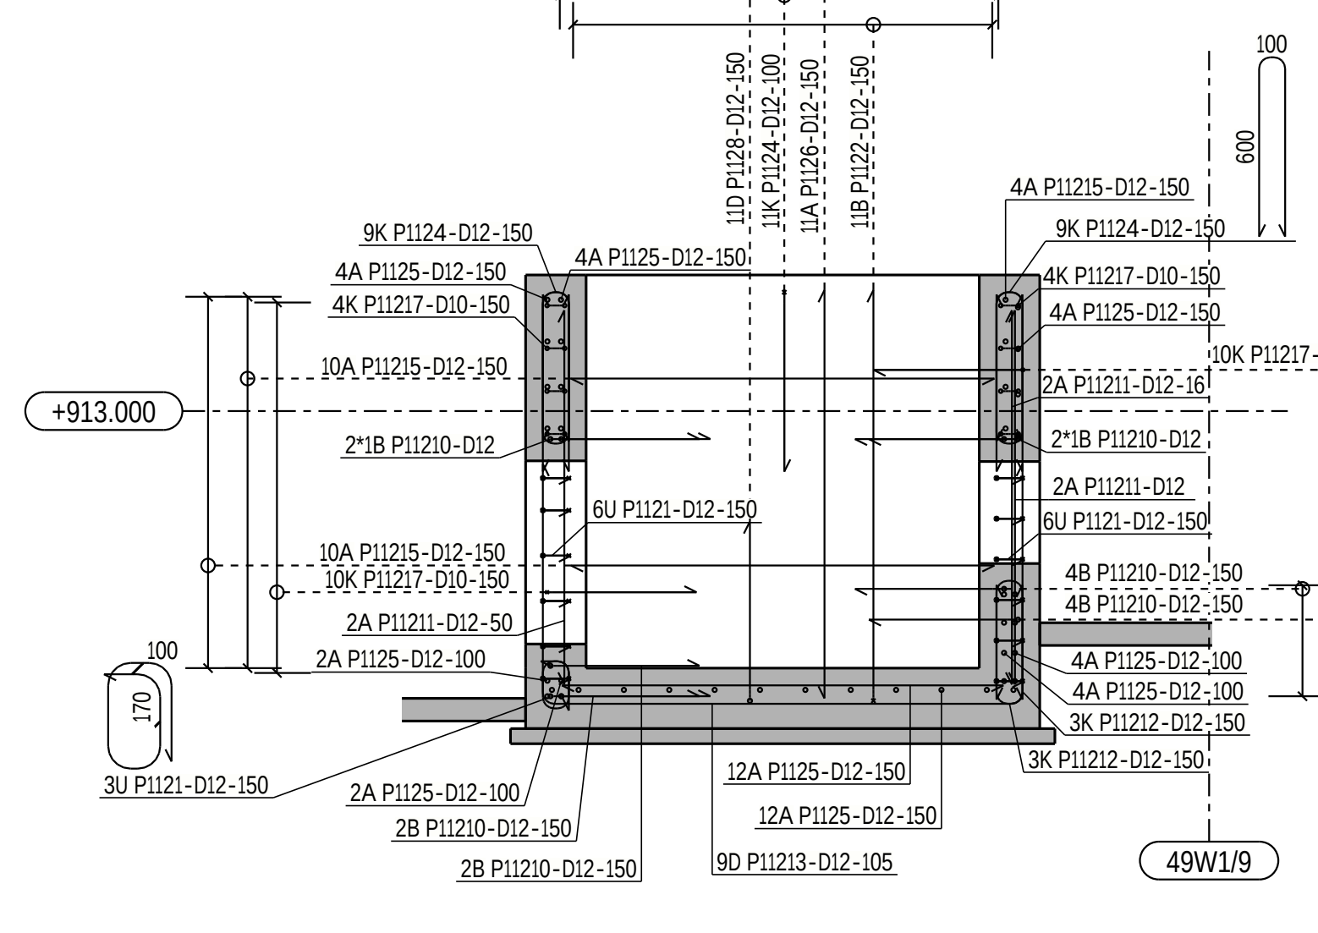

SECTION : J - J
(SCALE 1:25)

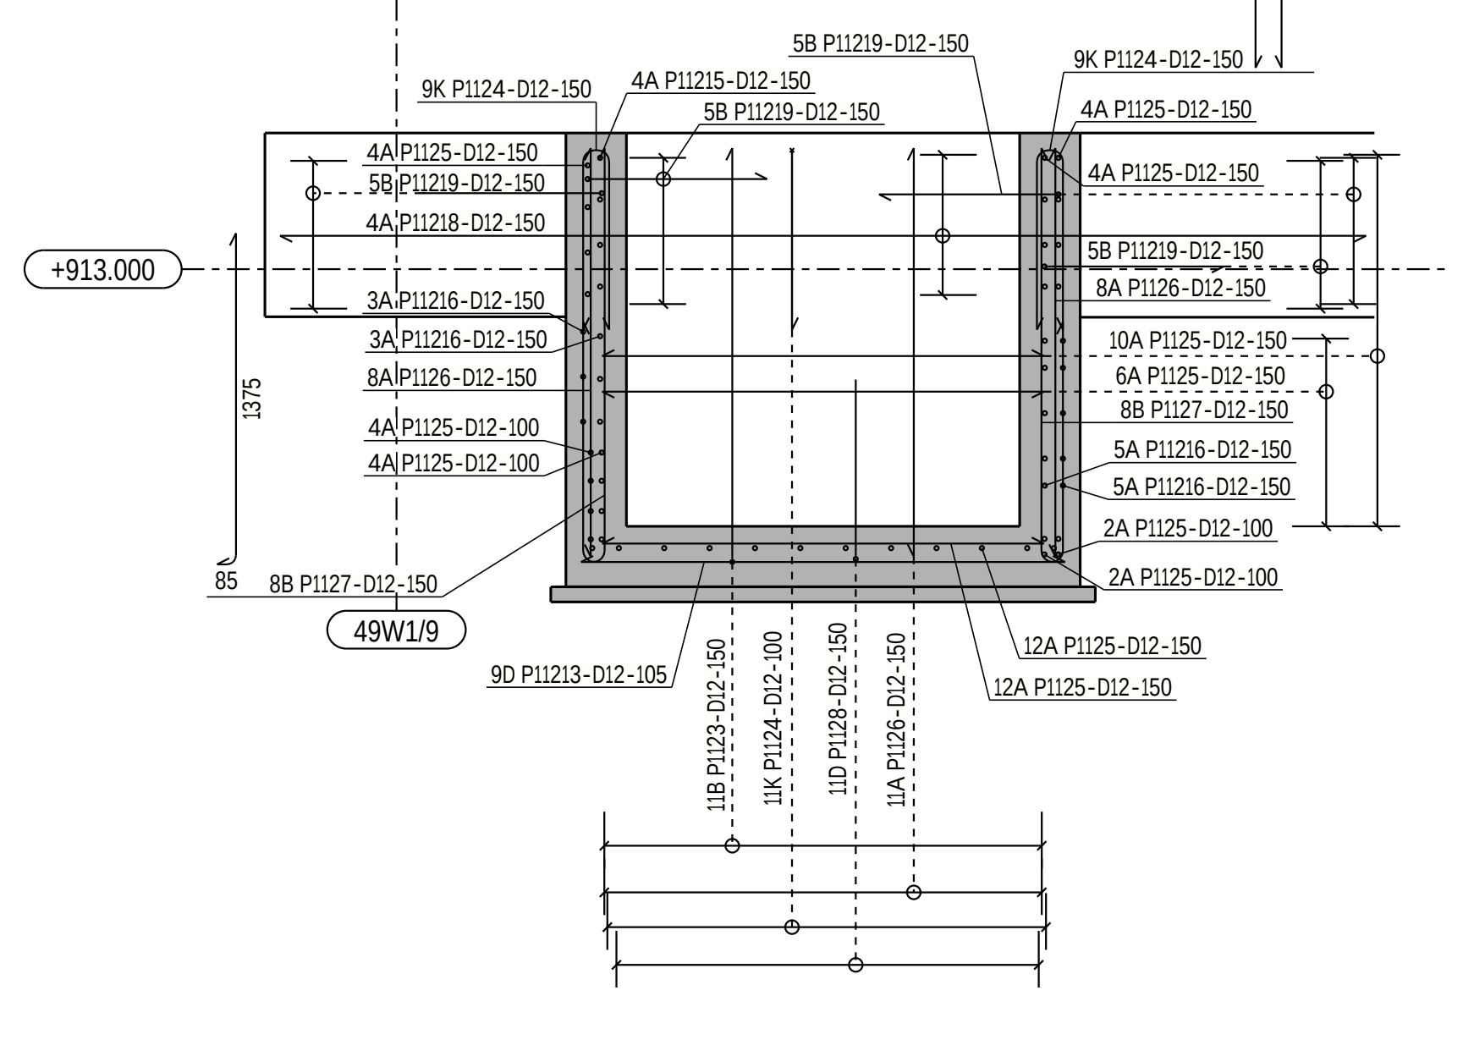

SECTION : K - K
(SCALE 1:25)

CONCRETE INFORMATION

Concretes used	C35		
Concrete cover 1	75±10mm		BOTTOM OF SLAB
Concrete cover 2	50±10mm		SIDES AND TOP OF SLAB, WALLS

REINFORCING BAR LIST — CAST UNIT CODE: FILL — PCS: 11

REINFORCING BAR LIST — CAST UNIT CODE: P105 — PCS: 1

TYPE	POS	PCS	GRADE	D [mm]	L [mm]	dL [mm]	WEIGHT SUM [kg]	a	b	c	d	e	u	v	x	TD	COMMENT
A	P1051	20	B500B	12	1500		26.6	1500									
D	P1052	42	B500B	10	1230		32.0	600	80	600						40	
A	P1053	22	B500B	12	620		12.1	621									
D	P1054	20	B500B	12	2770		49.2	600	1630	600						60	
D	P1055	11	B500B	12	1690		16.5	75	1600	75						60	
D	P1056	12	B500B	12	1630		17.4	60	1570	60						60	
D	P1057	6	B500B	10	830		3.1	400	80	400						40	
A	P1058	16	B500B	12	1510		21.5	1512									
A	P1059	19	B500B	12	620		10.6	625									
A	P10510	4	B500B	12	1050		3.7	1050									
K	P10511	2	B500B	8	1020		0.8	500	500							32	
U	P10512	5	B500B	10	480		1.5	115	80	130	80	130				40	
A	P10513	4	B500B	12	550		2.0	558									
K	P10514	35	B500B	8	1010		14.0	500	500							32	

REINFORCING BAR TOTAL WEIGHT [kg] 211.0

REINFORCING BAR LIST — CAST UNIT CODE: P109 — PCS: 1

TYPE	POS	PCS	GRADE	D [mm]	L [mm]	dL [mm]	WEIGHT SUM [kg]	a	b	c	d	e	u	v	x	TD	COMMENT
B	P1091	22	B500B	12	1380		27.1	1317	100				90			60	
A	P1092	38	B500B	12	1300		43.9	1302									
A	P1093	5	B500B	12	4150		18.4	4154									
A	P1094	48	B500B	12	1400		59.7	1400									
K	P1095	22	B500B	12	1240		24.2	600	600							60	
B	P1096	16	B500B	12	1370		19.5	1327	75				90			60	
K	P1097	28	B500B	12	1040		25.9	500	500							60	
A	P1098	10	B500B	12	1000		8.9	1000									
A	P1099	10	B500B	12	900		8.0	900									
A	P10910	4	B500B	12	1460		5.2	1460									
D	P10911	9	B500B	12	3090		24.7	800	1550	800						60	
D	P10912	11	B500B	12	3040		29.7	750	1600	750						60	
A	P10913	23	B500B	12	1500		30.6	1500									
B	P10914	16	B500B	12	1170		16.6	600	600				90			60	
K	P10915	50	B500B	10	1020		31.6	500	500							40	
U	P10916	3	B500B	12	660		1.8	171	100	171	100	171				60	
U	P10917	6	B500B	10	400		1.5	100	75	100	75	100				40	
D	P10918	10	B500B	10	1050		6.5	500	100	500						40	
A	P10919	5	B500B	12	1600		7.1	1600									

REINFORCING BAR TOTAL WEIGHT [kg] 390.9

REINFORCING BAR LIST — CAST UNIT CODE: P112 — PCS: 1

TYPE	POS	PCS	GRADE	D [mm]	L [mm]	dL [mm]	WEIGHT SUM [kg]	a	b	c	d	e	u	v	x	TD	COMMENT
U	P1121	15	B500B	12	660		8.9	173	100	173	100	173				60	
B	P1122	11	B500B	12	1430		14.0	1365	100				90			60	
B	P1123	11	B500B	12	1440		14.1	1375	100				90			60	
K	P1124	40	B500B	12	1240		44.1	600	600							60	
A	P1125	64	B500B	12	1460		83.0	1460									
A	P1126	38	B500B	12	1350		45.6	1350									
B	P1127	16	B500B	12	1430		20.3	1375	85				90			60	
D	P1128	11	B500B	12	2740		26.8	600	1600	600						60	
K	P1129	20	B500B	12	1040		18.5	500	500							60	
B	P11210	16	B500B	12	1470		20.9	500	1000				90			60	
A	P11211	10	B500B	12	1230		11.0	1237									
K	P11212	6	B500B	12	840		4.5	400	400							60	
D	P11213	9	B500B	12	3140		25.1	800	1600	800						60	
D	P11214	3	B500B	12	2110		5.6	420	1600	154						60	
A	P11215	24	B500B	12	1400		29.8	1400									
A	P11216	16	B500B	12	880		12.6	887									
K	P11217	28	B500B	10	1020		17.7	500	500							40	
A	P11218	4	B500B	12	3590		12.8	3590									
B	P11219	20	B500B	12	1170		20.8	600	600				90			60	

REINFORCING BAR TOTAL WEIGHT [kg] 435.9

REINFORCING BAR LIST — CAST UNIT CODE: P122 — PCS: 2

REINFORCING BAR LIST — CAST UNIT CODE: P128 — PCS: 2

REINFORCEMENT BENDING SHAPES:

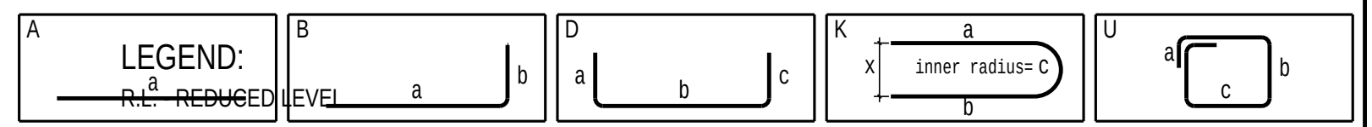

LEGEND:

~~R.L. - REDUCED LEVEL~~

T.O.C. - TOP OF CONCRETE

B.O.F. - BOTTOM OF FOUNDATION

F.G.L. - FINISHED GROUND LEVEL

P.C.C. - PLAIN CEMENT CONCRETE

TYP - TYPICAL

MKD - MARKED

CL - CENTER LINE

BOTTOM REINF. (B)

TOP REINF. (T)

SBC - SAFE BEARING CAPACITY

MIN. - MINIMUM

REF. - REFERED

GA - GENERAL ARRANGEMENT

DWG. - DRAWING

R.C.C. - REINFORCED CEMENT CONCRETE

NOTES:

1. ALL DIMENSIONS ARE IN MILLIMETRES AND LEVELS ARE IN METRES UNLESS OTHERWISE STATED

2. GRADE OF CONCRETE SHALL BE C35 (35MPa) UNLESS NOTED OTHERWISE & C15 (15MPa) FOR BLINDING CONCRETE.

3. GRADE OF REINFORCEMENT SHALL BE DEFORMED BAR ASTM A615-GRADE 60 (fy=420MPa)

4. CLEAR COVER TO MAIN REINFORCEMENT SHALL BE AS FOLLOWS:
a) FOUNDATION: 75 mm (BOTTOM & SIDE)
b) FOUNDATION: 50 mm (TOP)
c) COLUMN & PEDESTAL: 50 mm

5. MINIMUM LAP LENGTHS OF REINFORCEMENT SHALL BE 40XBAR DIAMETER

6. FOR STANDARD REINFORCEMENT DETAILS & GENERAL NOTES FOR CIVIL WORKS REFER TO DRAWING NUMBER MD-216-1000-EG-CV-DED-1005 & 1001

7. ANCHOR BOLTS AND EMBEDDED STEELWORK SHALL BE HOT DIP GALVANIZED

8. T.O.C. & TOP OF SCREED TOLERANCE SHALL BE WITHIN +/- 10MM OF DESIGN LEVEL

9. NET SAFE BEARING CAPACITY OF SOIL AT BOTTOM OF FOUNDATION IS CONSIDERED AS 375 KN/SQ.M.

10. REBARS CAN BE MOVED LOCALLY BY +/- 25mm TO AVOID INTERFERENCE WITH EMBEDDED PARTS

KEYPLAN

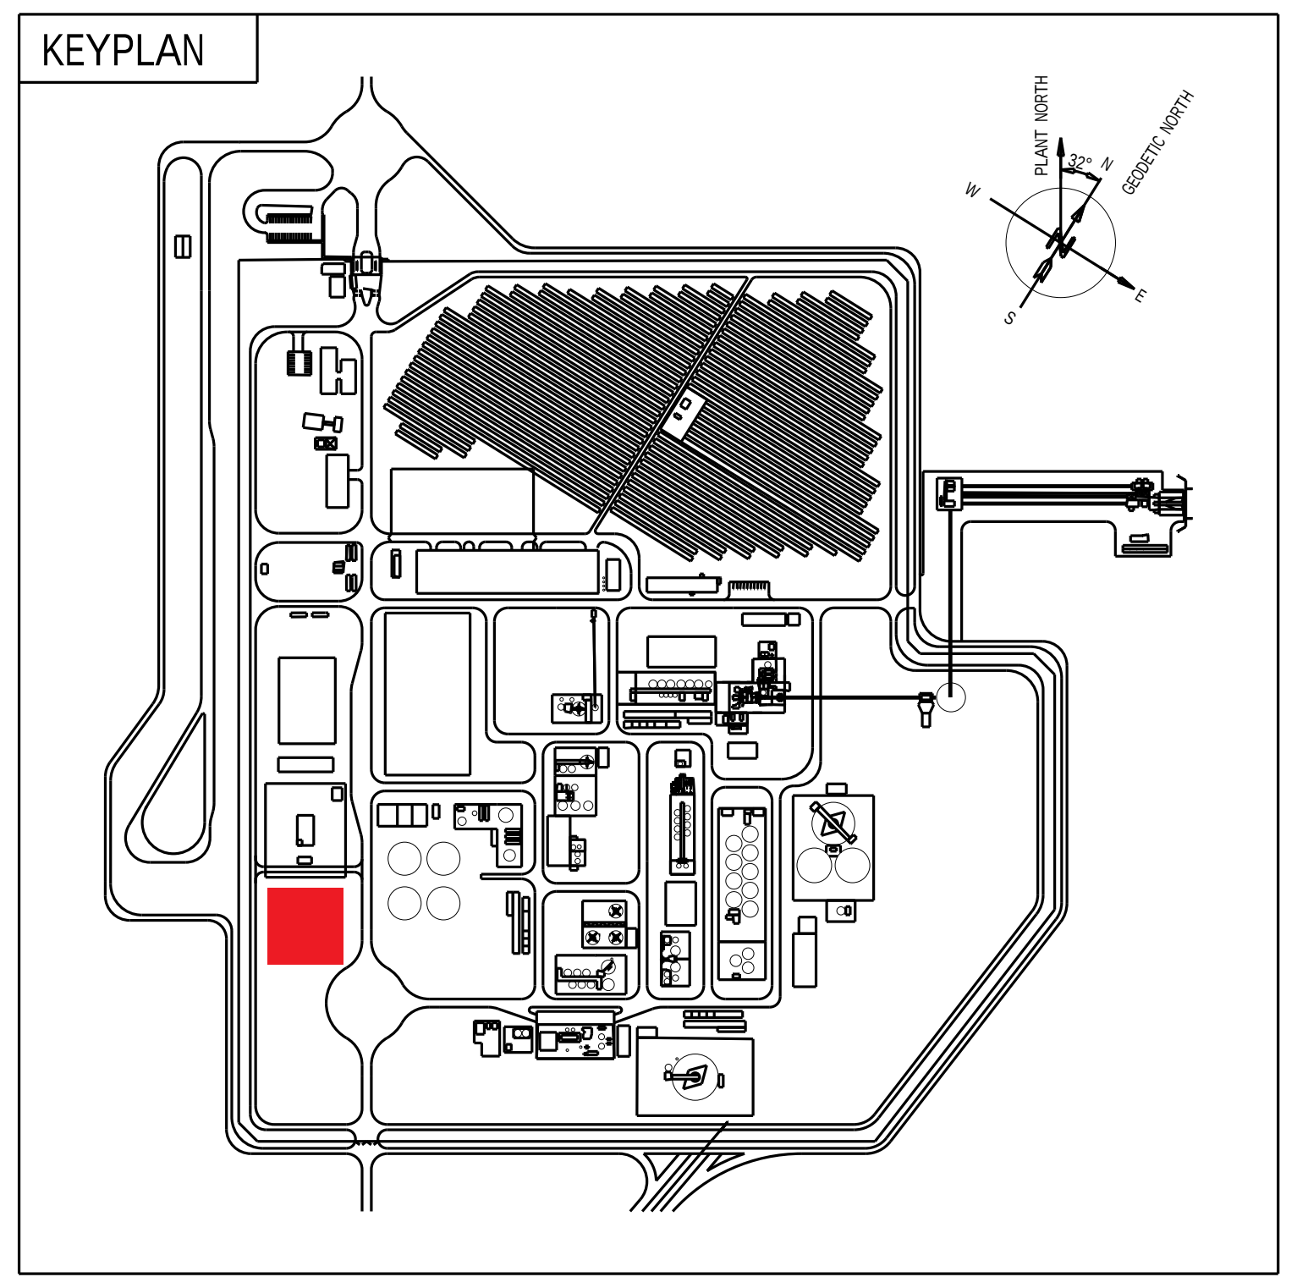

DOCUMENT NUMBER	REFERENCE DOCUMENTS	DOCUMENT NUMBER	REFERENCE DOCUMENTS
MD-216-1000-EG-ST-CRT-1001	DESIGN CRITERIA		
MD-216-49W1-EG-CV-DED-1028	SLAB DETAIL- AND REINFORCEMENT DRAWING - GRIDLINES G-J/1-5	MD-216-49W1-EG-CV-DED-1029	SLAB DETAIL- AND REINFORCEMENT DRAWING - GRIDLINES D-G/8-12
MD-216-49W1-EG-CV-GAD-1003	GENERAL ARRANGEMENT DRAWING GL 1-10/A-E	MD-216-49W1-EG-CV-DED-1027	SLAB DETAIL- AND REINFORCEMENT DRAWING - GRIDLINES G-J/5-10
MD-216-49W1-EG-CV-GAD-1001	GENERAL ARRANGEMENT DRAWING - GRIDLINES 1-7/E-J	MD-216-49W1-EG-CV-GAD-1002	GENERAL ARRANGEMENT DRAWING - GRIDLINES 7-12/E-J

REV	DATE	REVISION DESCRIPTION	DRN	CHK	ENG	APP	EMP
D01	29.01.2024	AS-BUILT	JonRen	MauNot	NanWu	LuiPiz	
C01	01.03.2022	ISSUED FOR CONSTRUCTION	JonRen	MauNot	NanWu	LuiPiz	
A01	14.02.2022	ISSUED FOR APPROVAL	NanWu	MauNot	LuiPiz	SouCha	

RESERVED FOR VENDOR LOGO AND DRAWING NUMBER

LARSEN & TOUBRO

This drawing is the property of LARSEN & TOUBRO and must not be passed on to any person or body not authorized by us to recieve it or be copied or otherwise made use either in full or in part by such person or body without our prior permission in writing.

Outotec

The content of these documents are the sole property of Outotec Oyj. Any rights not expressly granted herein are reserved. Reproduction, transfer or distribution of part or all of the contents in any form without prior written permission of Outotec is prohibited.

MA'ADEN معادن
Saudi Arabian Mining Company شركة التعدين العربية السعودية

This document and the information contained herein is Ma'aden proprietary know-how. This document or any part thereof should not be reproduced, stored in a retrieval system or transmitted by any means, electronic or otherwise, or divulged without prior written permission of Ma'aden.

LARSEN & TOUBRO DRAWING NUMBER		REVISION 2
OUTOTEC DRAWING NUMBER 900707_GAU01_AG11_CTB01_49033	DOCUMENT ID OU100745540	REVISION 2

DRAWN	NanWu	16.02.2022
CHECKED	MauNot	16.02.2022
ENGINEER	NanWu	16.02.2022
APPROVED	LuiPiz	16.02.2022
EMPLOYER		
SCALE	1:120	A0

MANSOURAH - MASSARAH GOLD PROJECT
49W1 RAW WATER TREATMENT PLANT
SUMP PUMP PIT
DIMENSIONAL- AND REINFORCEMENT DRAWING

DRAWING NUMBER MD-216-49W1-EG-CV-DED-1033

REV D01

Tekla Structures