


REV	DRAWING NUMBER
D01	MD-216-49W1-EG-CV-DED-1034

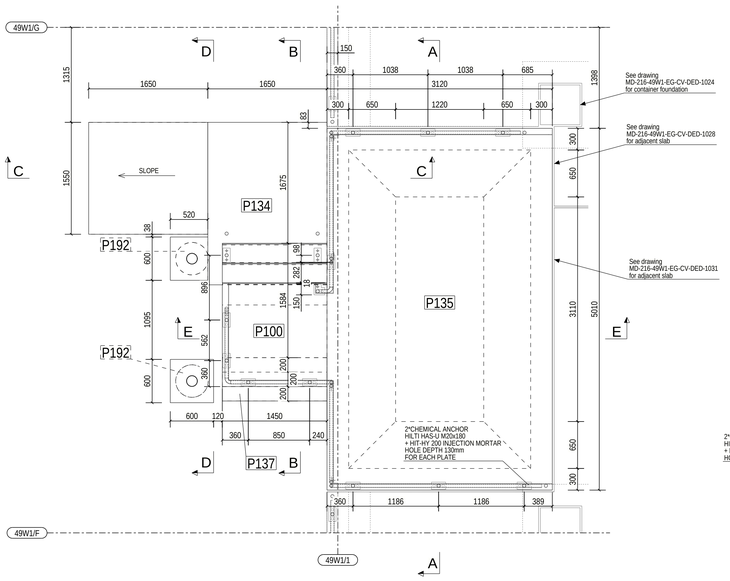


R.C.C CONTAINER PLATFORM AND STAIRS DIMENSIONS
(SCALE 1:30)

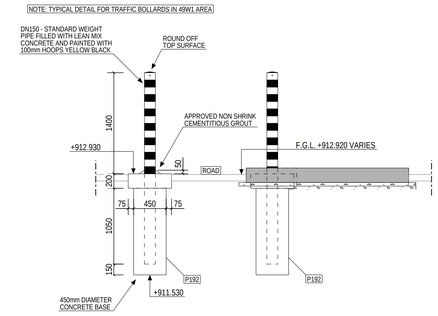


SECTION : D - D
(SCALE 1:30)

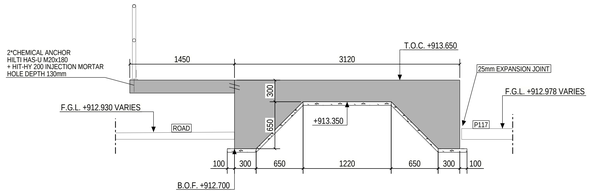


SECTION : E - E
(SCALE 1:30)

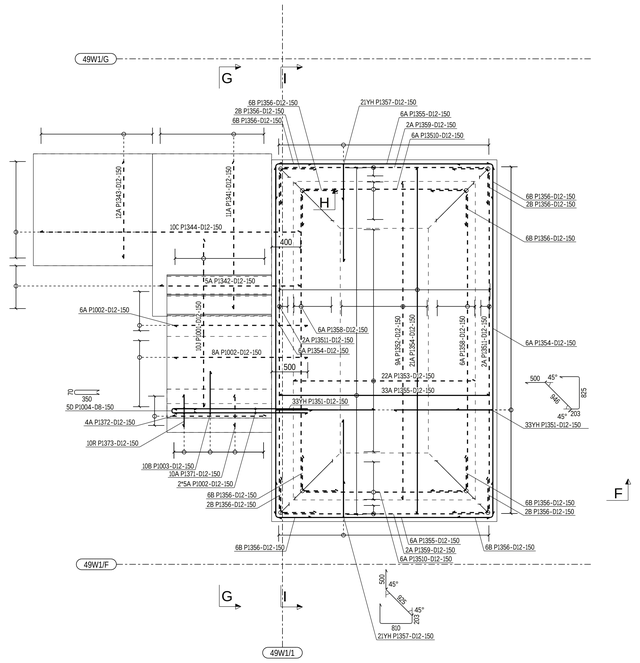


R.C.C CONTAINER PLATFORM AND STAIRS REINFORCEMENT
(SCALE 1:30)

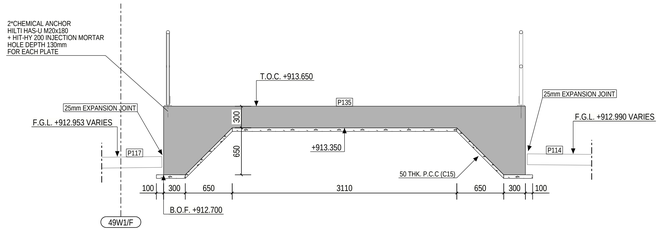


SECTION : A - A
(SCALE 1:30)

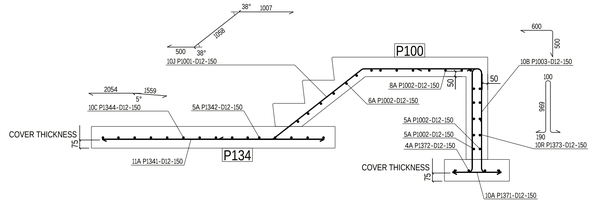


SECTION : G - G
(SCALE 1:20)

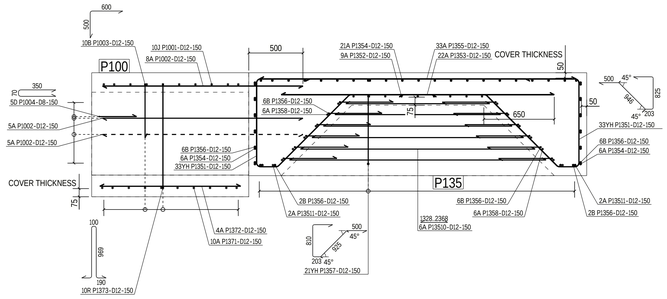


SECTION : F - F
(SCALE 1:20)

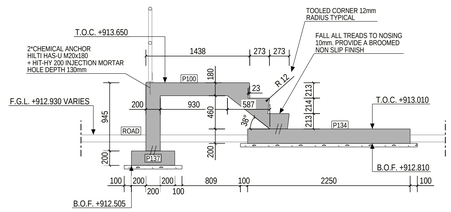


SECTION : B - B
(SCALE 1:30)

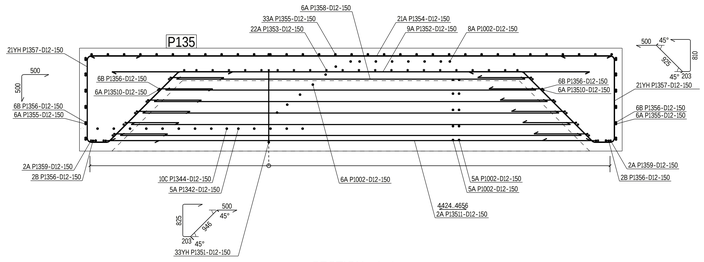


SECTION : I - I
(SCALE 1:20)

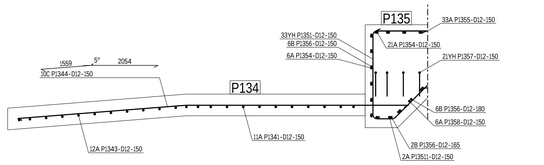


SECTION : H - H
(SCALE 1:20)

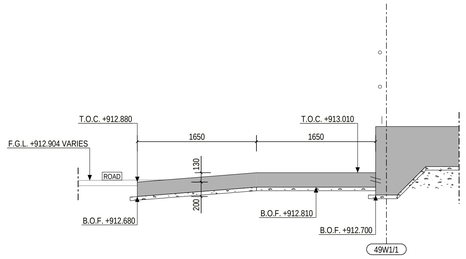

SECTION : C - C
(SCALE 1:30)

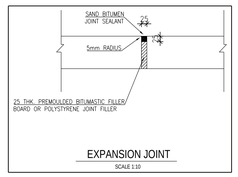

EXPANSION JOINT
SCALE 1:10

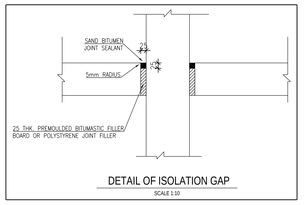

DETAIL OF ISOLATION GAP
SCALE 1:10

CONCRETE INFORMATION

Concretes used	C35	
Concrete cover 1	75±10mm	BOTTOM OF SLAB AND PLATFORM
Concrete cover 2	50±10mm	STAIRS, SIDES AND TOP OF PLATFORM

REINFORCING BAR LIST — CAST UNIT CODE: P100 — PCS: 1

REINFORCING BARS TYPE	POS	PCS	GRADE	D [mm]	L [mm]	dL [mm]	WEIGHT SUM [kg]	BENDING DIMENSIONS [mm] a	b	c	d	e	u	v	x	TD	COMMENT
J	P1001	10	B500B	12	2550		22.7	1007	1058	500					38		60	
A	P1002	24	B500B	12	1850		39.4	1850										
B	P1003	10	B500B	12	1070		9.5	500	600						90		60	
D	P1004	5	B500B	8	730		1.4	350	70	350							32	

REINFORCING BAR TOTAL WEIGHT [kg] 73.1

REINFORCING BAR LIST — CAST UNIT CODE: P134 — PCS: 1

REINFORCING BARS TYPE	POS	PCS	GRADE	D [mm]	L [mm]	dL [mm]	WEIGHT SUM [kg]	BENDING DIMENSIONS [mm] a	b	c	d	e	u	v	x	TD	COMMENT
A	P1341	11	B500B	12	2050		20.0	2050									
A	P1342	5	B500B	12	1950		8.7	1950									
A	P1343	12	B500B	12	1350		14.4	1350									
C	P1344	10	B500B	12	3610		32.1	2054	1559						5		60	

REINFORCING BAR TOTAL WEIGHT [kg] 75.1

REINFORCING BAR LIST — CAST UNIT CODE: P135 — PCS: 1

REINFORCING BARS TYPE	POS	PCS	GRADE	D [mm]	L [mm]	dL [mm]	WEIGHT SUM [kg]	BENDING DIMENSIONS [mm] a	b	c	d	e	u	v	x	TD	COMMENT
YH	P1351	66	B500B	12	2900		170.0	500	825	203	946	500	45			60	
A	P1352	9	B500B	12	4410		35.2	4410									
A	P1353	22	B500B	12	2520		49.2	2520									
A	P1354	33	B500B	12	4810		140.9	4810									
A	P1355	45	B500B	12	2920		116.7	2920									
B	P1356	56	B500B	12	970		49.2	500	500						90		60	
YH	P1357	42	B500B	12	2860		106.8	500	810	203	925	500	45			60	
A	P1358	12	B500B	12	4250		39.8	4258									
62	AT GROUP	6	PCS	...	3210	208	...	3218									
A	P1359	4	B500B	12	2760		9.4	2766									
2	AT GROUP	2	PCS	...	2530	230	...	2534									
A	P13510	12	B500B	12	2360		19.7	2368									
2	AT GROUP	6	PCS	...	1320	208	...	1328									
A	P13511	4	B500B	12	4650		16.1	4656									
2	AT GROUP	2	PCS	...	4420	230	...	4424									

REINFORCING BAR TOTAL WEIGHT [kg] 752.2


REINFORCING BAR LIST — CAST UNIT CODE: P137 — PCS: 1

REINFORCING BARS TYPE	POS	PCS	GRADE	D [mm]	L [mm]	dL [mm]	WEIGHT SUM [kg]	BENDING DIMENSIONS [mm] a	b	c	d	e	u	v	x	TD	COMMENT
A	P1371	10	B500B	12	450		4.0	450									
A	P1372	4	B500B	12	1300		4.6	1300									
R	P1373	10	B500B	12	2290		20.4	190	969	100	969	190					60	

REINFORCING BAR TOTAL WEIGHT [kg] 29.0

REINFORCING BAR LIST — CAST UNIT CODE: P192 — PCS: 2


REINFORCEMENT BENDING SHAPES:

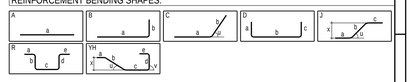

LEGEND:
- R.L - REDUCED LEVEL
- T.O.C. - TOP OF CONCRETE
- B.O.F. - BOTTOM OF FOUNDATION
- F.G.L. - FINISHED GROUND LEVEL
- P.C.C. - PLAIN CEMENT CONCRETE
- TYP - TYPICAL
- MKD - MARKED
- CL - CENTER LINE
- BOTTOM REINF. (B)
- TOP REINF. (T)
- SBC - SAFE BEARING CAPACITY
- MIN. - MINIMUM
- REF. - REFERED
- GA - GENERAL ARRANGEMENT
- DWG. - DRAWING
- R.C.C. - REINFORCED CEMENT CONCRETE
- CONSTRUCTION JOINT

NOTES:
1. ALL DIMENSIONS ARE IN MILLIMETRES AND LEVELS ARE IN METRES UNLESS OTHERWISE STATED
2. GRADE OF CONCRETE SHALL BE C35 (35MPa) UNLESS NOTED OTHERWISE & C15 (15MPa) FOR BLINDING CONCRETE.
3. GRADE OF REINFORCEMENT SHALL BE DEFORMED BAR ASTM A615-GRADE 60 (fy=420MPa)
4. CLEAR COVER TO MAIN REINFORCEMENT SHALL BE AS FOLLOWS:
   a) FOUNDATION: 75 mm (BOTTOM & SIDE)
   b) FOUNDATION: 50 mm (TOP)
   c) COLUMN & PEDESTAL: 50 mm
5. MINIMUM LAP LENGTHS OF REINFORCEMENT SHALL BE 40XBAR DIAMETER
6. FOR STANDARD REINFORCEMENT DETAILS & GENERAL NOTES FOR CIVIL WORKS REFER TO DRAWING NUMBER MD-216-1000-EG-CV-DED-1005 & 1001
7. ANCHOR BOLTS AND EMBEDDED STEELWORK SHALL BE HOT DIP GALVANIZED
8. T.O.C. & TOP OF SCREED TOLERANCE SHALL BE WITHIN +/- 10MM OF DESIGN LEVEL
9. NET SAFE BEARING CAPACITY OF SOIL AT BOTTOM OF FOUNDATION IS CONSIDERED AS 375 KN/SQ.M
10. REBARS CAN BE MOVED LOCALLY BY +/- 25mm TO AVOID INTERFERENCE WITH EMBEDDED PARTS

KEYPLAN

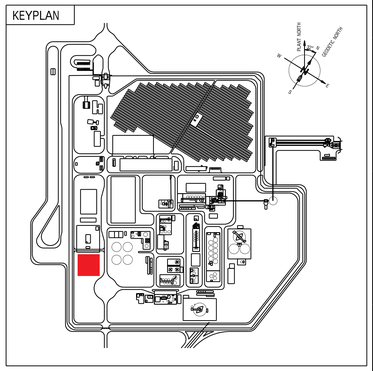

MD-216-49W1-EG-CV-DED-1028	SLAB SECTOR GL G-J/1-5 DETAIL- AND REINFORCEMENT DRAWING	MD-216-49W1-EG-CV-DED-1031	SLAB SECTOR GL D-G/1-4 DETAIL- AND REINFORCEMENT DRAWING
MD-10L-SMEM-EG-ST-DST-0001	CONCRETE STUCTURAL STANDARDS	MD-216-49W1-EG-CV-DED-1024	CONTAINER FOUNDATIONS DETAIL- AND REINFORCEMENT DRAWING
MD-216-49W1-EG-CV-GAD-1003	1-J/1A-E GENERAL ARRANGEMENT DRAWING	MD-216-1000-EG-ST-CRT-1001	DESIGN CRITERIA
MD-216-49W1-EG-CV-GAD-1001	1-B/E-J GENERAL ARRANGEMENT DRAWING	MD-216-49W1-EG-CV-GAD-1002	7-12/D-J GENERAL ARRANGEMENT DRAWING

DOCUMENT NUMBER | REFERENCE DOCUMENTS | DOCUMENT NUMBER | REFERENCE DOCUMENTS

REV	DATE	REVISION DESCRIPTION	DRN	CHK	ENG	APP	EMP
D01	29.01.2024	AS-BUILT	JonRen	MauNot	NamWu	LuiPiz	
C01	01.03.2022	ISSUED FOR CONSTRUCTION	JonRen	MauNot	NamWu	LuiPiz	
A01	10.02.2022	ISSUED FOR APPROVAL	JonRen	MauNot	NamWu	LuiPiz	

RESERVED FOR VENDOR LOGO AND DRAWING NUMBER

LARSEN & TOUBRO

This drawing is the property of LARSEN & TOUBRO and must not be passed on to any person or body not authorized by us to receive it or be copied or otherwise made use either in full or in part by such person or body without our prior permission in writing.

Outotec

The content of these documents are the sole property of Outotec Oyj. Any rights not expressly granted herein are reserved. Reproduction, transfer or distribution of part or all of the contents in any form without prior written permission of Outotec is prohibited.

MA'ADEN معادن — Saudi Arabian Mining Company — شركة معادن العربية السعودية

This document and the information contained herein is Ma'aden proprietary know-how. This document or any part thereof should not be reproduced, stored in a retrieval system or transmitted by any means, electronic or otherwise, or divulged without prior written permission of Ma'aden.

LARSEN & TOUBRO DRAWING NUMBER: REVISION 2

OUTOTEC DRAWING NUMBER: 900707_GAU01_AG11_CTB01_49034 | DOCUMENT ID: OU100745541 | REVISION 2

DRAWN	JonRen	10.02.2022
CHECKED	MauNot	10.02.2022
ENGINEER	NamWu	10.02.2022
APPROVED	LuiPiz	10.02.2022
EMPLOYER		
SCALE		A0

MANSOURAH - MASSARAH GOLD PROJECT
49W1 RAW WATER TREATMENT PLANT
CONTAINER PLATFORM AND STAIRS
DETAIL- AND REINFORCEMENT DRAWING

DRAWING NUMBER: MD-216-49W1-EG-CV-DED-1034 | REV: D01