

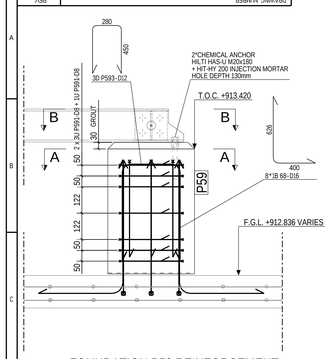



FOUNDATION P59 REINFORCEMENT
(SCALE 1:10)

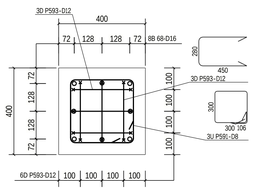


SECTION : A - A
(SCALE 1:10)

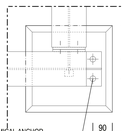


SECTION : B - B
(SCALE 1:10)

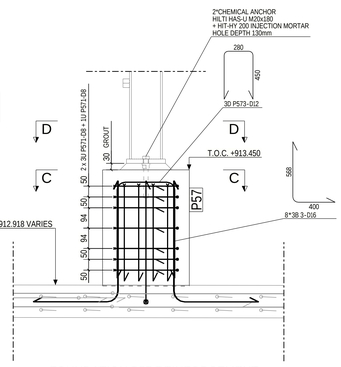


FOUNDATION P57 REINFORCEMENT
(SCALE 1:10)

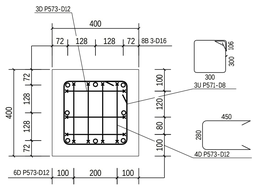


SECTION : C - C
(SCALE 1:10)

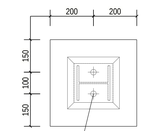


SECTION : D - D
(SCALE 1:10)

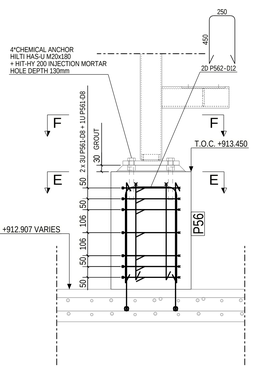


FOUNDATION P56 REINFORCEMENT
(SCALE 1:10)

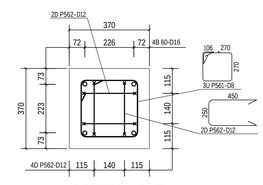


SECTION : E - E
(SCALE 1:10)

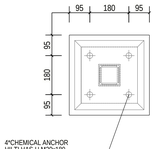


SECTION : F - F
(SCALE 1:10)

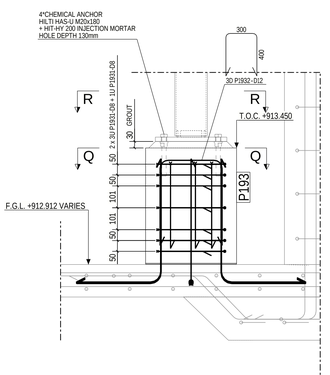


FOUNDATION P193 REINFORCEMENT
(SCALE 1:10)

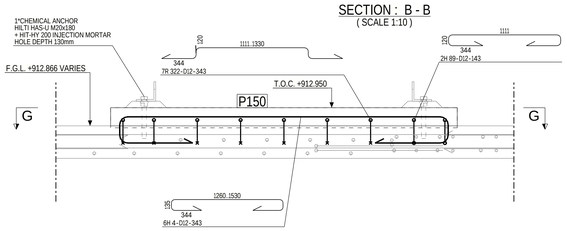


STAIR LANDING P150 REINFORCEMENT
(SCALE 1:10)

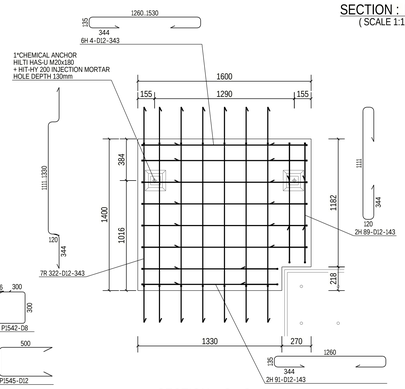


SECTION : G - G
(SCALE 1:20)

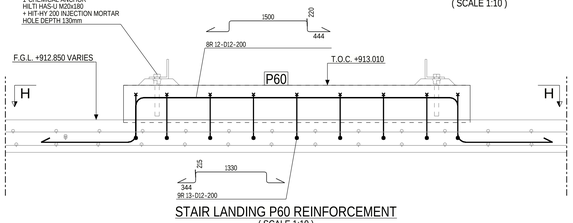


STAIR LANDING P60 REINFORCEMENT
(SCALE 1:10)

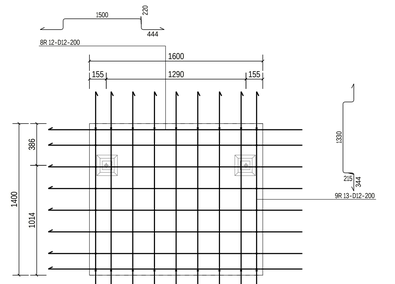


SECTION : H - H
(SCALE 1:20)

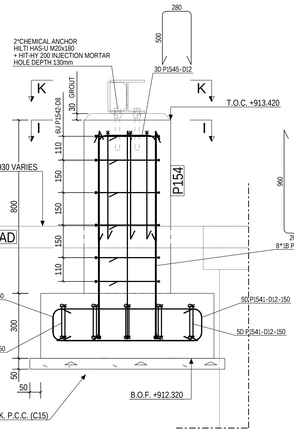


FOUNDATION P154 REINFORCEMENT
(SCALE 1:10)

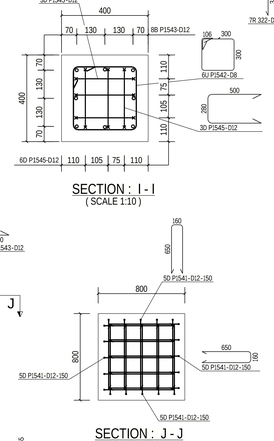

SECTION : I - I
(SCALE 1:10)

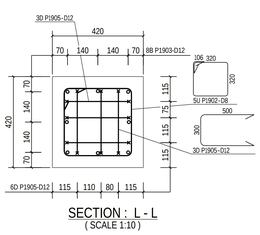


SECTION : L - L
(SCALE 1:10)

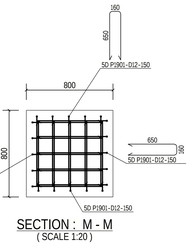


SECTION : M - M
(SCALE 1:20)


SECTION : J - J
(SCALE 1:20)

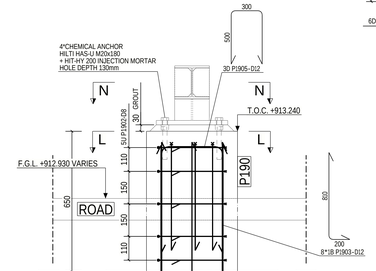


FOUNDATION P190 REINFORCEMENT
(SCALE 1:10)

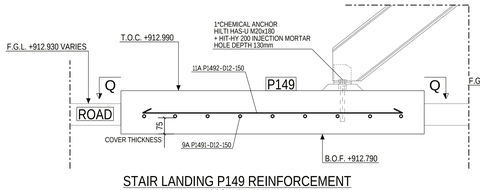


STAIR LANDING P149 REINFORCEMENT
(SCALE 1:10)

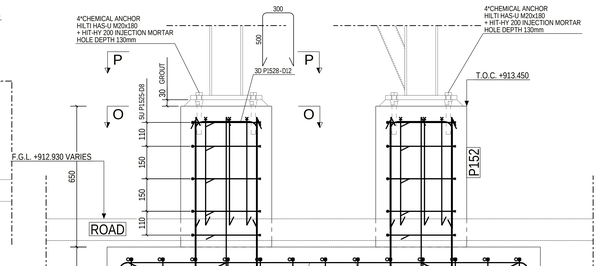


FOUNDATION P152 REINFORCEMENT
(SCALE 1:10)

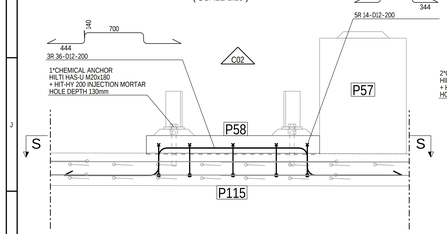


LADDER PLATFORM P58 REINFORCEMENT
(SCALE 1:10)

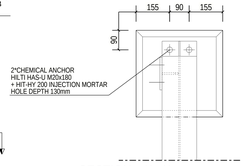


SECTION : K - K
(SCALE 1:10)

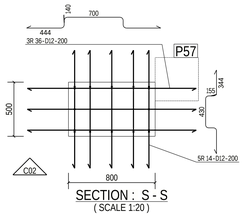


SECTION : S - S
(SCALE 1:20)

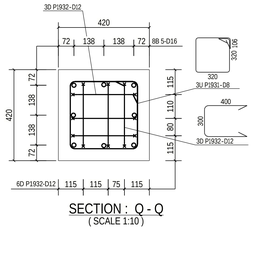


SECTION : Q - Q
(SCALE 1:10)

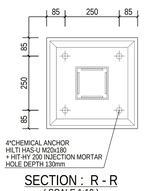


SECTION : R - R
(SCALE 1:10)

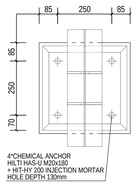


SECTION : N - N
(SCALE 1:10)

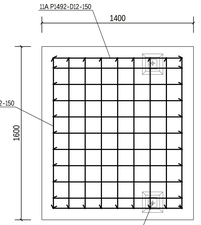

SECTION : Q - Q
(SCALE 1:20)

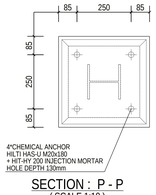

SECTION : P - P
(SCALE 1:10)

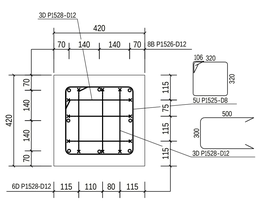

SECTION : O - O
(SCALE 1:10)

CONCRETE INFORMATION

Concretes used	C35
Concrete cover 1	50x10mm

REINFORCING BAR LIST — CAST UNIT CODE: P56 — PCS: 1

TYPE	POS	PCS	GRADE	D [mm]	L [mm]	dL [mm]	WEIGHT SUM [kg]	a	b	c	d	e	u	v	x	TD	COMMENT
U	P561	7	B500B	8	1190		3.3	106	270	270	270	270				32	
D	P562	4	B500B	12	1090		3.9	450	250	450						60	

REINFORCING BAR TOTAL WEIGHT [kg] 7.2

REINFORCING BAR LIST — CAST UNIT CODE: P57 — PCS: 1

TYPE	POS	PCS	GRADE	D [mm]	L [mm]	dL [mm]	WEIGHT SUM [kg]	a	b	c	d	e	u	v	x	TD	COMMENT
U	P571	7	B500B	8	1310		3.6	106	300	300	300	300				32	
D	P573	7	B500B	12	1120		7.0	450	280	450						60	

REINFORCING BAR TOTAL WEIGHT [kg] 10.6

REINFORCING BAR LIST — CAST UNIT CODE: P58 — PCS: 1

REINFORCING BAR LIST — CAST UNIT CODE: P59 — PCS: 1

TYPE	POS	PCS	GRADE	D [mm]	L [mm]	dL [mm]	WEIGHT SUM [kg]	a	b	c	d	e	u	v	x	TD	COMMENT
U	P591	7	B500B	8	1310		3.6	106	300	300	300	300				32	
D	P593	6	B500B	12	1120		6.0	450	280	450						60	

REINFORCING BAR TOTAL WEIGHT [kg] 9.6

REINFORCING BAR LIST — CAST UNIT CODE: P60 — PCS: 1

REINFORCING BAR LIST — CAST UNIT CODE: P149 — PCS: 1

TYPE	POS	PCS	GRADE	D [mm]	L [mm]	dL [mm]	WEIGHT SUM [kg]	a	b	c	d	e	u	v	x	TD	COMMENT
A	P1491	9	B500B	12	1400		11.2	1400									
A	P1492	11	B500B	12	1200		11.7	1200									

REINFORCING BAR TOTAL WEIGHT [kg] 22.9

REINFORCING BAR LIST — CAST UNIT CODE: P150 — PCS: 1

REINFORCING BAR LIST — CAST UNIT CODE: P152 — PCS: 1

TYPE	POS	PCS	GRADE	D [mm]	L [mm]	dL [mm]	WEIGHT SUM [kg]	a	b	c	d	e	u	v	x	TD	COMMENT
H	P1521	12	B500B	12	3100		33.0	500	160	1900	160	500				60	
H	P1522	13	B500B	12	2900		33.5	500	160	1700	160	500				60	
A	P1523	12	B500B	12	1800		19.2	1800									
A	P1524	13	B500B	12	1600		18.5	1600									
U	P1525	10	B500B	8	1390		5.5	106	320	320	320	320				32	
B	P1526	16	B500B	12	980		13.9	200	810				90			60	
D	P1528	12	B500B	12	1240		13.2	500	300	500						60	

REINFORCING BAR TOTAL WEIGHT [kg] 136.8

REINFORCING BAR LIST — CAST UNIT CODE: P154 — PCS: 1

TYPE	POS	PCS	GRADE	D [mm]	L [mm]	dL [mm]	WEIGHT SUM [kg]	a	b	c	d	e	u	v	x	TD	COMMENT
D	P1541	20	B500B	12	1400		24.9	650	160	650						60	
U	P1542	6	B500B	8	1310		3.1	106	300	300	300	300				32	
B	P1543	8	B500B	12	1130		8.0	200	960				90			60	
D	P1545	6	B500B	12	1220		6.5	500	280	500						60	

REINFORCING BAR TOTAL WEIGHT [kg] 42.5

REINFORCING BAR LIST — CAST UNIT CODE: P190 — PCS: 1

TYPE	POS	PCS	GRADE	D [mm]	L [mm]	dL [mm]	WEIGHT SUM [kg]	a	b	c	d	e	u	v	x	TD	COMMENT
D	P1901	20	B500B	12	1400		24.9	650	160	650						60	
U	P1902	5	B500B	8	1390		2.8	106	320	320	320	320				32	
B	P1903	8	B500B	12	980		7.0	200	810				90			60	
D	P1905	6	B500B	12	1240		6.6	500	300	500						60	

REINFORCING BAR TOTAL WEIGHT [kg] 41.2

REINFORCING BAR LIST — CAST UNIT CODE: P193 — PCS: 1

TYPE	POS	PCS	GRADE	D [mm]	L [mm]	dL [mm]	WEIGHT SUM [kg]	a	b	c	d	e	u	v	x	TD	COMMENT
U	P1931	14	B500B	8	1390		7.7	106	320	320	320	320				32	
D	P1932	6	B500B	12	1040		5.5	400	300	400						60	

REINFORCING BAR TOTAL WEIGHT [kg] 13.3

REINFORCEMENT BENDING SHAPES:




LEGEND:

R.L - REDUCED LEVEL
T.O.C. - TOP OF CONCRETE
B.O.F. - BOTTOM OF FOUNDATION
F.G.L. - FINISHED GROUND LEVEL
P.C.C. - PLAIN CEMENT CONCRETE
TYP - TYPICAL
MKD - MARKED
CL - CENTER LINE
BOTTOM REINF. (B)
TOP REINF. (T)
SBC - SAFE BEARING CAPACITY
MIN. - MINIMUM
REF. - REFERED
GA - GENERAL ARRANGEMENT
DWG. - DRAWING
R.C.C. - REINFORCED CEMENT CONCRETE

NOTES:

1. ALL DIMENSIONS ARE IN MILLIMETRES AND LEVELS ARE IN METRES UNLESS OTHERWISE STATED
2. GRADE OF CONCRETE SHALL BE C35 (35MPa) UNLESS NOTED OTHERWISE & C15 (15MPa) FOR BLINDING CONCRETE.
3. GRADE OF REINFORCEMENT SHALL BE DEFORMED BAR ASTM A615-GRADE 60 (fy=420MPa)
4. CLEAR COVER TO MAIN REINFORCEMENT SHALL BE AS FOLLOWS:
   a) FOUNDATION: 75 mm (BOTTOM & SIDE)
   b) FOUNDATION: 50 mm (TOP)
   c) COLUMN & PEDESTAL: 50 mm
5. MINIMUM LAP LENGTHS OF REINFORCEMENT SHALL BE 40XBAR DIAMETER
6. FOR STANDARD REINFORCEMENT DETAILS & GENERAL NOTES FOR CIVIL WORKS REFER TO DRAWING NUMBER MD-216-1000-EG-CV-DED-1005 & 1001
7. ANCHOR BOLTS AND EMBEDDED STEELWORK SHALL BE HOT DIP GALVANIZED
8. T.O.C. & TOP OF SCREED TOLERANCE SHALL BE WITHIN +/- 10MM OF DESIGN LEVEL
9. NET SAFE BEARING CAPACITY OF SOIL AT BOTTOM OF FOUNDATION IS CONSIDERED AS 275 KN/SQ.M.
10. REBARS CAN BE MOVED LOCALLY BY +/- 25mm TO AVOID INTERFERENCE WITH EMBEDDED PARTS

KEYPLAN

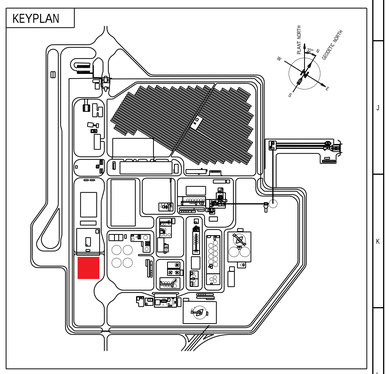

NOTE: LOCATION FOR STARTER BARS ARE SHOWN IN DRAWINGS:
MD-216-49W1-EG-CV-DED-1028 &
MD-216-49W1-EG-CV-DED-1027
AND NOT SHOWN IN REINFORCEMENT LIST

LOCATION FOR STRUCTURES IN GENERAL ARRANGEMENT DRAWINGS
MD-216-49W1-EG-CV-GAD-1001 &
MD-216-49W1-EG-CV-GAD-1002

DOCUMENT NUMBER	REFERENCE DOCUMENTS
MD-216-49W1-EG-CV-DED-1027	SLAB SECTOR GL G-J/5-10 DETAIL- AND REINFORCEMENT DRAWING
MD-101-SMEM-EG-ST-DST-0001	CONCRETE STUCTURAL STANDARDS
MD-216-49W1-EG-CV-GAD-1003	1-2/2-A- E GENERAL ARRANGEMENT DRAWING
MD-216-49W1-EG-CV-GAD-1001	1-8/E-J GENERAL ARRANGEMENT DRAWING

DOCUMENT NUMBER	REFERENCE DOCUMENTS
MD-216-49W1-EG-CV-DED-1028	SLAB SECTOR GL G-J/1-5 DETAIL- AND REINFORCEMENT DRAWING
MD-216-2000-EG-ST-CRT-1001	DESIGN CRITERIA
MD-216-49W1-EG-CV-GAD-1002	7-12/D-J GENERAL ARRANGEMENT DRAWING

REV	DATE	REVISION DESCRIPTION	DRN	CHK	ENG	APP	EMP
D01	29.01.2024	AS-BUILT	JonRen	MauNot	NanWu	LuiPiz	
C02	21.03.2022	LADDER PLATFORM P58 ADDED	JonRen	MauNot	NanWu	LuiPiz	
C01	01.03.2022	ISSUED FOR CONSTRUCTION	JonRen	MauNot	NanWu	LuiPiz	
A01	11.02.2022	ISSUED FOR APPROVAL	JonRen	MauNot	NanWu	LuiPiz	

RESERVED FOR VENDOR LOGO AND DRAWING NUMBER

LARSEN & TOUBRO

This drawing is the property of LARSEN & TOUBRO and must not be passed on to any person or body not authorized by us to receive it or be copied or otherwise made use either in full or in part by such person or body without our prior permission in writing.

Outotec

The content of these documents are the sole property of Outotec Oyj. Any rights not expressly granted herein are reserved. Reproduction, transfer or distribution of part or all of the contents in any form without prior written permission of Outotec is prohibited.

MA'ADEN معادن
Saudi Arabian Mining Company شركة معادن العربية السعودية

This document and the information contained herein is Ma'aden proprietary know-how. This document or any part thereof should not be reproduced, stored in a retrieval system or transmitted by any means, electronic or otherwise, or divulged without prior written permission of Ma'aden.

LARSEN & TOUBRO DRAWING NUMBER	REVISION 3
OUTOTEC DRAWING NUMBER 900707_GAU01_AG11_CTB01_49035	DOCUMENT © OU100745542 — REVISION 3

DRAWN	JonRen	11.02.2022
CHECKED	MauNot	11.02.2022
ENGINEER	NanWu	11.02.2022
APPROVED	LuiPiz	11.02.2022
EMPLOYER		
SCALE	1:10	A0

MANSOURAH - MASSARAH GOLD PROJECT
49W1 RAW WATER TREATMENT PLANT
SEC. PLATFORMS, STAIR AND PEDESTAL FOUNDATION 1
DETAIL- AND REINFORCEMENT DRAWING

DRAWING NUMBER MD-216-49W1-EG-CV-DED-1035 — REV D01