MD-216-49W1-EG-CV-DED-1036
DRAWING NUMBER
REV
D01

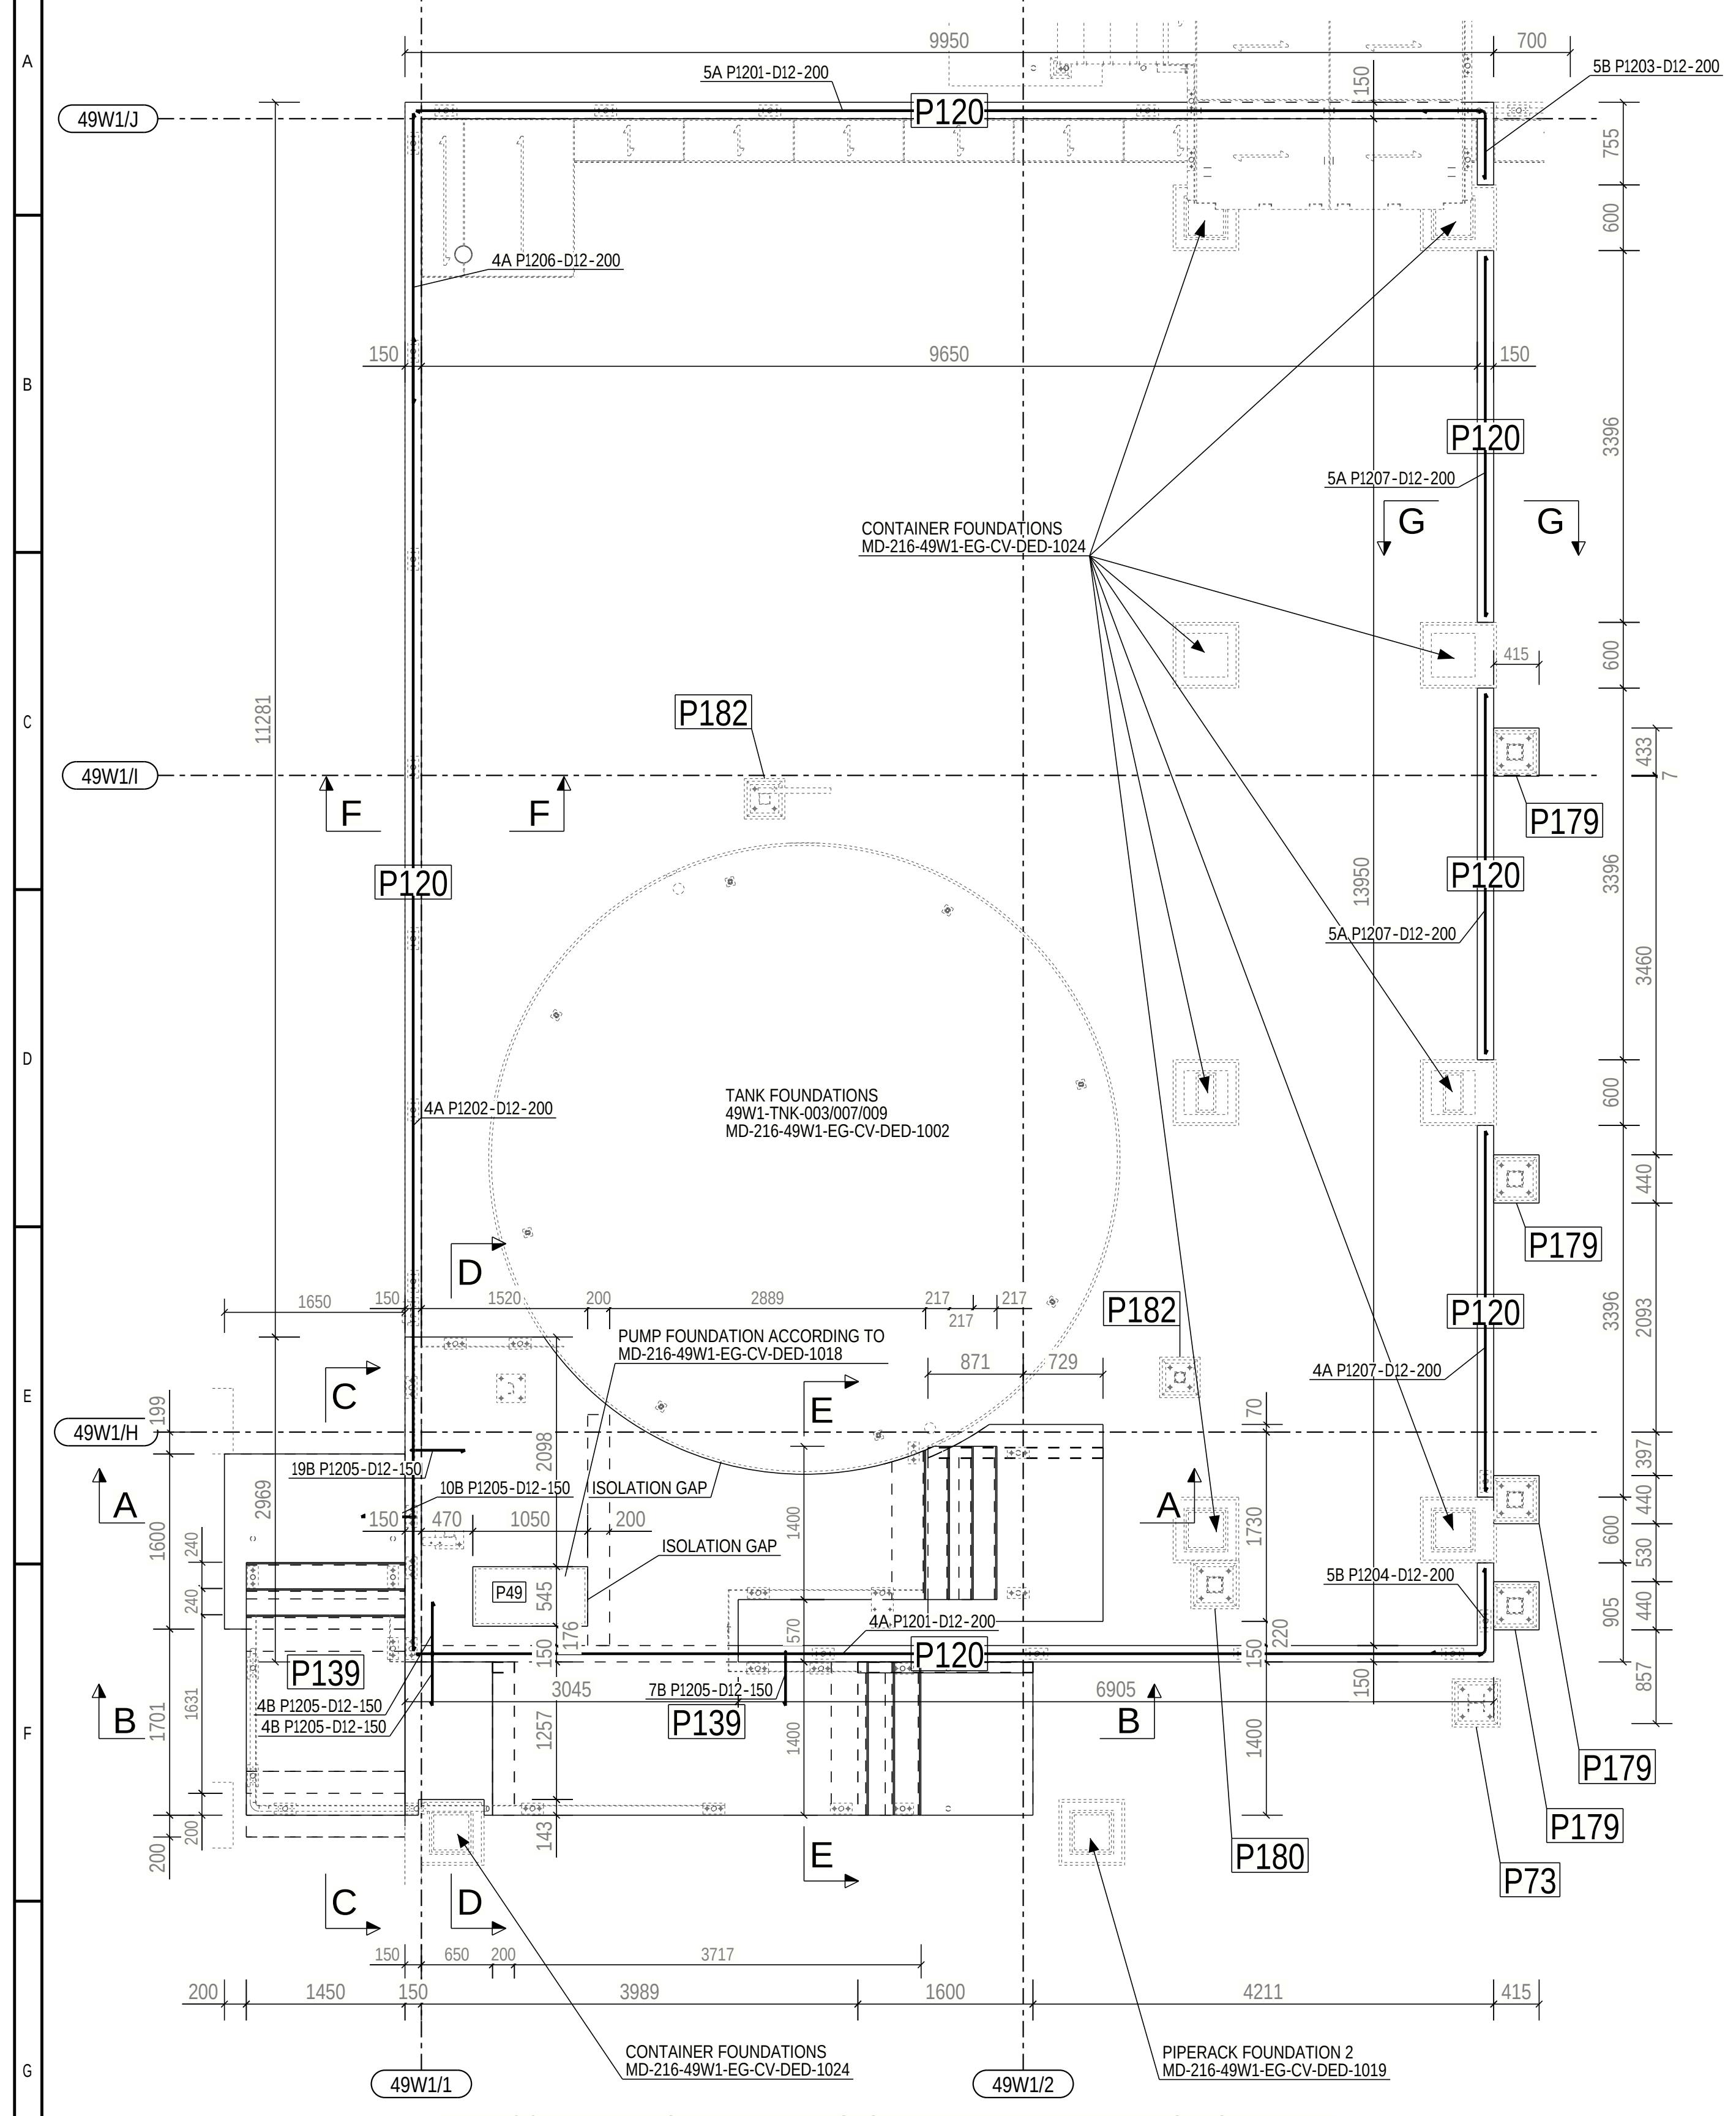

TNK 007 PLATFORM DIMENSION AND WALL REINFORCEMENT
(SCALE 1:50)

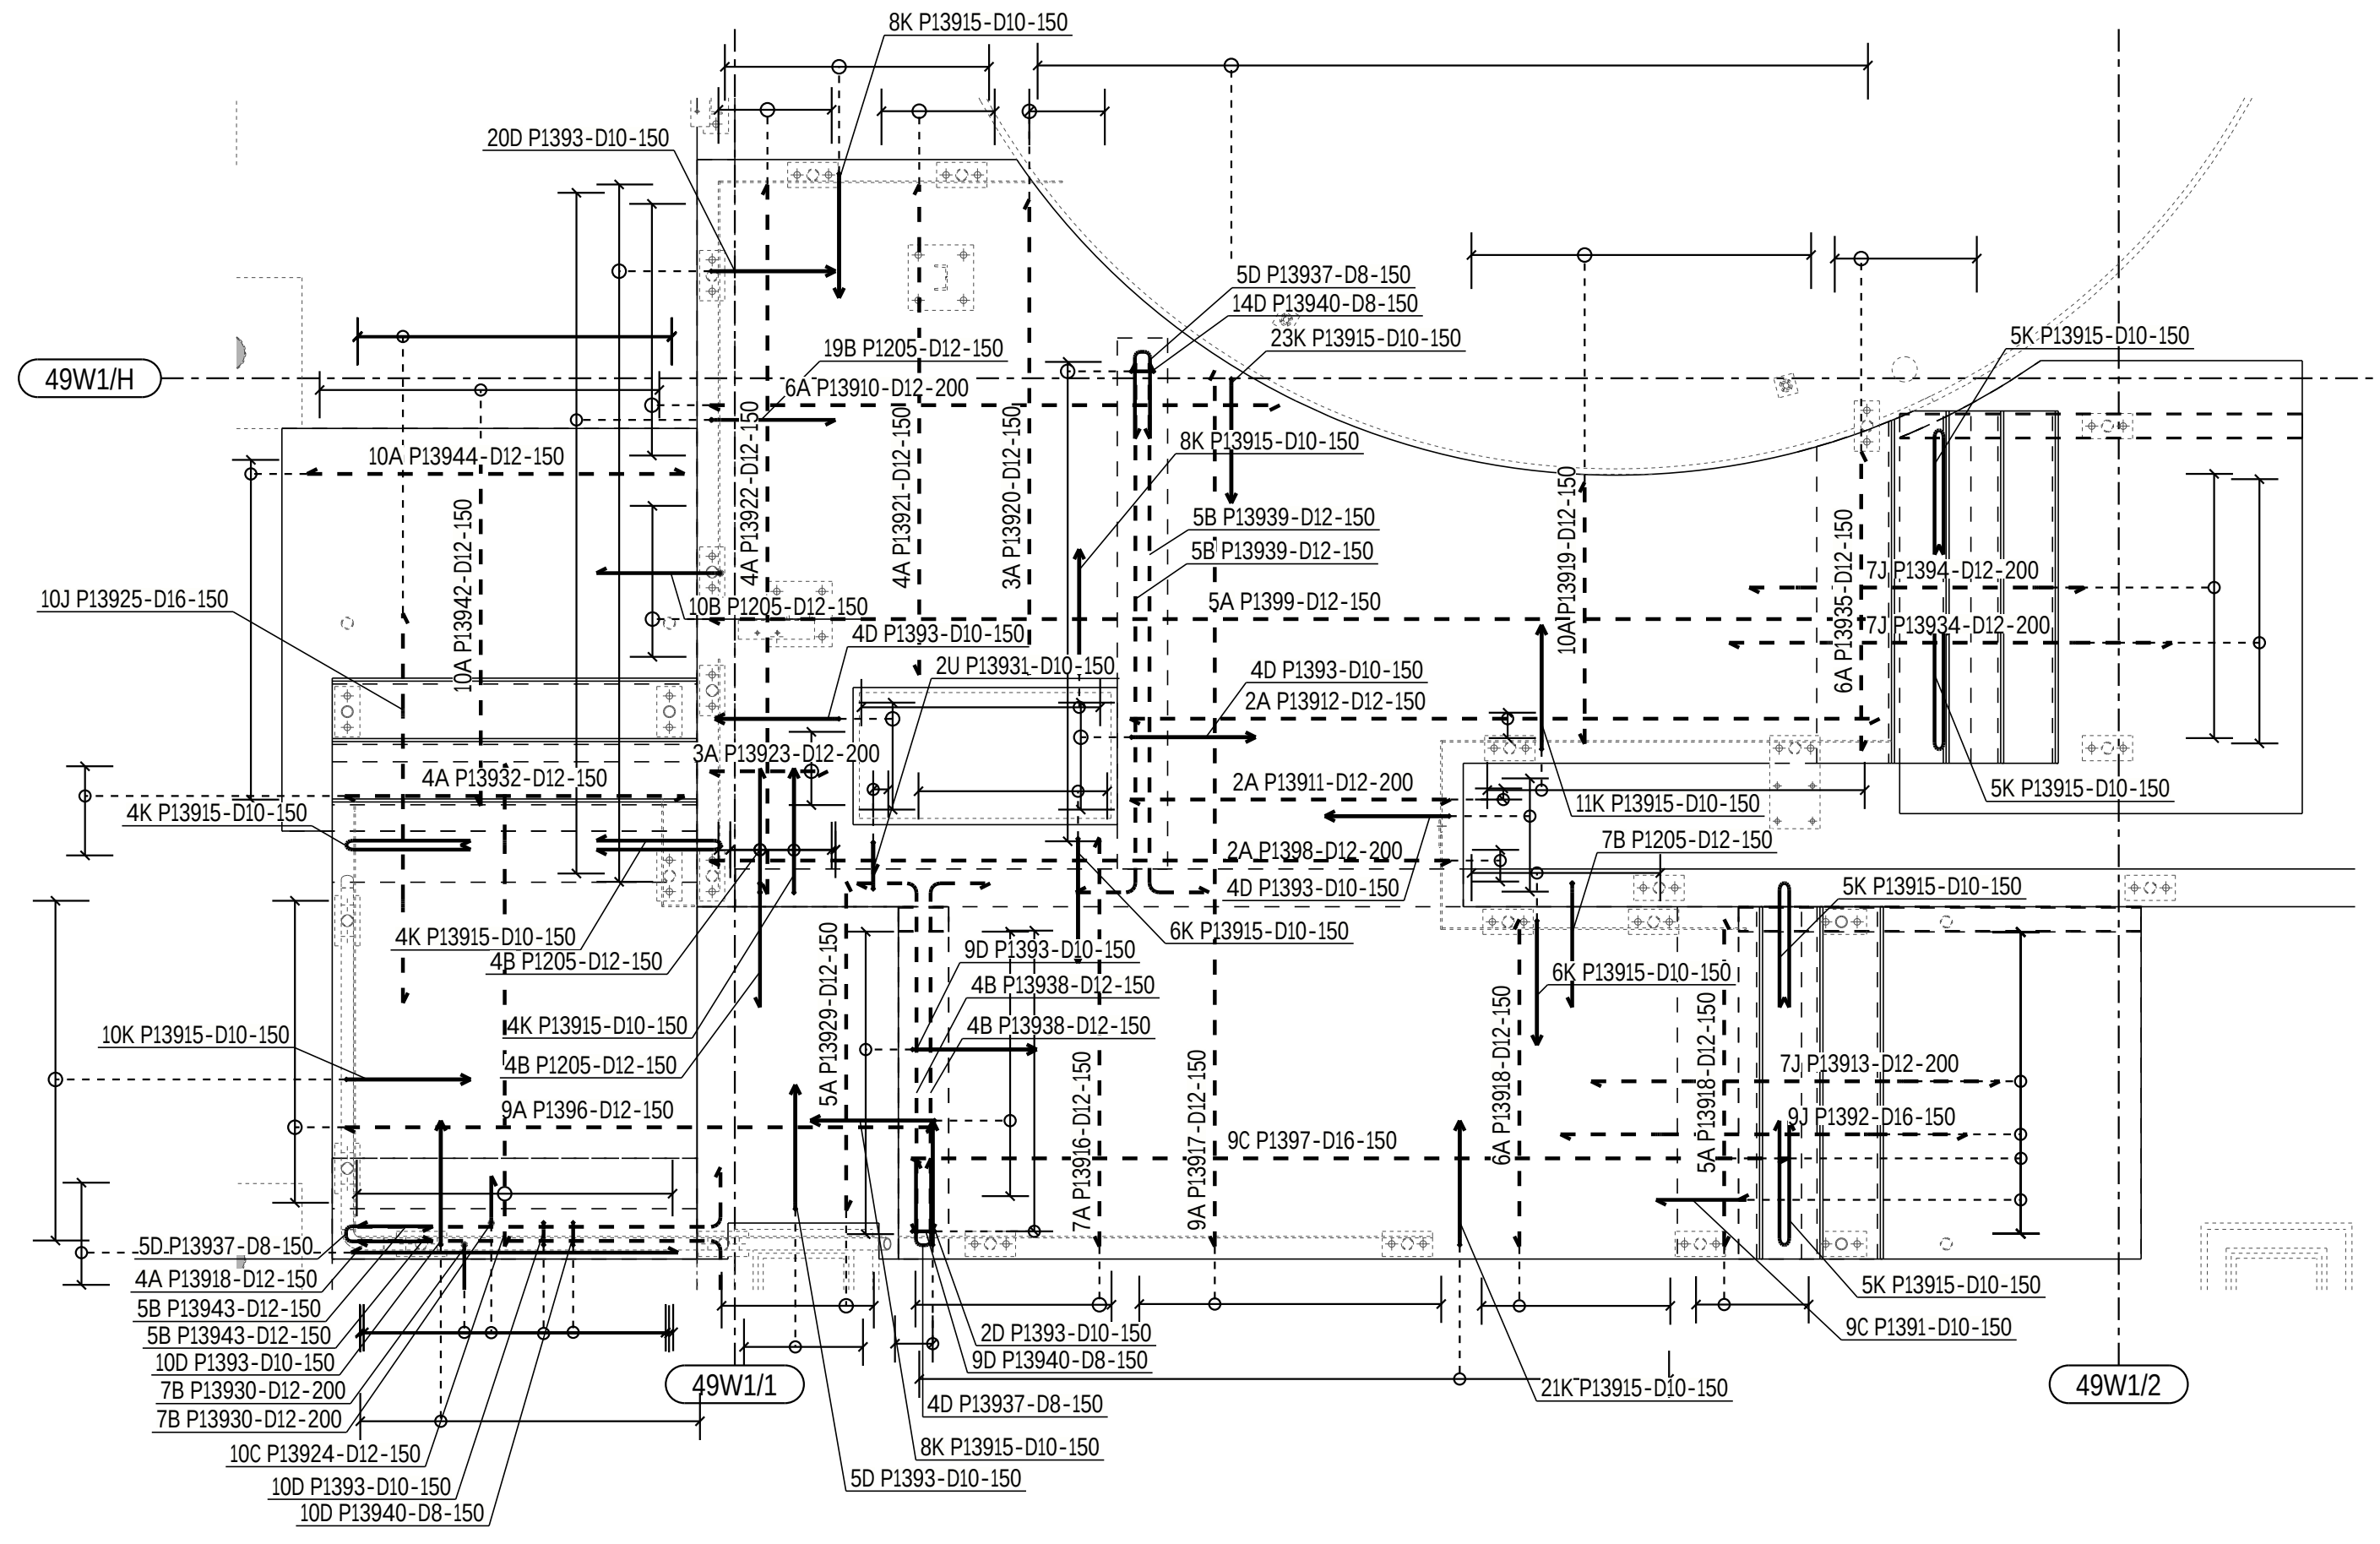

R.C.C PLATFORM BOTTOM REINFORCEMENT
(SCALE 1:30)

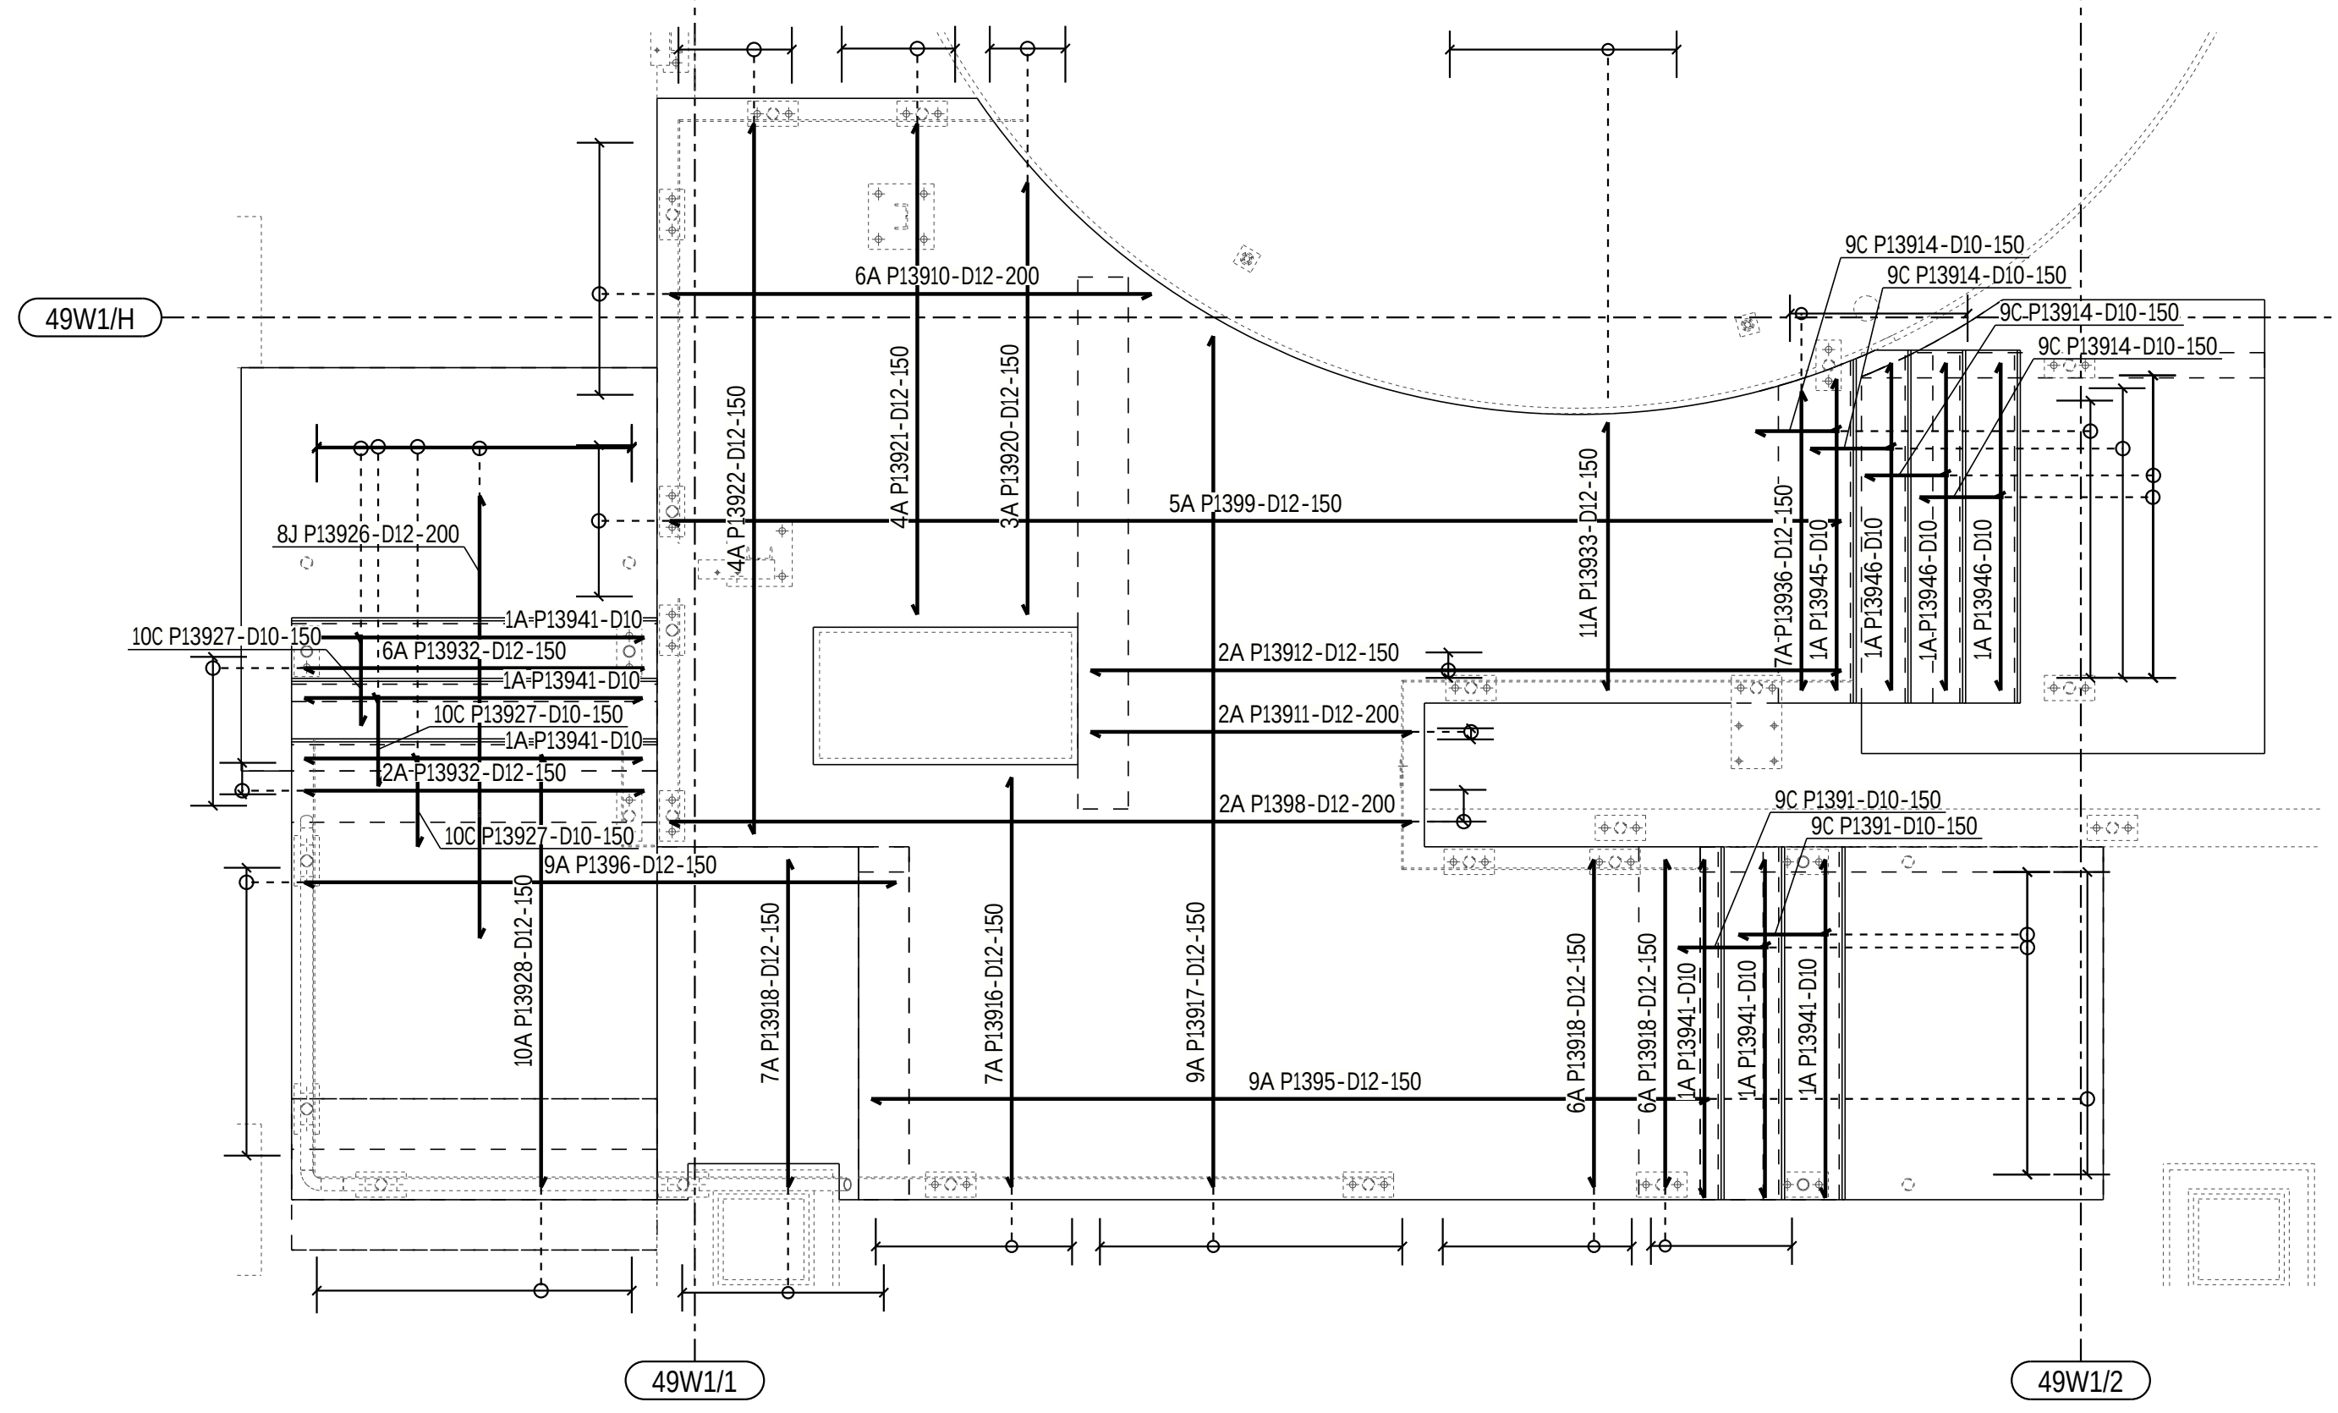

R.C.C PLATFORM TOP REINFORCEMENT
(SCALE 1:30)

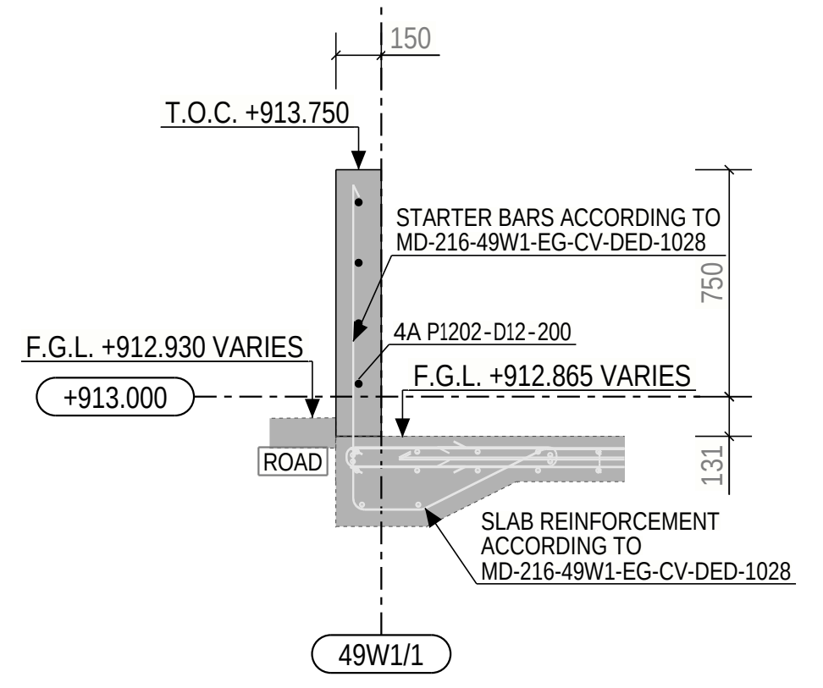
T.O.C. +913.750
STARTER BARS ACCORDING TO
MD-216-49W1-EG-CV-DED-1028
F.G.L. +912.930 VARIES
+913.000
F.G.L. +912.865 VARIES
ROAD
SLAB REINFORCEMENT ACCORDING TO
MD-216-49W1-EG-CV-DED-1028
49W1/1

SECTION : F - F
(SCALE 1:25)

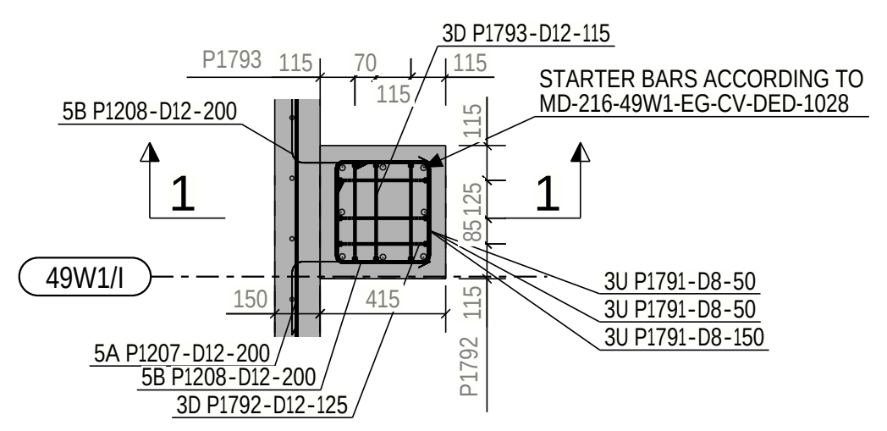

FOUNDATION P179 REINFORCEMENT
(SCALE 1:25)

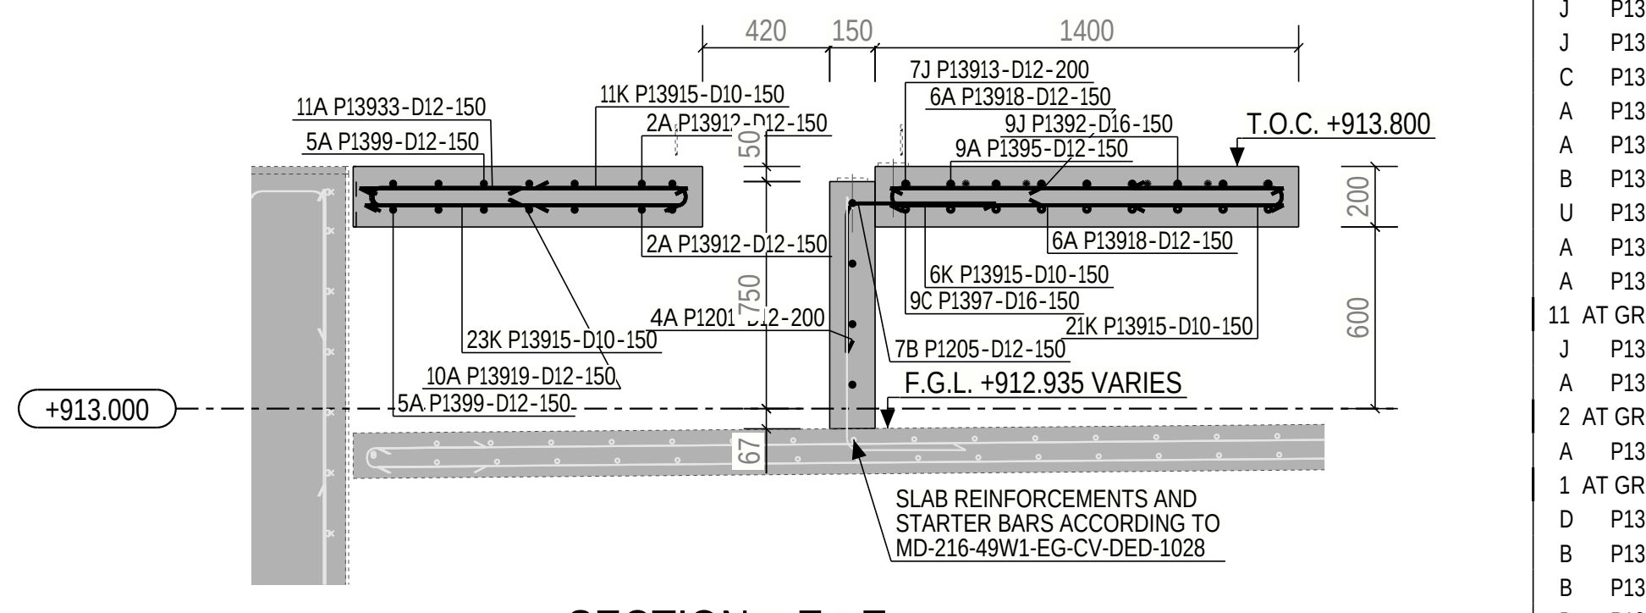

SECTION : E - E
(SCALE 1:25)

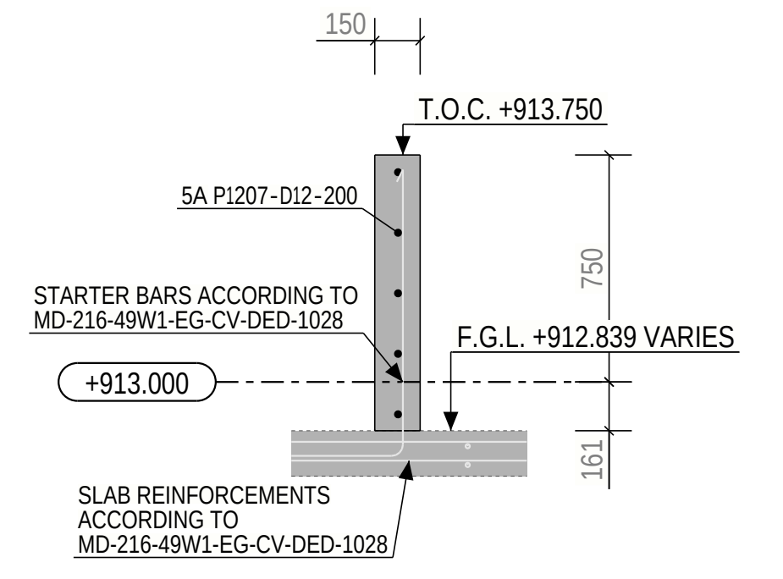
T.O.C. +913.750
STARTER BARS ACCORDING TO
MD-216-49W1-EG-CV-DED-1028
F.G.L. +912.839 VARIES
+913.000
SLAB REINFORCEMENTS
ACCORDING TO
MD-216-49W1-EG-CV-DED-1028

SECTION : G - G
(SCALE 1:25)

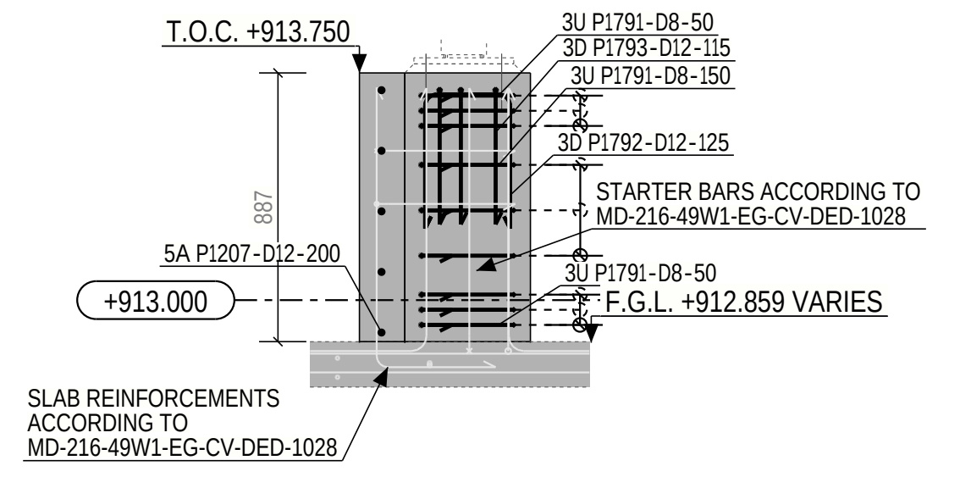
T.O.C. +913.750
STARTER BARS ACCORDING TO
MD-216-49W1-EG-CV-DED-1028
F.G.L. +912.859 VARIES
+913.000
SLAB REINFORCEMENTS
ACCORDING TO
MD-216-49W1-EG-CV-DED-1028

SECTION : 1 - 1
(SCALE 1:25)

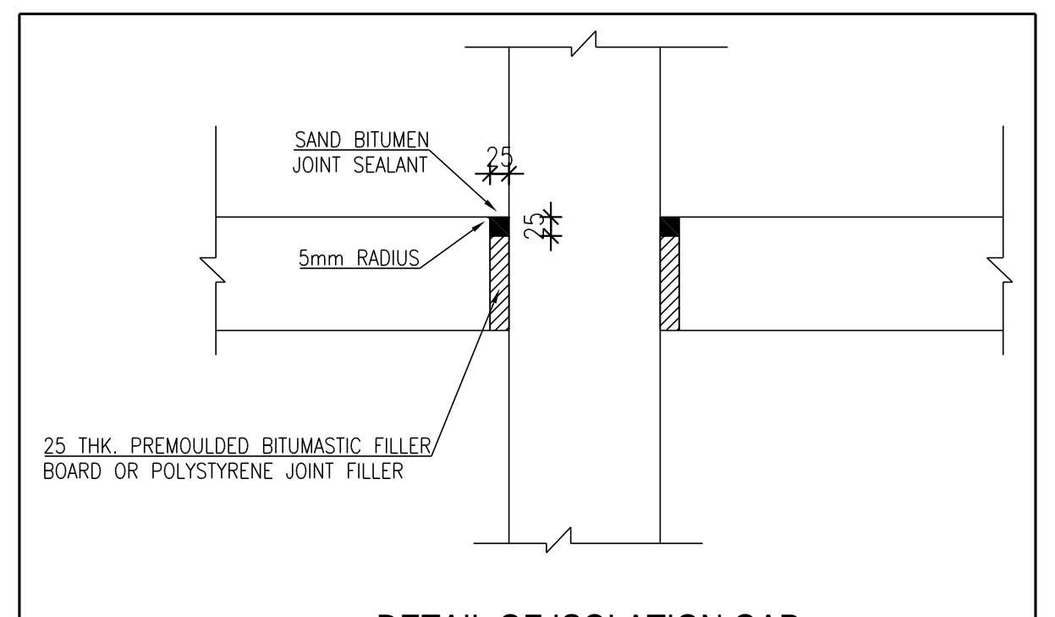
SAND BITUMEN
JOINT SEALANT
5mm RADIUS
25 THK. PREMOULDED BITUMASTIC FILLER
BOARD OR POLYSTYRENE JOINT FILLER

DETAIL OF ISOLATION GAP
SCALE 1:10

CONCRETE INFORMATION

Concretes used	C35	
Concrete cover 1	75±10mm	BOTTOM OF SLAB
Concrete cover 2	50±10mm	SIDES AND TOP OF SLAB, WALLS, BEAMS AND COLUMNS

REINFORCING BAR LIST
CAST UNIT CODE: P120 PCS: 1

REINFORCING BARS TYPE	POS	PCS	GRADE	D [mm]	L [mm]	dL [mm]	WEIGHT SUM [kg]	a	b	c	d	e	u	v	x	TD	COMMENT
A	P1201	9	B500B	12	9750		77.9	9750									
A	P1202	4	B500B	12	12000		42.6	12000									
B	P1203	5	B500B	12	1180		5.3	635	580				90			60	
B	P1204	5	B500B	12	1250		5.6	500	787				90			60	
B	P1205	44	B500B	12	970		37.9	500	500				90			60	
A	P1206	4	B500B	12	2650		9.4	2650									
A	P1207	14	B500B	12	3290		41.0	3296									

REINFORCING BAR TOTAL WEIGHT [kg] 219.7

REINFORCING BAR LIST
CAST UNIT CODE: P139 PCS: 2

REINFORCING BARS TYPE	POS	PCS	GRADE	D [mm]	L [mm]	dL [mm]	WEIGHT SUM [kg]	a	b	c	d	e	u	v	x	TD	COMMENT
C	P1391	27	B500B	10	630		10.6	364	294				97			40	
J	P1392	9	B500B	16	1890		26.9	400	1110	400			42			80	
D	P1393	68	B500B	10	1050		44.2	500	100	500						40	
J	P1394	7	B500B	12	1590		9.9	200	1210	200			39			60	
A	P1395	9	B500B	12	3320		26.6	3325									
A	P1396	18	B500B	12	2350		37.6	2350									
C	P1397	9	B500B	16	3580		51.0	3193	400				42			80	
A	P1398	4	B500B	12	2940		10.5	2944									
A	P1399	10	B500B	12	4640		41.3	4649									
?	P10321	0	B500B	12	0		0.0										
A	P13910	12	B500B	12	2830		20.1	2837									
43	AT GROUP	6	PCS	...	1250	316	...	1252									
A	P13911	4	B500B	12	1270		4.5	1275									
A	P13912	4	B500B	12	2970		10.6	2979									
J	P13913	7	B500B	12	1900		11.8	400	1116	400			42			60	
C	P13914	36	B500B	10	560		12.6	339	248				98			40	
K	P13915	133	B500B	10	1020		84.0	500	500							40	
A	P13916	14	B500B	12	1620		20.2	1626									
A	P13917	18	B500B	12	3690		53.2	3690									
24	AT GROUP	9	PCS	...	3060	79	...	3060									
A	P13918	34	B500B	12	1300		39.2	1300									
A	P13919	10	B500B	12	1100		9.4	1104									
4	AT GROUP	10	PCS	...	1010	10	...	1016									
A	P13920	6	B500B	12	1890		9.1	1890									
2	AT GROUP	3	PCS	...	1530	180	...	1539									
A	P13921	8	B500B	12	1940		13.8	1948									
A	P13922	8	B500B	12	2810		20.0	2819									
A	P13923	3	B500B	12	470		1.3	470									
C	P13924	10	B500B	12	2000		17.8	1608	400				38			60	
J	P13925	10	B500B	16	1740		27.6	400	964	400			38			80	
J	P13926	8	B500B	12	1950		13.9	500	971	500			38			60	
C	P13927	30	B500B	10	610		11.4	368	266				98			40	
A	P13928	10	B500B	12	1710		15.2	1716									
A	P13929	5	B500B	12	1300		5.8	1307									
B	P13930	14	B500B	12	1080		13.5	920	194				90			60	
U	P13931	2	B500B	10	740		0.9	132	196	100	196	100				40	
A	P13932	12	B500B	12	1350		14.4	1350									
A	P13933	11	B500B	12	1230		10.9	1238									
11	AT GROUP	11	PCS	...	1050	18	...	1056									
J	P13934	7	B500B	12	2010		12.6	400	1231	400			38			60	
A	P13935	6	B500B	12	1290		6.6	1294									
2	AT GROUP	6	PCS	...	1160	26	...	1164									
A	P13936	7	B500B	12	1280		7.6	1280									
1	AT GROUP	7	PCS	...	1180	17	...	1180									
D	P13937	14	B500B	8	730		4.0	350	70	350						32	
B	P13938	8	B500B	12	1610		11.5	1400	244				90			60	
B	P13939	10	B500B	12	2320		20.6	2109	244				90			60	
D	P13940	33	B500B	8	760		9.9	350	100	350						32	
A	P13941	6	B500B	10	1340		5.0	1342									
A	P13942	10	B500B	12	1400		12.4	1400									
B	P13943	10	B500B	12	1660		14.8	1450	244				90			60	
A	P13944	10	B500B	12	1500		13.3	1500									
A	P13945	1	B500B	10	1230		0.8	1236									
A	P13946	3	B500B	10	1300		2.4	1300									

REINFORCING BAR TOTAL WEIGHT [kg] 821.5

REINFORCING BAR LIST
CAST UNIT CODE: P179 PCS: 4

REINFORCING BARS TYPE	POS	PCS	GRADE	D [mm]	L [mm]	dL [mm]	WEIGHT SUM [kg]	a	b	c	d	e	u	v	x	TD	COMMENT
U	P1791	36	B500B	8	1420		20.3	106	340	315	340	315				32	
D	P1792	12	B500B	12	1130		12.1	450	295	450						60	
D	P1793	12	B500B	12	1160		12.4	450	320	450						60	

REINFORCING BAR TOTAL WEIGHT [kg] 44.7

REINFORCEMENT BENDING SHAPES:

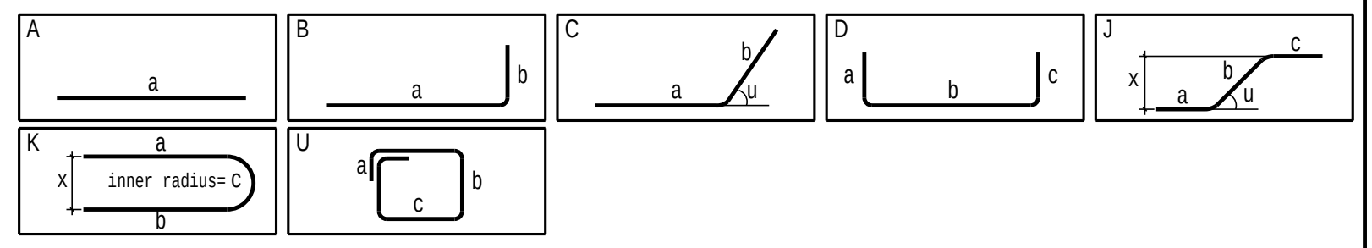

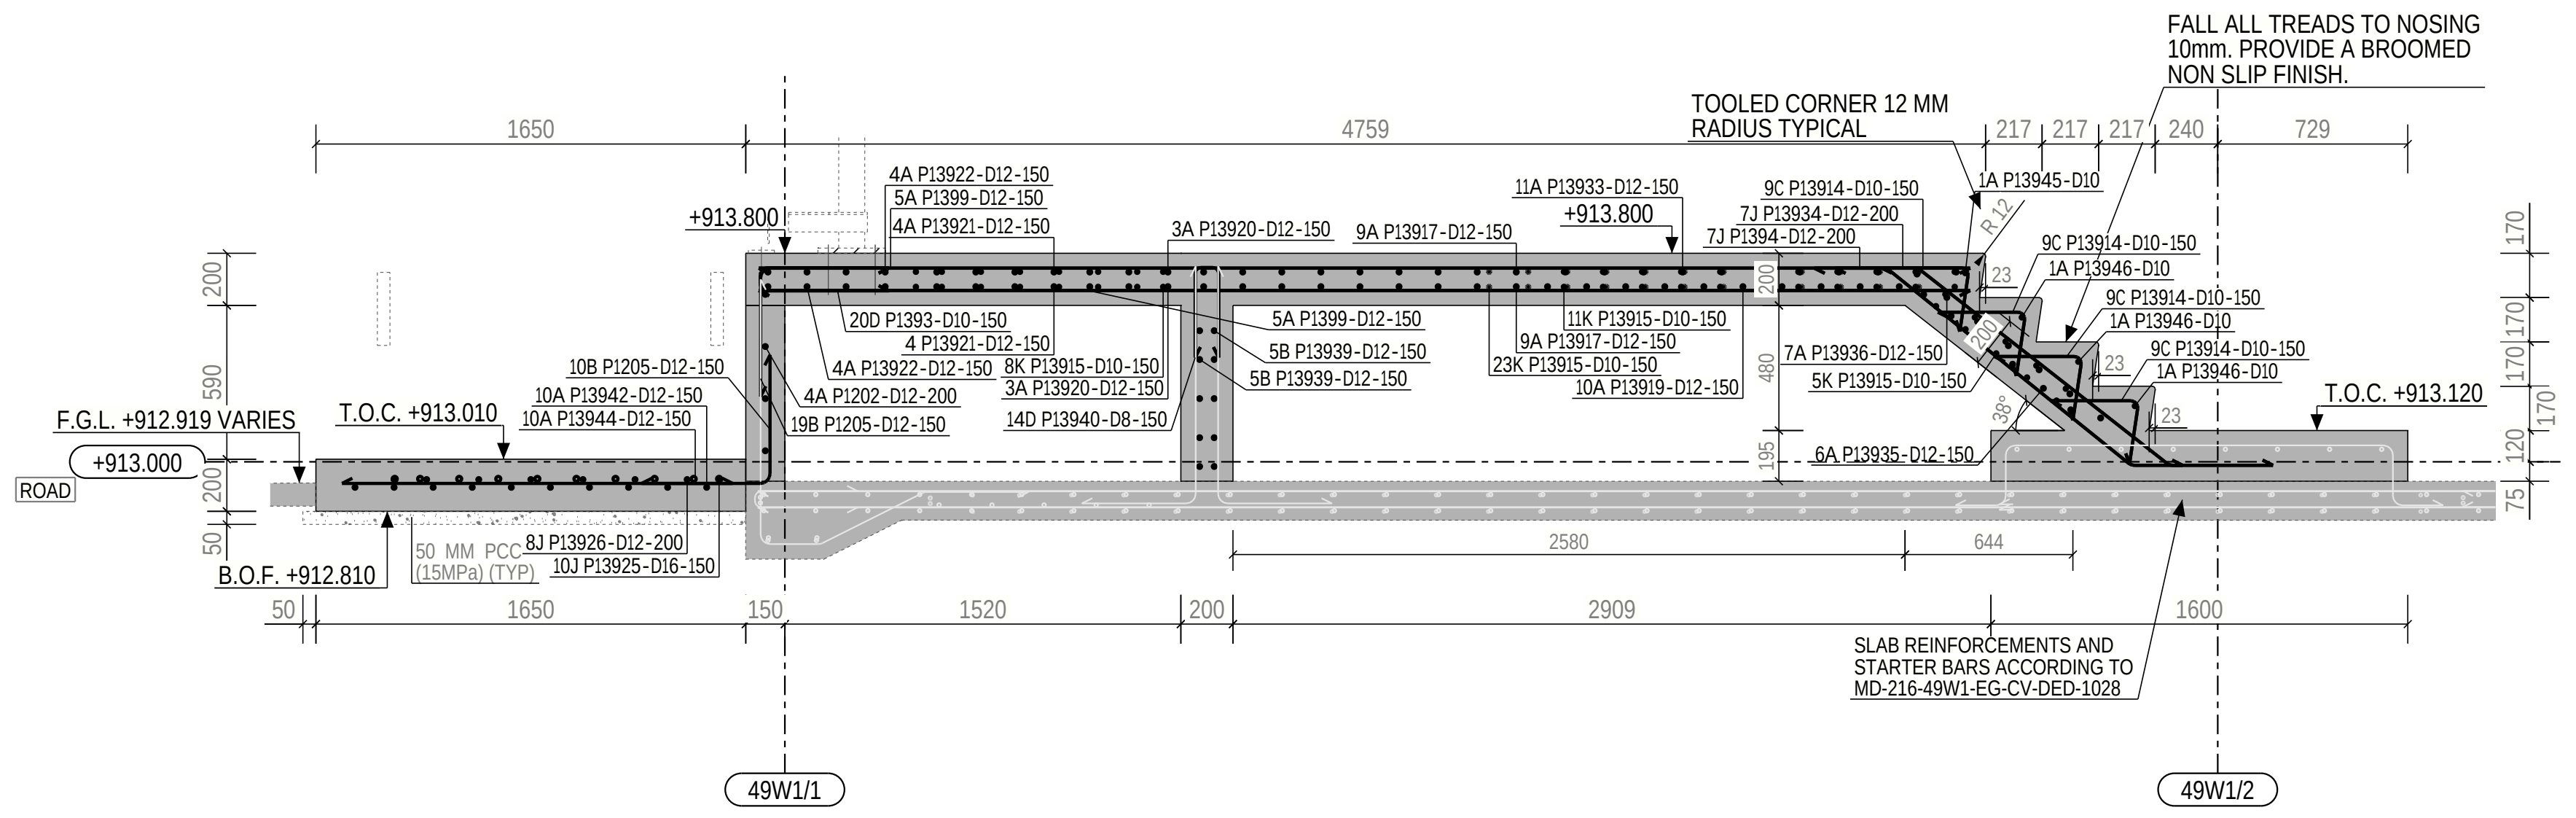

SECTION : A - A
(SCALE 1:25)

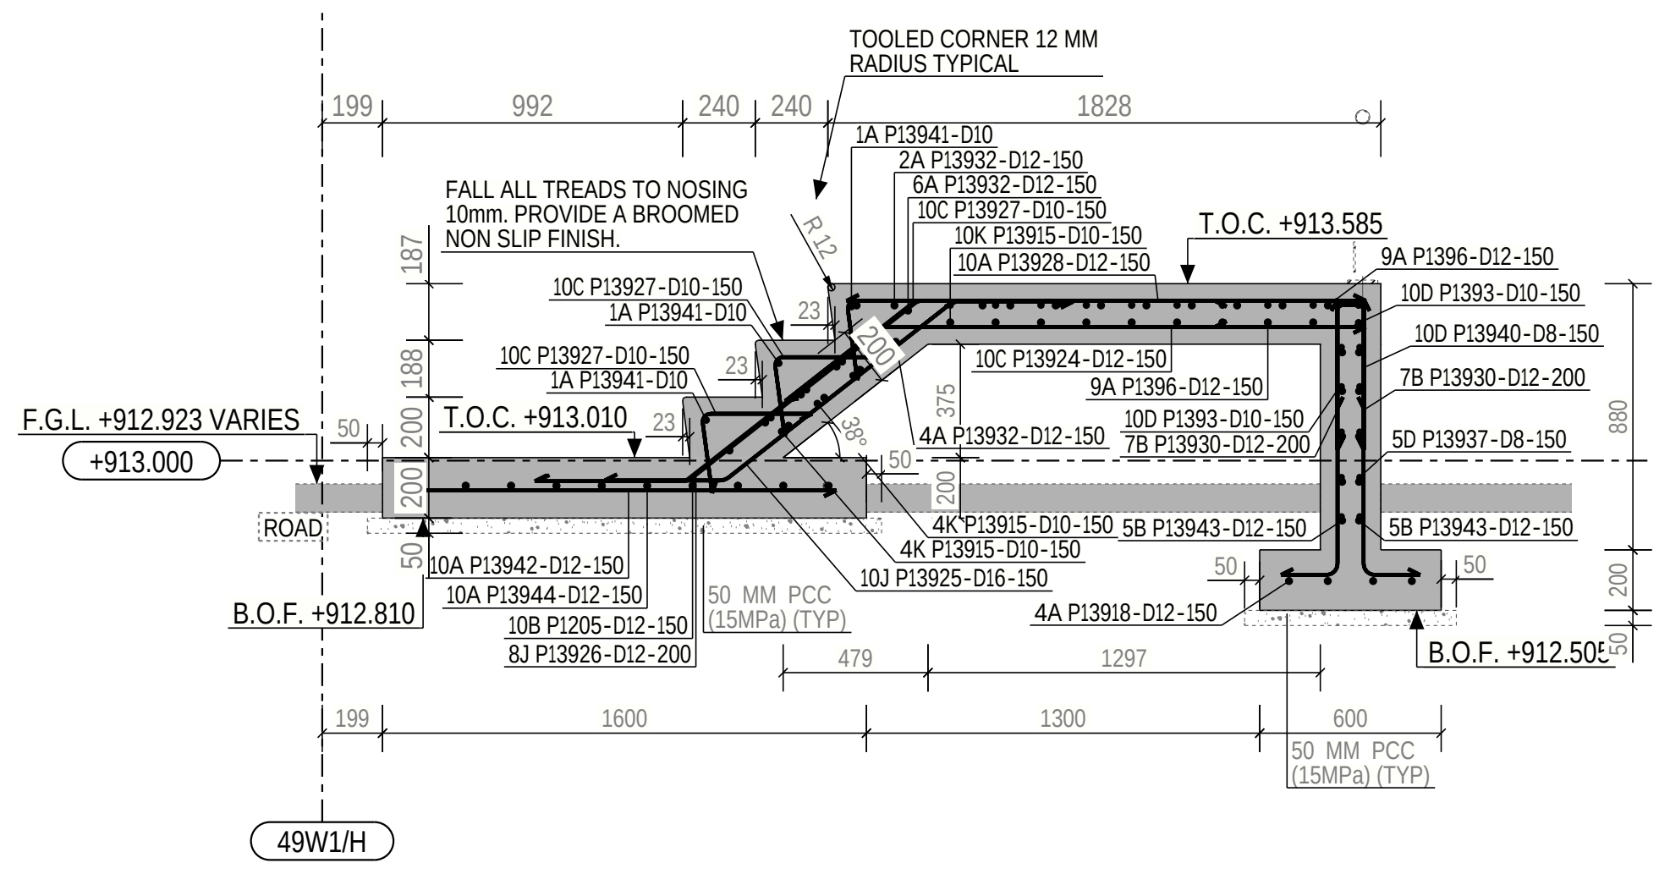

SECTION : C - C
(SCALE 1:25)

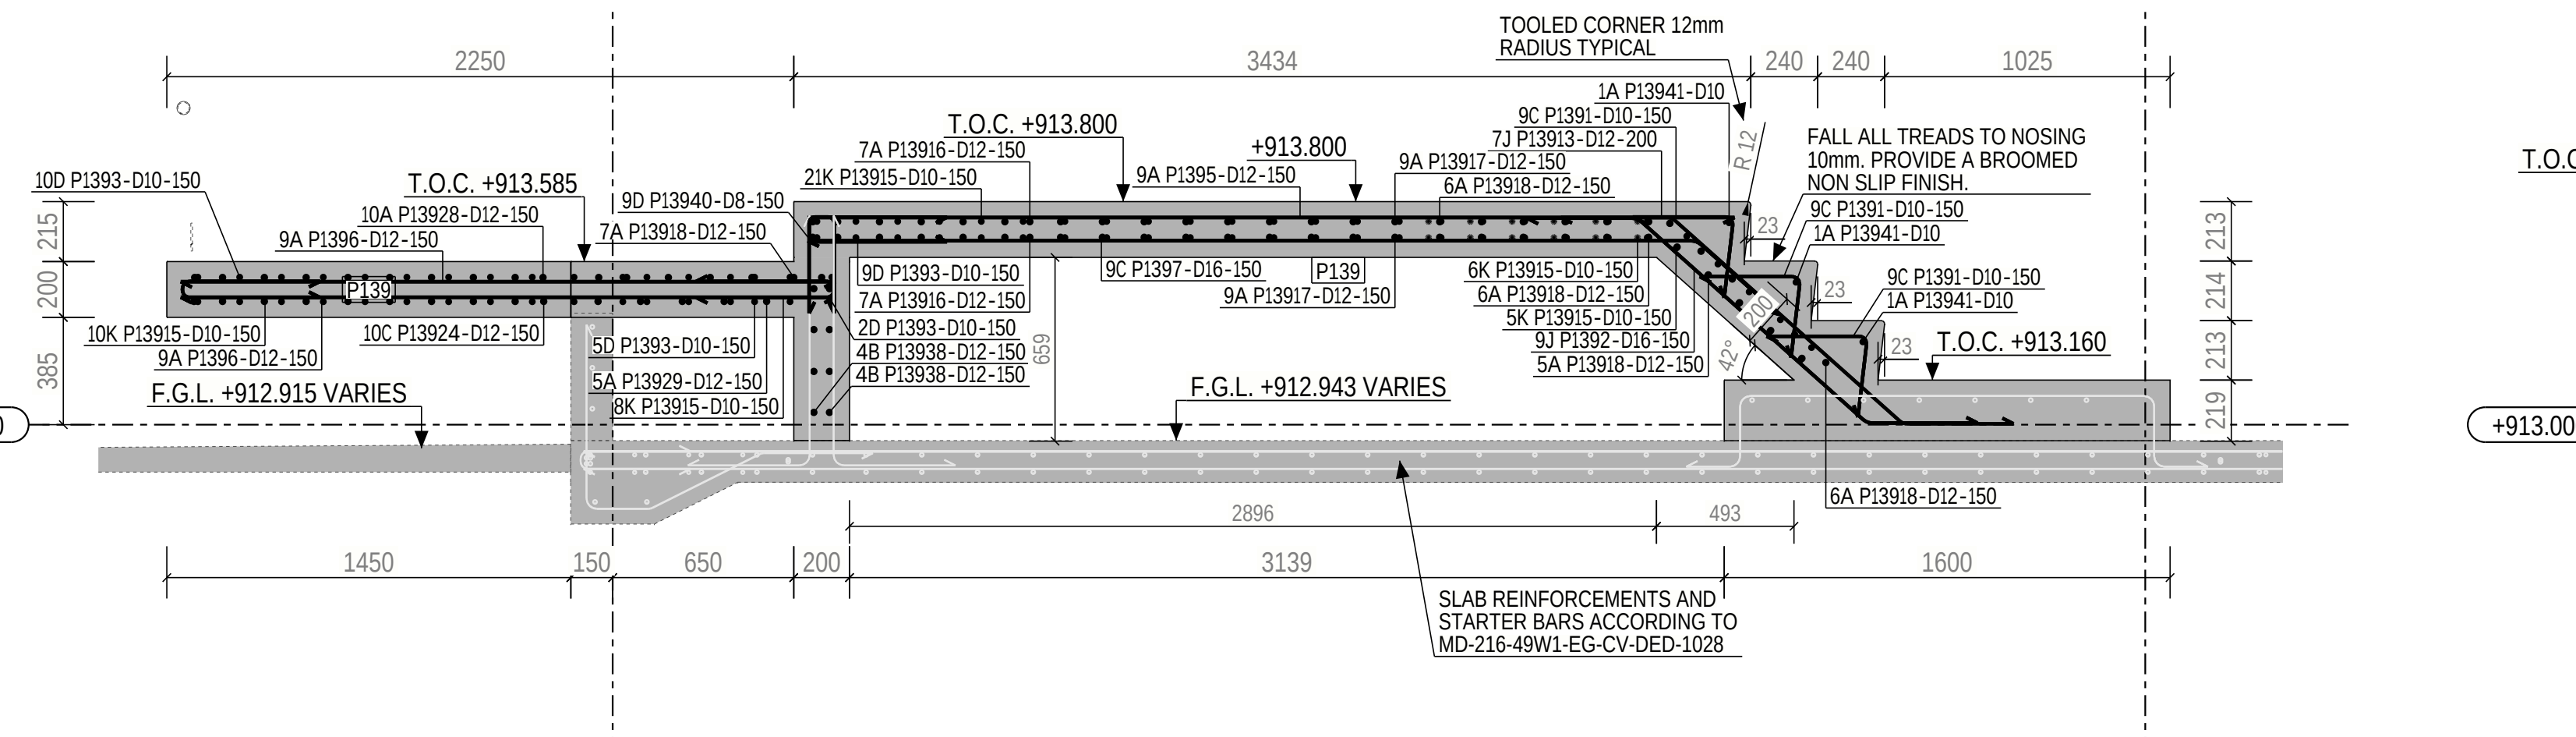

SECTION : B - B
(SCALE 1:25)

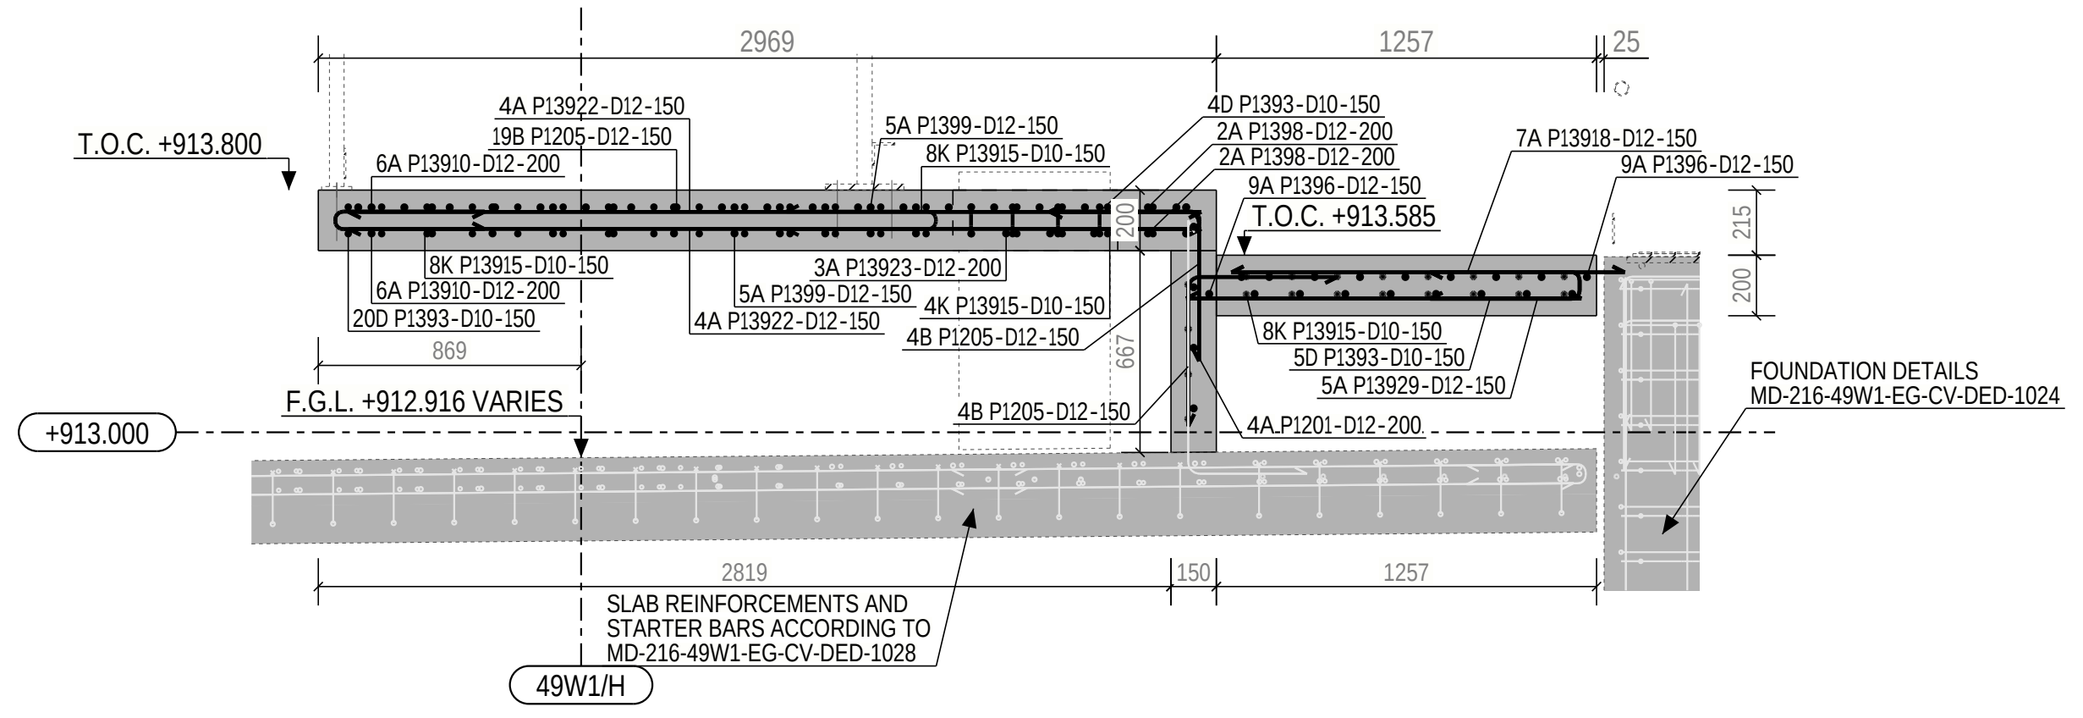

SECTION : D - D
(SCALE 1:25)

NOTE: LOCATIONS FOR STARTER BARS ARE SHOWN IN DRAWING MD-216-49W1-EG-CV-DED-1028 AND NOT SHOWN IN REINFORCEMENT LIST

LOCATIONS FOR STRUCTURES IN GENERAL ARRANGEMENT DRAWING MD-216-49W1-EG-CV-GAD-1001

LEGEND:

R.L. - REDUCED LEVEL
T.O.C. - TOP OF CONCRETE
B.O.F. - BOTTOM OF FOUNDATION
F.G.L. - FINISHED GROUND LEVEL
P.C.C. - PLAIN CEMENT CONCRETE
TYP - TYPICAL
MKD - MARKED
CL - CENTER LINE
BOTTOM REINF. (B)
TOP REINF. (T)
SBC - SAFE BEARING CAPACITY
MIN. - MINIMUM
REF. - REFERED
GA - GENERAL ARRANGEMENT
DWG. - DRAWING
R.C.C. - REINFORCED CEMENT CONCRETE

NOTES:

1. ALL DIMENSIONS ARE IN MILLIMETRES AND LEVELS ARE IN METRES UNLESS OTHERWISE STATED
2. GRADE OF CONCRETE SHALL BE C35 (35MPa) UNLESS NOTED OTHERWISE & C15 (15MPa) FOR BLINDING CONCRETE.
3. GRADE OF REINFORCEMENT SHALL BE DEFORMED BAR ASTM A615-GRADE 60 (fy=420MPa)
4. CLEAR COVER TO MAIN REINFORCEMENT SHALL BE AS FOLLOWS:
a) FOUNDATION: 75 mm (BOTTOM & SIDE)
b) FOUNDATION: 50 mm (TOP)
c) COLUMN & PEDESTAL: 50 mm
5. MINIMUM LAP LENGTHS OF REINFORCEMENT SHALL BE 40XBAR DIAMETER
6. FOR STANDARD REINFORCEMENT DETAILS & GENERAL NOTES FOR CIVIL WORKS REFER TO DRAWING NUMBER MD-216-1000-EG-CV-DED-1005 & 1001
7. ANCHOR BOLTS AND EMBEDDED STEELWORK SHALL BE HOT DIP GALVANIZED
8. T.O.C. & TOP OF SCREED TOLERANCE SHALL BE WITHIN +/- 10MM OF DESIGN LEVEL
9. NET SAFE BEARING CAPACITY OF SOIL AT BOTTOM OF FOUNDATION IS CONSIDERED AS 375 KN/SQ.M.
10. REBARS CAN BE MOVED LOCALLY BY +/- 25mm TO AVOID INTERFERENCE WITH EMBEDDED PARTS

KEYPLAN

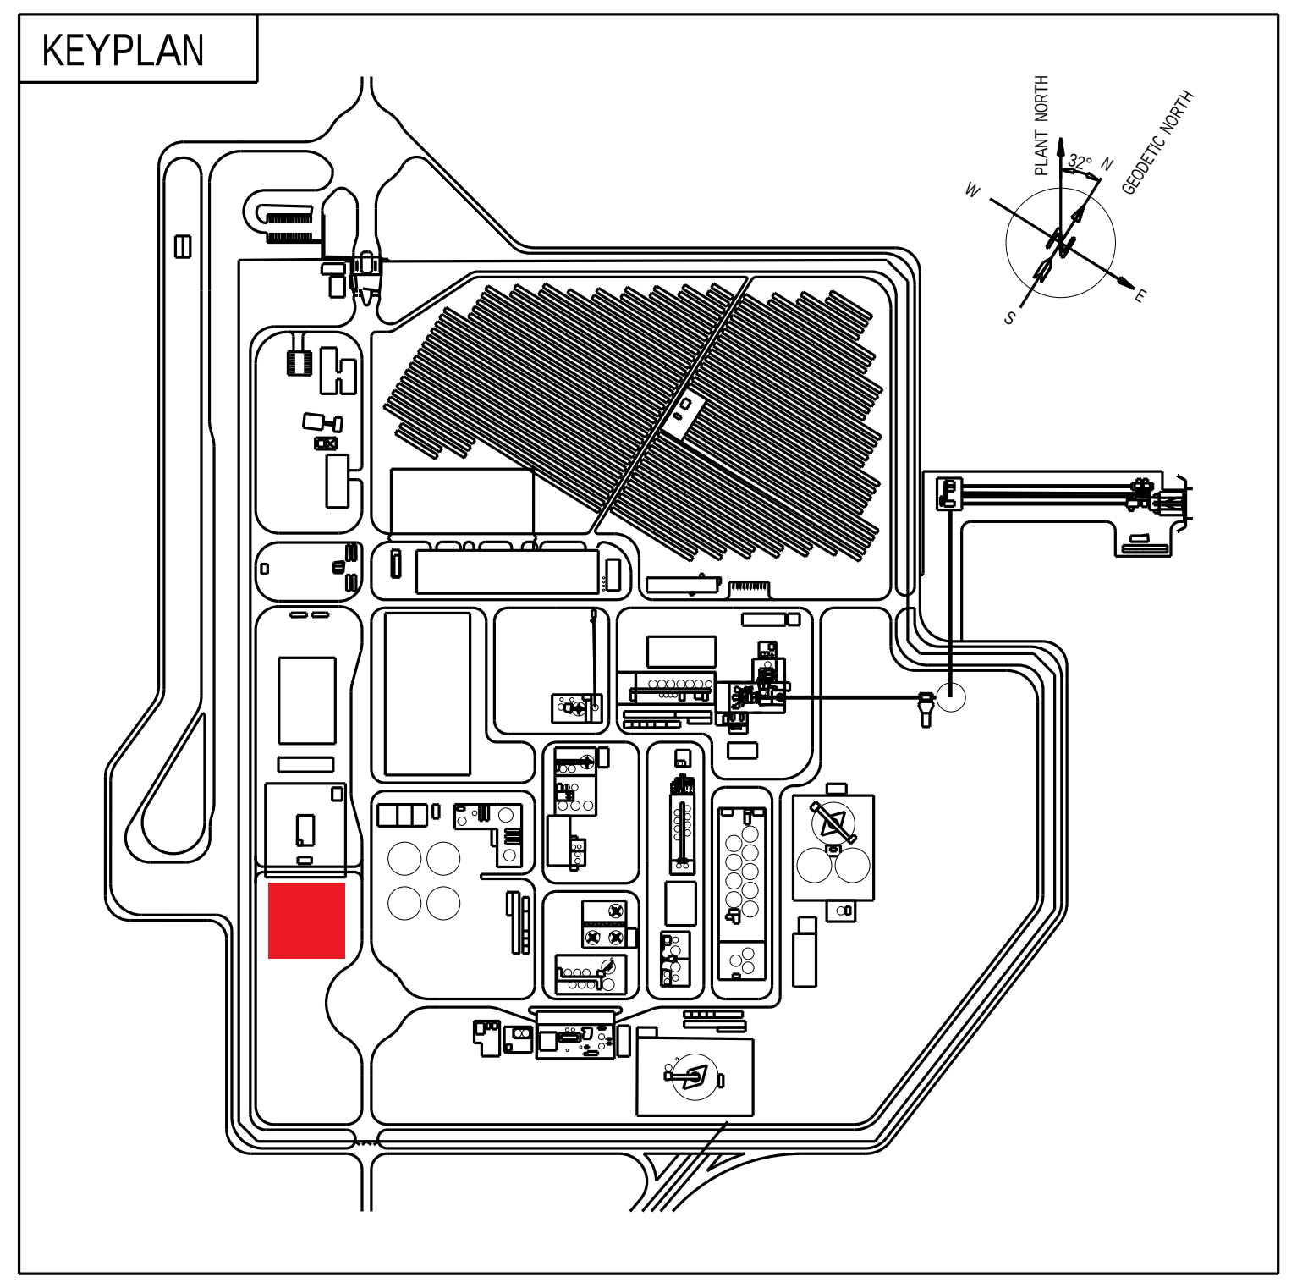

DOCUMENT NUMBER	REFERENCE DOCUMENTS	DOCUMENT NUMBER	REFERENCE DOCUMENTS
MD-216-49W1-EG-CV-DED-1019	PIPERACK FOUNDATION 2		
MD-216-49W1-EG-CV-DED-1028	SLAB SECTOR GL G-J/1-5	MD-216-49W1-EG-CV-DED-1018	EQUIPMENT FOUNDATION PUMPS 2
MD-216-49W1-EG-CV-DED-1002	TANK FOUNDATIONS 49W1-TNK-003/007/009	MD-216-49W1-EG-CV-DED-1024	CONTAINER FOUNDATIONS
MD-216-1000-EG-ST-CRT-1001	DESIGN CRITERIA	MD-216-49W1-EG-CV-GAD-1001	GENERAL ARRENGEMENT DRAWINGGL 1-7/E-J

REV	DATE	REVISION DESCRIPTION	DRN	CHK	ENG	APP	EMP
D01	29.01.2024	AS-BUILT	JonRen	MauNot	NanWu	LuiPiz	
C01	01.03.2022	ISSUED FOR CONSTRUCTION	JonRen	MauNot	NanWu	LuiPiz	
A01	18.02.2022	ISSUED FOR APPROVAL	KalKar	MauNot	NanWu	LuiPiz	

RESERVED FOR VENDOR LOGO AND DRAWING NUMBER

LARSEN & TOUBRO

This drawing is the property of LARSEN & TOUBRO and must not be passed on to any person or body not authorized by us to recieve it or be copied or otherwise made use either in full or in part by such person or body without our prior permission in writing.

Outotec

The content of these documents are the sole property of Outotec Oyj. Any rights not expressly granted herein are reserved. Reproduction, transfer or distribution of part or all of the contents in any form without prior written permission of Outotec is prohibited.

MA'ADEN معادن
Saudi Arabian Mining Company شركة التعدين العربية السعودية

This document and the information contained herein is Ma'aden proprietary know-how. This document or any part thereof should not be reproduced, stored in a retrieval system or transmitted by any means, electronic or otherwise, or divulged without prior written permission of Ma'aden.

LARSEN & TOUBRO DRAWING NUMBER
REVISION 2

OUTOTEC DRAWING NUMBER 900707_GAU01_AG11_CTB01_49036
DOCUMENT ID OU100745549
REVISION 2

DRAWN	KalKar	18.02.2022
CHECKED	MauNot	18.02.2022
ENGINEER	KalKar	18.02.2022
APPROVED	LuiPiz	18.02.2022
EMPLOYER		
SCALE	1:50	A0

MANSOURAH - MASSARAH GOLD PROJECT
49W1-TNK-007 PLATFORM

DIMENSION AND REINFORCEMENT DRAWING

DRAWING NUMBER MD-216-49W1-EG-CV-DED-1036
REV C01

Tekla Structures