

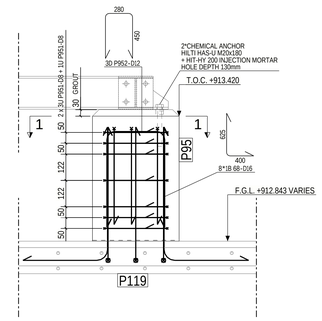



FOUNDATION P95 REINFORCEMENT
(SCALE 1:10)

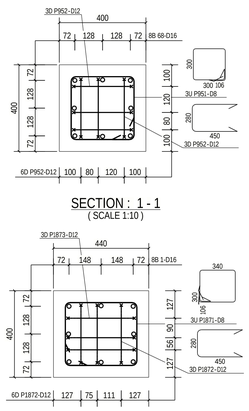


(SCALE 1:10)

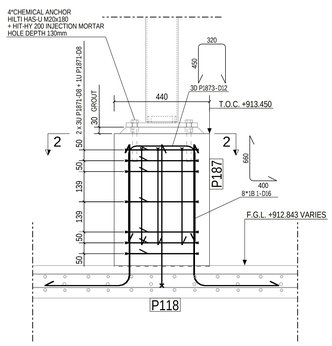


FOUNDATION P187 REINFORCEMENT
(SCALE 1:10)

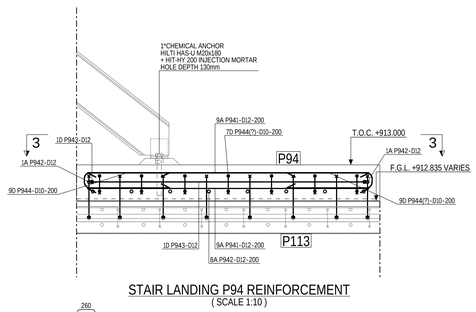


STAIR LANDING P94 REINFORCEMENT
(SCALE 1:10)

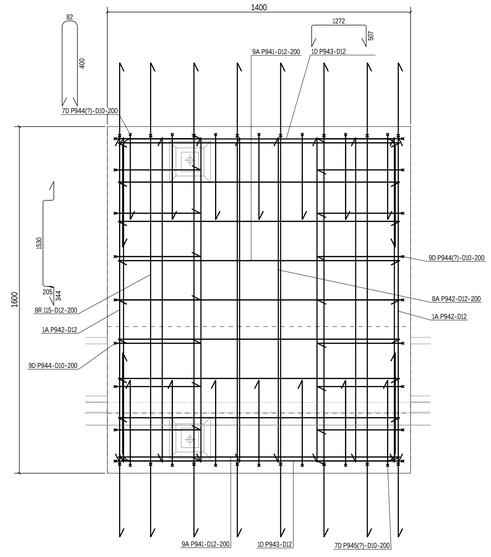


(SCALE 1:10)

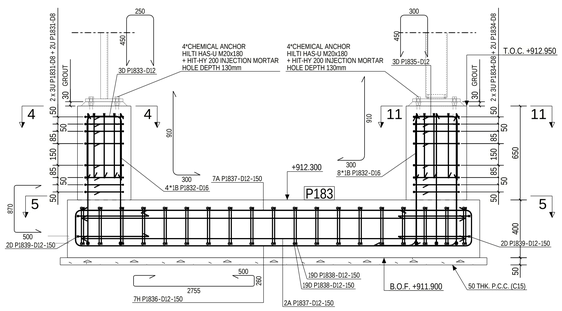


FOUNDATION P183 REINFORCEMENT
(SCALE 1:15)

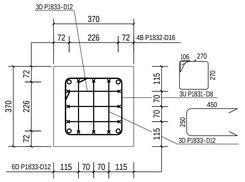


(SCALE 1:10)

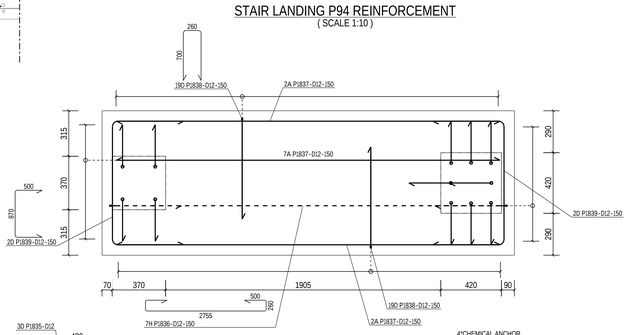


(SCALE 1:15)

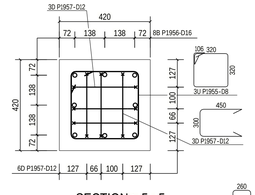


(SCALE 1:10)

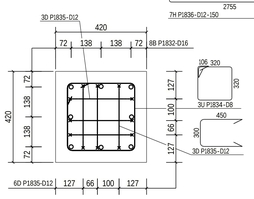


(SCALE 1:10)

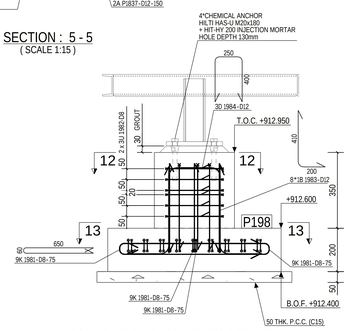


FOUNDATION P198 REINFORCEMENT
(SCALE 1:10)

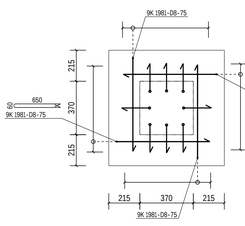


(SCALE 1:15)

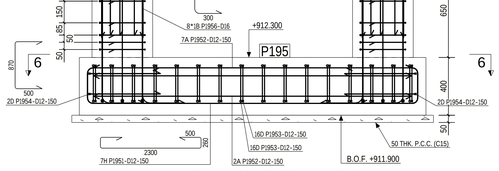


FOUNDATION P195 REINFORCEMENT
(SCALE 1:15)

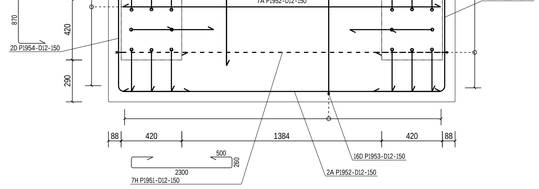


(SCALE 1:15)

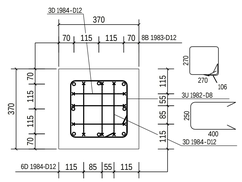


(SCALE 1:10)

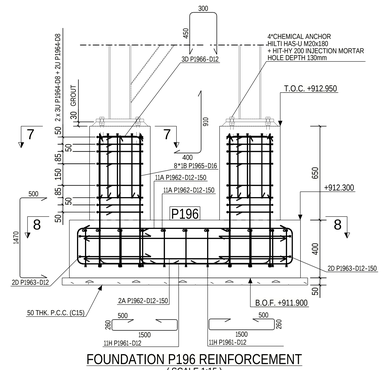


FOUNDATION P196 REINFORCEMENT
(SCALE 1:15)

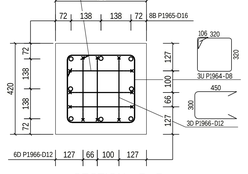


(SCALE 1:10)

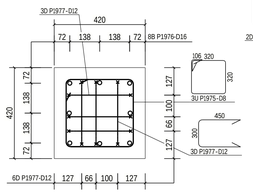


(SCALE 1:10)

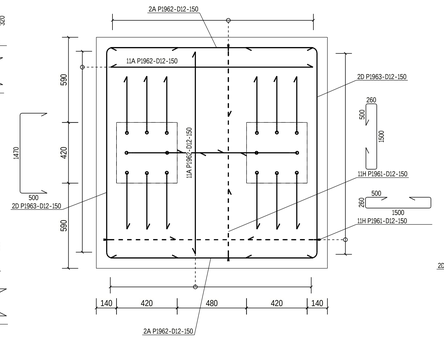

(SCALE 1:15)

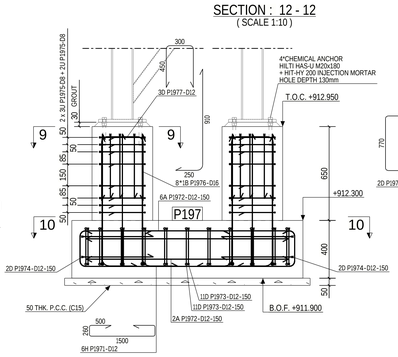

FOUNDATION P197 REINFORCEMENT
(SCALE 1:15)

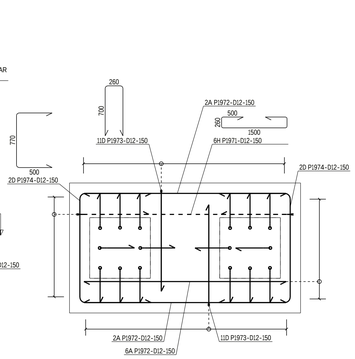

(SCALE 1:15)

CONCRETE INFORMATION

Concretes used	C35	
Concrete cover 1	75±10mm, 50±10mm	INDEPENDENT FOUNDATIONS BOTTOM, SIDES AND TOP
Concrete cover 2	50±10mm	PEDESTALS AND LANDINGS

REINFORCING BAR LIST — CAST UNIT CODE: P94 — PCS: 1

REINFORCING BARS TYPE	POS	PCS	GRADE	D [mm]	L [mm]	dL [mm]	WEIGHT SUM [kg]	BENDING DIMENSIONS [mm] a	b	c	d	e	u	v	x	TD	COMMENT
A	P941	18	B500B	12	1300		20.8	1300								60	
A	P942	10	B500B	12	1500		13.3	1500								40	
D	P943	2	B500B	12	2220		4.0	507	1272	507					60		
D	P944	9	B500B	10	830		4.6	400	82	400					40		
D	P944(7)	16	B500B	10	830		8.3	400	82	400					40		
D	P945(7)	7	B500B	10	840		3.6	400	90	400					40		

REINFORCING BAR TOTAL WEIGHT [kg] 54.6

REINFORCING BAR LIST — CAST UNIT CODE: P95 — PCS: 1

REINFORCING BARS TYPE	POS	PCS	GRADE	D [mm]	L [mm]	dL [mm]	WEIGHT SUM [kg]	BENDING DIMENSIONS [mm] a	b	c	d	e	u	v	x	TD	COMMENT
U	P951	7	B500B	8	1310		3.6	106	300	300	300	300				32	
D	P952	6	B500B	12	1120		6.0	450	280	450						60	

REINFORCING BAR TOTAL WEIGHT [kg] 9.6

REINFORCING BAR LIST — CAST UNIT CODE: P183 — PCS: 1

REINFORCING BARS TYPE	POS	PCS	GRADE	D [mm]	L [mm]	dL [mm]	WEIGHT SUM [kg]	BENDING DIMENSIONS [mm] a	b	c	d	e	u	v	x	TD	COMMENT
U	P1831	8	B500B	8	1190		3.8	106	270	270	270	270				32	
B	P1832	12	B500B	16	1160		22.2	300	910					90		80	
D	P1833	6	B500B	12	1090		5.8	450	250	450						60	
U	P1834	8	B500B	8	1390		4.4	106	320	320	320	320				32	
D	P1835	6	B500B	12	1140		6.1	450	300	450						60	
H	P1836	7	B500B	12	4150		25.8	500	260	2755	260	500				60	
A	P1837	11	B500B	12	2650		25.9	2655								60	
D	P1838	38	B500B	12	1600		54.0	700	260	700						60	
D	P1839	4	B500B	12	1810		6.4	500	870	500						60	

REINFORCING BAR TOTAL WEIGHT [kg] 154.4

REINFORCING BAR LIST — CAST UNIT CODE: P187 — PCS: 1

REINFORCING BARS TYPE	POS	PCS	GRADE	D [mm]	L [mm]	dL [mm]	WEIGHT SUM [kg]	BENDING DIMENSIONS [mm] a	b	c	d	e	u	v	x	TD	COMMENT
U	P1871	7	B500B	8	1390		3.9	106	340	300	340	300				32	
D	P1872	3	B500B	12	1120		3.0	450	280	450						60	
D	P1873	3	B500B	12	1160		3.1	450	320	450						60	

REINFORCING BAR TOTAL WEIGHT [kg] 9.9

REINFORCING BAR LIST — CAST UNIT CODE: P195 — PCS: 1

REINFORCING BARS TYPE	POS	PCS	GRADE	D [mm]	L [mm]	dL [mm]	WEIGHT SUM [kg]	BENDING DIMENSIONS [mm] a	b	c	d	e	u	v	x	TD	COMMENT
H	P1951	7	B500B	12	3700		23.0	500	260	2300	260	500				60	
A	P1952	11	B500B	12	2200		21.5	2200								60	
D	P1953	32	B500B	12	1600		45.5	700	260	700						60	
D	P1954	4	B500B	12	1810		6.4	500	870	500						60	
U	P1955	16	B500B	8	1390		8.8	106	320	320	320	320				32	
B	P1956	16	B500B	16	1160		29.6	300	910					90		80	
D	P1957	12	B500B	12	1140		12.1	450	300	450						60	

REINFORCING BAR TOTAL WEIGHT [kg] 146.9

REINFORCING BAR LIST — CAST UNIT CODE: P196 — PCS: 1

REINFORCING BARS TYPE	POS	PCS	GRADE	D [mm]	L [mm]	dL [mm]	WEIGHT SUM [kg]	BENDING DIMENSIONS [mm] a	b	c	d	e	u	v	x	TD	COMMENT
H	P1961	22	B500B	12	2900		56.7	500	260	1500	260	500				60	
A	P1962	26	B500B	12	1400		32.3	1400								60	
D	P1963	4	B500B	12	2410		8.6	500	1470	500						60	
U	P1964	16	B500B	8	1390		8.8	106	320	320	320	320				32	
B	P1965	16	B500B	16	1260		32.1	400	910					90		80	
D	P1966	12	B500B	12	1140		12.1	450	300	450						60	

REINFORCING BAR TOTAL WEIGHT [kg] 150.6

REINFORCING BAR LIST — CAST UNIT CODE: P197 — PCS: 1

REINFORCING BARS TYPE	POS	PCS	GRADE	D [mm]	L [mm]	dL [mm]	WEIGHT SUM [kg]	BENDING DIMENSIONS [mm] a	b	c	d	e	u	v	x	TD	COMMENT
H	P1971	6	B500B	12	2900		15.5	500	260	1500	260	500				60	
A	P1972	10	B500B	12	1400		12.4	1400								60	
D	P1973	22	B500B	12	1600		31.3	700	260	700						60	
D	P1974	4	B500B	12	1710		6.1	500	770	500						60	
U	P1975	16	B500B	8	1390		8.8	106	320	320	320	320				32	
B	P1976	16	B500B	16	1110		28.3	250	910					90		80	
D	P1977	12	B500B	12	1140		12.1	450	300	450						60	

REINFORCING BAR TOTAL WEIGHT [kg] 114.5

REINFORCING BAR LIST — CAST UNIT CODE: P198 — PCS: 1

REINFORCING BARS TYPE	POS	PCS	GRADE	D [mm]	L [mm]	dL [mm]	WEIGHT SUM [kg]	BENDING DIMENSIONS [mm] a	b	c	d	e	u	v	x	TD	COMMENT
K	1981	36	B500B	8	1320		18.8	650	650							32	
U	1982	6	B500B	8	1190		2.8	106	270	270	270	270				32	
B	1983	8	B500B	12	580		4.1	200	410					90		60	
D	1984	6	B500B	12	990		5.3	400	250	400						60	

REINFORCING BAR TOTAL WEIGHT [kg] 31.0

REINFORCEMENT BENDING SHAPES:


NOTE: LOCATIONS FOR STARTER BARS ARE SHOWN IN DRAWINGS:
MD-216-49W1-EG-CV-DED-1029
MD-216-49W1-EG-CV-DED-1030
MD-216-49W1-EG-CV-DED-1030
AND NOT SHOWN IN REINFORCEMENT LIST

LOCATIONS FOR STRUCTURES IN GENERAL ARRANGEMENT DRAWINGS:
MD-216-49W1-EG-CV-GAD-1003

LEGEND:
R.L - REDUCED LEVEL
T.O.C. - TOP OF CONCRETE
B.O.F. - BOTTOM OF FOUNDATION
F.G.L. - FINISHED GROUND LEVEL
P.C.C. - PLAIN CEMENT CONCRETE
TYP - TYPICAL
MKD - MARKED
CL - CENTER LINE
BOTTOM REINF. (B)
TOP REINF. (T)
SBC - SAFE BEARING CAPACITY
MIN. - MINIMUM
REF. - REFERED
GA - GENERAL ARRANGEMENT
DWG. - DRAWING
R.C.C. - REINFORCED CEMENT CONCRETE

NOTES:
1. ALL DIMENSIONS ARE IN MILLIMETRES AND LEVELS ARE IN METRES UNLESS OTHERWISE STATED
2. GRADE OF CONCRETE SHALL BE C35 (35MPa) UNLESS NOTED OTHERWISE & C15 (15MPa) FOR BLINDING CONCRETE
3. GRADE OF REINFORCEMENT SHALL BE DEFORMED BAR ASTM A615-GRADE 60 (fy=420MPa)
4. CLEAR COVER TO MAIN REINFORCEMENT SHALL BE AS FOLLOWS:
a) FOUNDATION: 75 mm (BOTTOM & SIDE)
b) FOUNDATION: 50 mm (TOP)
c) COLUMN & PEDESTAL: 50 mm
5. MINIMUM LAP LENGTHS OF REINFORCEMENT SHALL BE 40XBAR DIAMETER
6. FOR STANDARD REINFORCEMENT DETAILS & GENERAL NOTES FOR CIVIL WORKS REFER TO DRAWING NUMBER MD-216-1000-EG-CV-DED-1005 & 1001
7. ANCHOR BOLTS AND EMBEDDED STEELWORK SHALL BE HOT DIP GALVANIZED
8. T.O.C. & TOP OF SCREED TOLERANCE SHALL BE WITHIN +/- 10MM OF DESIGN LEVEL
9. NET SAFE BEARING CAPACITY OF SOIL AT BOTTOM OF FOUNDATION IS CONSIDERED AS 375 KN/SQ.M.
10. REBARS CAN BE MOVED LOCALLY BY +/- 25mm TO AVOID INTERFERENCE WITH EMBEDDED PARTS

KEYPLAN

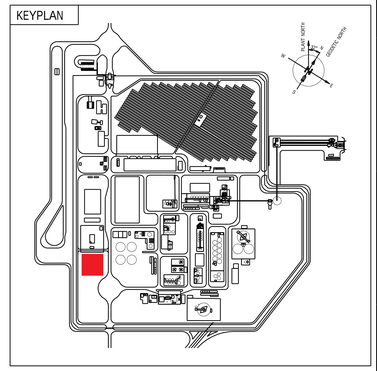

DOCUMENT NUMBER	REFERENCE DOCUMENTS
MD-216-49W1-EG-CV-DED-1031	SLAB SECTOR GL D-G/1-4 DETAIL- AND REINFORCEMENT DRAWING
MD-101-SMEM-EG-ST-DST-0001	CONCRETE STUCTURAL STANDARDS
MD-216-49WL-EG-CV-GAD-1003	1-32/A-E GENERAL ARRANGEMENT DRAWING
MD-216-49W1-EG-CV-GAD-1001	1-8/E-J GENERAL ARRANGEMENT DRAWING

DOCUMENT NUMBER	REFERENCE DOCUMENTS
MD-216-49W1-EG-CV-DED-1029	SLAB SECTOR GL D-G/8-12 DETAIL- AND REINFORCEMENT DRAWING
MD-216-49WL-EG-CV-DED-1030	SLAB SECTOR GL D-G/4-8 DETAIL- AND REINFORCEMENT DRAWING
MD-216-1000-EG-ST-DST-1001	DESIGN CRITERIA
MD-216-49WL-EG-CV-GAD-1002	7-22/D-J GENERAL ARRANGEMENT DRAWING

REV	DATE	REVISION DESCRIPTION	DRN	CHK	ENG	APP	EMP
D01	29.01.2024	AS-BUILT	JonRen	MauNot	NanWu	LuiPiz	
C01	01.03.2022	ISSUED FOR CONSTRUCTION	JonRen	MauNot	NanWu	LuiPiz	
A01	18.02.2022	ISSUED FOR APPROVAL	JonRen	MauNot	NanWu	LuiPiz	

RESERVED FOR VENDOR LOGO AND DRAWING NUMBER

LARSEN & TOUBRO DRAWING NUMBER — REVISION 2

OUTOTEC DRAWING NUMBER 900707_GAU01_AG11_CTB01_49040 — DOCUMENT ID OU100746297 — REVISION 2

LARSEN & TOUBRO
This drawing is the property of LARSEN & TOUBRO and must not be passed on to any person or body not authorized by us to receive it or be copied or otherwise made use either in full or in part by such person or body without our prior permission in writing.

Outotec
The content of these documents are the sole property of Outotec Oy. Any rights not expressly granted herein are reserved. Reproduction, transfer or distribution of part or all of the contents in any form without prior written permission of Outotec is prohibited.

MA'ADEN معادن
Saudi Arabian Mining Company شركة معادن العربية السعودية
This document and the information contained herein is Ma'aden proprietary know-how. This document or any part thereof should not be reproduced, stored in a retrieval system or transmitted by any means, electronic or otherwise, or divulged without prior written permission of Ma'aden.

DRAWN	JonRen	18.02.2022	
CHECKED	MauNot	18.02.2022	
ENGINEER	NanWu	18.02.2022	
APPROVED	LuiPiz	18.02.2022	
EMPLOYER			
SCALE	1:15	A0	

MANSOURAH - MASSARAH GOLD PROJECT
49W1 RAW WATER TREATMENT PLANT
SEC. PLATFORMS, STAIR AND PEDESTAL FOUNDATION 5
DETAIL- AND REINFORCEMENT DRAWING

DRAWING NUMBER MD-216-49W1-EG-CV-DED-1040 — REV D01