


DRAWING NUMBER: MD-216-49W1-EG-CV-DED-1041 | REV: D01

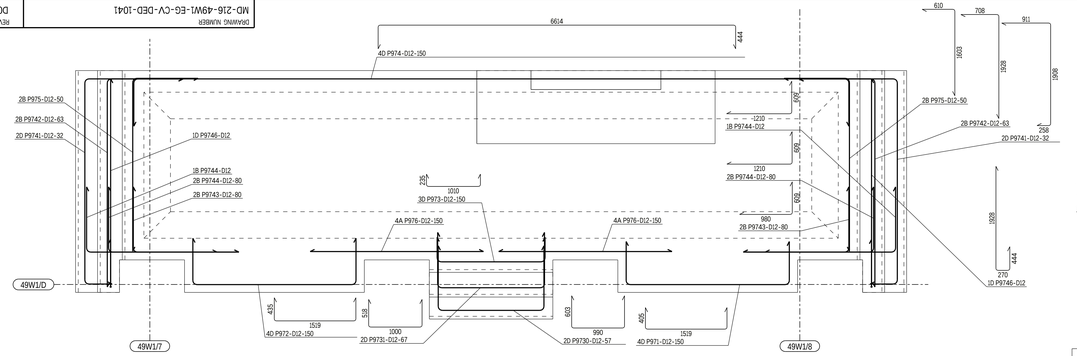


R.C.C SOUTH CONTAINER PLATFORM EDGE BAR REINFORCEMENT
(SCALE 1:20)

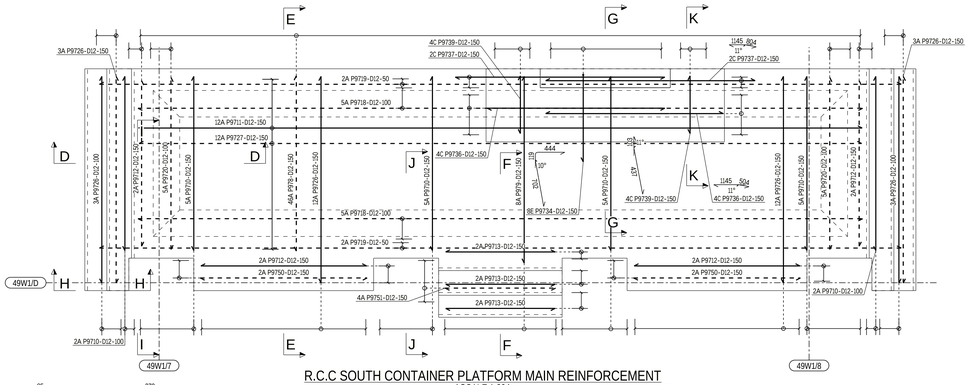


R.C.C SOUTH CONTAINER PLATFORM MAIN REINFORCEMENT
(SCALE 1:20)

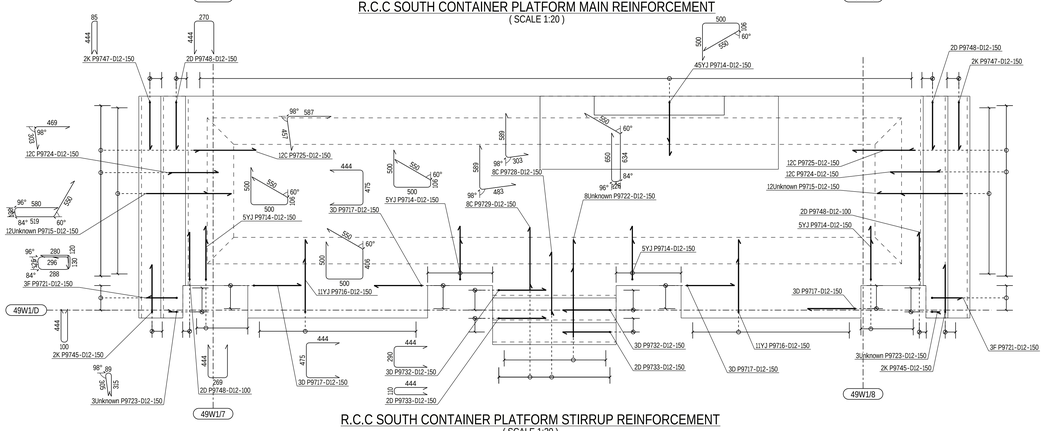


R.C.C SOUTH CONTAINER PLATFORM STIRRUP REINFORCEMENT
(SCALE 1:20)

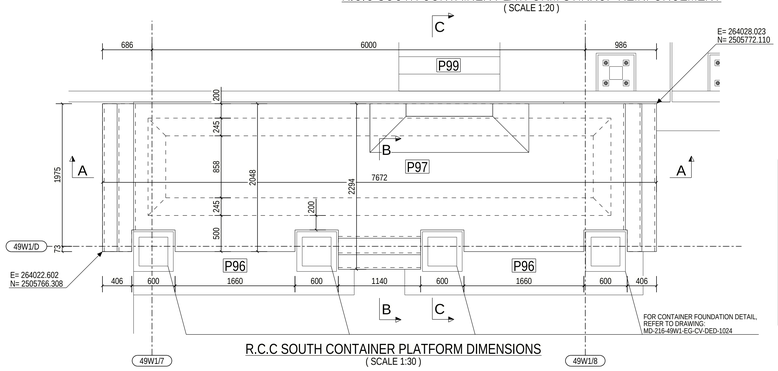


R.C.C SOUTH CONTAINER PLATFORM DIMENSIONS
(SCALE 1:30)

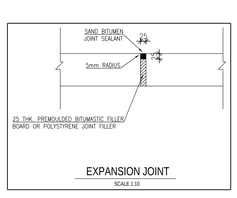


EXPANSION JOINT
SCALE 1:10

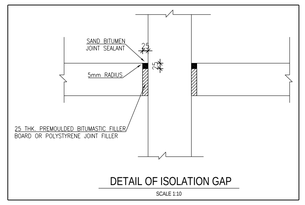


DETAIL OF ISOLATION GAP
SCALE 1:10

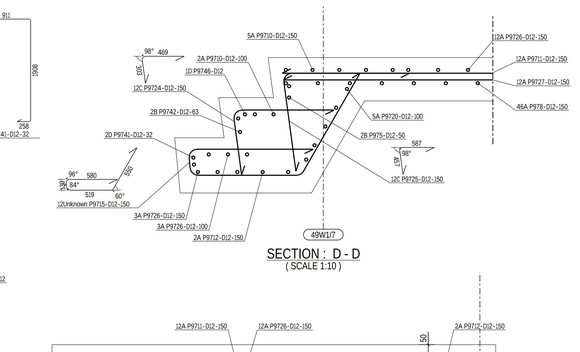


SECTION : D - D
(SCALE 1:10)

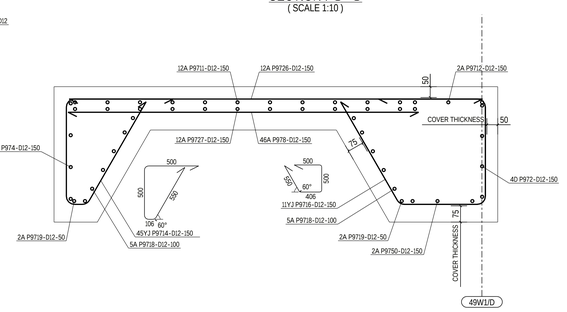


SECTION : E - E
(SCALE 1:10)

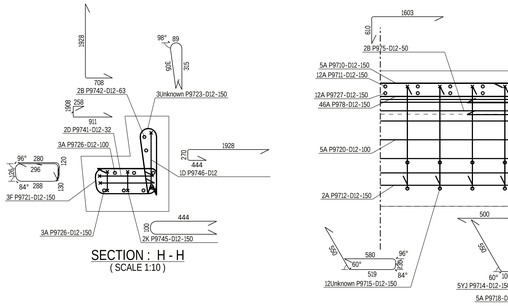


SECTION : I - I
(SCALE 1:10)

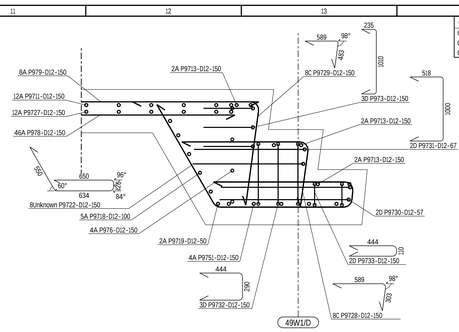


SECTION : F - F
(SCALE 1:10)

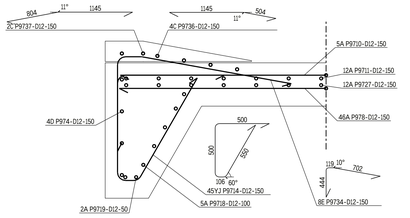


SECTION : G - G
(SCALE 1:10)

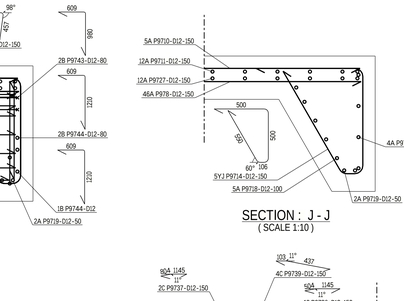


SECTION : J - J
(SCALE 1:10)

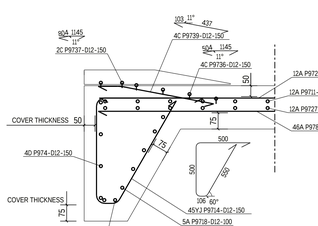


SECTION : K - K
(SCALE 1:10)

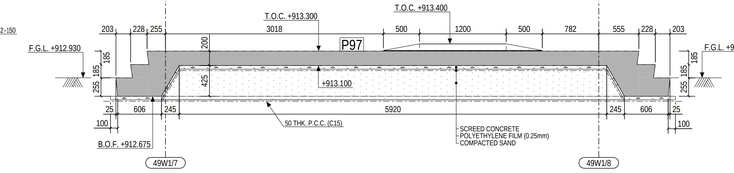

SECTION : A - A
(SCALE 1:30)

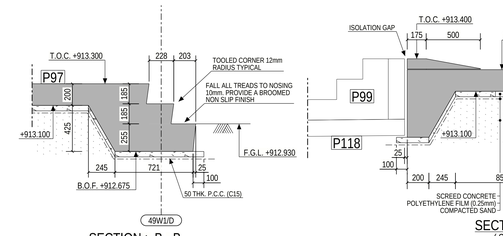

SECTION : B - B
(SCALE 1:20)

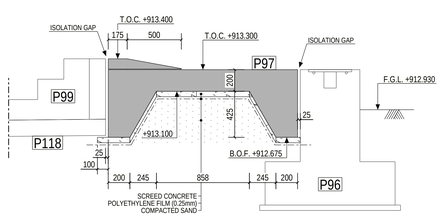

SECTION : C - C
(SCALE 1:20)

CONCRETE INFORMATION

Concretes used	C35		
Concrete cover 1	75±10mm	BOTTOM OF PLATFORM	
Concrete cover 2	50±10mm	SIDES AND TOP	


REINFORCING BAR LIST

CAST UNIT CODE: P97 PCS: 1

REINFORCING BARS TYPE	POS	PCS	GRADE	D [mm]	L [mm]	dL [mm]	WEIGHT SUM [kg]	BENDING DIMENSIONS [mm] a	b	c	d	e	u	v	x	TD	COMMENT
D	P971	4	B500B	12	2270		8.1	405	1519	405						60	
D	P972	4	B500B	12	2330		8.3	435	1519	435						60	
D	P973	3	B500B	12	1420		3.8	235	1010	235						60	
D	P974	4	B500B	12	7440		26.4	444	6614	444						60	
B	P975	4	B500B	12	2180		7.8	610	1603			90				60	
A	P976	8	B500B	12	1600		11.4	1600									
A	P978	46	B500B	12	1610		66.1	1618									
A	P979	8	B500B	12	1720		12.2	1723									
A	P9710	24	B500B	12	1600		34.3	1608									
A	P9711	12	B500B	12	6680		71.2	6679									
A	P9712	8	B500B	12	1530		10.9	1529									
A	P9713	6	B500B	12	1010		5.4	1010									
YJ	P9714	65	B500B	12	1580		91.5	550	106	500	500				60		
**	P9715	24	B500B	12	1710		36.6										
YJ	P9716	22	B500B	12	1880		36.8	550	406	500	500				60		
D	P9717	12	B500B	12	1300		13.9	444	475	444						60	
A	P9718	10	B500B	12	6690		59.4	6690									
A	P9719	4	B500B	12	7400		26.3	7402									
A	P9720	10	B500B	12	1580		14.1	1588									
F	P9721	6	B500B	12	1110		5.9	120	130	288					130		
**	P9722	8	B500B	12	1890		13.5										
**	P9723	6	B500B	12	650		3.5										
C	P9724	24	B500B	12	740		15.9	469	303			98				60	
C	P9725	24	B500B	12	1020		21.7	587	457			98				60	
A	P9726	36	B500B	12	1900		61.0	1908									
A	P9727	12	B500B	12	6670		71.1	6669									
C	P9728	8	B500B	12	860		6.2	589	303			98				60	
C	P9729	8	B500B	12	1040		7.4	589	483			98				60	
D	P9730	2	B500B	12	2130		3.8	603	990	603						60	
D	P9731	2	B500B	12	1970		3.5	518	1000	518						60	
D	P9732	6	B500B	12	1110		6.0	444	290	444						60	
D	P9733	4	B500B	12	930		3.3	444	110	444						60	
E	P9734	8	B500B	12	1230		8.8	444	119	702		10				60	
C	P9736	8	B500B	12	1640		11.7	504	1145			11				60	
C	P9737	4	B500B	12	1940		6.9	804	1145			11				60	
C	P9739	8	B500B	12	540		3.8	103	437			11				288	
D	P9741	4	B500B	12	3010		10.7	911	1908	258						60	
B	P9742	4	B500B	12	2600		9.3	1928	708			90				60	
B	P9743	4	B500B	12	1550		5.5	980	609			90				60	
B	P9744	6	B500B	12	1780		9.5	1210	609			90				60	
K	P9745	4	B500B	12	920		3.3	444	444							60	
D	P9746	2	B500B	12	2580		4.6	1928	270	444						60	
K	P9747	4	B500B	12	910		3.2	444	444							60	
D	P9748	8	B500B	12	1090		7.8	444	270	444						60	
A	P9750	4	B500B	12	1540		5.5	1539									
A	P9751	4	B500B	12	1020		3.6	1020									

REINFORCING BAR TOTAL WEIGHT [kg] 861.4

REINFORCEMENT BENDING SHAPES:

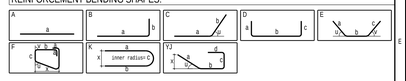


LEGEND:

R.L - REDUCED LEVEL
T.O.C. - TOP OF CONCRETE
B.O.F. - BOTTOM OF FOUNDATION
F.G.L. - FINISHED GROUND LEVEL
P.C.C. - PLAIN CEMENT CONCRETE
TYP - TYPICAL
MKD - MARKED
CL - CENTER LINE
BOTTOM REINF. (B)
TOP REINF. (T)
SBC - SAFE BEARING CAPACITY
MIN. - MINIMUM
REF. - REFERED
GA - GENERAL ARRANGEMENT
DWG. - DRAWING
R.C.C. - REINFORCED CEMENT CONCRETE

NOTES:

1. ALL DIMENSIONS ARE IN MILLIMETRES AND LEVELS ARE IN METRES UNLESS OTHERWISE STATED
2. GRADE OF CONCRETE SHALL BE C35 (35MPa) UNLESS NOTED OTHERWISE & C15 (15MPa) FOR BLINDING CONCRETE.
3. GRADE OF REINFORCEMENT SHALL BE DEFORMED BAR ASTM A615-GRADE 60 (fy=420MPa)
4. CLEAR COVER TO MAIN REINFORCEMENT SHALL BE AS FOLLOWS:
a) FOUNDATION: 75 mm (BOTTOM & SIDE)
b) FOUNDATION: 50 mm (TOP)
c) COLUMN & PEDESTAL: 50 mm
5. MINIMUM LAP LENGTHS OF REINFORCEMENT SHALL BE 40XBAR DIAMETER
6. FOR STANDARD REINFORCEMENT DETAILS & GENERAL NOTES FOR CIVIL WORKS REFER TO DRAWING NUMBER MD-216-1000-EG-CV-DED-1005 & 1001
7. ANCHOR BOLTS AND EMBEDDED STEELWORK SHALL BE HOT DIP GALVANIZED
8. T.O.C. & TOP OF SCREED TOLERANCE SHALL BE WITHIN +/- 10MM OF DESIGN LEVEL
9. NET SAFE BEARING CAPACITY OF SOIL AT BOTTOM OF FOUNDATION IS CONSIDERED AS 375 KN/SQ.M.
10. REBARS CAN BE MOVED LOCALLY BY +/- 25mm TO AVOID INTERFERENCE WITH EMBEDDED PARTS

KEYPLAN

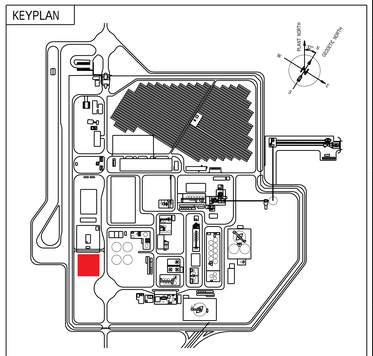

DOCUMENT NUMBER	REFERENCE DOCUMENTS	DOCUMENT NUMBER	REFERENCE DOCUMENTS
MD-101-SMEM-EG-ST-DST-0001	CONCRETE STUCTURAL STANDARDS		
MD-216-49W1-EG-CV-GAD-1003	1-10/A-E GENERAL ARRANGEMENT DRAWING	MD-216-1000-EG-ST-CRT-1001	DESIGN CRITERIA
MD-216-49W1-EG-CV-GAD-1001	1-B/E-J GENERAL ARRANGEMENT DRAWING	MD-216-49W1-EG-CV-GAD-1002	7-12/D-J GENERAL ARRANGEMENT DRAWING

REV	DATE	REVISION DESCRIPTION	DRN	CHK	ENG	APP	EMP
D01	29.01.2024	AS-BUILT	JonRen	MauNot	NanWu	LuiPiz	
C01	07.03.2022	ISSUED FOR CONSTRUCTION	JonRen	MauNot	NanWu	LuiPiz	
A01	22.02.2022	ISSUED FOR APPROVAL	JonRen	MauNot	NanWu	LuiPiz	

RESERVED FOR VENDOR LOGO AND DRAWING NUMBER

LARSEN & TOUBRO DRAWING NUMBER: — REVISION: 2

OUTOTEC DRAWING NUMBER: 900707_GAU01_AG11_CTB01_49041 — DOCUMENT ID: OU100746298 — REVISION: 2

LARSEN & TOUBRO

This drawing is the property of LARSEN & TOUBRO and must not be passed on to any person or body not authorised by us to receive it or be copied or otherwise made use either in full or in part by such person or body without our prior permission in writing.

Outotec

The content of these documents are the sole property of Outotec Oyj. Any rights not expressly granted herein are reserved. Reproduction, transfer or distribution of part or all of the contents in any form without prior written permission of Outotec is prohibited.

MA'ADEN معادن — Saudi Arabian Mining Company — شركة معادن العربية السعودية

This document and the information contained herein is Ma'aden proprietary know-how. This document or any part thereof should not be reproduced, stored in a retrieval system or transmitted by any means, electronic or otherwise, or divulged without prior written permission of Ma'aden.

DRAWN	JonRen	21.02.2022
CHECKED	MauNot	21.02.2022
ENGINEER	NanWu	21.02.2022
APPROVED	LuiPiz	21.02.2022
EMPLOYER		
SCALE	1:15	A0

MANSOURAH - MASSARAH GOLD PROJECT
49W1 RAW WATER TREATMENT PLANT
SOUTH CONTAINER PLATFORM
DETAIL- AND REINFORCEMENT DRAWING

DRAWING NUMBER: MD-216-49W1-EG-CV-DED-1041 — REV: D01

Adobe Structure