

MD-216-49W1-EG-CV-GAD-1003 | REV D01

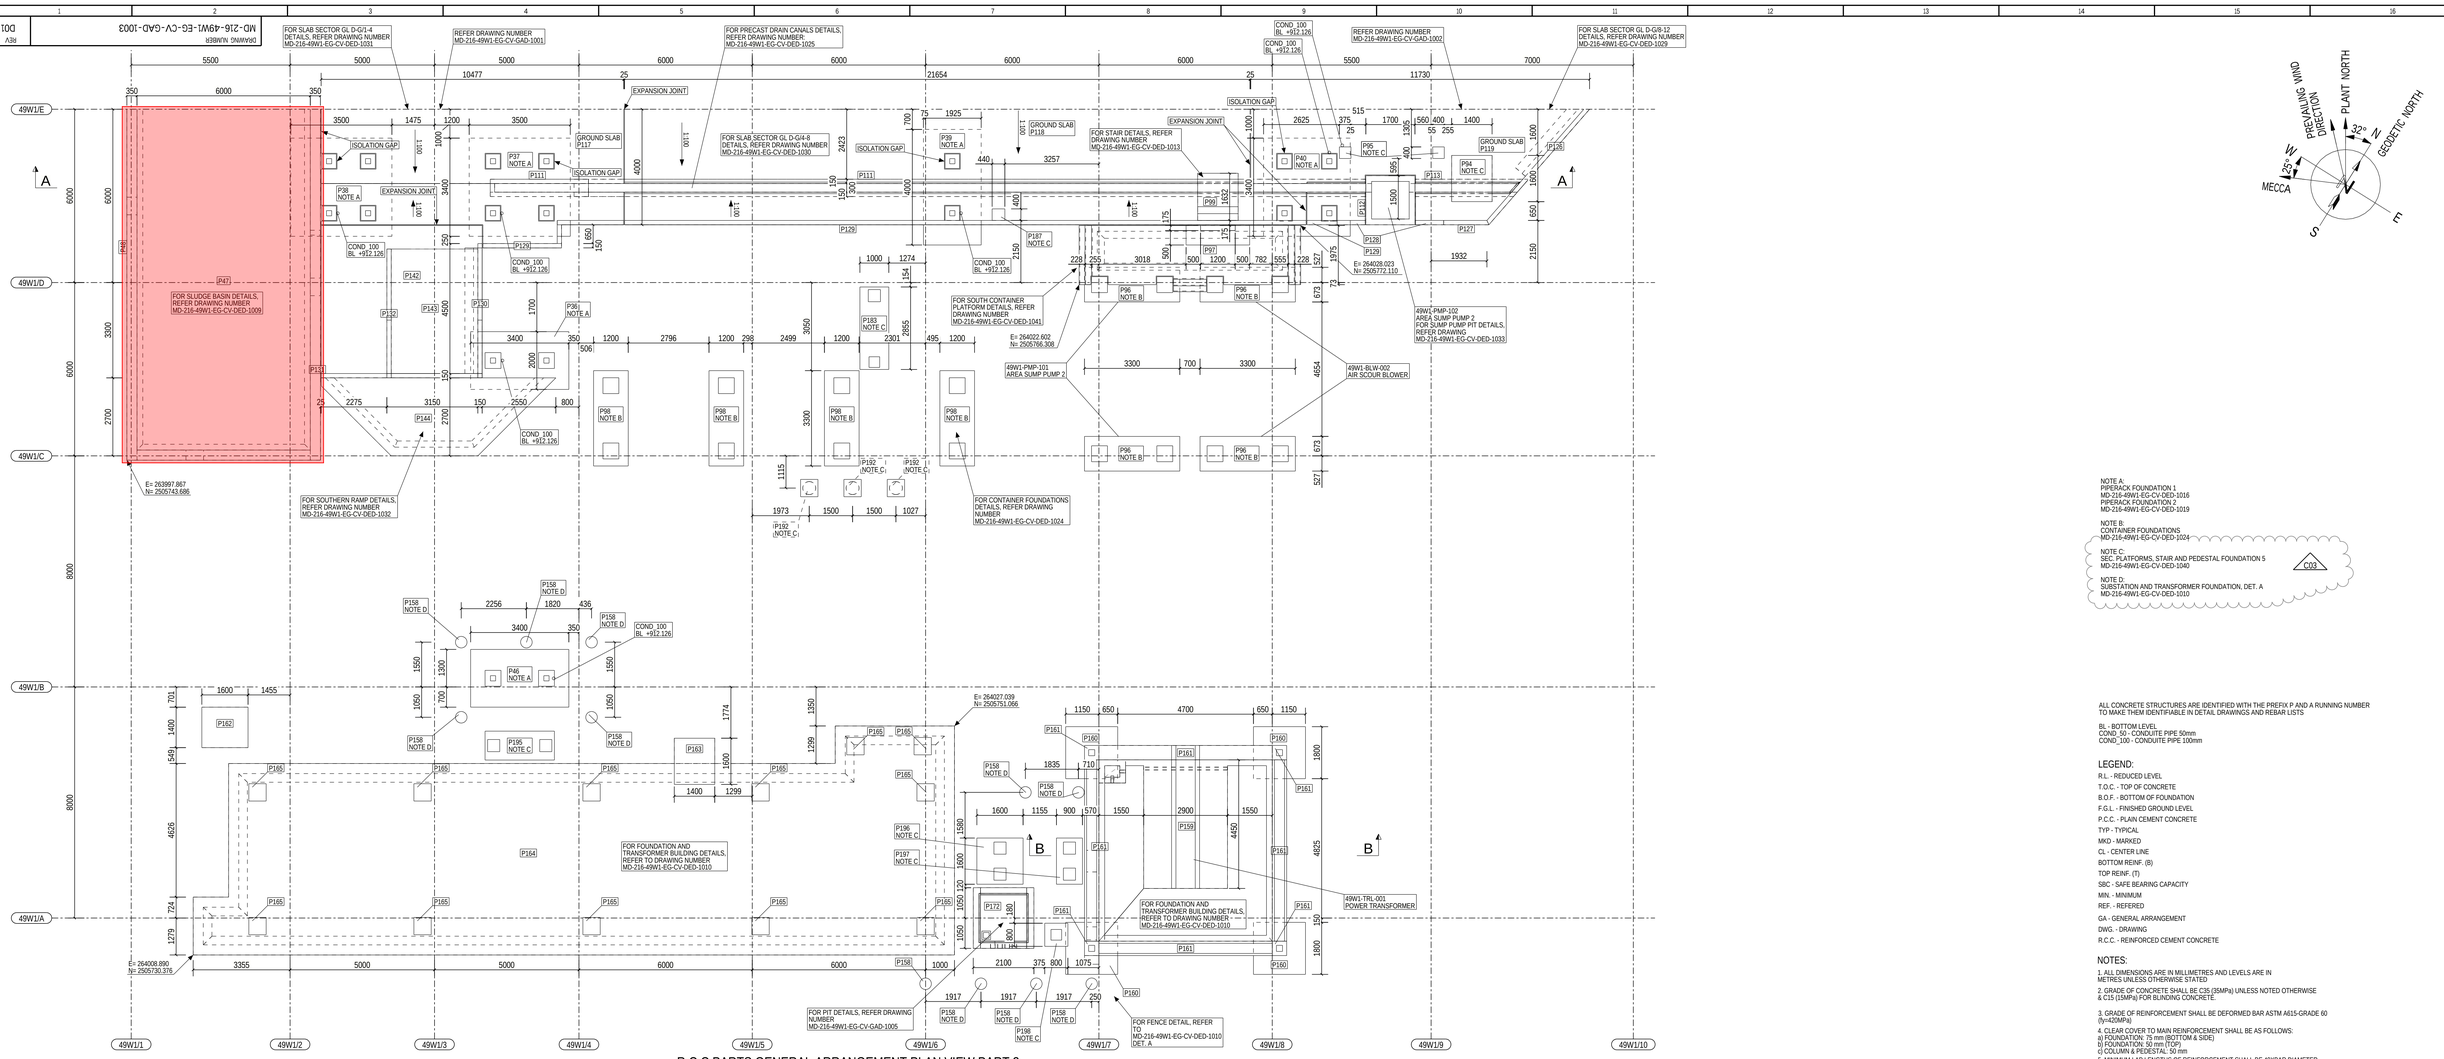

R.C.C PARTS GENERAL ARRANGEMENT PLAN VIEW PART 3
(SCALE 1:75)

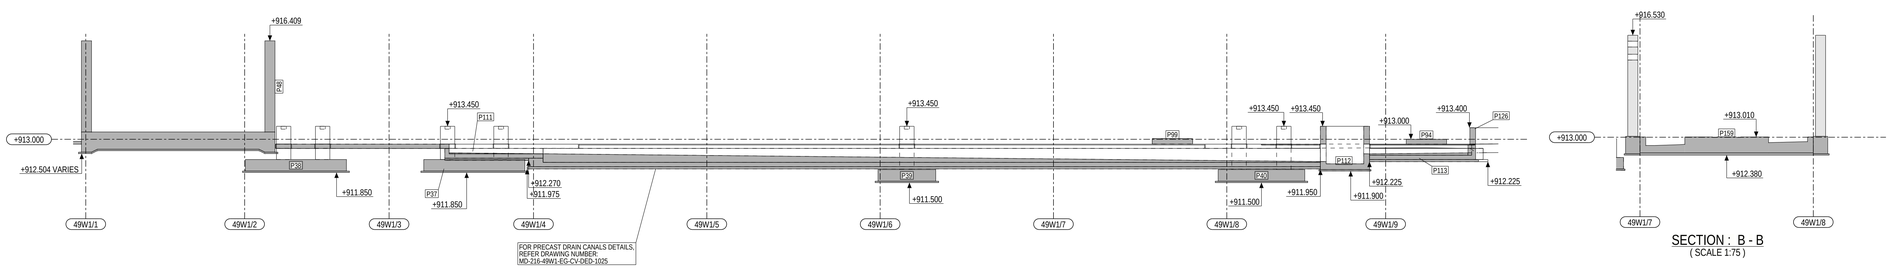

SECTION : A - A
(SCALE 1:75)

SECTION : B - B
(SCALE 1:75)

NOTE A:
PIPERACK FOUNDATION 1
MD-216-49W1-EG-CV-DED-1016
PIPERACK FOUNDATION 2
MD-216-49W1-EG-CV-DED-1019

NOTE B:
CONTAINER FOUNDATIONS
MD-216-49W1-EG-CV-DED-1024

NOTE C:
SEC. PLATFORMS, STAIR AND PEDESTAL FOUNDATION 5
MD-216-49W1-EG-CV-DED-1040

NOTE D:
SUBSTATION AND TRANSFORMER FOUNDATION, DET. A
MD-216-49W1-EG-CV-DED-1010

C03

ALL CONCRETE STRUCTURES ARE IDENTIFIED WITH THE PREFIX P AND A RUNNING NUMBER TO MAKE THEM IDENTIFIABLE IN DETAIL DRAWINGS AND REBAR LISTS

BL - BOTTOM LEVEL
COND_50 - CONDUITE PIPE 50mm
COND_100 - CONDUITE PIPE 100mm


LEGEND:

R.L - REDUCED LEVEL
T.O.C. - TOP OF CONCRETE
B.O.F. - BOTTOM OF FOUNDATION
F.G.L. - FINISHED GROUND LEVEL
P.C.C. - PLAIN CEMENT CONCRETE
TYP - TYPICAL
MKD - MARKED
CL - CENTER LINE
BOTTOM REINF. (B)
TOP REINF. (T)
SBC - SAFE BEARING CAPACITY
MIN. - MINIMUM
REF. - REFERED
GA - GENERAL ARRANGEMENT
DWG. - DRAWING
R.C.C. - REINFORCED CEMENT CONCRETE

NOTES:

1. ALL DIMENSIONS ARE IN MILLIMETRES AND LEVELS ARE IN METRES UNLESS OTHERWISE STATED
2. GRADE OF CONCRETE SHALL BE C35 (35MPa) UNLESS NOTED OTHERWISE & C15 (15MPa) FOR BLINDING CONCRETE.
3. GRADE OF REINFORCEMENT SHALL BE DEFORMED BAR ASTM A615-GRADE 60 (fy=420MPa)
4. CLEAR COVER TO MAIN REINFORCEMENT SHALL BE AS FOLLOWS:
a) FOUNDATION: 75 mm (BOTTOM & SIDE)
b) FOUNDATION: 50 mm (TOP)
c) COLUMN & PEDESTAL: 50 mm
5. MINIMUM LAP LENGTHS OF REINFORCEMENT SHALL BE 40XBAR DIAMETER
6. FOR STANDARD REINFORCEMENT DETAILS & GENERAL NOTES FOR CIVIL WORKS REFER TO DRAWING NUMBER MD-216-1000-EG-CV-DED-1005 & 1001
7. ANCHOR BOLTS AND EMBEDDED STEELWORK SHALL BE HOT DIP GALVANIZED
8. T.O.C. & TOP OF SCREED TOLERANCE SHALL BE WITHIN +/- 10MM OF DESIGN LEVEL
9. NET SAFE BEARING CAPACITY OF SOIL AT BOTTOM OF FOUNDATION IS CONSIDERED AS 375 KN/SQ.M.
10. REBARS CAN BE MOVED LOCALLY BY +/- 25mm TO AVOID INTERFERENCE WITH EMBEDDED PARTS
11. FOR DETAILS OF SLAB EDGE THICKENING AND RE-ENTRANT REBARS REFER MD-101-SMEM-EG-ST-DST-002 AND MD-101-SMEM-EG-ST-DST-007, FOR DETAILS OF SLAB JOINTS REFER MD-216-1000-EG-CV-DED-1002

KEYPLAN

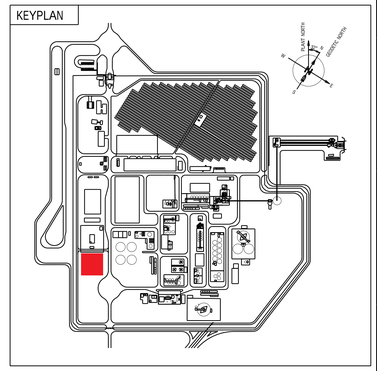

DOCUMENT NUMBER	REFERENCE DOCUMENTS
MD-216-49W1-EG-CV-DED-1013	STAIRS DETAIL- AND REINFORCEMENT DRAWING
MD-216-49W1-EG-CV-DED-1040	SEC. PLATFORMS, STAIR AND PEDESTAL FOUNDATION 5 DETAIL- AND REINFORCEMENT
MD-216-49W1-EG-CV-DED-1034	CONTAINER PLATFORM AND STAIRS DETAIL- AND REINFORCEMENT DRAWING
MD-216-49W1-EG-CV-DED-1029	SLAB SECTOR GL D-G/8-12 DETAIL- AND REINFORCEMENT DRAWING
MD-216-49W1-EG-CV-DED-1031	SLAB SECTOR GL D-G/1-4 SLAB SECTOR GL D-G/1-4
MD-216-49W1-EG-CV-DED-1019	PIPERACK FOUNDATION 2 DETAIL- AND REINFORCEMENT DRAWING
MD-216-49W1-EG-CV-DED-1033	SUMP PUMP PIT DIMENSIONAL- AND REINFORCEMENT DRAWING
MD-216-49W1-EG-CV-GAD-1004	49W1 ROAD AND DETACHED STRUCTURES GENERAL ARRANGEMENT DRAWING
MD-216-49W1-EG-CV-GAD-1001	1-8/E-J GENERAL ARRANGEMENT DRAWING

DOCUMENT NUMBER	REFERENCE DOCUMENTS
MD-216-49W1-EG-CV-DED-1010	SUBSTATION AND TRANSFORMER FOUNDATION DIMENSIONAL DRAWING
MD-216-49W1-EG-CV-DED-1041	SOUTH CONTAINER PLATFORM DETAIL- AND REINFORCEMENT DRAWING
MD-216-49W1-EG-CV-DED-1025	PRECAST DRAIN CANALS DIMENSIONAL- AND REINFORCEMENT DRAWING
MD-216-49W1-EG-CV-DED-1030	SLAB SECTOR GL D-G/4-8 DETAIL- AND REINFORCEMENT DRAWING
MD-216-49W1-EG-CV-DED-1032	SOUTHERN RAMP DETAIL- AND REINFORCEMENT DRAWING
MD-216-49W1-EG-CV-DED-1016	PIPERACK FOUNDATION 1 DETAIL- AND REINFORCEMENT DRAWING
MD-216-49W1-EG-CV-DED-1024	CONTAINER FOUNDATIONS DETAIL- AND REINFORCEMENT DRAWING
MD-216-49W1-EG-CV-GAD-1002	7-12/D-J GENERAL ARRANGEMENT DRAWING

REV	DATE	REVISION DESCRIPTION	DRN	CHK	ENG	APP	EMP
D01	29.01.2024	AS-BUILT	JonRen	MauNot	NarWu	LuiPiz	
C03	21.02.2022	REFERENCE TO SEC. PLATFORMS, STAIRS AND PEDESTALS ADDED	JonRen	MauNot	NarWu	LuiPiz	
C02	15.02.2022	LAYOUT UPDATED, HOLD MARKS REMOVED, REFERENCES ADDED	JonRen	MauNot	NarWu	LuiPiz	
C01	07.01.2021	ISSUED FOR CONSTRUCTION	JonRen	MauNot	NarWu	LuiPiz	
A02	29.11.2021	ISSUED FOR APPROVAL	JonRen	MauNot	NarWu	LuiPiz	
A01	29.10.2021	ISSUED FOR REFERENCE	JonRen	MauNot	NarWu	LuiPiz	

RESERVED FOR VENDOR LOGO AND DRAWING NUMBER

LARSEN & TOUBRO

This drawing is the property of LARSEN & TOUBRO and must not be passed on to any person or body not authorized by us to receive it or be copied or otherwise made use either in full or in part by such person or body without our prior permission in writing.

Outotec

The content of these documents are the sole property of Outotec Oyj. Any rights not expressly granted herein are reserved. Reproduction, transfer or distribution of part or all of the contents in any form without prior written permission of Outotec is prohibited.

MA'ADEN معادن
Saudi Arabian Mining Company شركة معادن العربية السعودية

This document and the information contained herein is Ma'aden proprietary know-how. This document or any part thereof should not be reproduced, stored in a retrieval system or transmitted by any means, electronic or otherwise, or divulged without prior written permission of Ma'aden.

LARSEN & TOUBRO DRAWING NUMBER	O19045_080_C_G_24891_003	REVISION 5
OUTOTEC DRAWING NUMBER	900707_GAU01_AG11_MTL01_49043	DOCUMENT ID OU100732599 / REVISION 5
DRAWN	JonRen	29.10.2021
CHECKED	MauNot	29.10.2021
ENGINEER	NarWu	29.10.2021
APPROVED	LuiPiz	29.10.2021
EMPLOYER		
SCALE	1:75	A0

MANSOURAH - MASSARAH GOLD PROJECT
49W1 RAW WATER TREATMENT PLANT
GL 1-10/A-E
GENERAL ARRANGEMENT DRAWING

DRAWING NUMBER: MD-216-49W1-EG-CV-GAD-1003 | REV: D01