

DRAWING NUMBER: MD-216-49W1-EG-CV-GAD-1004 | REV: D01

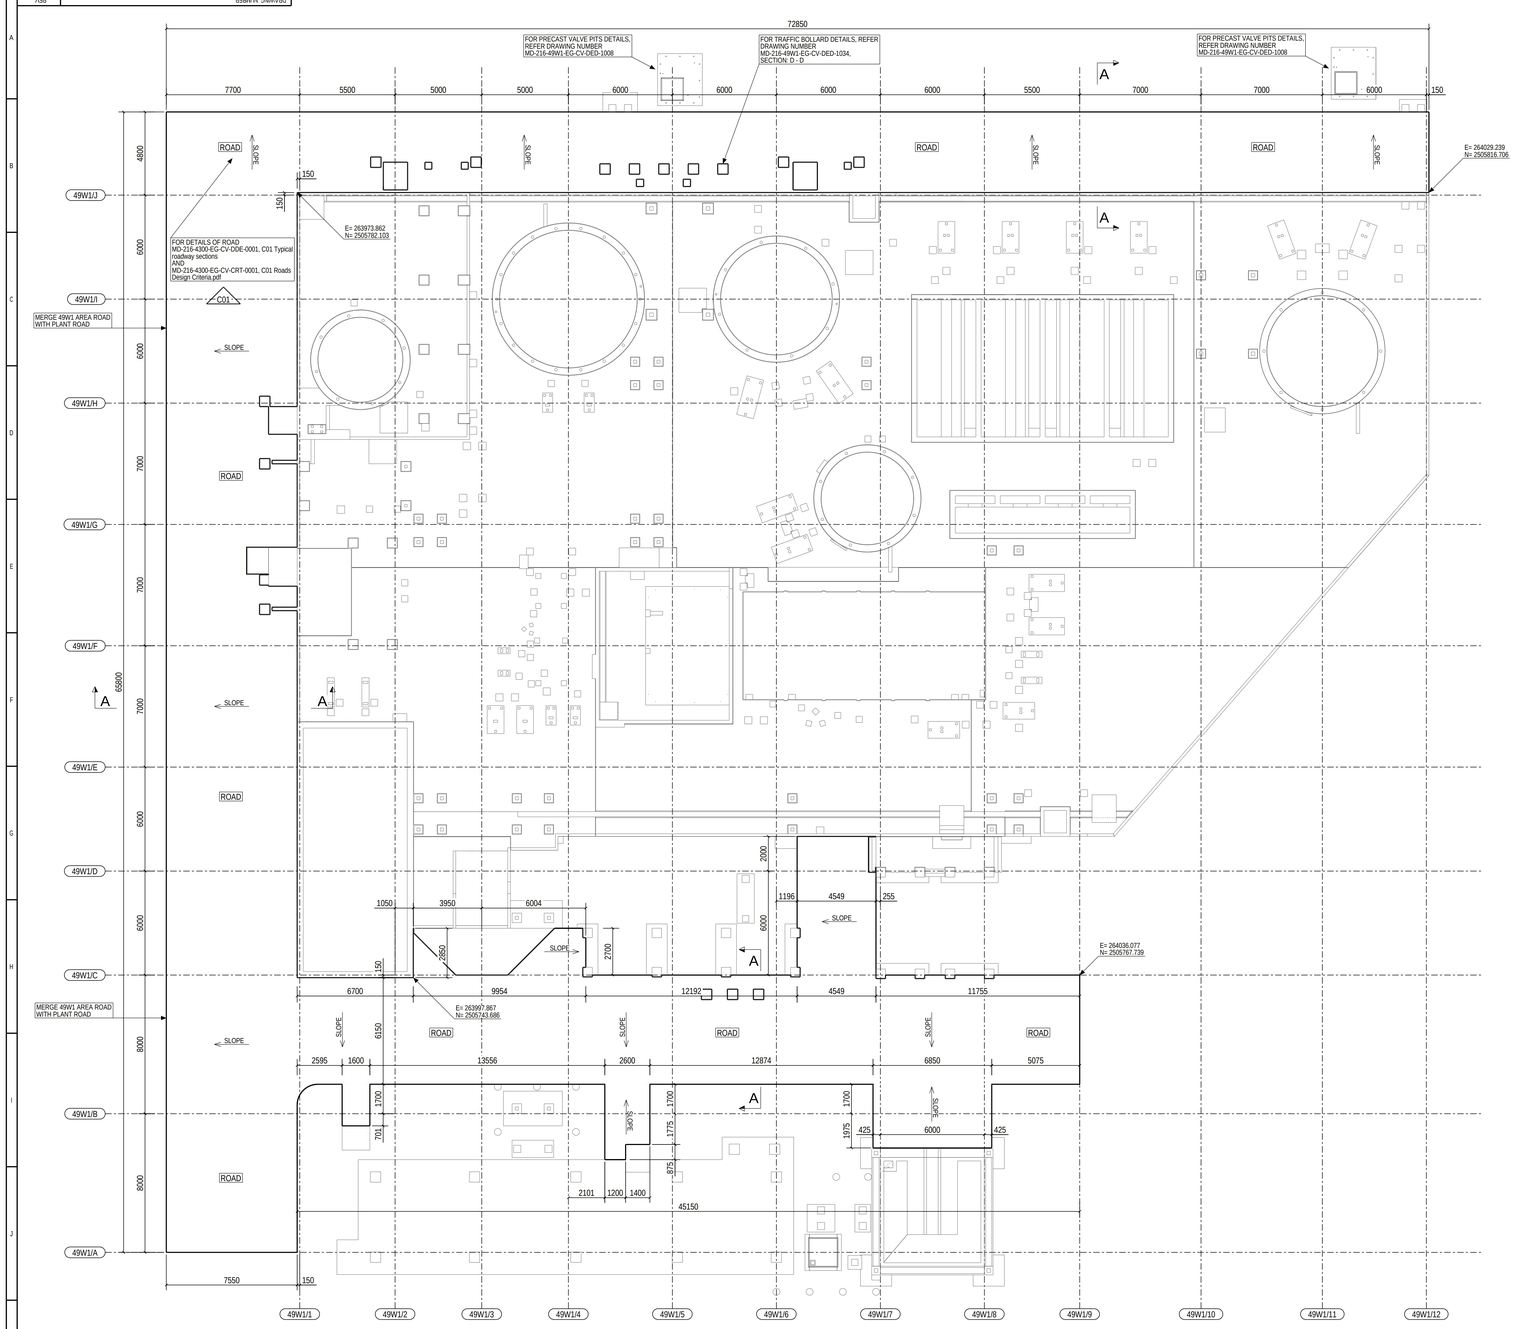



ROAD DIMENSIONS
(SCALE 1:125)

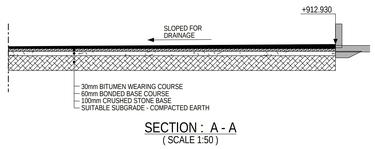

ROADTYPE B ACCORDING TO MD-216-4300-EG-CV-DDE-0001, C01 Typical roadway sections

SECTION : A - A
(SCALE 1:50)

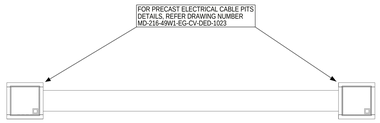

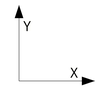


LEGEND:

R.L - REDUCED LEVEL
T.O.C. - TOP OF CONCRETE
B.O.F. - BOTTOM OF FOUNDATION
F.G.L. - FINISHED GROUND LEVEL
P.C.C. - PLAIN CEMENT CONCRETE
TYP - TYPICAL
MKD - MARKED
CL - CENTER LINE
BOTTOM REINF. (B)
TOP REINF. (T)
SBC - SAFE BEARING CAPACITY
MIN. - MINIMUM
REF. - REFERED
GA - GENERAL ARRANGEMENT
DWG. - DRAWING
R.C.C. - REINFORCED CEMENT CONCRETE

NOTES:

1. ALL DIMENSIONS ARE IN MILLIMETRES AND LEVELS ARE IN METRES UNLESS OTHERWISE STATED
2. GRADE OF CONCRETE SHALL BE C35 (35MPa) UNLESS NOTED OTHERWISE & C15 (15MPa) FOR BUNDING CONCRETE.
3. GRADE OF REINFORCEMENT SHALL BE DEFORMED BAR ASTM A615-GRADE 60 (fy=420MPa)
4. CLEAR COVER TO MAIN REINFORCEMENT SHALL BE AS FOLLOWS:
a) FOUNDATION: 75 mm (BOTTOM & SIDE)
b) FOUNDATION: 50 mm (TOP)
c) COLUMN & PEDESTAL: 50 mm
5. MINIMUM LAP LENGTHS OF REINFORCEMENT SHALL BE 40XBAR DIAMETER
6. FOR STANDARD REINFORCEMENT DETAILS & GENERAL NOTES FOR CIVIL WORKS REFER TO DRAWING NUMBER MD-216-1000-EG-CV-DED-1005 & 1001
7. ANCHOR BOLTS AND EMBEDDED STEELWORK SHALL BE HOT DIP GALVANIZED
8. T.O.C. & TOP OF SCREED TOLERANCE SHALL BE WITHIN +/- 10MM OF DESIGN LEVEL
9. NET SAFE BEARING CAPACITY OF SOIL AT BOTTOM OF FOUNDATION IS CONSIDERED AS 375 KN/SQ.M.
10. REBARS CAN BE MOVED LOCALLY BY +/- 25mm TO AVOID INTERFERENCE WITH EMBEDDED PARTS

KEYPLAN

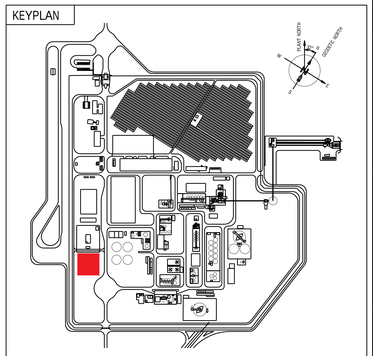

DOCUMENT NUMBER	REFERENCE DOCUMENTS
MD-216-49W1-EG-CV-GAD-1003	1-J1/A-E GENERAL ARRANGEMENT DRAWING
MD-216-49W1-EG-CV-GAD-1001	1-B/E-J GENERAL ARRANGEMENT DRAWING

DOCUMENT NUMBER	REFERENCE DOCUMENTS
MD-216-4300-EG-CV-DDE-0001	C01 TYPICAL ROADWAY SECTIONS
MD-216-49W1-EG-CV-GAD-1002	7-12/D-J GENERAL ARRANGEMENT DRAWING

REV	DATE	REVISION DESCRIPTION	DRN	CHK	ENG	APP	EMP
D01	29.01.2024	AS-BUILT	JonRen	MauNot	NanWu	LuiPiz	
C02	23.02.2022	ROAD GEOMETRY UPDATED, OUTSIDE STRUCTURES DIMENSIONS REMOVED	JonRen	MauNot	NanWu	LuiPiz	
C01	29.11.2021	ISSUED FOR CONSTRUCTION	JonRen	MauNot	NanWu	LuiPiz	
A01	29.10.2021	ISSUED FOR APPROVAL	JonRen	MauNot	NanWu	LuiPiz	

RESERVED FOR VENDOR LOGO AND DRAWING NUMBER

LARSEN & TOUBRO

This drawing is the property of LARSEN & TOUBRO and must not be passed on to any person or body not authorized by us to receive it or be copied or otherwise made use either in full or in part by such person or body without our prior permission in writing.

Outotec

The content of these documents are the sole property of Outotec Oyj. Any rights not expressly granted herein are reserved. Reproduction, transfer or distribution of part or all of the contents in any form without prior written permission of Outotec is prohibited.

MA'ADEN معادن
Saudi Arabian Mining Company شركة معادن العربية السعودية

This document and the information contained herein is Ma'aden proprietary know-how. This document or any part thereof should not be reproduced, stored in a retrieval system or transmitted by any means, electronic or otherwise, or divulged without prior written permission of Ma'aden.

LARSEN & TOUBRO DRAWING NUMBER: 019045_080_C_G_24891_004 | REVISION: 3
OUTOTEC DRAWING NUMBER: 900707_GAU01_AG11_MTL01_49044 | DOCUMENT ID: OU100732600 | REVISION: 3

DRAWN	JonRen	29.10.2021
CHECKED	MauNot	29.10.2021
ENGINEER	NanWu	29.10.2021
APPROVED	LuiPiz	29.10.2021
EMPLOYER		
SCALE		A0

MANSOURAH - MASSARAH GOLD PROJECT
49W1 RAW WATER TREATMENT PLANT
49W1 ROAD AND DETACHED STRUCTURES
GENERAL ARRANGEMENT DRAWING

DRAWING NUMBER: MD-216-49W1-EG-CV-GAD-1004 | REV: D01