DRAWING NUMBER
MD-216-49W1-EG-CV-GAD-1005
REV
D01

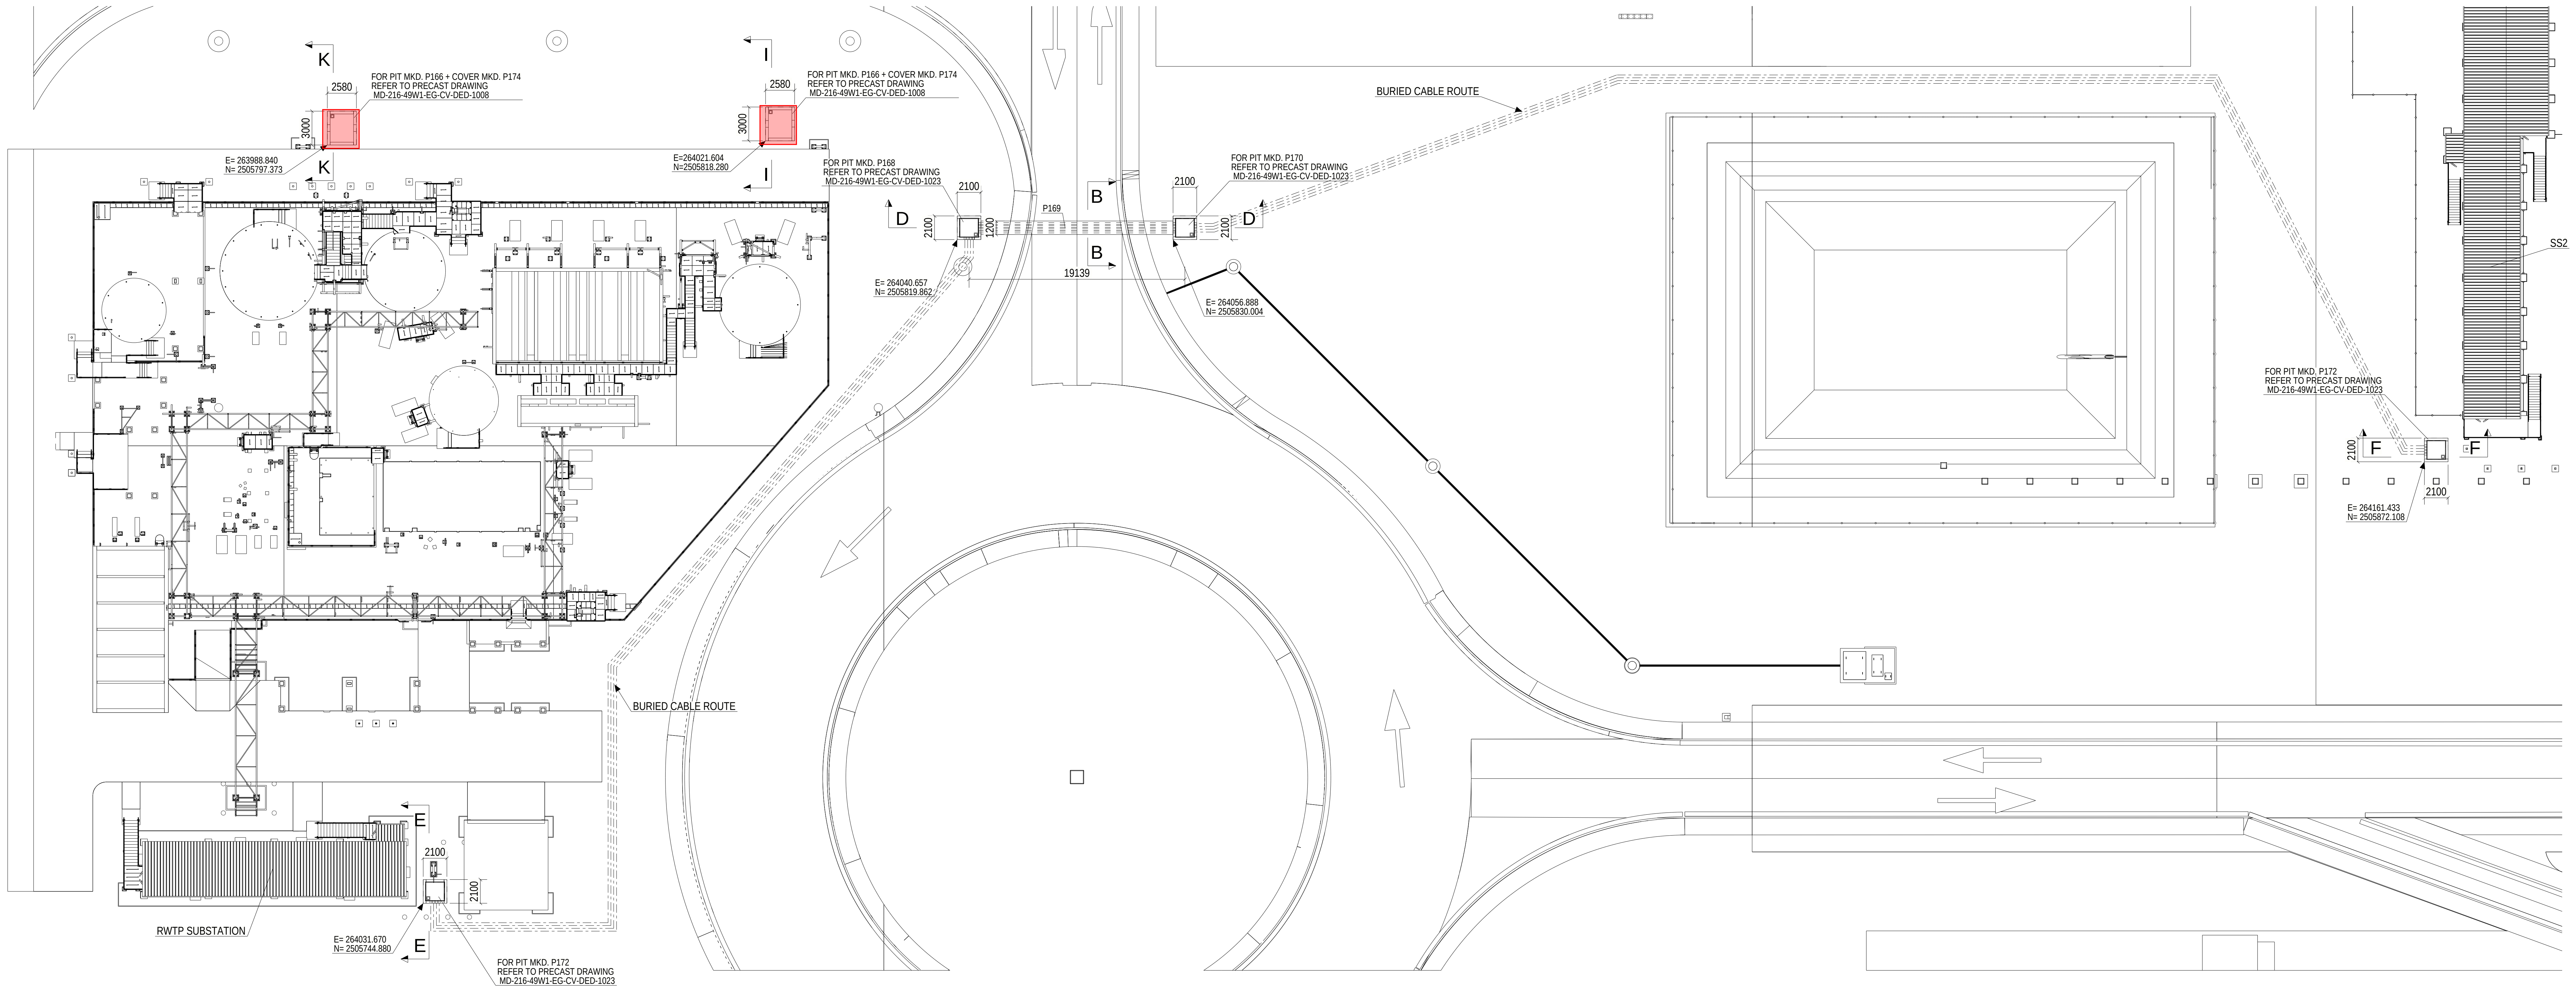
FOR PIT MKD. P166 + COVER MKD. P174
REFER TO PRECAST DRAWING
MD-216-49W1-EG-CV-DED-1008
FOR PIT MKD. P168
REFER TO PRECAST DRAWING
MD-216-49W1-EG-CV-DED-1023
FOR PIT MKD. P170
REFER TO PRECAST DRAWING
MD-216-49W1-EG-CV-DED-1023
FOR PIT MKD. P172
REFER TO PRECAST DRAWING
MD-216-49W1-EG-CV-DED-1023
BURIED CABLE ROUTE
RWTP SUBSTATION
SS2
P169
19139
E= 263988.840
N= 2505797.373
E= 264021.604
N= 2505818.280
E= 264040.657
N= 2505819.862
E= 264056.888
N= 2505830.004
E= 264161.433
N= 2505872.108
E= 264031.670
N= 2505744.880
2580
3000
2100
1200
B
D
E
F
I
K

LAYOUT PLAN
(SCALE 1:250)

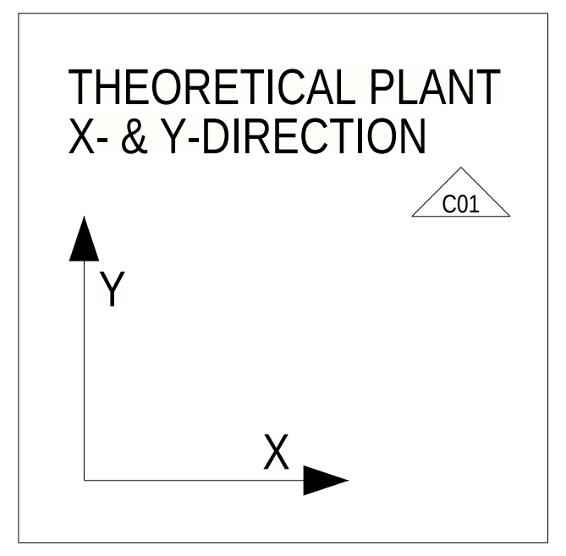

THEORETICAL PLANT X- & Y-DIRECTION

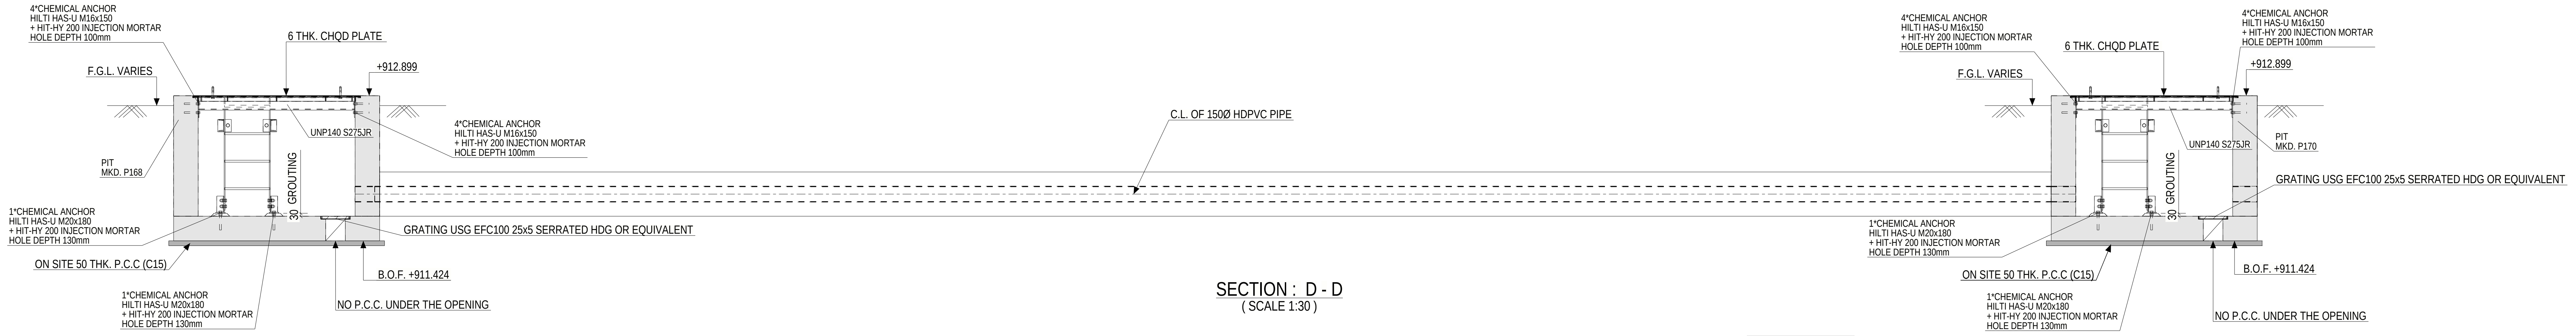
4*CHEMICAL ANCHOR
HILTI HAS-U M16x150
+ HIT-HY 200 INJECTION MORTAR
HOLE DEPTH 100mm
6 THK. CHQD PLATE
F.G.L. VARIES
+912.899
C.L. OF 150Ø HDPVC PIPE
UNP140 S275JR
PIT
MKD. P168
PIT
MKD. P170
30 GROUTING
1*CHEMICAL ANCHOR
HILTI HAS-U M20x180
+ HIT-HY 200 INJECTION MORTAR
HOLE DEPTH 130mm
GRATING USG EFC100 25x5 SERRATED HDG OR EQUIVALENT
ON SITE 50 THK. P.C.C (C15)
B.O.F. +911.424
NO P.C.C. UNDER THE OPENING

SECTION : D - D
(SCALE 1:30)

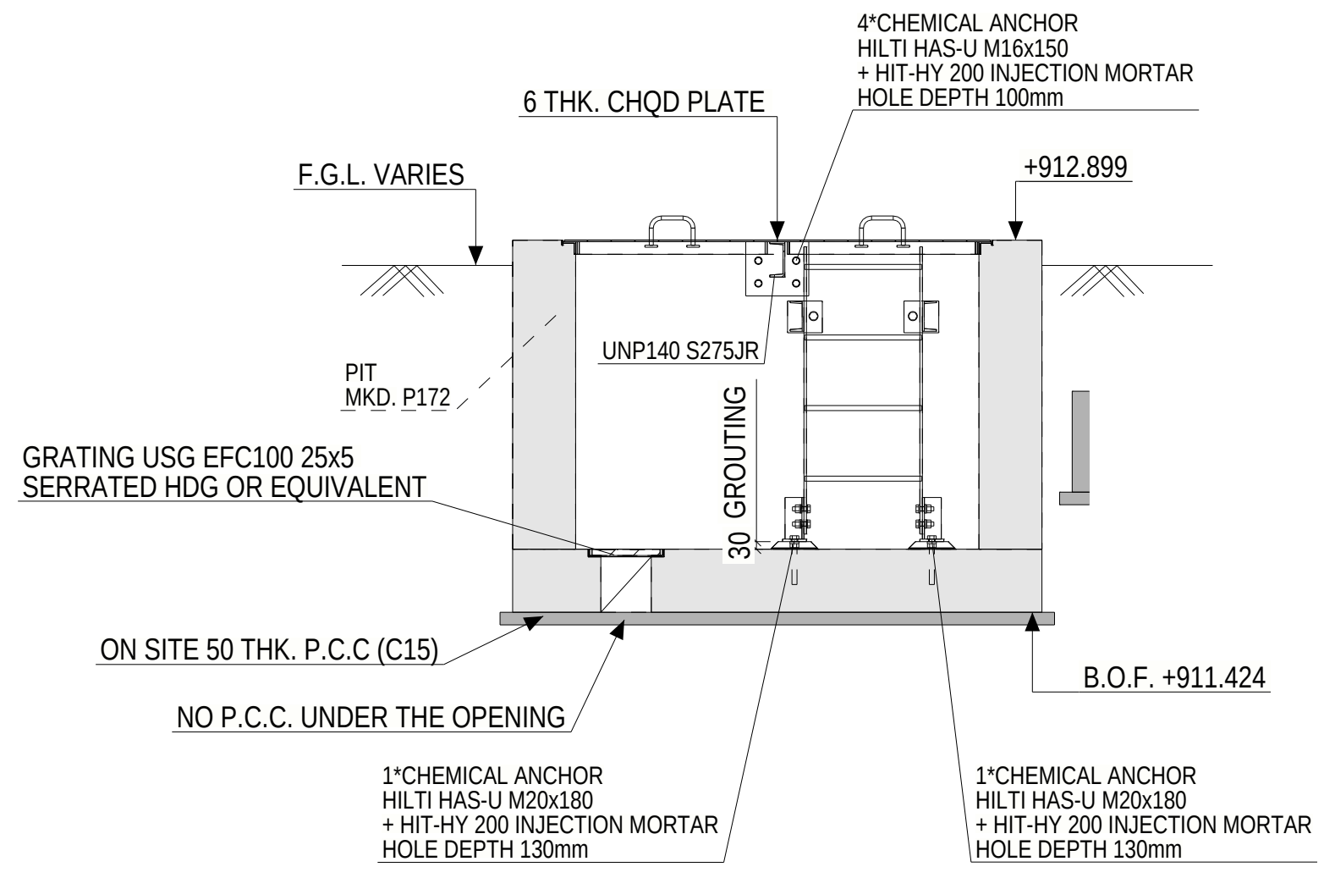
4*CHEMICAL ANCHOR
HILTI HAS-U M16x150
+ HIT-HY 200 INJECTION MORTAR
HOLE DEPTH 100mm
6 THK. CHQD PLATE
F.G.L. VARIES
+912.899
PIT
MKD. P172
UNP140 S275JR
GRATING USG EFC100 25x5
SERRATED HDG OR EQUIVALENT
30 GROUTING
ON SITE 50 THK. P.C.C (C15)
NO P.C.C. UNDER THE OPENING
B.O.F. +911.424
1*CHEMICAL ANCHOR
HILTI HAS-U M20x180
+ HIT-HY 200 INJECTION MORTAR
HOLE DEPTH 130mm

SECTION : E - E
(SCALE 1:30)

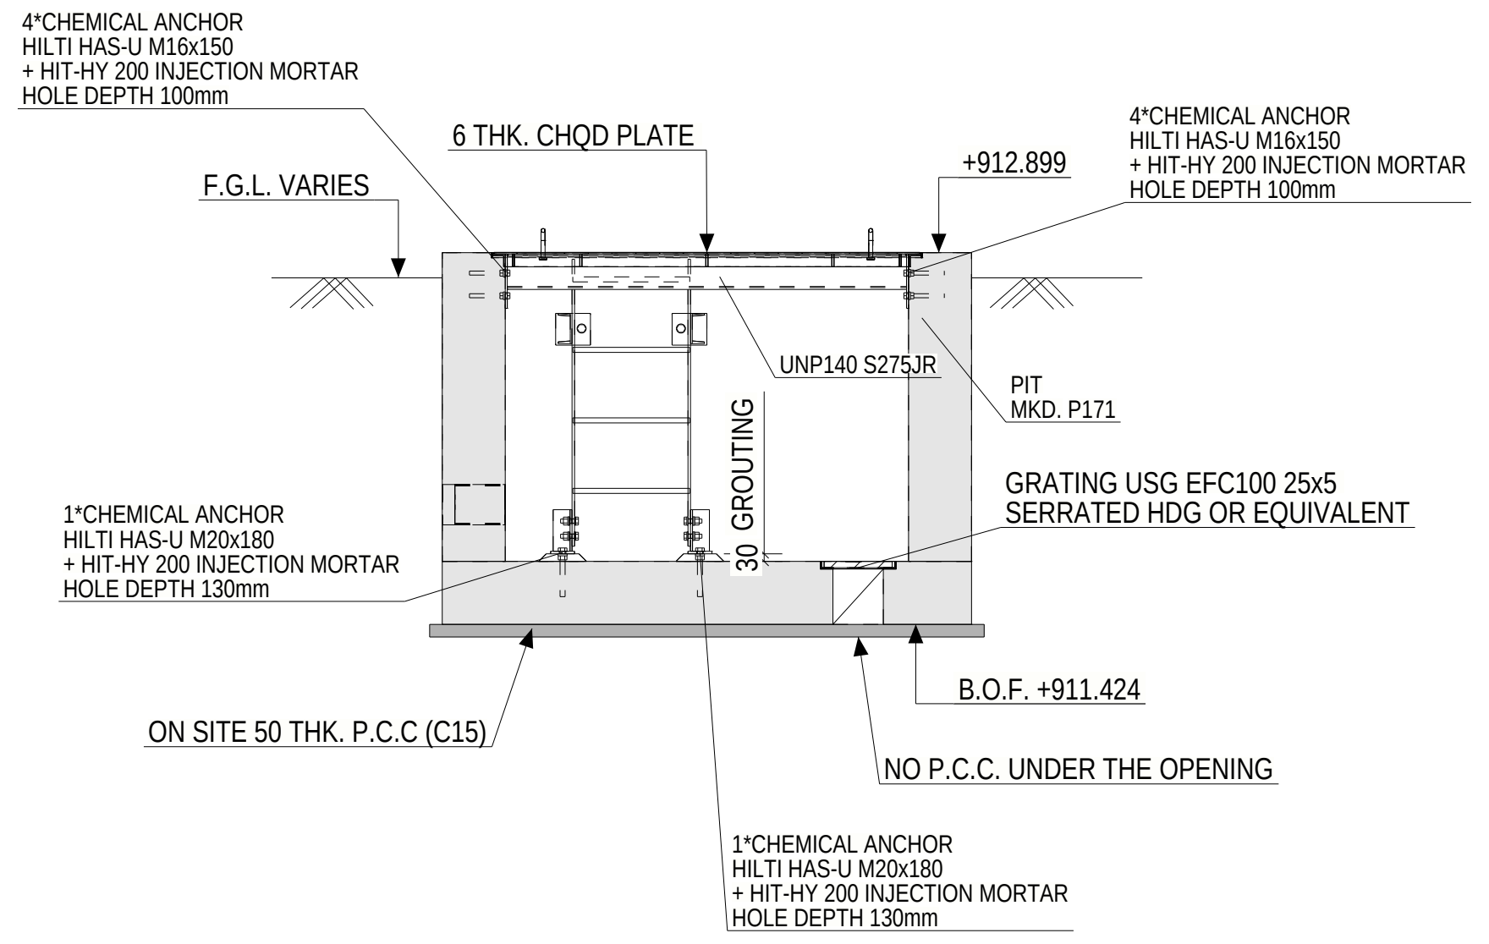
4*CHEMICAL ANCHOR
HILTI HAS-U M16x150
+ HIT-HY 200 INJECTION MORTAR
HOLE DEPTH 100mm
6 THK. CHQD PLATE
F.G.L. VARIES
+912.899
UNP140 S275JR
PIT
MKD. P171
GRATING USG EFC100 25x5
SERRATED HDG OR EQUIVALENT
30 GROUTING
1*CHEMICAL ANCHOR
HILTI HAS-U M20x180
+ HIT-HY 200 INJECTION MORTAR
HOLE DEPTH 130mm
ON SITE 50 THK. P.C.C (C15)
B.O.F. +911.424
NO P.C.C. UNDER THE OPENING

SECTION : F - F
(SCALE 1:30)

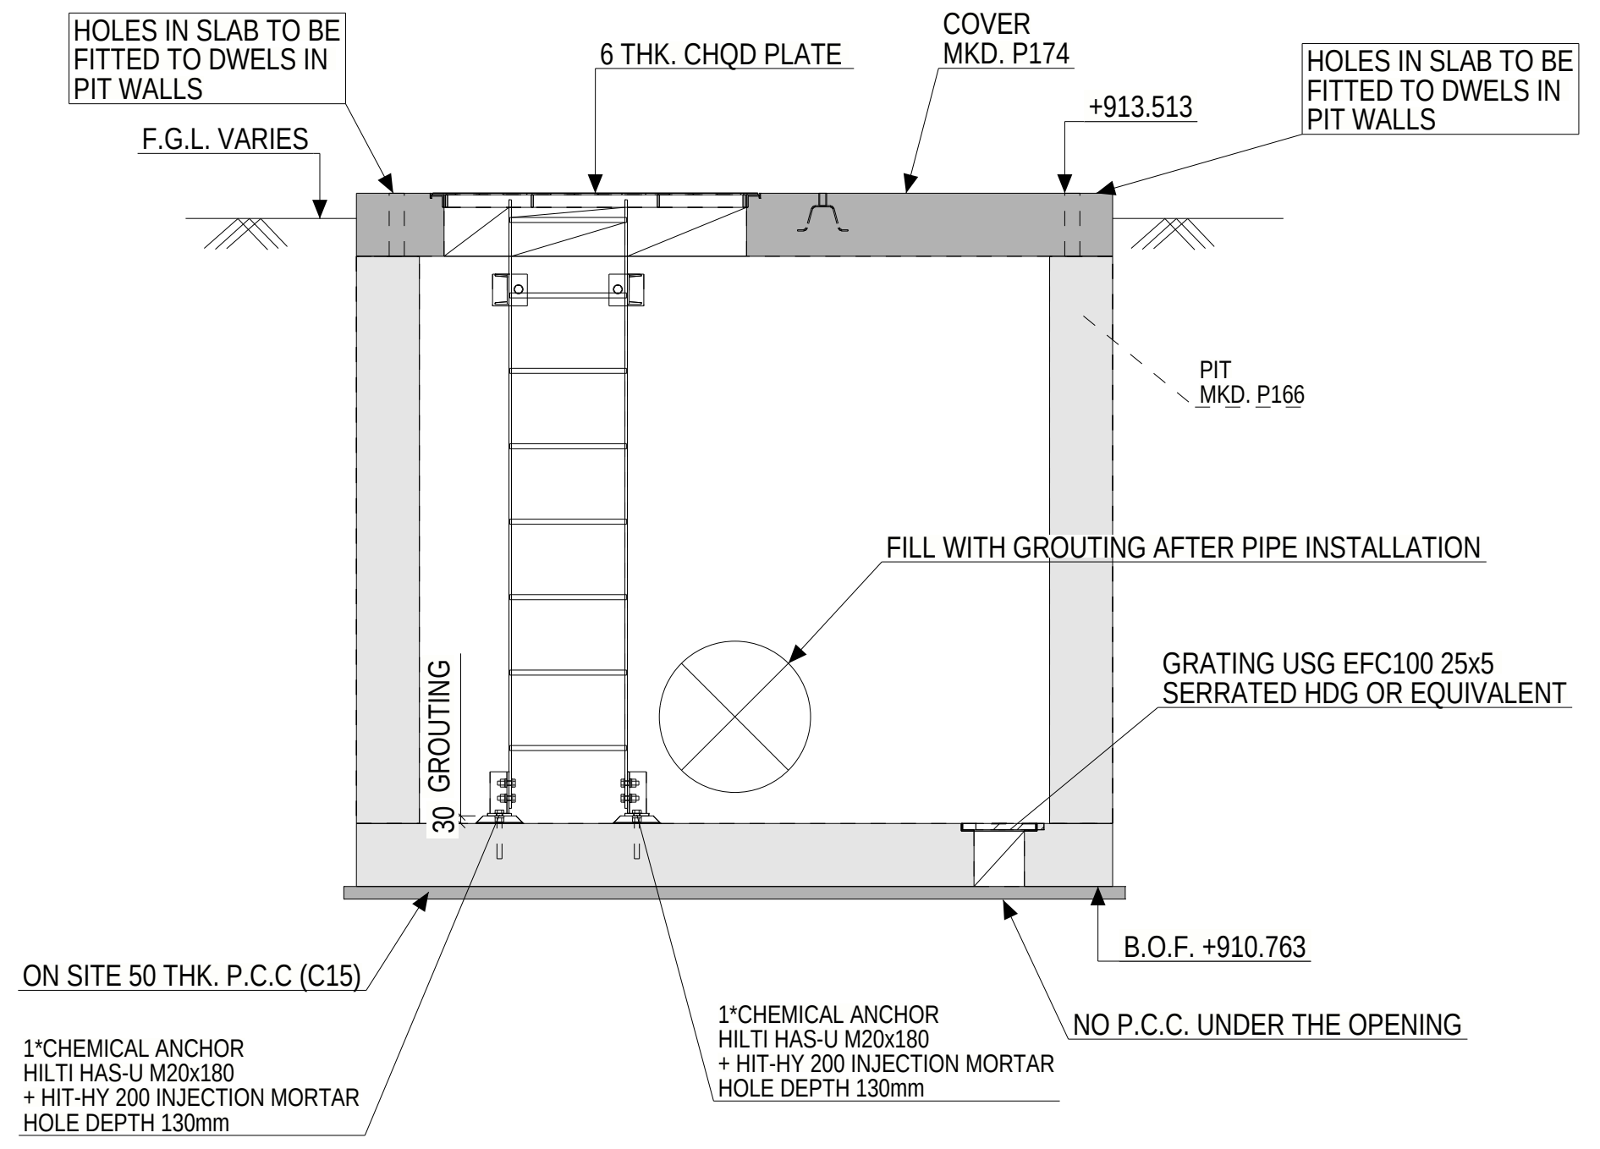
HOLES IN SLAB TO BE
FITTED TO DWELS IN
PIT WALLS
6 THK. CHQD PLATE
COVER
MKD. P174
+913.513
F.G.L. VARIES
PIT
MKD. P166
FILL WITH GROUTING AFTER PIPE INSTALLATION
GRATING USG EFC100 25x5
SERRATED HDG OR EQUIVALENT
30 GROUTING
ON SITE 50 THK. P.C.C (C15)
1*CHEMICAL ANCHOR
HILTI HAS-U M20x180
+ HIT-HY 200 INJECTION MORTAR
HOLE DEPTH 130mm
B.O.F. +910.763
NO P.C.C. UNDER THE OPENING

SECTION : I - I
(SCALE 1:30)

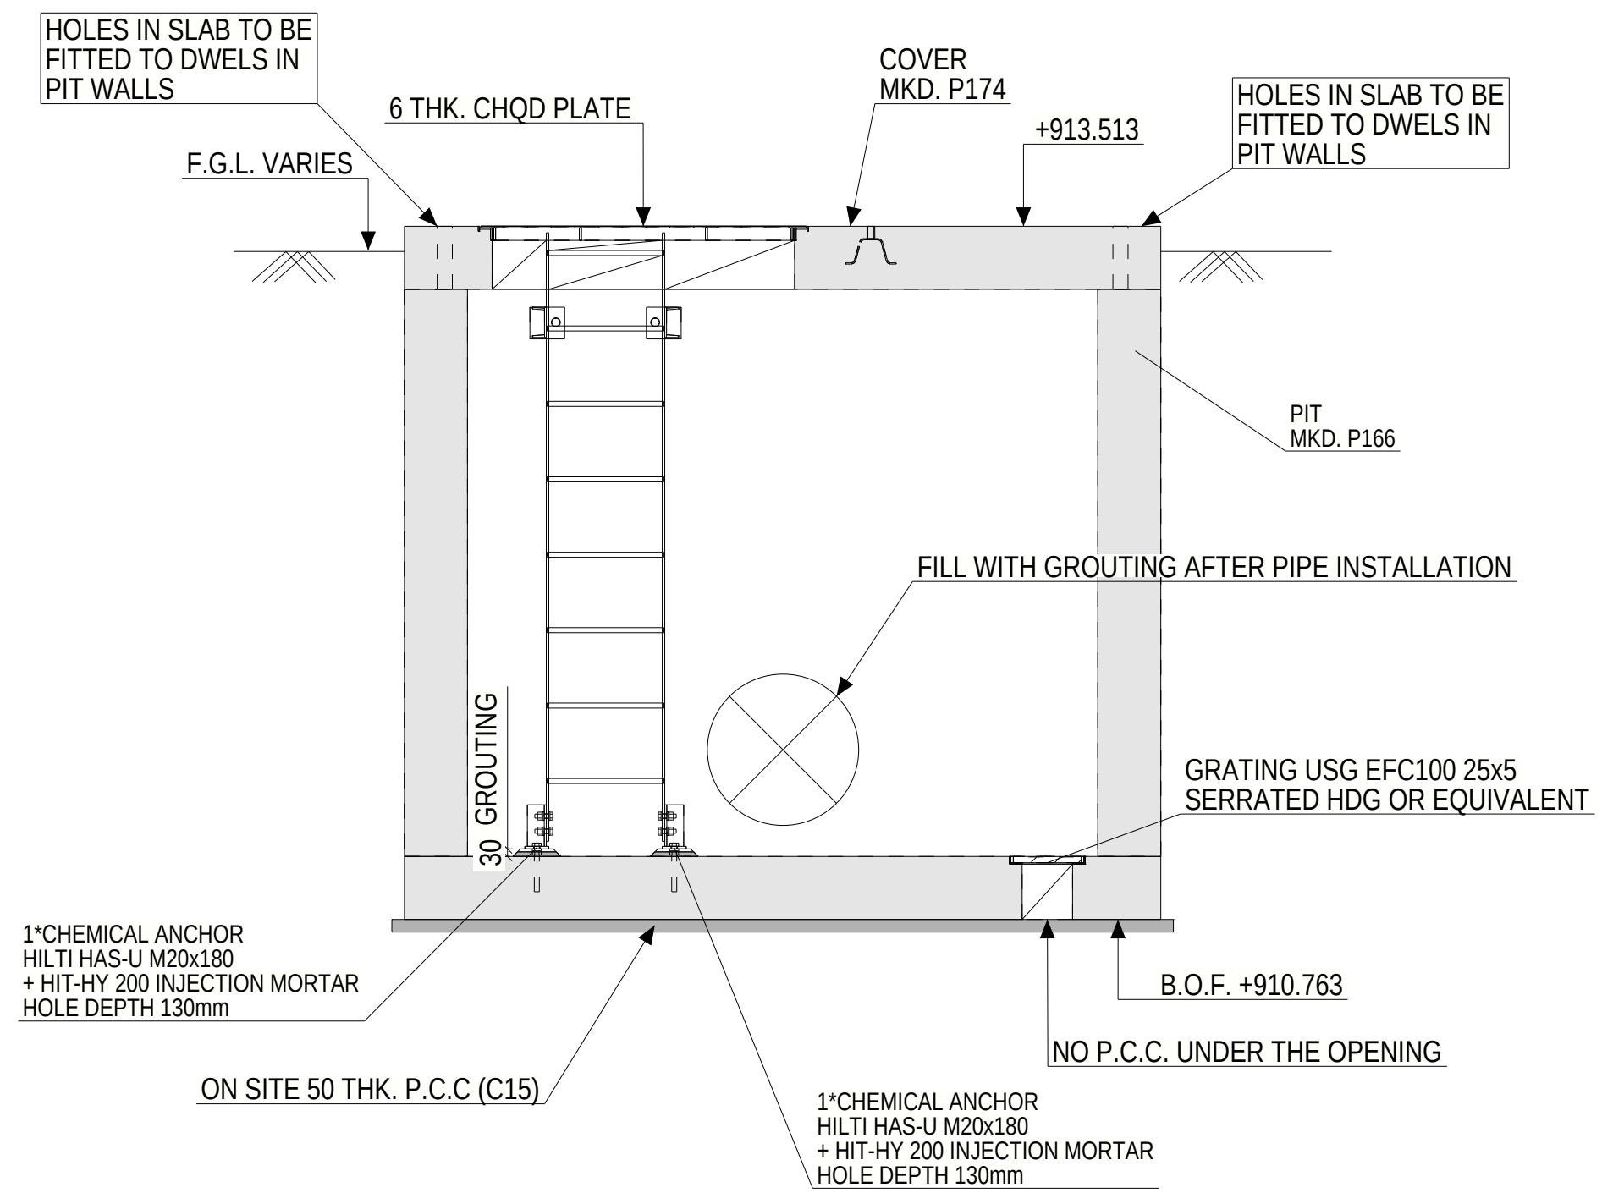
HOLES IN SLAB TO BE
FITTED TO DWELS IN
PIT WALLS
6 THK. CHQD PLATE
COVER
MKD. P174
+913.513
F.G.L. VARIES
PIT
MKD. P166
FILL WITH GROUTING AFTER PIPE INSTALLATION
GRATING USG EFC100 25x5
SERRATED HDG OR EQUIVALENT
30 GROUTING
1*CHEMICAL ANCHOR
HILTI HAS-U M20x180
+ HIT-HY 200 INJECTION MORTAR
HOLE DEPTH 130mm
ON SITE 50 THK. P.C.C (C15)
B.O.F. +910.763
NO P.C.C. UNDER THE OPENING

SECTION : K - K
(SCALE 1:30)

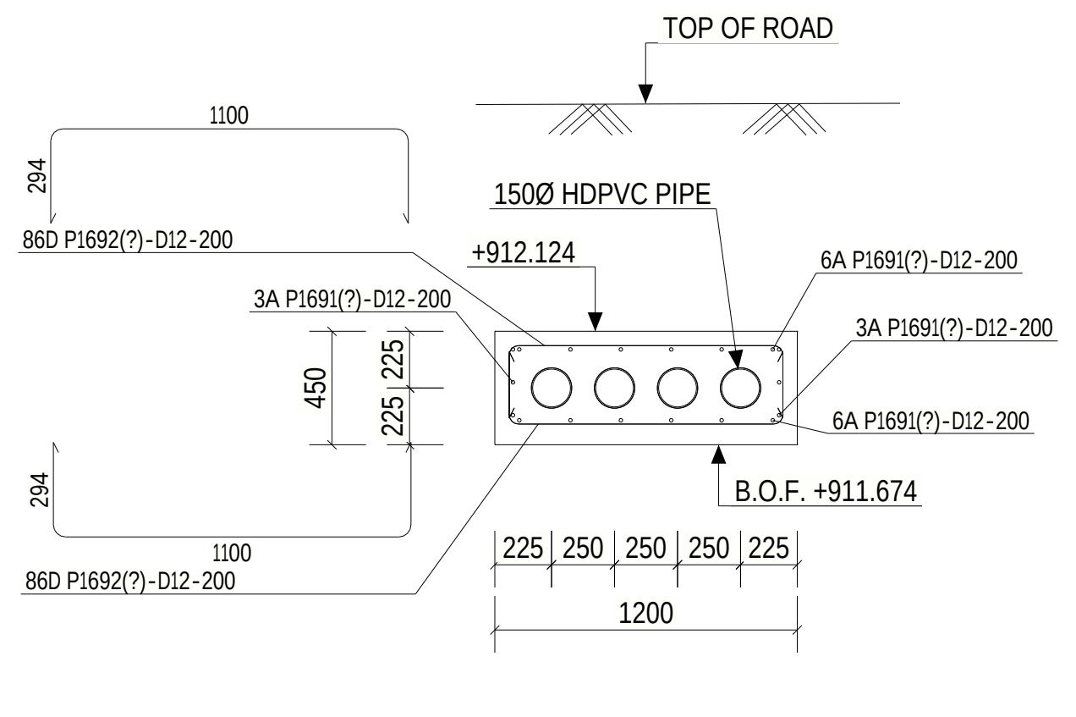
TOP OF ROAD
150Ø HDPVC PIPE
+912.124
B.O.F. +911.674
1100
294
450
225
1200
225 250 250 250 225

SECTION : B - B
(SCALE 1:30)

LEGEND:
R.L. - REDUCED LEVEL
T.O.C. - TOP OF CONCRETE
B.O.F. - BOTTOM OF FOUNDATION
F.G.L. - FINISHED GROUND LEVEL
P.C.C. - PLAIN CEMENT CONCRETE
TYP - TYPICAL
MKD - MARKED
CL - CENTER LINE
BOTTOM REINF. (B)
TOP REINF. (T)
SBC - SAFE BEARING CAPACITY
MIN. - MINIMUM
REF. - REFERED
GA - GENERAL ARRANGEMENT
DWG. - DRAWING
R.C.C. - REINFORCED CEMENT CONCRETE

NOTES:

1. ALL DIMENSIONS ARE IN MILLIMETRES AND LEVELS ARE IN METRES UNLESS OTHERWISE STATED
2. GRADE OF CONCRETE SHALL BE C35 (35MPa) UNLESS NOTED OTHERWISE & C15 (15MPa) FOR BLINDING CONCRETE.
3. GRADE OF REINFORCEMENT SHALL BE DEFORMED BAR ASTM A615-GRADE 60 (fy=420MPa)
4. CLEAR COVER TO MAIN REINFORCEMENT SHALL BE AS FOLLOWS:
a) FOUNDATION: 75 mm (BOTTOM & SIDE)
b) FOUNDATION: 50 mm (TOP)
c) COLUMN & PEDESTAL: 50 mm
5. MINIMUM LAP LENGTHS OF REINFORCEMENT SHALL BE 40XBAR DIAMETER
6. FOR STANDARD REINFORCEMENT DETAILS & GENERAL NOTES FOR CIVIL WORKS REFER TO DRAWING NUMBER MD-216-1000-EG-CV-DED-1005 & 1001
7. ANCHOR BOLTS AND EMBEDDED STEELWORK SHALL BE HOT DIP GALVANIZED
8. T.O.C. & TOP OF SCREED TOLERANCE SHALL BE WITHIN +/- 10MM OF DESIGN LEVEL
9. NET SAFE BEARING CAPACITY OF SOIL AT BOTTOM OF FOUNDATION IS CONSIDERED AS 375 KN/SQ.M.
10. REBARS CAN BE MOVED LOCALLY BY +/- 25mm TO AVOID INTERFERENCE WITH EMBEDDED PARTS
C01 11. EARTHWORKS FOR ROAD CROSSINGS SHALL BE CONSTRUCTED PER 5.15 OF MD-101-SMEM-EG-CV-SPC-0003

KEYPLAN

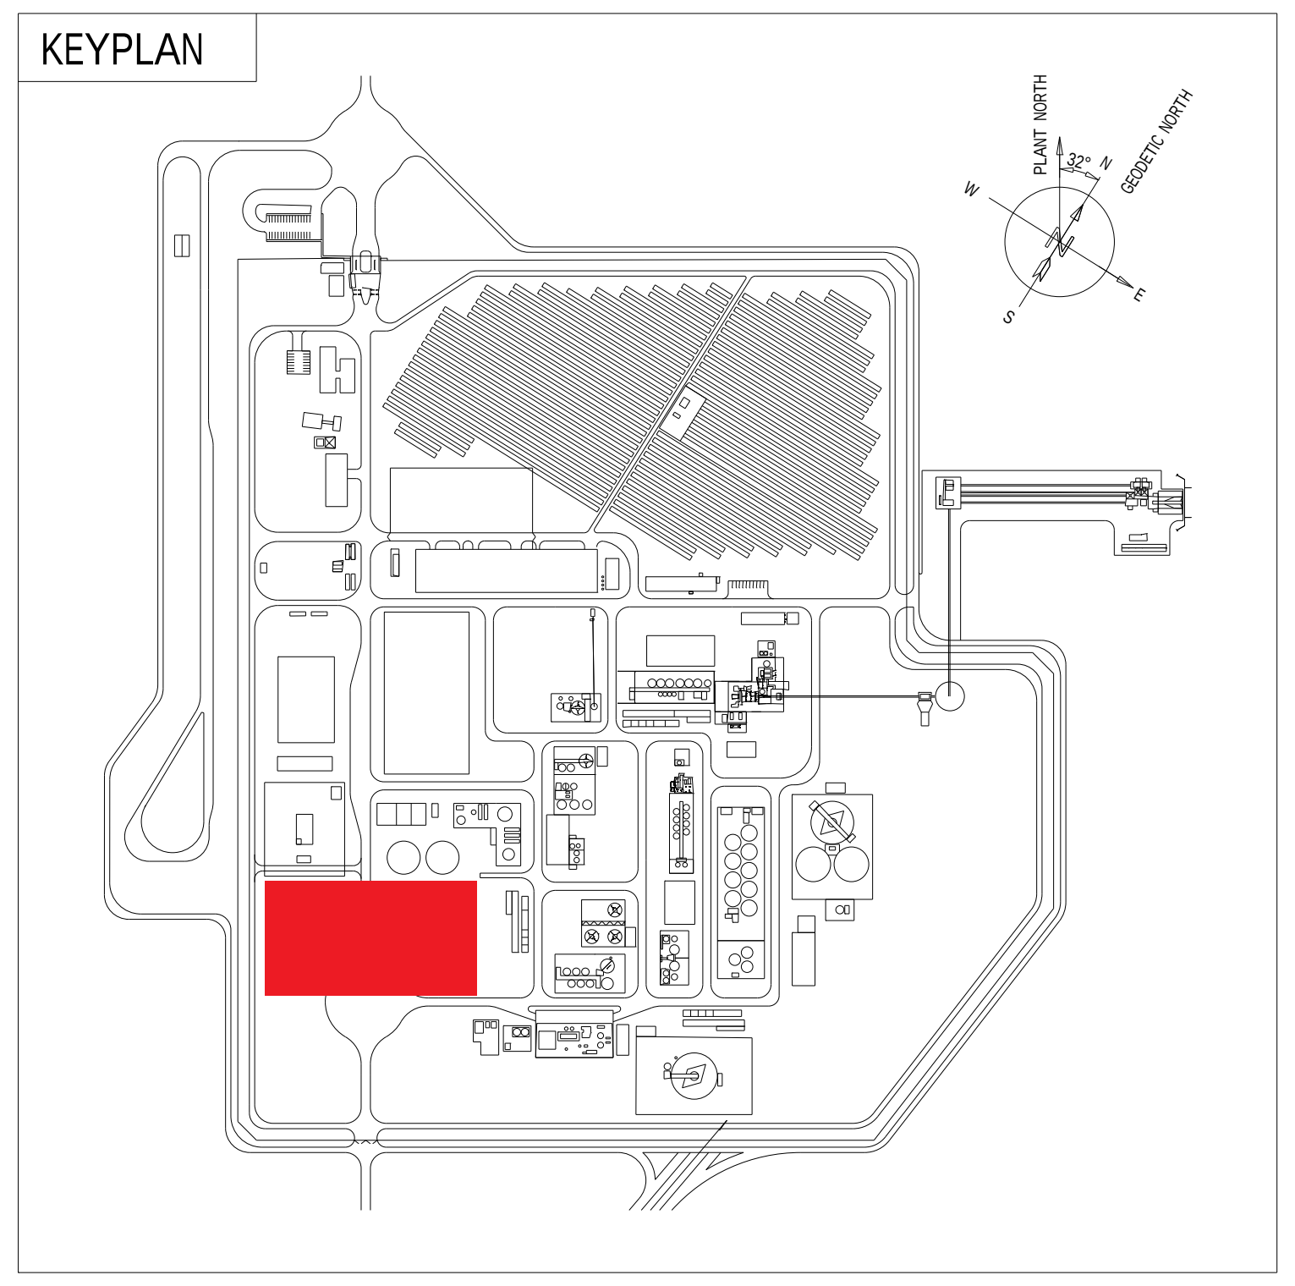
PLANT NORTH
GEODETIC NORTH
32°
N
W

DOCUMENT NUMBER	REFERENCE DOCUMENTS	DOCUMENT NUMBER	REFERENCE DOCUMENTS
MD-216-1000-EG-ST-CRT-1001	DESIGN CRITERIA	MD-216-49W1-EG-CV-CAL-1006	DAF BASIN, COAGULANT BASIN, PIT, SLUDGE BASIN, VESSEL FOUNDATION
MD-216-49W1-EG-CV-DED-1008	PRECAST VALVE PITS	MD-216-49W1-EG-CV-DED-1023	PRECAST ELECTRICAL PITS

REV	DATE	REVISION DESCRIPTION	DRN	CHK	ENG	APP	EMP
D01	29.01.2024	AS-BUILT	NikJan	MauNot	LuiPiz	SouCha	
C01	14.02.2022	ISSUED FOR CONSTRUCTION	NikJan	MauNot	LuiPiz	SouCha	
A01	14.01.2022	ISSUED FOR APPROVAL	EvgPon	MauNot	NanWu	LuiPiz	

RESERVED FOR VENDOR LOGO AND DRAWING NUMBER

LARSEN & TOUBRO

This drawing is the property of LARSEN & TOUBRO and must not be passed on to any person or body not authorized by us to recieve it or be copied or otherwise made use either in full or in part by such person or body without our prior permission in writing.

Outotec

The content of these documents are the sole property of Outotec Oyj. Any rights not expressly granted herein are reserved. Reproduction, transfer or distribution of part or all of the contents in any form without prior written permission of Outotec is prohibited.

MA'ADEN معادن
Saudi Arabian Mining Company شركة التعدين العربية السعودية

This document and the information contained herein is Ma'aden proprietary know-how. This document or any part thereof should not be reproduced, stored in a retrieval system or transmitted by any means, electronic or otherwise, or divulged without prior written permission of Ma'aden.

LARSEN & TOUBRO DRAWING NUMBER	019045_080_C_G_24891_005	REVISION 2
OUTOTEC DRAWING NUMBER	900707_GAU01_AG11_MTL01_49045	DOCUMENT ID 0U100732601 / REVISION 2

DRAWN	EvgPon	14.01.2022
CHECKED	MauNot	14.01.2022
ENGINEER	NanWu	14.01.2022
APPROVED	LuiPiz	14.01.2022
EMPLOYER		
SCALE	1:250	A0

MANSOURAH - MASSARAH GOLD PROJECT
RAW WATER TREATMENT PLANT
PULL PIT LAYOUT FROM SS2 TO RWTP SUBSTATION
GENERAL ARRANGEMENT DRAWING

DRAWING NUMBER
MD-216-49W1-EG-CV-GAD-1005
REV
D01

Tekla Structures