


DRAWING NUMBER: MD-216-3520-EG-CV-DED-1283 | REV: D01

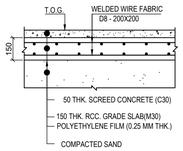


TYP. DET. OF 150 THK. GRADE SLAB
(SCALE 1:15)

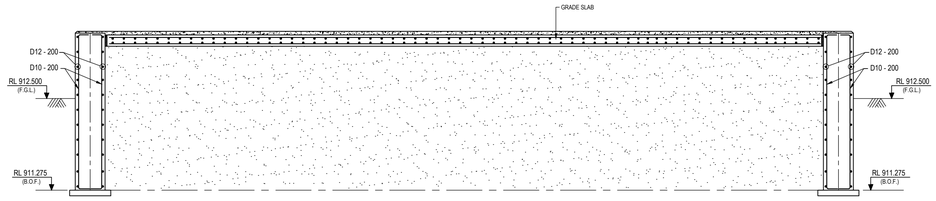


SECTION : C-C
(SCALE 1:30)

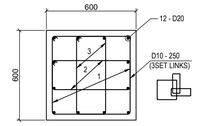


SECTION : E-E
(SCALE 1:15)

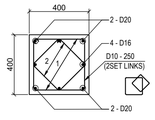


SECTION : G-G
(SCALE 1:15)

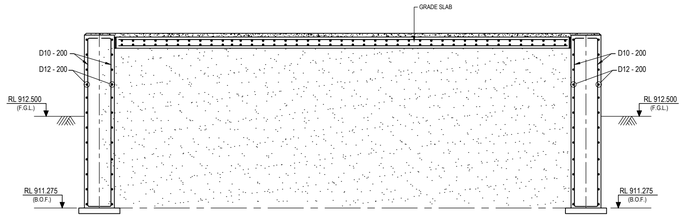


SECTION : A-A
(SCALE 1:30)

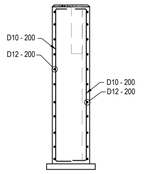


SECTION : B-B
(SCALE 1:30)

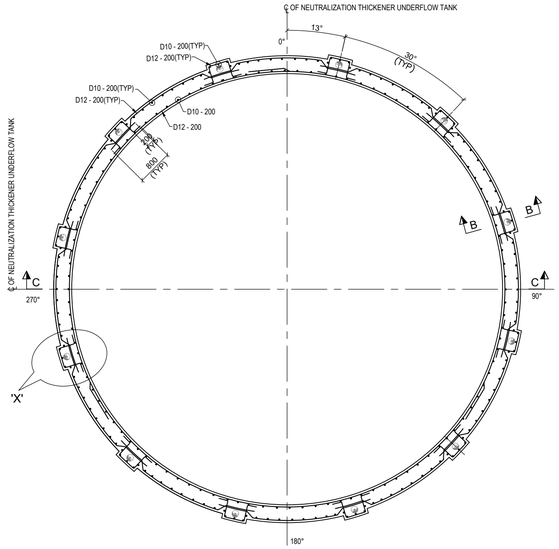


R.C.C DETAIL AT TOP OF FOUNDATION
(FOR NEUTRALIZATION THICKENER UNDERFLOW TANK : REA - 007)
(SCALE 1:50)

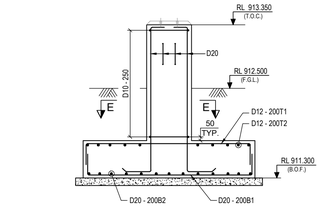


SECTION : D-D
(SCALE 1:30)

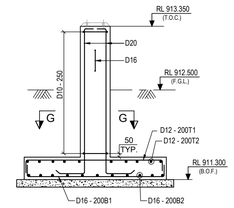


SECTION : F-F
(SCALE 1:30)

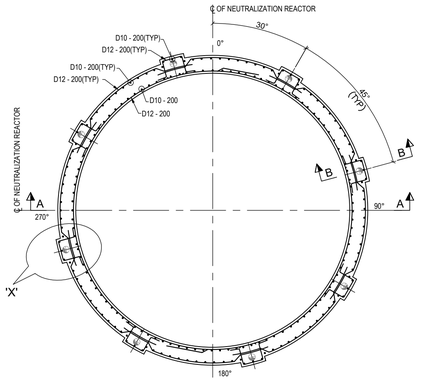


R.C.C DETAIL AT TOP OF FOUNDATION
(FOR NEUTRALIZATION REACTOR : REA - 001,003 & 005)
(SCALE 1:50)

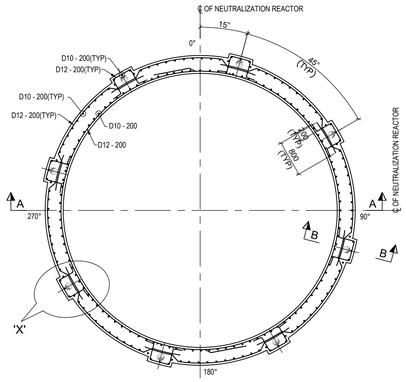


R.C.C DETAIL AT TOP OF FOUNDATION
(FOR NEUTRALIZATION REACTOR : REA - 002,004 & 006)
(SCALE 1:50)

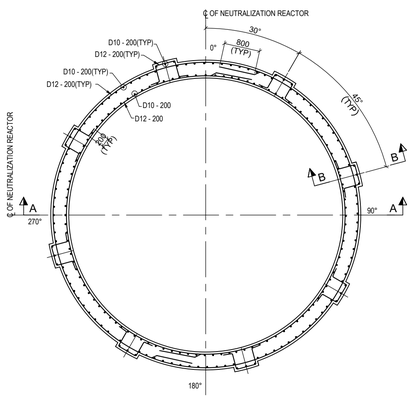


R.C.C DETAIL AT BOTTOM OF FOUNDATION
(FOR NEUTRALIZATION REACTOR : REA - 001,003 & 005)
(SCALE 1:50)

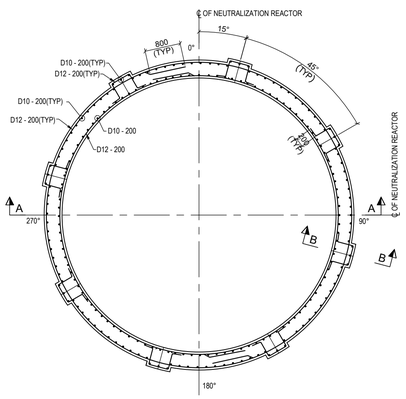


R.C.C DETAIL AT BOTTOM OF FOUNDATION
(FOR NEUTRALIZATION REACTOR : REA - 002,004 & 006)
(SCALE 1:50)

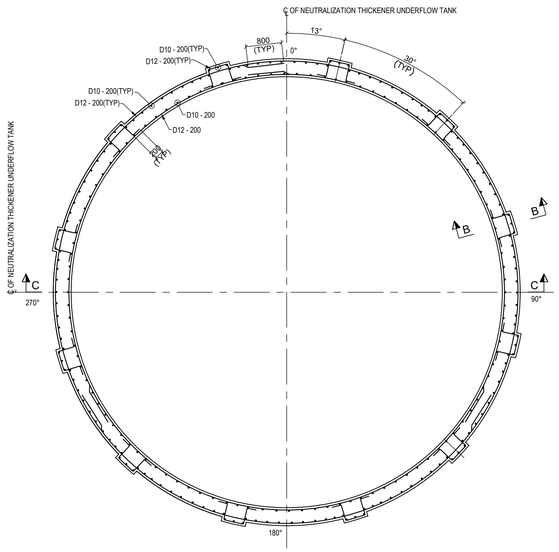


R.C.C. DETAIL AT BOTTOM OF FOUNDATION
(FOR NEUTRALIZATION THICKENER UNDERFLOW : REA - 007)
(SCALE 1:50)

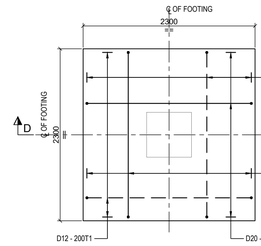

R.C.C DETAIL OF FOUNDATION MKD. F1
(SCALE 1:30)

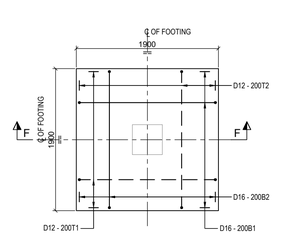

R.C.C DETAIL OF FOUNDATION MKD. F2
(SCALE 1:30)

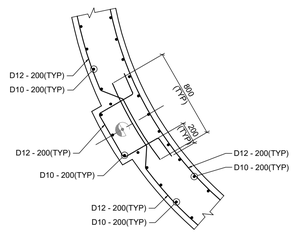

DETAIL : 'X'
SCALE 1:20

LEGEND:-

R.L - REDUCED LEVEL
T.O.C - TOP OF CONCRETE
B.O.F - BOTTOM OF FOUNDATION
F.G.L - FINISHED GROUND LEVEL
P.C.C - PLAIN CEMENT CONCRETE
R.C.C - REINFORCED CEMENT CONCRETE
TYP - TYPICAL
MKD - MARKED
℄ - CENTRE LINE
BOTTOM REINF.(B) - – – – – –
TOP REINF.(T) - ————
T.O.G - TOP OF GROUT
THK. - THICK
EQV. - EQUIVALENT
GA - GENERAL ARRANGEMENT
REF. - REFER
DRG. - DRAWING

NOTES:-

1. ALL DIMENSIONS ARE IN MILLIMETRES AND LEVELS ARE IN METRES UNLESS OTHERWISE STATED.
2. GRADE OF CONCRETE SHALL BE M35
3. GRADE OF REINFORCEMENT SHALL BE DEFORMED BAR ASTM A615-GRADE 60 (fy=420 MPa)
4. CLEAR COVER TO MAIN REINFORCEMENT SHALL BE AS FOLLOWS:
   a) FOUNDATION : 75 mm. (BOTTOM & SIDE)
   b) FOUNDATION : 50 mm. (TOP)
   c) COLUMN : 50 mm.
   d) RING WALL : 50 mm.
5. MINIMUM LAP LENGTHS OF REINFORCEMENT SHALL BE 40 x BAR DIAMETER.
6. FOR GA DRAWING REF. DRG. NO. MD - 216 - 3520 - EG - CV - GAD - 1282.
   MD - 216 - 3520 - EG - CV - GAD - 1283.

DOCUMENT NUMBER	REFERENCE DOCUMENTS	REV	DATE	REVISION DESCRIPTION	DRN	CHK	ENG	APP	EMP
D01		D01	22/02/2023	AS-BUILT	SBH	BDA	STY	AG	
C03		C03	08/09/2020	ISSUED FOR CONSTRUCTION & REVISED AS MKD.	SBH	BDA	STY	AG	
C02		C02	16/05/2020	ISSUED FOR CONSTRUCTION & REVISED AS MKD.	SBH	BDA	STY	AG	
C01		C01	28/04/2020	ISSUED FOR CONSTRUCTION	SBH	BDA	STY	AG	
A02		A02	04/03/2020	REVISED AS PER EMPLOYER COMMENTS ON 05/02/2020	SBH	BDA	STY	AG	
A01		A01	10/01/2020	ISSUED FOR REFERENCE	SBH	BDA	STY	AG	

RESERVED FOR VENDOR LOGO AND DRAWING NUMBER

LARSEN & TOUBRO

This drawing is the property of LARSEN & TOUBRO and must not be passed on to any person or body not authorized by us to receive it nor be copied or otherwise made use either in full or in part by such person or body without our prior permission in writing.

Outotec

The content of these documents are the sole property of Outotec Oyj. Any rights not expressly granted herein are reserved. Reproduction, transfer or distribution of part or all of the contents in any form without prior written permission of Outotec is prohibited.

MA'ADEN معادن
Saudi Arabian Mining Company شركة معادن السعودية للتعدين

This document and the information contained herein is Ma'aden proprietary know-how. This document or any part thereof should not be reproduced, stored in a retrieval system or transmitted by any means, electronic or otherwise, or divulged without prior written permission of Ma'aden.

LARSEN & TOUBRO DRAWING NUMBER			REVISION
019045_450_C_D_24120_001			5
OUTOTEC DRAWING NUMBER		DOCUMENT ID	REVISION
900707 __ GAU01 __ RN13 __ CTB17 __ 35207		OU100665548	5
DRAWN	SBH	08/01/2020	MANSOURAH - MASSARAH GOLD PROJECT
CHECKED	BDA	09/01/2020	DETAIL DRAWING
ENGINEER	STY	08/01/2020	NEUTRALIZATION AND THICKENING
APPROVED	AG	10/01/2020	THICKENER & TANK FOUNDATION
EMPLOYER			
SCALE 1:100		A0	DRAWING NUMBER: MD - 216 - 3520 - EG - CV - DED - 1283
			REV: D01