
DRAWING NUMBER MD-216-3000-EG-CV-GAD-1001 REV D01

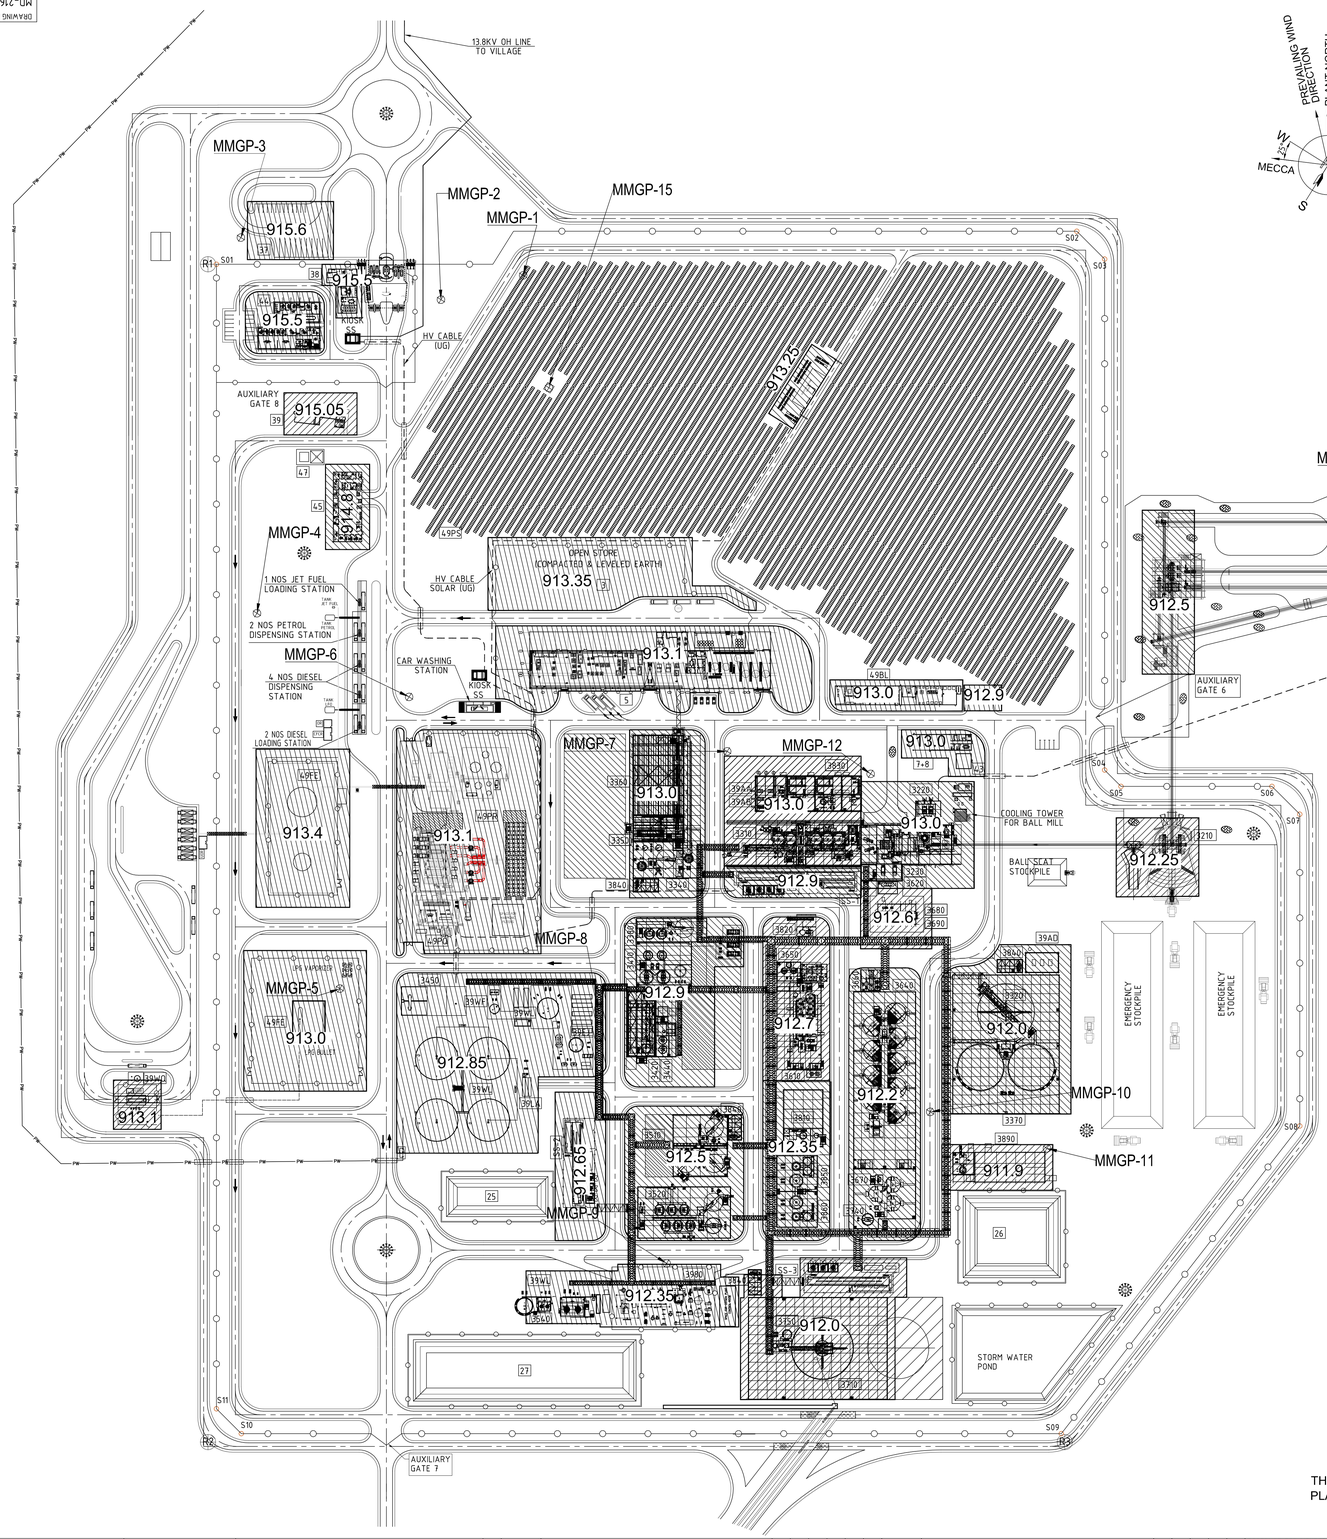

AREA	DESCRIPTION
1	WEIGHBRIDGE
2	NOT USED
3	WAREHOUSE OUTSIDE LAYDOWN
4	NOT USED
5	WORKSHOP
6	NOT USED
7	ENGINEERING OFFICE
8	CONTROL ROOM
9	NOT USED
25	ACIDIC EVENT POND
26	CYANIDE EVENT POND
27	PASTE THICKENER EVENT POND
37	BUS STOP
38	SECURITY GATE 5
39	MOSQUE
43	ABLUTION
44	ADMIN BUILDING
45	EMERGENCY SERVICES BUILDING
46	NOT USED
47	COMMUNICATION TOWER

AREA	DESCRIPTION
3110	PRIMARY CRUSHING
3120	SECONDARY CRUSHING
3130	TERTIARY CRUSHING
3210	CRUSHED ORE STORAGE AND TRANSFER
3220	GRINDING AND CLASSIFICATION - BALL MILL
3230	GRINDING AND CLASSIFICATION - GRAVITY CONCENTRATOR
3310	FLOTATION ROUGHER/SCAVENGER/CLEANER
3320	LOW GRADE THICKENING
3340	CONCENTRATE THICKENING
3350	CONCENTRATE FILTRATION
3360	CONCENTRATE STORAGE AND REPULP
3370	FLOTATION PROCESS WATER STORAGE
3380	ACIDULATION
3410	PRESSURE OXIDATION - AUTOCLAVE FEED STORAGE
3420	PRESSURE OXIDATION - AUTOCLAVE, FLASH VESSEL & SCRUBBER
3440	PRESSURE OXIDATION - HOT ACID CURE
3450	PRESSURE OXIDATION - SERVICES
3510	CCD CIRCUIT
3520	NEUTRALIZATION AND THICKENING
3540	POX - PROCESS WATER STORAGE
3610	POX CONDITIONING/LEACHING/ADSORPTION
3620	INTENSIVE CYANIDE LEACHING
3640	LOW GRADE CONDITIONING/LEACHING/ADSORPTION
3650	POX ACID WASH/ELUTION/CARBON REGENERATION
3660	LOW GRADE ACID WASH / ELUTION / CARBON REGENERATION
3670	PRIMARY CYANIDE DESTRUCTION
3680	ELECTROWINNING
3690	GOLD ROOM, CALCINING & SMELTING
3710	TAILINGS PASTE THICKENER
3720	TAILINGS DISPOSAL/TAILINGS MANAGEMENT FACILITY PIPELINE
3740	SECONDARY CYANIDE DESTRUCTION
3750	CIL PROCESS WATER STORAGE
3810	REAGENTS - CAUSTIC AND CYANIDE
3820	REAGENTS - HYDROCHLORIC ACID/SULPHAMIC ACID
3830	REAGENTS - FLOTATION
3840	REAGENTS - FLOCCULANT
3850	REAGENTS - LIME SLAKING
3860	REAGENTS - LIMESTONE
3890	REAGENTS - SMBS & PEROXIDE
39WL	RAW WATER
39LA	FIRE WATER SYSTEM
39WQ	GLAND WATER / MINE WATER
39WF	POTABLE WATER STORAGE AND DISTRIBUTION
39EJ	DEMINERALISATION SYSTEM
39AD	LOW PRESSURE AIR
39AB	PLANT AIR DISTRIBUTION
39AA	INSTRUMENT AIR DISTRIBUTION
39MA	PIPE RACKS
3980	OXYGEN PLANT
4000	OTHER BUILDINGS
1800	HEALTH & SAFETY & SECURITY AND RISK
49RO	INTERNAL ROAD AND DRAINAGE
4400	TAILINGS MANAGEMENT FACILITY CHANNEL/DRAINAGE/POND
49EE	SEWAGE COLLECTION
49PR	POWER GENERATION
49PQ	POWER DISTRIBUTION
49PS	SOLAR POWER PLANT
49FE	FUEL OIL STORAGE
49FE	FUEL OIL STORAGE(LPG)
49RA	MAIN ACCESS ROAD
39W1	BOOSTER PUMP STATION & PROCESS WATER SUPPLY
49WF	POTABLE WATER SUPPLY
49BL	LABORATORY

NOTES:

1. ALL LEVELS ARE ABSOLUTE LEVELS(MEASURED FROM MEAN SEA LEVEL) IN METRES.
2. ALL LEVELS INDICATED IN DRAWING ARE FINISHED GROUND LEVEL(F.G.L.) OF DIFFERENT PLANT UNITS.
3. FOR ALL CO ORDINATES OF FENCE AND PROCESS UNITS REFER DRAWING NO.MD-216-1000-EG-ME-PPD-1002.

THIS DRAWING SHALL BE UPDATED ON BASIS OF FINALISED PLANT LAYOUT.

DOCUMENT NUMBER	REFERENCE DOCUMENTS
MD-216-1000-EG-ME-PPD-1002	PLOT PLAN GENERAL PROCESS PLANT LAYOUT

REV	DATE	REVISION DESCRIPTION	DRN	CHK	ENG	APP	EMP
D01	10/06/2023	AS-BUILT	MNS	SJM	AVG	AG	
C01	07/03/2020	ISSUED FOR CONSTRUCTION AND REVISED AS PER EMPLOYER COMMENT ON 18/12/2019 AND REVISED AS MKD.	MNS	SJM	AVG	AG	
A01	12-11-2019	FIRST ISSUE	MNS	SJM	AVG	AG	

RESERVED FOR VENDOR LOGO AND DRAWING NUMBER

LARSEN & TOUBRO

This drawing is the property of LARSEN & TOUBRO and must not be passed on to any person or body not authorised by us to receive it nor be copied or otherwise made use either in full or in part by such person or body without our prior permission in writing.

Outotec

The content of these documents are the sole property of Outotec Oy. Any rights not expressly granted herein are reserved. Reproduction, transfer or distribution of part or all of the contents in any form without prior written permission of Outotec is prohibited

MA'ADEN معادن Saudi Arabian Mining Company شركة معادن للتعدين العربية السعودية

This document and the information contained herein is Ma'aden proprietary know-how. This document or any part thereof should not be reproduced, stored in a retrieval system or transmitted by any means, electronic or otherwise, or divulged without prior written permission of Ma'aden.

LARSEN & TOUBRO DRAWING NUMBER: 019045_900_C_G_24001_001 — REVISION: 2

OUTOTEC DRAWING NUMBER: 900707_GAU01_ZZ01_MTL01_30001 — DOCUMENT ID: OU1000665313 — REVISION: 2

DRAWN	MNS	07-11-2019
CHECKED	SJM	08-11-2019
ENGINEER	AVG	11-11-2019
APPROVED	AG	12-11-2019
EMPLOYER		
SCALE	1:1500	A0

MANSOURAH - MASSARAH GOLD PROJECT
GENERAL ARRANGEMENT DRAWING
PROCESS PLANT EARTHWORKS
FINISHED GROUND LEVELS ETC.

DRAWING NUMBER: MD-216-3000-EG-CV-GAD-1001 — REV: D01