




PART PLAN
M.S GRATING
SCALE 1:10

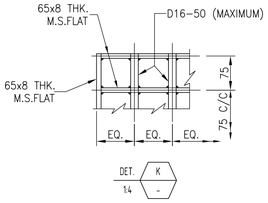


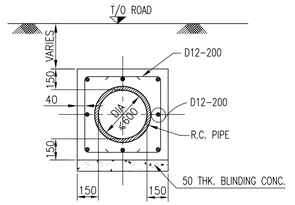



TYPICAL CROSS SECTION
OF R.C. PIPE UNDER ROAD
SCALE 1:20

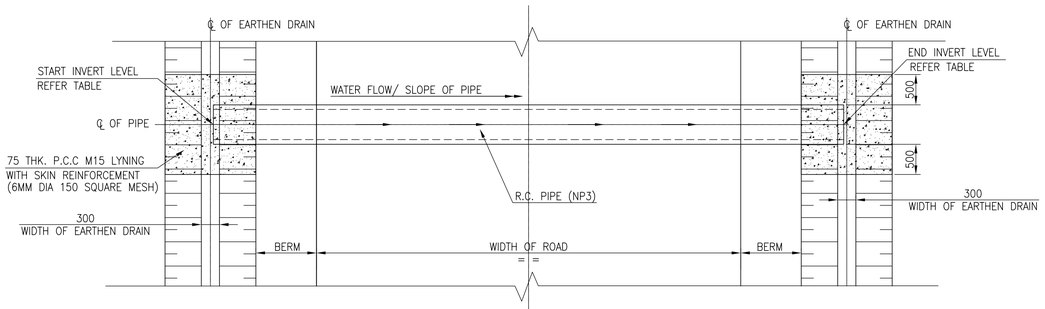


TYPICAL G.A. DETAIL OF PIPE UNDER ROAD FOR
STORM WATER DRAIN
SCALE= 1:50

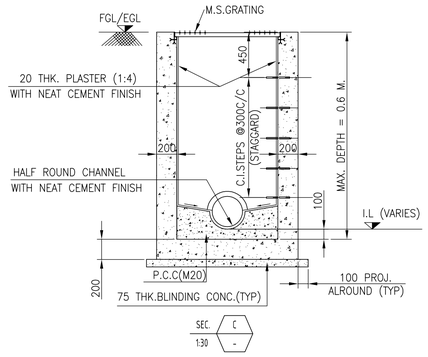

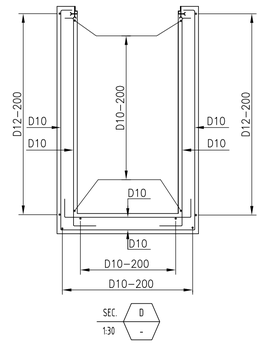


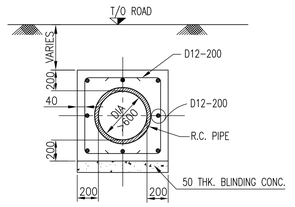


TYPICAL CROSS SECTION
OF R.C. PIPE UNDER ROAD
SCALE 1:20

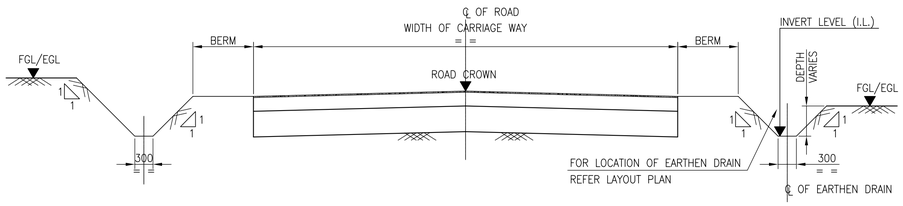

TYPICAL CROSS SECTION OF ROAD WITH EARTHEN DRAIN
SCALE= 1:50

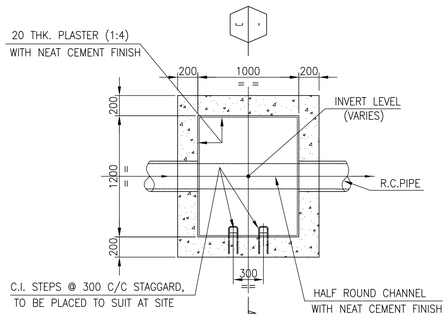


G.A. PLAN

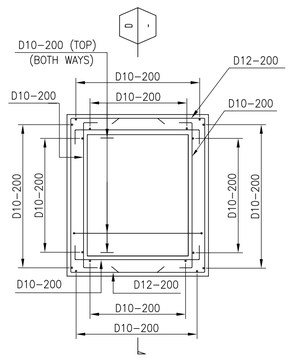

R.C. PLAN

G.A. & R.C. DETAIL OF INSPECTION PIT (TYP.)
FOR NATURAL OUTFALL
SCALE= 1:50

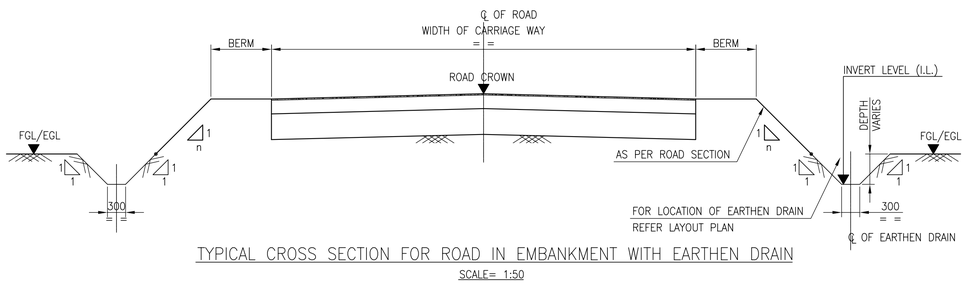

TYPICAL CROSS SECTION FOR ROAD IN EMBANKMENT WITH EARTHEN DRAIN
SCALE= 1:50

LEGEND:

TYP.	TYPICAL
DET.	DETAILS
LAY.	LAYOUT
U.N.O	UNLESS NOTED OTHERWISE
R.C.	REINFORCED CONCRETE
NET.	NETWORK
MKD.	MARKED
P.C.C	PLAIN CEMENT CONCRETE
℄	CENTRE LINE
DIA	DIAMETER
C/C	CENTRE TO CENTRE
FGL	FINISHED GROUND LEVEL
EGL	EXISTING GROUND LEVEL
M.S.	MILD STEEL
C.I.	CAST IRON
G.A.	GENERAL ARRANGEMENT
THK.	THICK
I.L.	INVERT LEVEL

NOTES:
1. ALL DIMENSIONS ARE IN MILLIMETRES
2. CO-ORDINATES AND LEVELS ARE IN METRES
3. CO-ORDINATES ARE ON WORLD GRID (FLAT PLANT/WORLD)
4. WORLD MAPPING GRID BASED ON UTM (WGS 84) Q38N
5. GRADE OF REINFORCED CEMENT CONCRETE SHALL BE M35.
6. REINFORCEMENT BARS SHALL CONFORM TO ASTM A615 GRADE 60 (fy=420 N/sq.mm.)
7. CLEAR COVER TO MAIN REINFORCEMENT SHALL BE 25mm(MINIMUM) U.N.O.
8. DRAIN SECTIONS TO BE LINED WITH 50-75 THICK P.C.C IN CASE OF UNSTABLE OR SOFT SOIL. FOR STIFF SOIL AND ROCK NO LINER IS REQUIRED.

FOR ADDITIONAL ROAD CROSSING DRAINAGE PIPE AT MOBILE CRANE AND VEHICLE OPERATIONAL AREA, REFER DRAWING NO. MD-216-49EA-EG-CV-GAD-1002 (SH 3).

THIS DRAWING SHOULD BE READ IN CONJUNCTION WITH DRAWING NO. MD-216-49EA-EG-CV-DED-1001 MD-216-49EA-EG-CV-GAD-1001 & MD-216-49EA-EG-CV-GAD-1002

DOCUMENT NUMBER	REFERENCE DOCUMENTS	REV	DATE	REVISION DESCRIPTION	DRN	CHK	ENG	APP	EMP
		D01	08/09/2023	AS-BUILT	APEX	BJB	APEX	SJM	
		C02	02/06/2021	ISSUED FOR CONSTRUCTION & REVISED AS MARKED (02)	APEX	BJB	APEX	SJM	
		C01	25/01/2021	ISSUED FOR CONSTRUCTION & REVISED AS PER EMPLOYER COMMENT ON 08/01/2021 AND AS MARKED (01)	APEX	BJB	APEX	SJM	
		A04	11/12/2020	REVISED AS PER EMPLOYER'S COMMENT ON 10/11/2020 & ISSUED FOR REVIEW	APEX	SNM	APEX	SJM	
		A03	14/10/2020	REVISED AS PER EMPLOYER'S COMMENTS ON 16/08/2020	SB	SNM	APEX	SJM	
		A02	29/07/2020	GENERALLY REVISED AS PER EMPLOYER'S COMMENTS	SB	SNM	APEX	SJM	
MD-216-49EA-EG-CV-GAD-1002	LAY. & DET. OF STORM WATER DRAINAGE NET. SH 1 & SH 2			ON 30/04/2020 & AS MARKED (03)					
MD-216-49EA-EG-CV-GAD-1001	LAY. AND DETAILS OF STORM WATER DRAINAGE NET.	A01	31/03/2020	ISSUED FOR REFERENCE	SB	SNM	APEX	SJM	

RESERVER FOR VENDOR LOGO AND DRAWING NUMBER

LARSEN & TOUBRO

This drawing is the property of LARSEN & TOUBRO and must not be passed on to any person or body not authorized by us to receive it nor be copied or otherwise made use either in full or in part by such person or body without our prior permission in writing.

Outotec

The content of these documents are the sole property of Outotec Oyj. Any rights not expressly granted herein are reserved. Reproduction, transfer or distribution of part or all of the contents in any form without prior written permission of Outotec is prohibited.

MA'ADEN معادن
Saudi Arabian Mining Company شركة التعدين العربية السعودية

This document and the information contained herein is Ma'aden proprietary know-how. This document or any part thereof should not be reproduced, stored in a retrieval system or transmitted by any means, electronic or otherwise, or divulged without prior written permission of Ma'aden.

LARSEN & TOUBRO DRAWING NUMBER	019045_910_C_V_24019_002	REVISION 6
OUTOTEC DRAWING NUMBER	900707__GAU01__AG90__CTB17__00002	DOCUMENT ID OU100673473 / REVISION 6

DRAWN	SB	27/03/2020
CHECKED	SNM	29/03/2020
ENGINEER	APEX	25/03/2020
APPROVED	SJM	31/03/2020
EMPLOYER		
SCALE	1:50	A1

MANSOURAH - MASSARAH GOLD PROJECT
DETAIL DRAWING
PROCESS PLANT STORM WATER DRAINAGE NET.
SCHEDULE OF STORM WATER MANHOLE

DRAWING NUMBER MD-216-49EA-EG-CV-DED-1002 REV D01