
REVISION: D01

DRAWING NUMBER: MD - 216 - 49EA - EG - CV - GAD - 1001

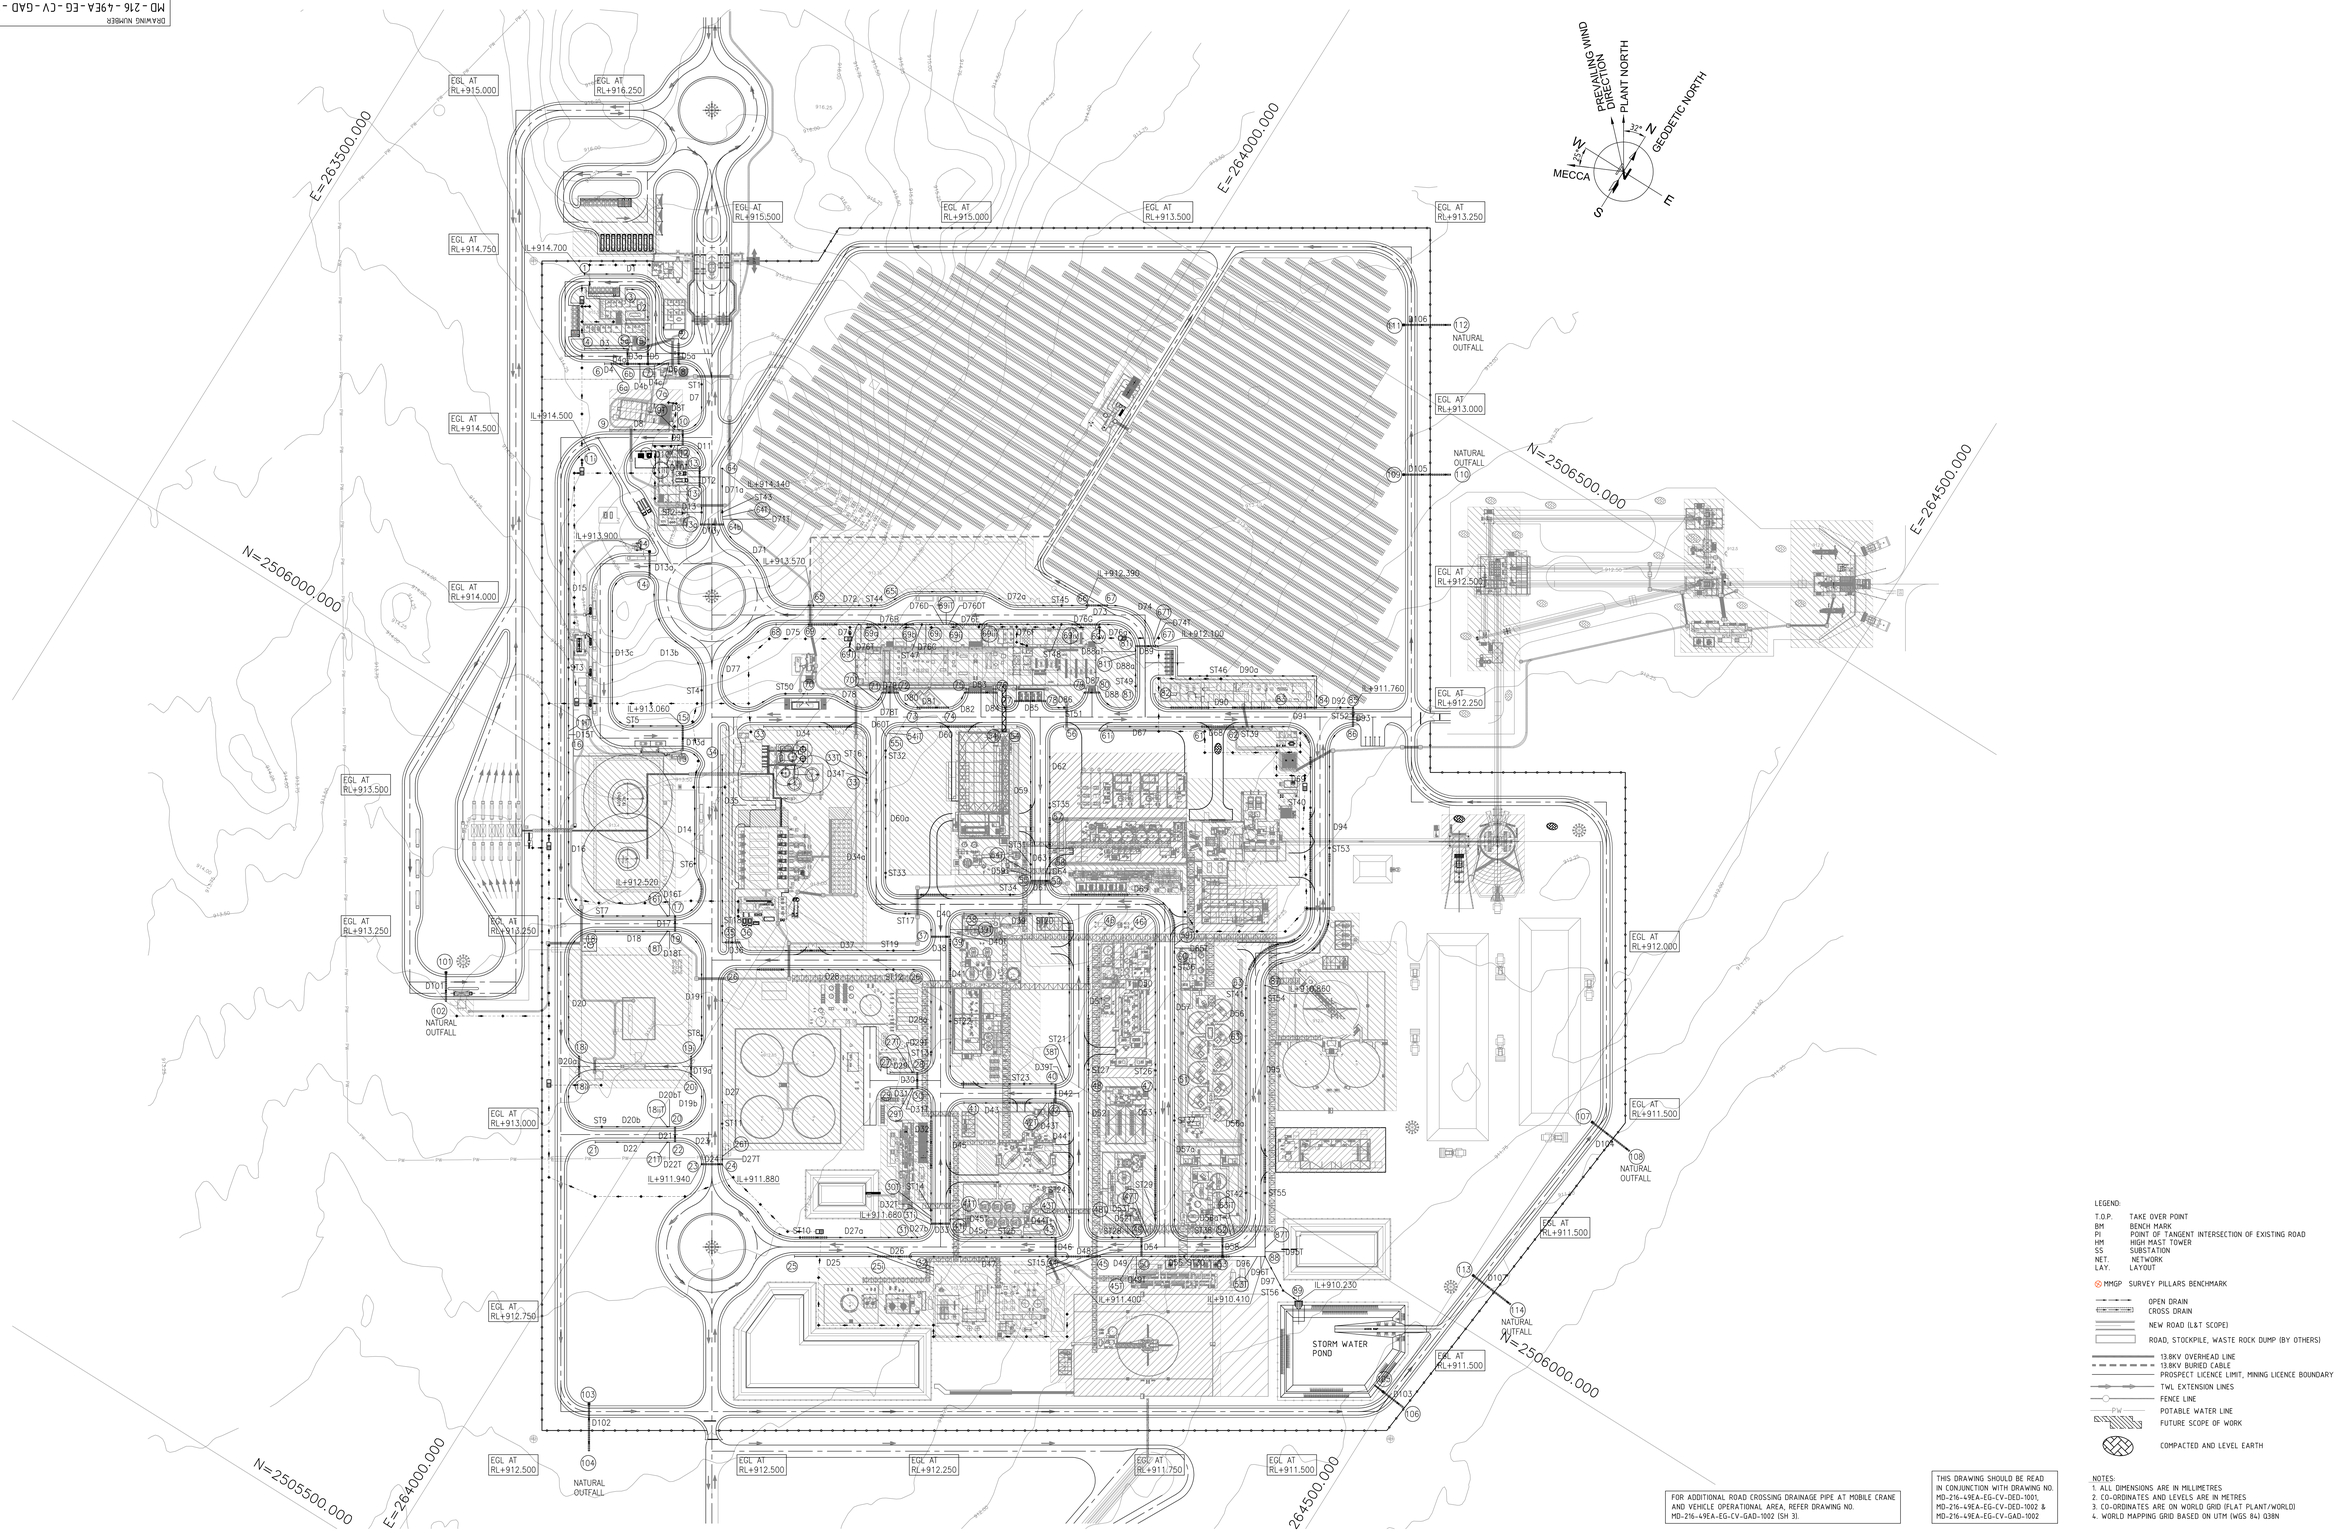

LEGEND:

T.O.P.	TAKE OVER POINT
BM	BENCH MARK
PI	POINT OF TANGENT INTERSECTION OF EXISTING ROAD
HM	HIGH MAST TOWER
SS	SUBSTATION
NET.	NETWORK
LAY.	LAYOUT
MMGP	SURVEY PILLARS BENCHMARK
	OPEN DRAIN
	CROSS DRAIN
	NEW ROAD (L&T SCOPE)
	ROAD, STOCKPILE, WASTE ROCK DUMP (BY OTHERS)
	13.8KV OVERHEAD LINE
	13.8KV BURIED CABLE
	PROSPECT LICENCE LIMIT, MINING LICENCE BOUNDARY
	TWL EXTENSION LINES
	FENCE LINE
PW	POTABLE WATER LINE
	FUTURE SCOPE OF WORK
	COMPACTED AND LEVEL EARTH

NOTES:
1. ALL DIMENSIONS ARE IN MILLIMETRES
2. CO-ORDINATES AND LEVELS ARE IN METRES
3. CO-ORDINATES ARE ON WORLD GRID (FLAT PLANT/WORLD)
4. WORLD MAPPING GRID BASED ON UTM (WGS 84) 038N

FOR ADDITIONAL ROAD CROSSING DRAINAGE PIPE AT MOBILE CRANE AND VEHICLE OPERATIONAL AREA, REFER DRAWING NO. MD-216-49EA-EG-CV-GAD-1002 (SH 3).

THIS DRAWING SHOULD BE READ IN CONJUNCTION WITH DRAWING NO. MD-216-49EA-EG-CV-DED-1001, MD-216-49EA-EG-CV-DED-1002 & MD-216-49EA-EG-CV-GAD-1002

DOCUMENT NUMBER	REFERENCE DOCUMENTS	REV	DATE	REVISION DESCRIPTION	DRN	CHK	ENG	APP	EMP
		D01	08/09/2021	AS-BUILT	APEX	BJB	APEX	SJM	
		C02	02/06/2021	ISSUED FOR CONSTRUCTION & REVISED AS MARKED	APEX	BJB	APEX	SJM	
		C01	25/01/2021	ISSUED FOR CONSTRUCTION	APEX	BJB	APEX	SJM	
		A04	11/12/2020	REVISED AS PER EMPLOYER'S COMMENT ON 10/11/2020 & ISSUED FOR REVIEW	APEX	SNM	APEX	SJM	
		A03	14/10/2020	REVISED AS PER EMPLOYER'S COMMENTS ON 16/08/2020	SB	SNM	APEX	SJM	
		A02	29/07/2020	GENERALLY REVISED AS PER EMPLOYER'S COMMENTS ON 30/04/2020	SB	SNM	APEX	SJM	
MD-216-1000-EG-GE-PPD-1002	PROCESS PLANT LAYOUT	A01	31/03/2020	ISSUED FOR REFERENCE	SB	SNM	APEX	SJM	

RESERVER FOR VENDOR LOGO AND DRAWING NUMBER

LARSEN & TOUBRO

This drawing is the property of LARSEN & TOUBRO and must not be passed on to any person or body not authorized by us to receive it nor be copied or otherwise made use either in full or in part by such person or body without our prior permission in writing.

Outotec

The content of these documents are the sole property of Outotec Oyj. Any rights not expressly granted herein are reserved. Reproduction, transfer or distribution of part or all of the contents in any form without prior written permission of Outotec is prohibited.

MA'ADEN معادن
Saudi Arabian Mining Company شركة معادن العربية السعودية

This document and the information contained herein is Ma'aden proprietary know-how. This document or any part thereof should not be reproduced, stored in a retrieval system or transmitted by any means, electronic or otherwise, or divulged without prior written permission of Ma'aden.

LARSEN & TOUBRO DRAWING NUMBER			REVISION
O19045_910_C_V_24018_001			6
OUTOTEC DRAWING NUMBER		DOCUMENT ID	REVISION
900707 __ GAU01 __ AG90__ MTL01 __00001		OU1006734 70	6
DRAWN	SB	27/03/2020	MANSOURAH - MASSARAH GOLD PROJECT
CHECKED	SNM	29/03/2020	GENERAL ARRANGEMENT DRAWING
ENGINEER	APEX	25/03/2020	PROCESS PLANT STORM WATER DRAINAGE NET.
APPROVED	SJM	31/03/2020	LAY. & DETAIL OF STORM WATER DRAINAGE NET.
EMPLOYER			DRAWING NUMBER: MD - 216 - 49EA - EG - CV - GAD - 1001
SCALE 1:1500	A0		REV: D01