

DRAWING NUMBER: MD-216-3100-EG-CV-GAD-2023 | REV: D01

TERTIARY CRUSHER HOUSE

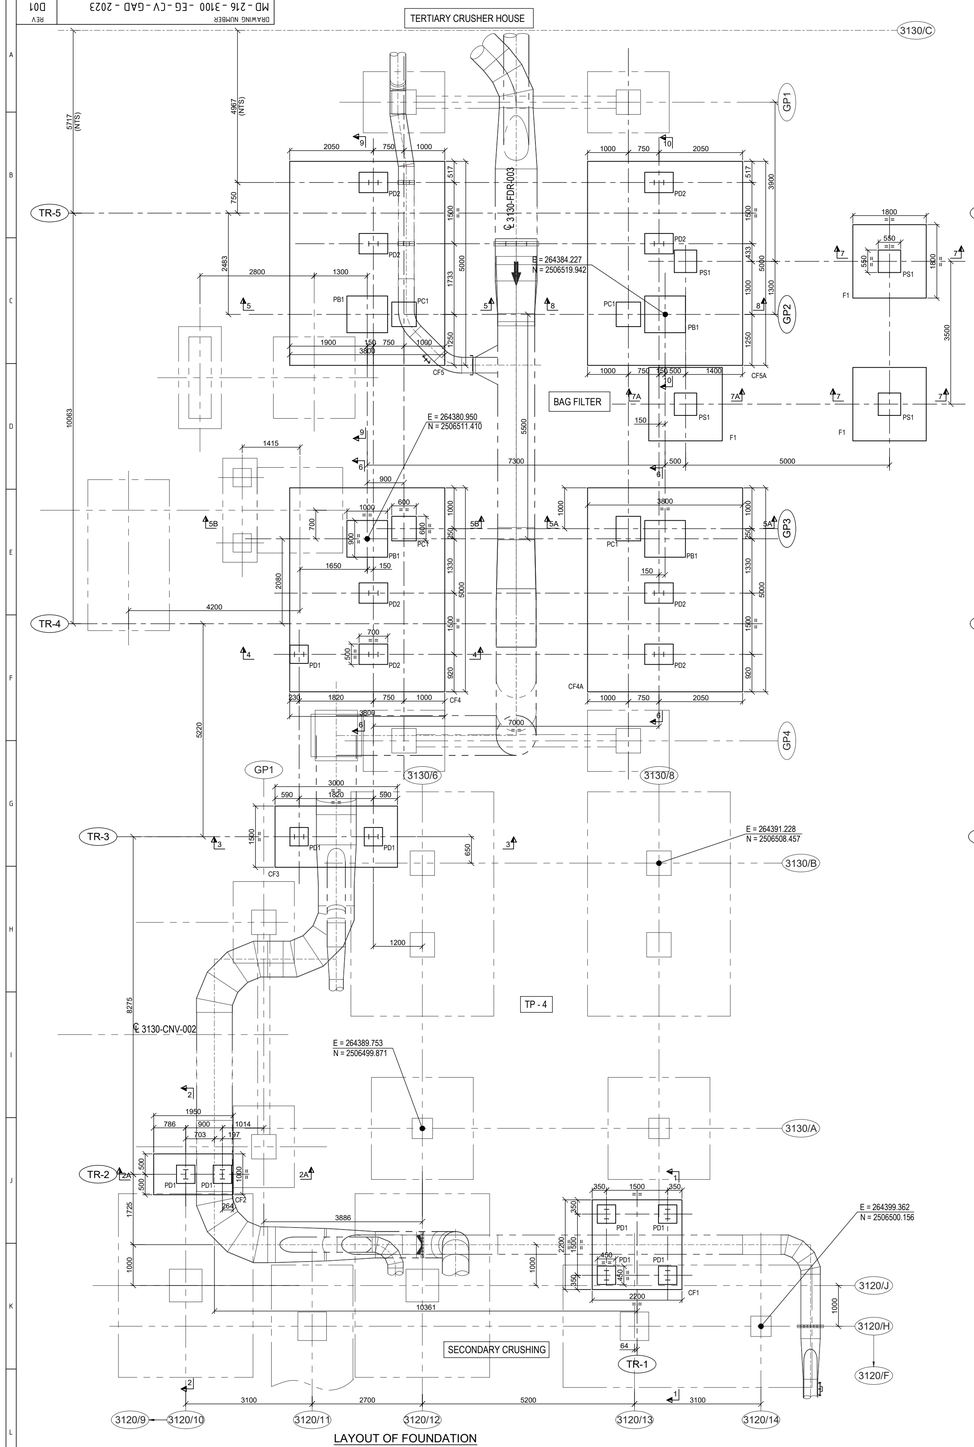


LAYOUT OF FOUNDATION
(SCALE-1:50)

TERTIARY CRUSHER HOUSE

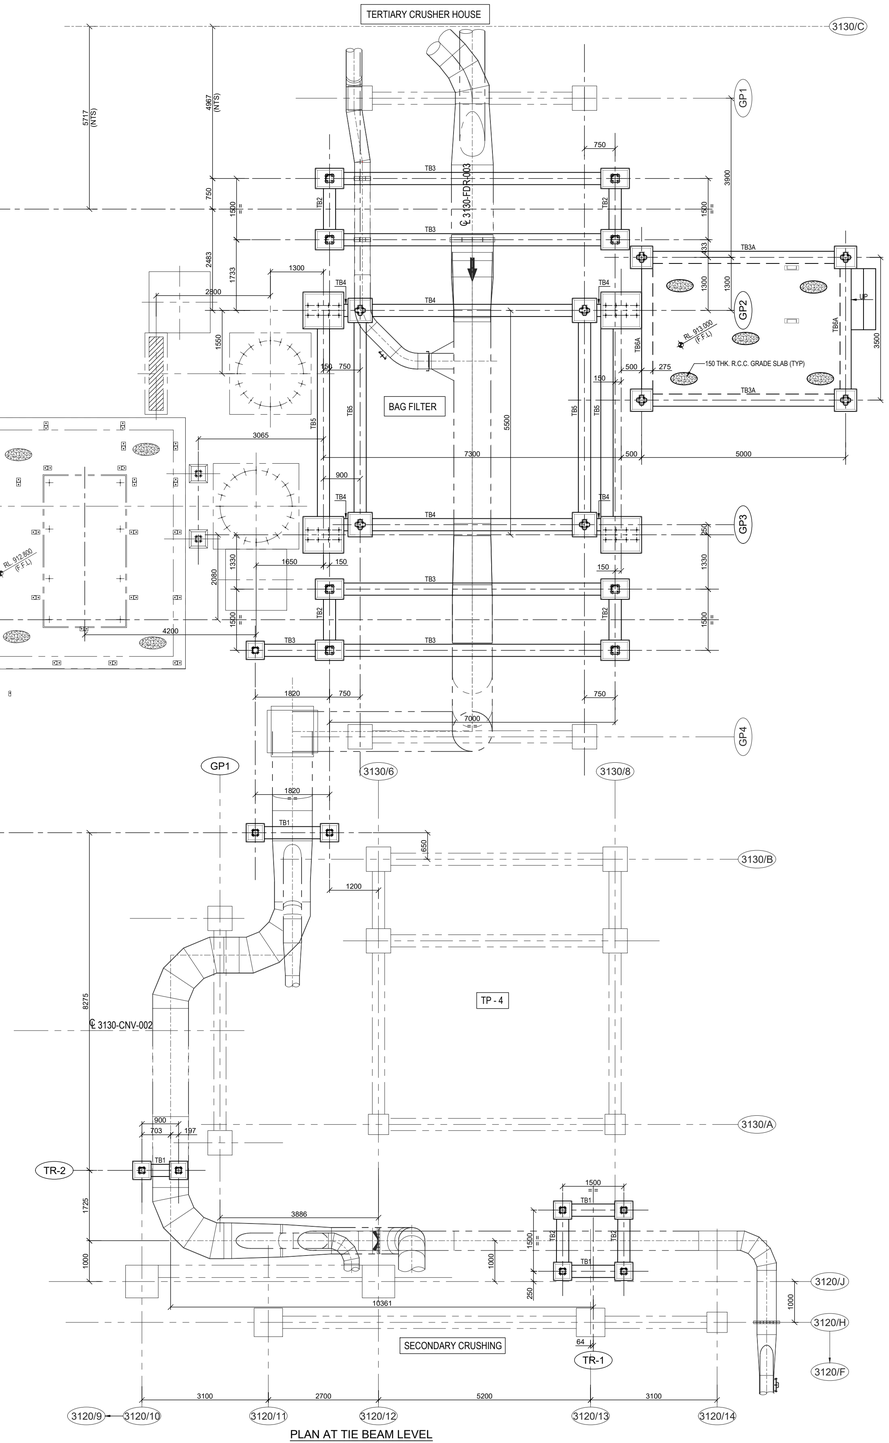

PLAN AT TIE BEAM LEVEL
(SCALE-1:50)

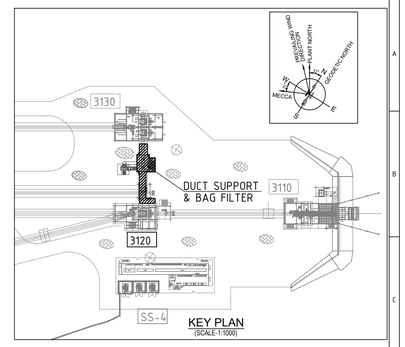

SCHEDULE OF BEAM

BEAM MKD.	SIZE		LEVEL
	WIDTH (mm.)	DEPTH (mm.)	
TB1	300	300	RL. 912.300 (T.O.B.)
TB2	300	400	RL. 912.300 (T.O.B.)
TB3	300	600	RL. 912.300 (T.O.B.)
TB3A	300	600	RL. 912.850 (T.O.B.)
TB4	300	600	RL. 912.300 (T.O.B.)
TB5	300	500	RL. 912.300 (T.O.B.)
TB6	275	500	RL. 912.300 (T.O.B.)
TB6A	275	500	RL. 912.850 (T.O.B.)

LEGENDS :-

R.L - REDUCED LEVEL
℄ - CENTRE LINE
CJ - CONSTRUCTION JOINT
FDN. - FOUNDATION.
T.O.C. - TOP OF CONCRETE.
F.G.L - FINISHED GROUND LEVEL.
F.F.L - FINISHED FLOOR LEVEL.
B.O.F. - BOTTOM OF FOUNDATION
TYP. - TYPICAL
R.C.C - REINFORCED CEMENT CONCRETE
P.C.C - PLAIN CEMENT CONCRETE
MKD. - MARKED.
THK - THICK
NTS - NOT TO SCALE
PC - PEDESTAL FOR CONVEYOR
PD - PEDESTAL FOR DUCT SUPPORT
PB - PEDESTAL FOR BAG FILTER
PS - PEDESTAL FOR STAIR

NOTES :-

1. ALL DIMENSIONS ARE IN MILLIMETRES AND LEVELS AND CO-ORDINATES ARE IN METRES. UNLESS OTHERWISE STATED.
2. GRADE OF CONCRETE SHALL BE C35 FOR FOUNDATION.
3. GRADE OF REINFORCEMENT SHALL BE DEFORMED BAR ASTM A615 - GRADE 60 (fy = 420 MPa).
4. NET SAFE BEARING CAPACITY OF SOIL AT BOTTOM OF FOUNDATION CONSIDERED 300KN/ SQ. M.
5. CLEAR COVER TO MAIN REINFORCEMENT SHALL BE AS
   a) FOUNDATION = 75 mm (BOTTOM & SIDE) 50 mm. (TOP)
   b) COLUMN & PEDESTAL = 50mm
   c) BEAM = 50mm
   d) SLAB = 40mm
6. FOR MINIMUM LAP LENGTH OF REINFORCEMENT AND OTHER GENERAL NOTES FOR CIVIL WORKS REFER STANDARD DRG : MD-216-1000-EG-CV-DED-1001
7. THIS DRG. SHALL BE READ IN CONJUNCTION WITH DRG. NO. MD-216-3100-EG-CV-GAD-2024
8. ALL STRUCTURAL WORK SHALL CONFORM TO CIVIL STRUCTURAL DESIGN CRITERIA NO. MD - 216 - 1000 -EG -ST - CRT - 1001
9. FOR OTHER STANDARD REINFORCEMENT DETAILS REFER DRG : MD-216-1000-EG-CV-DED-1005

DOCUMENT NUMBER	REFERENCE DOCUMENTS
MD-216-3100-EG-ST-GAD-2023	CRUSHING BUILDING BAG FILTER
	PLAN, ELEVATION AND DETAIL OF STAIR
MD-216-3130-EG-CV-GAD-1004	GA OF CONVEYORS 3130-FDR-003 & FDR-004
	LAYOUT & DETAIL
MD-216-3120-EG-CV-GAD-1004	SECONDARY CRUSHING-LAYOUT & DETAIL
MD-216-3130-EG-ST-GAD-2020	TERTIARY CRUSHING-PLAN, ELEVATION AND
	DETAIL OF DEDUSTING DUCT SUPPORT
MD-216-3120-EG-ST-GAD-2021	SECONDARY CRUSHING-PLAN, ELEVATION AND
	DETAIL OF DEDUSTING DUCT SUPPORT
MD-216-3100-EG-ME-DED-V509-2002	FDN LOAD DATA FOR SCREEN HOUSE BAG FILTER

REV	DATE	REVISION DESCRIPTION	DRN	CHK	ENG	APP	EMP
D01	10/03/2023	AS-BUILT	JKM	SBY	APL	PRI	
C01	14/10/2020	ISSUED FOR CONSTRUCTION & REVISED AS MKD. C01	JKM	SBY	APL	PRI	
A01	17/08/2020	ISSUED FOR REFERENCE	JKM	SBY	APL	PRI	

RESERVED FOR VENDOR LOGO AND DRAWING NUMBER

LARSEN & TOUBRO

This drawing is the property of LARSEN & TOUBRO and must not be passed on to any person or body not authorized by us to receive it nor be copied or otherwise made use either in full or in part by such person or body without our prior permission in writing.

Outotec

The content of these documents are the sole property of Outotec Oyj. Any rights not expressly granted herein are reserved. Reproduction, transfer or distribution of part or all of the contents in any form without prior written permission of Outotec is prohibited.

MA'ADEN معادن Saudi Arabian Mining Company

This document and the information contained herein is Ma'aden proprietary know-how. This document or any part thereof should not be reproduced, stored in a retrieval system or transmitted by any means, electronic or otherwise, or divulged without prior written permission of Ma'aden.

LARSEN & TOUBRO DRAWING NUMBER	019045_080_C_G_24368_004		REVISION 2
OUTOTEC DRAWING NUMBER	900707__GAU01__ZC01__MTL01__31052	DOCUMENT ID OU100692090	REVISION 2
DRAWN	JKM	13/08/2020	
CHECKED	SBY	14/08/2020	
ENGINEER	APL	11/08/2020	
APPROVED	PRI	17/08/2020	
EMPLOYER			
SCALE	1:50, 1:1000	A0	

MANSOURAH - MASSARAH GOLD PROJECT
GENERAL ARRANGEMENT DRAWING
CRUSHING
LAYOUT OF BAG FILTER & DUCT SUPPORT FOUNDATION SHT 1

DRAWING NUMBER: MD - 216 - 3100 - EG - CV - GAD - 2023 | REV: D01