


DRAWING NUMBER: MD-216-3100-EG-CV-GAD-2024 | REV: D01

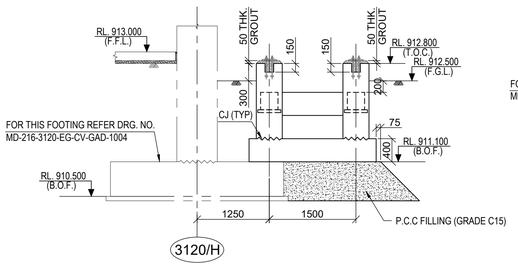


SECTION 1-1
(SCALE-1:50)

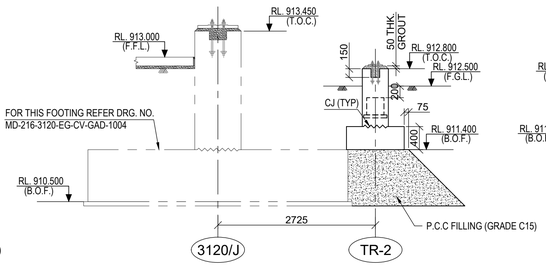


SECTION 2-2
(SCALE-1:50)

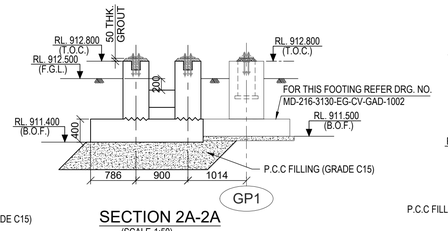

SECTION 2A-2A
(SCALE-1:50)

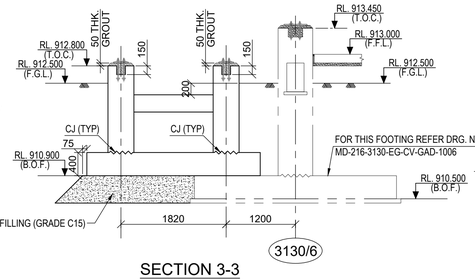


SECTION 3-3
(SCALE-1:50)

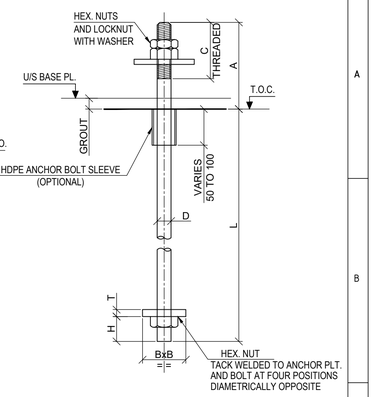


TYP. DETAIL OF BOLT


SCHEDULE OF BOLTS						
D BOLT DIA. MM	BxB BOTTOM PLATE (SQUARE) SQ MM	DIMENSIONS (MM)				
		L	A	C	T	H
20	60x60	450	160	110	10	30
24	75x75	600	175	125	12	30
50	150x150	1250	275	200	25	60

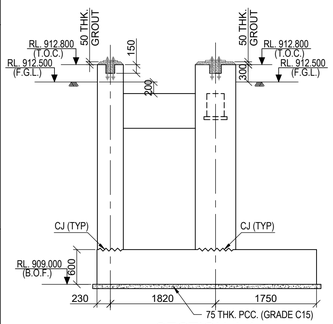


SECTION 4-4
(SCALE-1:50)

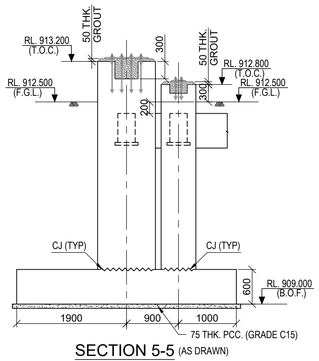


SECTION 5-5 (AS DRAWN)
SECTION 5A-5A (IN OPP. HAND)
(SCALE-1:50)

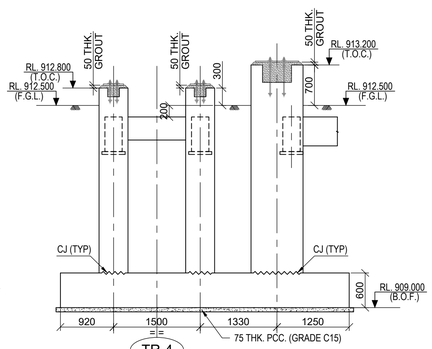


SECTION 6-6
(SCALE-1:50)

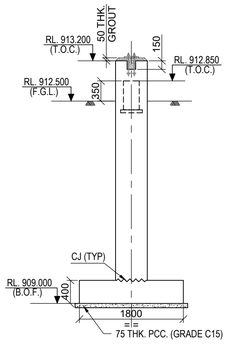


SECTION 7-7
(SCALE-1:50)

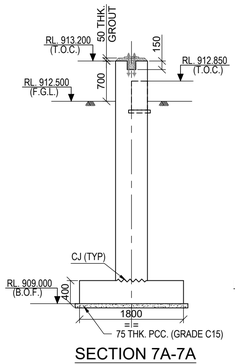


SECTION 7A-7A
(SCALE-1:50)

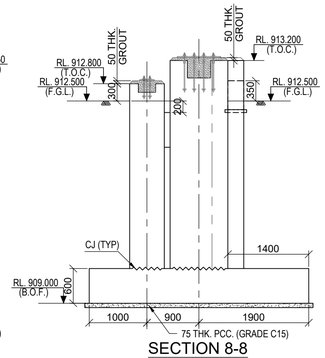


SECTION 8-8
(SCALE-1:50)

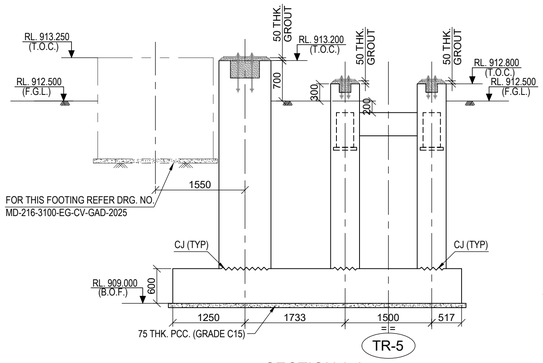


SECTION 9-9
(SCALE-1:50)

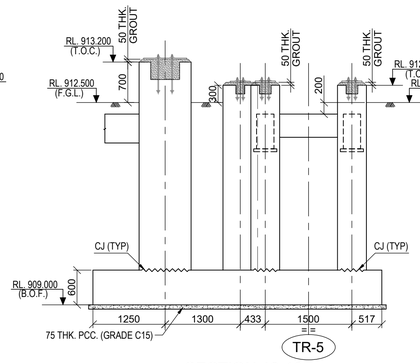

SECTION 10-10
(SCALE-1:50)

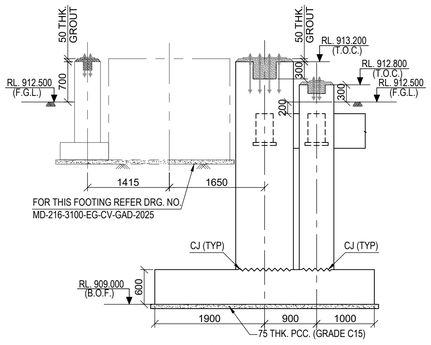

SECTION 5B-5B
(SCALE-1:50)

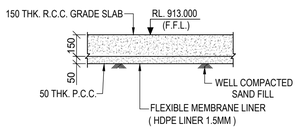


TYP. DETAIL OF 150 THK. GRADE SLAB
SCALE 1:20

LEGENDS :-


R.L. - REDUCED LEVEL
℄. - CENTRE LINE
CJ - CONSTRUCTION JOINT
FDN. - FOUNDATION.
T.O.C. - TOP OF CONCRETE.
F.G.L. - FINISHED GROUND LEVEL.
F.F.L. - FINISHED FLOOR LEVEL.
B.O.F. - BOTTOM OF FOUNDATION
TYP. - TYPICAL.
R.C.C - REINFORCED CEMENT CONCRETE
P.C.C - PLAIN CEMENT CONCRETE
MKD. - MARKED.
THK. - THICK
NTS. - NOT TO SCALE
PC - PEDESTAL FOR CONVEYOR
PD - PEDESTAL FOR DUCT SUPPORT
PB - PEDESTAL FOR BAG FILTER
PS - PEDESTAL FOR STAIR

NOTES :-


1. ALL DIMENSIONS ARE IN MILLIMETRES AND LEVELS AND CO-ORDINATES ARE IN METRES. UNLESS OTHERWISE STATED.
2. GRADE OF CONCRETE SHALL BE C35 FOR FOUNDATION.
3. GRADE OF REINFORCEMENT SHALL BE DEFORMED BAR ASTM A615 - GRADE 60 (fy = 420 MPa).
4. NET SAFE BEARING CAPACITY OF SOIL AT BOTTOM OF FOUNDATION CONSIDERED 500KN/ SQ. M.
5. CLEAR COVER TO MAIN REINFORCEMENT SHALL BE AS
   a) FOUNDATION = 75 mm (BOTTOM & SIDE) 50 mm. (TOP)
   b) COLUMN & PEDESTAL = 50mm
   c) BEAM = 50mm
   d) SLAB = 40mm
6. FOR MINIMUM LAP LENGTH OF REINFORCEMENT AND OTHER GENERAL NOTES FOR CIVIL WORKS REFER STANDARD DRG : MD-216-1000-EG-CV-DED-1001
7. THIS DRG. SHALL BE READ IN CONJUNCTION WITH DRG. NO. MD-216-3100-EG-CV-GAD-2023
8. ALL STRUCTURAL WORK SHALL CONFORM TO CIVIL STRUCTURAL DESIGN CRITERIA NO. MD - 216 - 1000 -EG -ST - CRT - 1001
9. FOR OTHER STANDARD REINFORCEMENT DETAILS REFER DRG : MD-216-1000-EG-CV-DED-1005

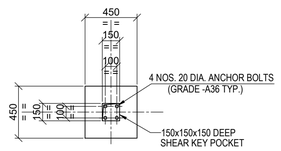


DETAIL OF PEDESTAL MKD. PD1
(SCALE-1:25)

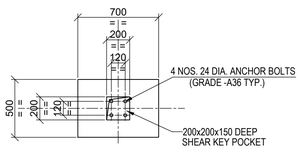


DETAIL OF PEDESTAL MKD. PD2
(SCALE-1:25)

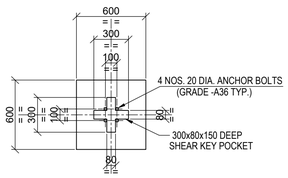

DETAIL OF PEDESTAL MKD. PC1
(SCALE-1:25)

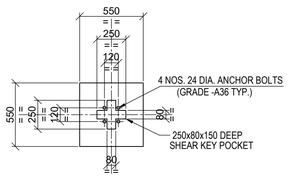

DETAIL OF PEDESTAL MKD. PS1
(SCALE-1:25)

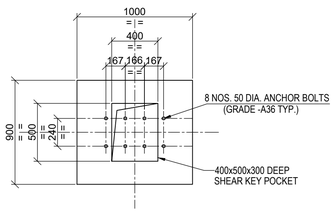

DETAIL OF PEDESTAL MKD. PB1
(SCALE-1:25)

DOCUMENT NUMBER	REFERENCE DOCUMENTS	REV	DATE	REVISION DESCRIPTION	DRN	CHK	ENG	APP	EMP
MD-216-3100-EG-ST-GAD-2023	CRUSHING BUILDING BAG FILTER								
	PLAN, ELEVATION AND DETAIL OF STAIR								
MD-216-3130-EG-CV-GAD-1004	GA OF CONVEYORS 3130-FDR-003 & FDR-004								
	LAYOUT & DETAIL								
MD-216-3120-EG-CV-GAD-1004	SECONDARY CRUSHING-LAYOUT & DETAIL								
MD-216-3130-EG-ST-GAD-2020	TERTIARY CRUSHING-PLAN, ELEVATION AND								
	DETAIL OF DEDUSTING DUCT SUPPORT	D01	10/03/2023	AS-BUILT	JKM	SBY	APL	PRI	
MD-216-3120-EG-ST-GAD-2021	SECONDARY CRUSHING-PLAN, ELEVATION AND	C02	06/01/2021	ISSUED FOR CONSTRUCTION & REVISED AS MKD. C02	JKM	SBY	APL	PRI	
	DETAIL OF DEDUSTING DUCT SUPPORT	C01	14/10/2020	ISSUED FOR CONSTRUCTION & REVISED AS MKD. C01	JKM	SBY	APL	PRI	
MD-216-3100-EG-ME-DED-V509-2002	FDN LOAD DATA FOR SCREEN HOUSE BAG FILTER	A01	17/08/2020	ISSUED FOR REFERENCE	JKM	SBY	APL	PRI	

RESERVED FOR VENDOR LOGO AND DRAWING NUMBER

LARSEN & TOUBRO

This drawing is the property of LARSEN & TOUBRO and must not be passed on to any person or body not authorized by us to receive it nor be copied or otherwise made use either in full or in part by such person or body without our prior permission in writing.

Outotec

The content of these documents are the sole property of Outotec Oyj. Any rights not expressly granted herein are reserved. Reproduction, transfer or distribution of part or all of the contents in any form without prior written permission of Outotec is prohibited.

MA'ADEN معادن
Saudi Arabian Mining Company شركة فتحين العربية السعودية

This document and the information contained herein is Ma'aden proprietary know-how. This document or any part thereof should not be reproduced, stored in a retrieval system or transmitted by any means, electronic or otherwise, or divulged without prior written permission of Ma'aden.

LARSEN & TOUBRO DRAWING NUMBER			REVISION
019045_080_C_G_24368_005			3
OUTOTEC DRAWING NUMBER		DOCUMENT ID	REVISION
900707__GAU01__ZC01__MTL01__31053		OU100692091	3
DRAWN	JKM	13/08/2020	
CHECKED	SBY	14/08/2020	
ENGINEER	APL	11/08/2020	
APPROVED	PRI	17/08/2020	
EMPLOYER			
SCALE	1:50,25	A1	

MANSOURAH - MASSARAH GOLD PROJECT
GENERAL ARRANGEMENT DRAWING
CRUSHING
LAYOUT OF BAG FILTER & DUCT SUPPORT FOUNDATION SHT 2

DRAWING NUMBER	REV
MD - 216 - 3100 - EG - CV - GAD - 2024	D01