


DRAWING NUMBER: MD-216-3100-EG-CV-GAD-2025 REV D01

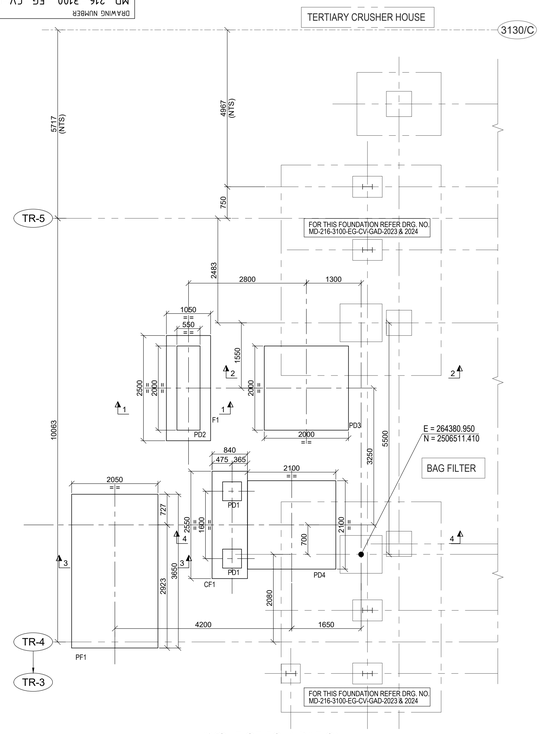


LAYOUT OF FOUNDATION
(SCALE-1:50)

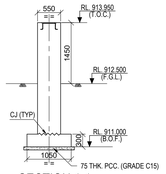


SECTION 1-1
(SCALE-1:50)

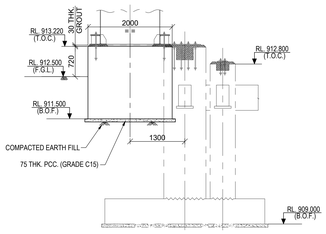


SECTION 2-2
(SCALE-1:50)

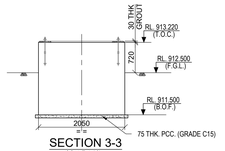


SECTION 3-3
(SCALE-1:50)

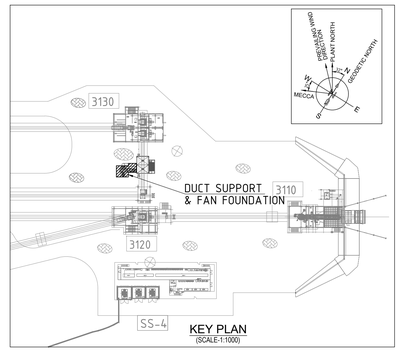


KEY PLAN
(SCALE-1:1000)

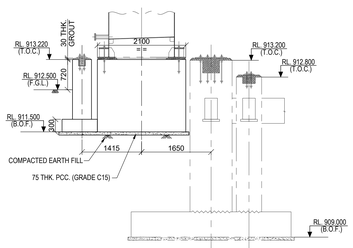


SECTION 4-4
(SCALE-1:50)

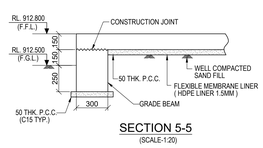


SECTION 5-5
(SCALE-1:20)

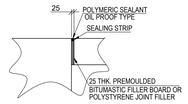


SECTION 6-6
(SCALE-1:20)

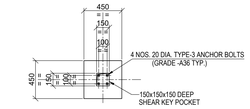


DETAIL OF PEDESTAL MKD. PD1
(SCALE-1:25)

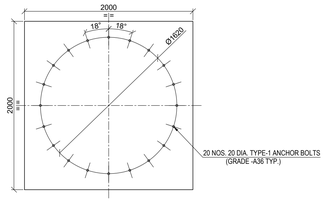


DETAIL OF PEDESTAL MKD. PD3
(SCALE-1:25)

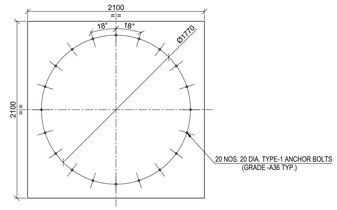


DETAIL OF PEDESTAL MKD. PD4
(SCALE-1:25)

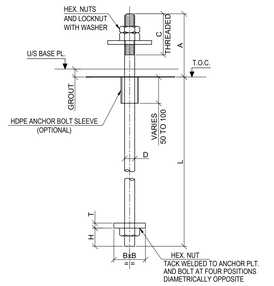


TYP. DETAIL OF BOLT

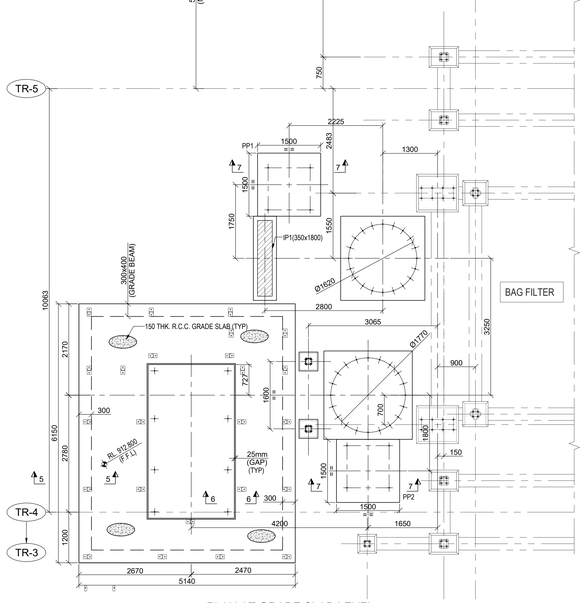


PLAN AT GRADE SLAB LEVEL
(SCALE-1:50)

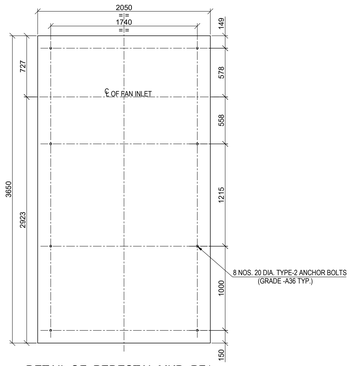


DETAIL OF PEDESTAL MKD. PF1
(SCALE-1:25)

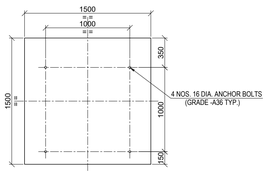


DETAIL OF PEDESTAL MKD. PP1
(SCALE-1:25)

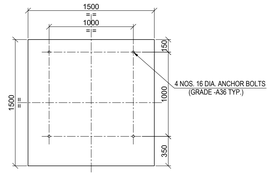


DETAIL OF PEDESTAL MKD. PP2
(SCALE-1:25)

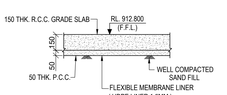


TYP. DETAIL OF 150 THK. GRADE SLAB
SCALE 1:20

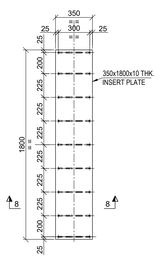

DETAIL OF INSERT PLATE - IP1
(SCALE-1:20)

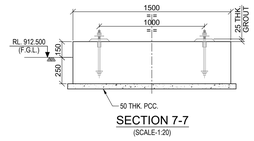

SECTION 7-7
(SCALE-1:20)

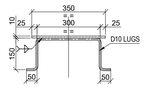

SECTION 8-8
(SCALE 1:10)

SCHEDULE OF BOLTS

D BOLT DIA. MM	BxB BOTTOM PLATE (SQUARE) SQ MM	DIMENSIONS (MM)				
		L	A	C	T	H
20 DIA TYPE-1	60x60	450	350	110	10	30
20 DIA TYPE-2	60x60	450	140	110	10	30
20 DIA TYPE-3	60x60	450	160	110	10	30
16 DIA	50x50	350	150	100	10	30

LEGENDS :-

R.L - REDUCED LEVEL
℄ - CENTRE LINE
CJ - CONSTRUCTION JOINT
FDN. - FOUNDATION.
T.O.C. - TOP OF CONCRETE.
F.G.L - FINISHED GROUND LEVEL.
F.F.L - FINISHED FLOOR LEVEL.
B.O.F. - BOTTOM OF FOUNDATION
TYP. - TYPICAL.
R.C.C - REINFORCED CEMENT CONCRETE
P.C.C - PLAIN CEMENT CONCRETE
MKD. - MARKED.
THK. - THICK
NTS. - NOT TO SCALE
PD - PEDESTAL FOR DUCT SUPPORT
PF - PEDESTAL FOR FAN
PP - PEDESTAL FOR PLATFORM

NOTES :-

1. ALL DIMENSIONS ARE IN MILLIMETRES AND LEVELS AND CO-ORDINATES ARE IN METRES, UNLESS OTHERWISE STATED.
2. GRADE OF CONCRETE SHALL BE C35 FOR FOUNDATION.
3. GRADE OF REINFORCEMENT SHALL BE DEFORMED BAR ASTM A615 - GRADE 60 (fy = 420 MPa).
4. NET SAFE BEARING CAPACITY OF SOIL AT BOTTOM OF FOUNDATION CONSIDERED 500KN/ SQ. M.
5. CLEAR COVER TO MAIN REINFORCEMENT SHALL BE AS
   a) FOUNDATION = 75 mm (BOTTOM & SIDE) 50 mm. (TOP)
   b) COLUMN & PEDESTAL = 50mm
   c) BEAM = 50mm
   d) SLAB = 40mm
6. FOR MINIMUM LAP LENGTH OF REINFORCEMENT AND OTHER GENERAL NOTES FOR CIVIL WORKS REFER STANDARD DRG : MD-216-1000-EG-CV-DED-1001
7. IF ANY PART OF FOUNDATION COMES ON BACKFILL ZONE OF ADJACENT FOUNDATION OR ANY LOOSE POCKETS ARE ENCOUNTERED BELOW FOUNDATION LEVEL THE SAME SHALL BE REMOVED AND FILLED WITH PCC.
8. THIS DRG. SHALL BE READ IN CONJUNCTION WITH DRG. NO. MD-216-3100-EG-CV-GAD-2023 & 2024
9. ALL STRUCTURAL WORK SHALL CONFORM TO CIVIL STRUCTURAL DESIGN CRITERIA NO. MD - 216 - 1000 -EG -ST - CRT - 1001
10. FOR OTHER STANDARD REINFORCEMENT DETAILS REFER DRG : MD-216-1000-EG-CV-DED-1005

DOCUMENT NUMBER	REFERENCE DOCUMENTS	REV	DATE	REVISION DESCRIPTION	DRN	CHK	ENG	APP	EMP
MD-216-3100-EG-CV-GAD-2023	LAYOUT OF BAG FILTER & DUCT SUPPORT FOUNDATION SHT 1								
MD-216-3100-EG-CV-GAD-2024	LAYOUT OF BAG FILTER & DUCT SUPPORT FOUNDATION SHT 2								
MD-216-3100-EG-ME-GAD-1026	DUCT-DUST EXTRACTION SYSTEM FOR SECONDARY CRUSHER HOUSE								
MD-216-3100-EG-ME-GAD-1027	DUCT-DUST EXTRACTION SYSTEM FOR SECONDARY CRUSHER HOUSE	D01	10/03/2023	AS-BUILT	JKM	SBY	APL	PRI	
MD-216-3100-EG-ME-DED-V509-2005	FAN FOR SEC. & TER. CRUSHER HOUSE DE SYSTEM (3100_FAN_001)	C01	26/11/2020	ISSUED FOR CONSTRUCTION & REVISED AS MARKED (C01)	JKM	SBY	APL	PRI	
		A01	24/09/2020	ISSUED FOR REFERENCE	JKM	SBY	APL	PRI	

RESERVED FOR VENDOR LOGO AND DRAWING NUMBER

LARSEN & TOUBRO
This drawing is the property of LARSEN & TOUBRO and must not be passed on to any person or body not authorized by us to receive it nor be copied or otherwise made use either in full or in part by such person or body without our prior permission in writing.

Outotec
The content of these documents are the sole property of Outotec Oyj. Any rights not expressly granted herein are reserved. Reproduction, transfer or distribution of part or all of the contents in any form without prior written permission of Outotec is prohibited.

MA'ADEN معادن Saudi Arabian Mining Company شركة معادن العربية السعودية
This document and the information contained herein is Ma'aden proprietary know-how. This document or any part thereof should not be reproduced, stored in a retrieval system or transmitted by any means, electronic or otherwise, or divulged without prior written permission of Ma'aden.

LARSEN & TOUBRO DRAWING NUMBER	019045_080_C_G_24369_001	REVISION 2
OUTOTEC DRAWING NUMBER	900707 _ GAU01 _ ZC01 _ MTL01 _ 31054	DOCUMENT ID OU100698064 / REVISION 2
DRAWN	JKM	22/09/2020
CHECKED	SBY	23/09/2020
ENGINEER	APL	21/09/2020
APPROVED	PRI	24/09/2020
EMPLOYER		
SCALE	1:50, 1:1000	A0

MANSOURAH - MASSARAH GOLD PROJECT
GENERAL ARRANGEMENT DRAWING
CRUSHING
LAYOUT OF FAN AND DUCT SUPPORT FOUNDATION

DRAWING NUMBER: MD - 216 - 3100 - EG - CV - GAD - 2025 REV: D01