


DRAWING NUMBER: MD-216-3720-EG-CV-GAD-1001
REV: D01

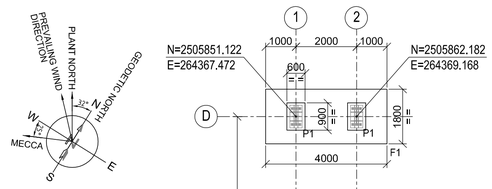


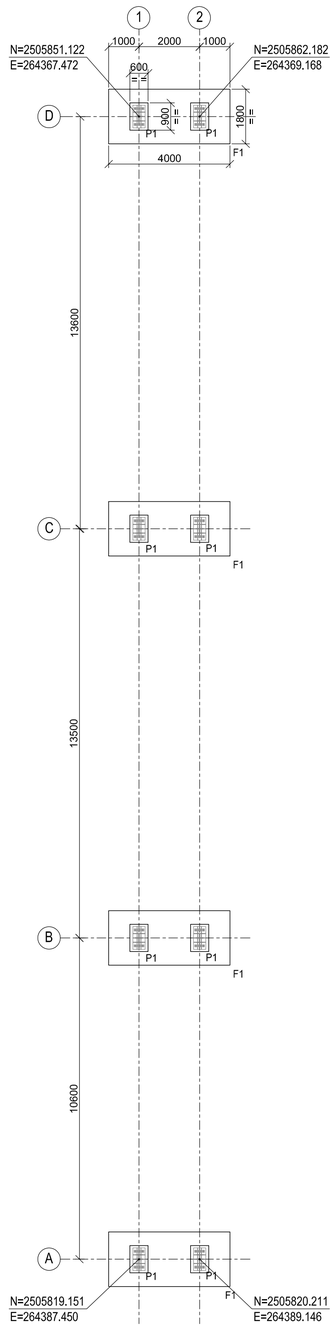


LAYOUT OF FOUNDATION
SCALE 1:100

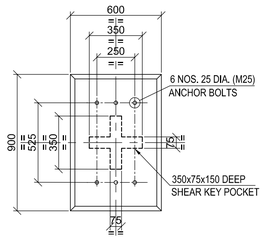


VIEW : 1-1
(DETAIL OF P1)
SCALE 1:20

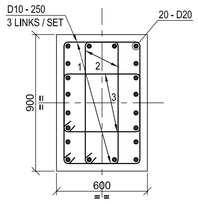

R.C DET. OF P1
SCALE 1:20

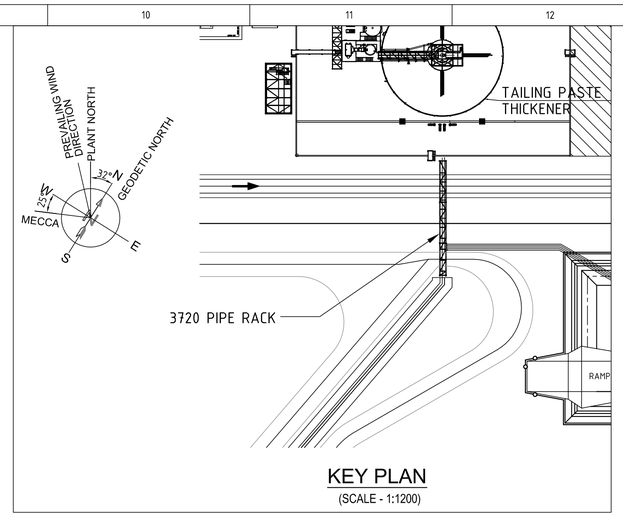


KEY PLAN
(SCALE - 1:1200)

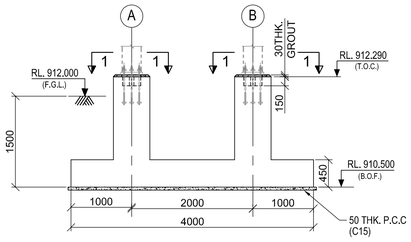


SECTION : A-A


SCALE 1:50

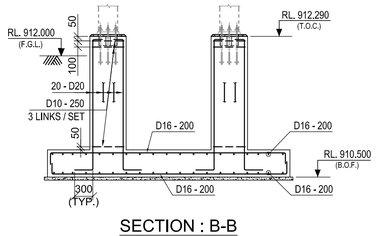

SECTION : B-B
SCALE 1:50

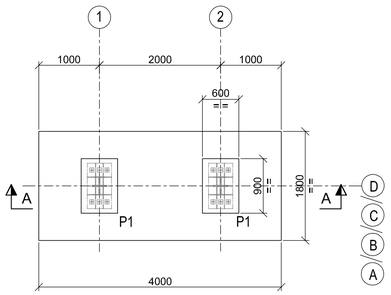

DET. OF FOUNDATION MKD. F1
SCALE 1:50

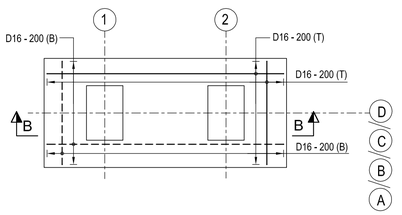

R.C DET. OF FOUNDATION MKD. F1
SCALE 1:50

LEGEND :-

R.L. - REDUCED LEVEL
CL. - CENTRE LINE
I.L - INVERT LEVEL
F.G.L - FINISHED GROUND LEVEL
T.O.C. - TOP OF CONCRETE
P.C.C - PLAIN CEMENT CONCRETE
THK. - THICK
TYP. - TYPICAL
B.O.F. - BOTTOM OF FOUNDATION
DET. - DETAIL
R.C. - REINFORCED CONCRETE
MKD. - MARKED
DIA - DIAMETER
BOTTOM REINFORCEMENT (B) - - - - - - - -
TOP REINFORCEMENT (T) - ————————

NOTES:-

1. ALL DIMENSIONS ARE IN MILLIMETRES AND LEVELS AND CO-ORDINATES ARE IN METRES UNLESS OTHERWISE STATED.
2. NET SAFE BEARING CAPACITY OF SOIL AT BOTTOM OF FOUNDATION IS CONSIDERED 400KN/SQ. M.
3. GRADE OF CONCRETE SHALL BE C35 (35MPa) FOR GRADE SLAB & C15 (15MPa) FOR BLINDING CONCRETE.
4. GRADE OF REINFORCEMENT SHALL BE DEFORMED BAR ASTM A615 - GRADE 60 (fy = 420 MPa).
5. IF ANY PART OF FOUNDATION COMES ON BACKFILL ZONE OF ADJACENT FOUNDATION OR ANY LOOSE SOIL ARE ENCOUNTERED BELOW FOUNDATION LEVEL THE SAME SHALL BE REMOVED AND FILLED WITH PCC.
6. CLEAR COVER TO REINFORCEMENT SHALL BE FOUNDATION - 50MM., PEDESTAL - 40MM.
7. FOR STANDARD REINFORCEMENT DETAIL & GENERAL NOTES FOR CIVIL WORKS REFER DRAWING NO. MD-216-1000-EG-CV-DED-1005 & 1001.

DOCUMENT NUMBER	REFERENCE DOCUMENTS	REV	DATE	REVISION DESCRIPTION	DRN	CHK	ENG	APP	EMP
		D01	13/10/2023	AS - BUILT	SYA	SJM	AVG	AG	
		C01	05/05/2021	ISSUED FOR CONSTRUCTION & REVISED AS PER EMPLOYER'S	SYA	SJM	AVG	AG	
MD-216-1000-EG-ST-CRT-1001	CIVIL, STRUCTURAL & ARCHITECTURAL - DESIGN CRITERIA			COMMENT DATED 04/05/2021					
MD-216-3720-EG-ST-GAD-1003	TAILING PASTE AREA PIPE-RACK	A01	30/03/2021	ISSUED FOR REVIEW	SYA	SJM	AVG	AG	

RESERVED FOR VENDOR LOGO AND DRAWING NUMBER

LARSEN & TOUBRO

This drawing is the property of LARSEN & TOUBRO and must not be passed on to any person or body not authorized by us to receive it nor be copied or otherwise made use either in full or in part by such person or body without our prior permission in writing.

Outotec

The content of these documents are the sole property of Outotec Oyj. Any rights not expressly granted herein are reserved. Reproduction, transfer or distribution of part or all of the contents in any form without prior written permission of Outotec is prohibited.

MA'ADEN معادن
Saudi Arabian Mining Company شركة التعدين العربية السعودية

This document and the information contained herein is Ma'aden proprietary know-how. This document or any part thereof should not be reproduced, stored in a retrieval system or transmitted by any means, electronic or otherwise, or divulged without prior written permission of Ma'aden.

LARSEN & TOUBRO DRAWING NUMBER: 019045_450_C_G_24646_001 — REVISION: 2
OUTOTEC DRAWING NUMBER: 900707__GAU01__ST03__MTL01__44046 — DOCUMENT ID: OU100717476 — REVISION: 2

DRAWN	SYA	24/03/2021
CHECKED	SJM	27/03/2021
ENGINEER	AVG	24/03/2021
APPROVED	AG	30/03/2021
EMPLOYER		
SCALE	1:100, 1:50	A1

MANSOURAH - MASSARAH GOLD PROJECT
GENERAL ARRANGEMENT DRAWING
TAILING PASTE AREA PIPE RACK
LAYOUT & DETAIL OF PIPE RACK FOUNDATIONS

DRAWING NUMBER: MD-216-3720-EG-CV-GAD-1001 — REV: D01

MA'ADEN معادن
Saudi Arabian Mining Company شركة التعدين العربية السعودية

BECHTEL

Mansourah Massarah Gold Project
Comment Resolution Log Sheet / Compliance Report

Outotec
LARSEN & TOUBRO

PROJECT: MANSOURAH MASSARAH GOLD PROJECT — **PROJECT NO.: 216**

STAGE: 4 - PROJECT EXECUTION. — **REVIEW LOG DOC. NO. & REV.:**

ACONEX REF. NO. & DATE: BECHTEL-WTRAN-010487, 4 May 2021

STATUS CODE: A - APPROVED, C - APPROVED WITH COMMENTS, R - REVISE & RESUBMIT & O - OTHERS (INFORMATION, REFERENCE, REVIEWED)

DOCUMENT NUMBER	Area / Title	Comment No.	PMC/PMT COMMENT DATE: 4 May 2021	Comment by	EPC Response DATE: 5 May 2021	Status	Remarks
			General Comments (cc)				
MD-216-3720-EG-CV-GAD-1001-RA01	3720	1	Please clarify why concrete covers are different from the Ma'aden Engineering Concrete General Notes	Bechtel	The cover shall be as per approved standard drawing available with construction team.	Closed	