


DRAWING NUMBER: MD-216-3740-EG-CV-GAD-1001
REV: D01

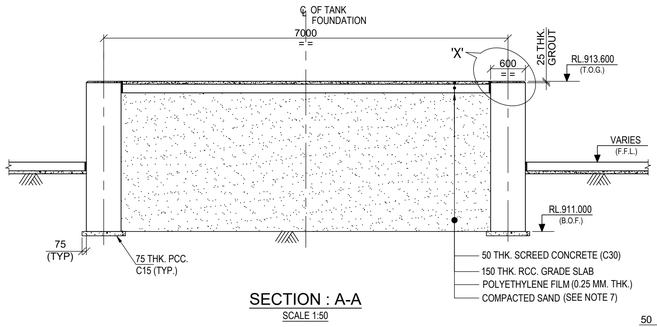


SECTION : A-A
SCALE 1:50

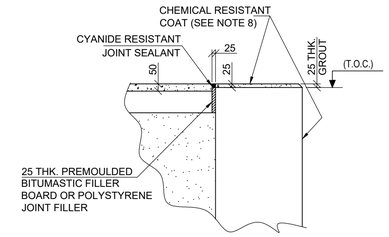


DETAIL - 'X'
SCALE 1:20

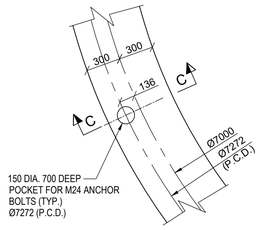


DETAIL : 'Y'
SCALE 1:25

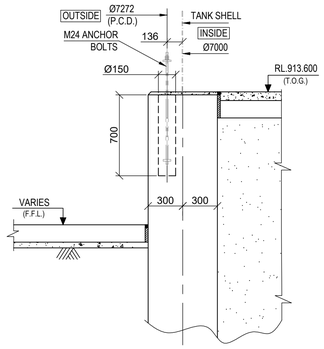


SECTION : C-C
SCALE 1:25

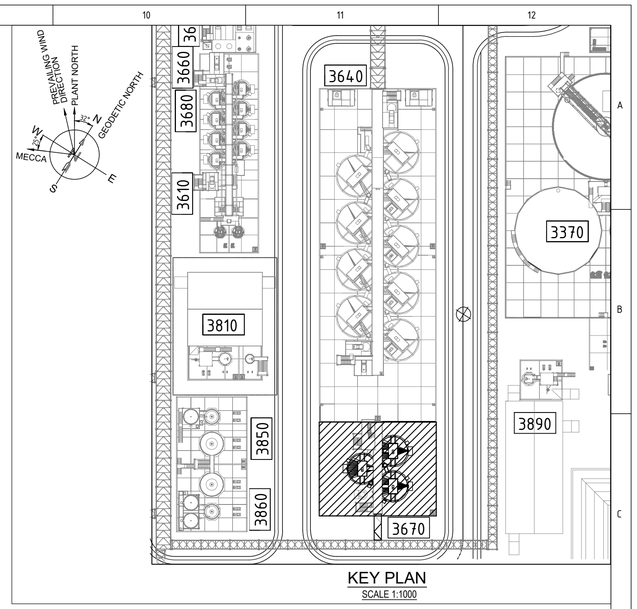


KEY PLAN
SCALE 1:1000

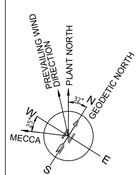


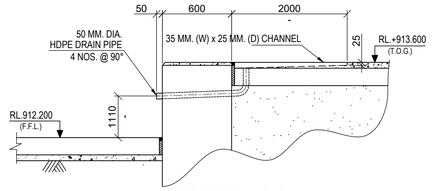


SECTION : B-B
SCALE 1:25

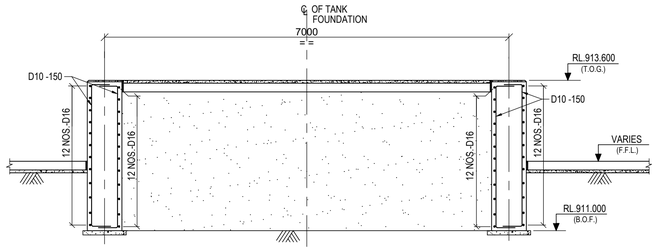


SECTION : A'-A'
SCALE 1:50

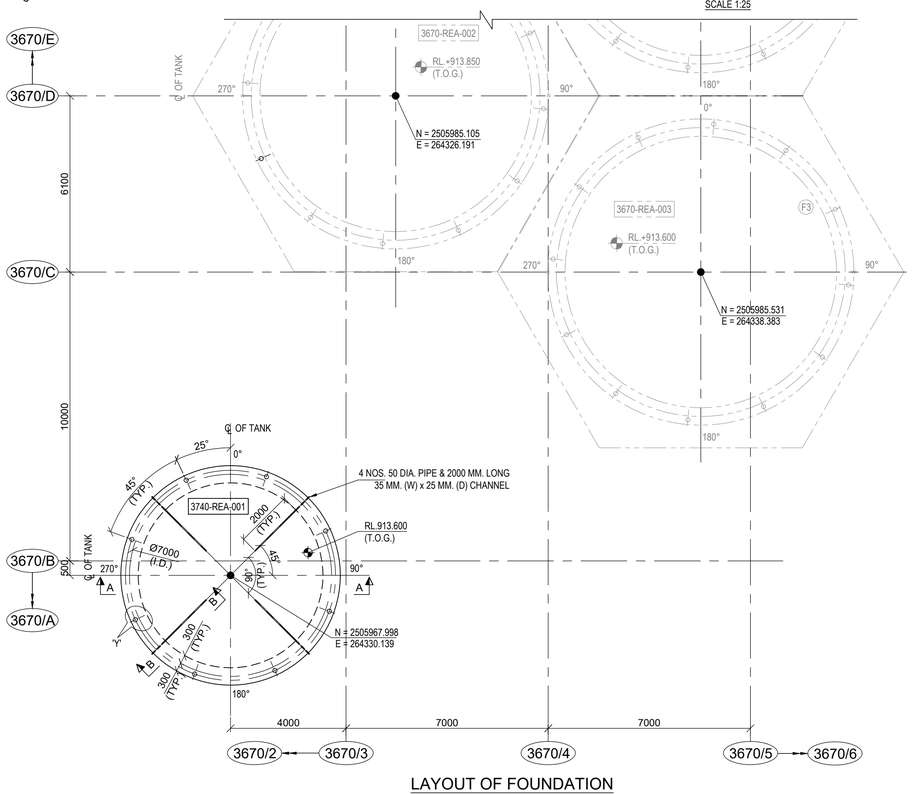

LAYOUT OF FOUNDATION
SCALE 1:100

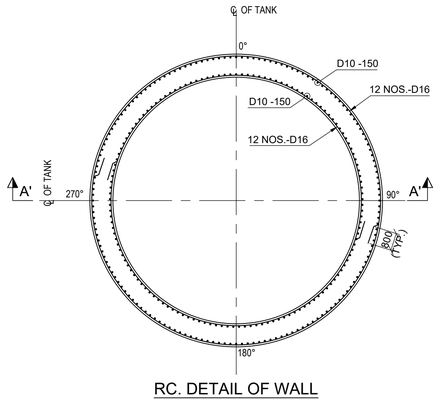

RC. DETAIL OF WALL
SCALE 1:75

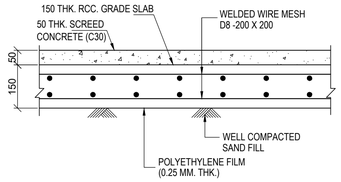

TYP. DET. OF 150 THK. GRADE SLAB
SCALE 1:10

LEGEND :-

R.L. - REDUCED LEVEL
℄ - CENTRE LINE
T.O.C. - TOP OF CONCRETE
TYP. - TYPICAL
R - RADIUS
F.G.L. - FINISHED GROUND LEVEL
F.F.L. - FINISHED FLOOR LEVEL
B.O.F. - BOTTOM OF FOUNDATION
P.C.D. - PITCH CIRCLE DIAMETER
Ø - DIAMETER
I.D. - INTERNAL DIAMETER
P.C.C - PLAIN CEMENT CONCRETE
MKD. - MARKED
THK. - THICK
DET. - DETAIL
T.O.G. - TOP OF GROUT
W - WIDTH
D - DEPTH
RC. - REINFORCED CONCRETE
RCC. - REINFORCED CEMENT CONCRETE
DIA. - DIAMETER
HDPE - HIGH DENSITY POLYETHYLENE

NOTES:-

1. ALL DIMENSIONS ARE IN MILLIMETRES AND LEVELS AND CO-ORDINATES ARE IN METRES UNLESS OTHERWISE STATED.
2. NET SAFE BEARING CAPACITY OF SOIL AT BOTTOM OF FOUNDATION CONSIDER 450KN/ SQ. M
3. GRADE OF CONCRETE SHALL BE C35 (35MPa) FOR FOUNDATION, C30 C30 (30MPa) FOR GRADE SLAB & C15 (15MPa) FOR BLINDING CONCRETE.
4. GRADE OF REINFORCEMENT SHALL BE DEFORMED BAR 420 MPa (GRADE 60) - ASTM A615/A615M.
5. GRADE OF WELDED WIRE FABRIC - ASTM A185(PLAIN) / A497 (DEFORMED).
6. IF ANY PART OF FOUNDATION COMES ON BACKFILL ZONE OF ADJACENT FOUNDATION OR ANY LOOSE SOIL ARE ENCOUNTERED BELOW FOUNDATION LEVEL THE SAME SHALL BE REMOVED AND FILLED WITH PCC.
7. SAND SHALL BE COMPACTED TO A MAXIMUM DEPTH OF 300MM AND SHALL BE COMPACTED TO 80% RELATIVE DENSITY AS DETERMINED BY ASTM D4253 AND ASTM D4254.
8. PRIMING COAT SIKAFLOOR 161 + BASE & SEALER COAT OF SIKAGUARD PW OR EQUIVALENT AS PER MANUFACTURER'S SPECIFICATION SHALL BE APPLIED FOR PROTECTING CONCRETE AGAINST CYANIDE, ACID AND ALKALI.
9. CLEAR COVER TO REINFORCEMENT SHALL BE AS FOLLOWS
   a) FOUNDATION = 50 mm
   b) SLAB = 20mm
10. FOR STANDARD REINFORCEMENT DETAIL & GENERAL NOTES FOR CIVIL WORKS REFER DRAWING NO. MD-216-1000-EG-CV-DED-1005 & 1001.

DOCUMENT NUMBER	REFERENCE DOCUMENTS	REV	DATE	REVISION DESCRIPTION	DRN	CHK	ENG	APP	EMP
MD-216-1000-EG-ST-CRT-1001	CIVIL, STRUCTURAL & ARCHITECTURAL - DESIGN CRITERIA	D01	17/03/2023	AS-BUILT	ABS	SJM	SOR	AG	
MD-216-3670-EG-ME-PLN-1001	FOUNDATION AND LOAD PLAN PRIMARY CYANIDE DESTRUCTION	C01	18/11/2020	ISSUED FOR CONSTRUCTION	ABS	SJM	SOR	AG	
	3670-REA-001 TO 003 CYANIDE DESTRUCTION REACTOR	A01	28/10/2020	ISSUED FOR REFERENCE	ABS	SJM	SOR	AG	

RESERVED FOR VENDOR LOGO AND DRAWING NUMBER

LARSEN & TOUBRO

This drawing is the property of LARSEN & TOUBRO and must not be passed on to any person or body not authorized by us to receive it nor be copied or otherwise made use either in full or in part by such person or body without our prior permission in writing.

Outotec

The content of these documents are the sole property of Outotec Oyj. Any rights not expressly granted herein are reserved. Reproduction, transfer or distribution of part or all of the contents in any form without prior written permission of Outotec is prohibited.

MA'ADEN معادن
Saudi Arabian Mining Company شركة معادن العربية السعودية

This document and the information contained herein is Ma'aden proprietary know-how. This document or any part thereof should not be reproduced, stored in a retrieval system or transmitted by any means, electronic or otherwise, or divulged without prior written permission of Ma'aden.

LARSEN & TOUBRO DRAWING NUMBER: 019045_450_C_G_24536_001 — REVISION: 2
OUTOTEC DRAWING NUMBER: 900707 _GAU01 _RN14 _MTL01 _37406 — DOCUMENT ID: OU100705877 — REVISION: 2

DRAWN	ABS	26/10/2020
CHECKED	SJM	27/10/2020
ENGINEER	SOR	26/10/2020
APPROVED	AG	28/10/2020
EMPLOYER		

SCALE: 1:100, 1:50, 1:25, 1:20 — A1

MANSOURAH - MASSARAH GOLD PROJECT
GENERAL ARRANGEMENT DRAWING
SECONDARY CYANIDE DESTRUCTION
GA & DETAILS OF TANK FOUNDATION

DRAWING NUMBER: MD-216-3740-EG-CV-GAD-1001 — REV: D01