


DRAWING NUMBER: MD - 216 - 3750 - EG - CV - GAD - 1310
REV: D01

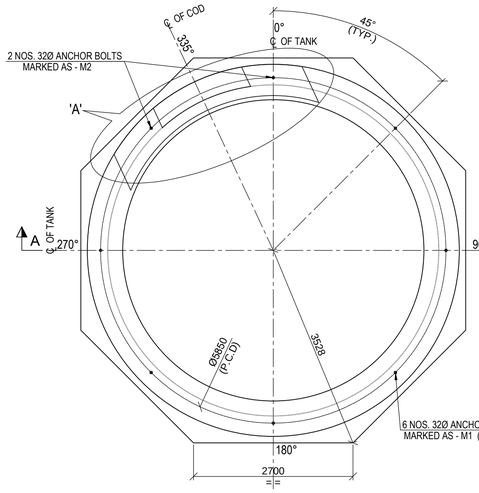


DETAIL OF TANK FOUNDATION MKD. F1
SCALE 1:50

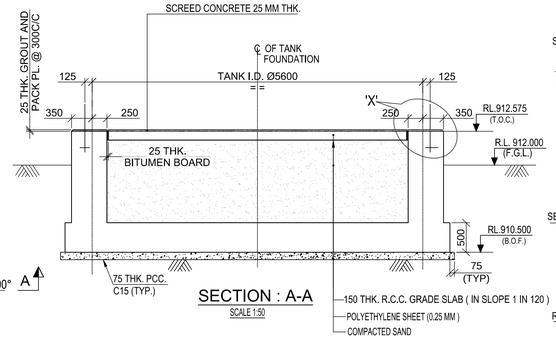


SECTION : A-A
SCALE 1:50

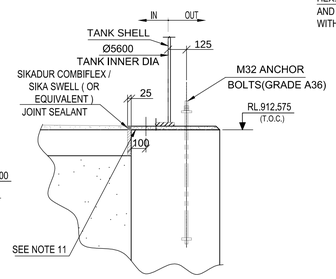


DETAIL - 'X'
SCALE 1:20

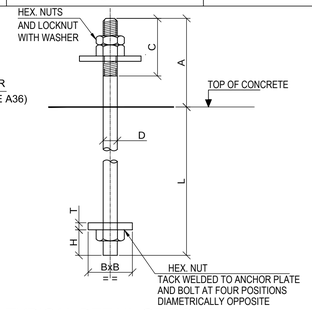


TYPICAL DETAIL OF BOLT
(SCALE - 1:50)

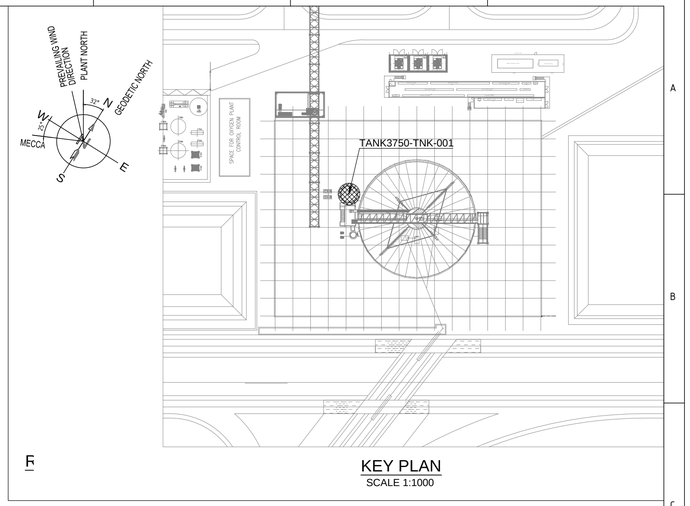


KEY PLAN
SCALE 1:1000

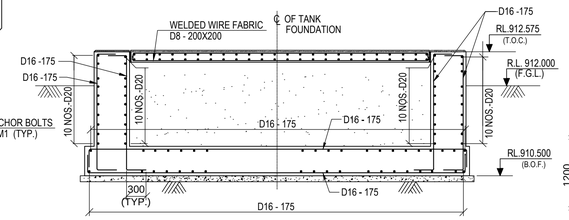

RCC. DETAIL OF SECTION A-A
SCALE 1:50

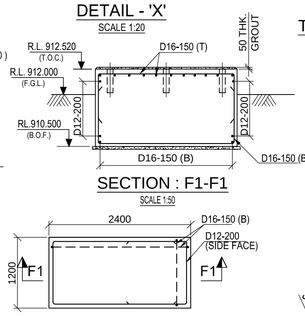


SECTION : F1-F1
SCALE 1:50

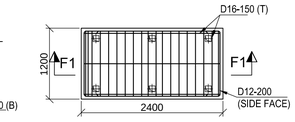


RCC DET. OF FDN. FOR PUMP MKD. 3750-PMP-001 & 002
(TOP VIEW)
SCALE 1:50


RCC DET. OF FDN. FOR PUMP MKD. 3750-PMP-001 & 002
(BOTTOM VIEW)
SCALE 1:40

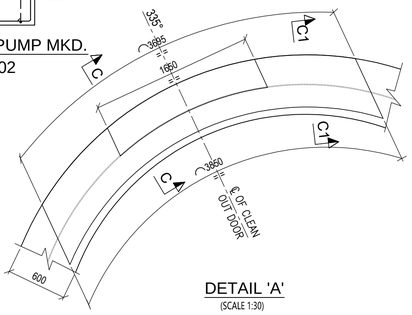

DETAIL 'A'
(SCALE 1:30)

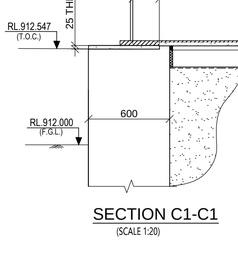


SECTION C1-C1
(SCALE 1:20)

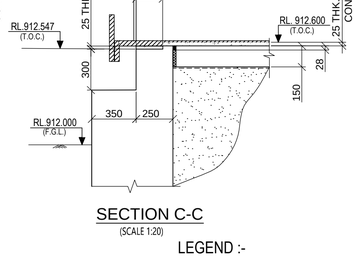


SECTION C-C
(SCALE 1:20)

LAYOUT OF FOUNDATION
SCALE 1:100


SCHEDULE OF BOLTS										
BOLT MARK	LEVEL (T.O.C)	D BOLT DIA. MM	NO. OF BOLTS	BxB BOTTOM PLATE (SQUARE) SQ MM	DIMENSIONS (MM)				
					L	A	C	T	H
M1	RL 912.575	32	6	100x100	800	605	180	16	35
M2	RL 912.547	32	2	100x100	800	633	180	16	35

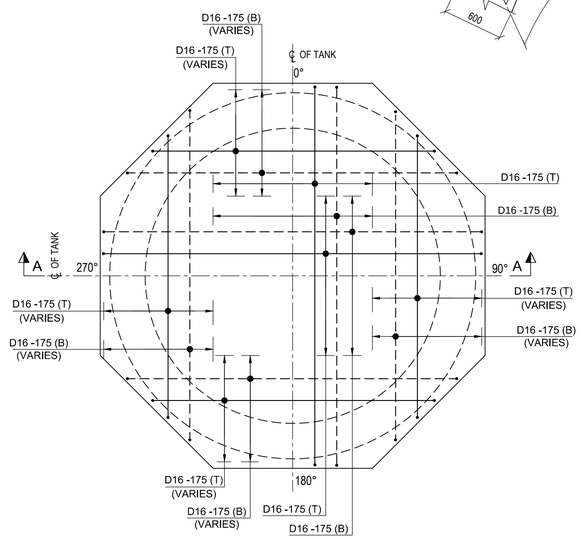

RCC. DETAIL OF TANK FOUNDATION MKD F1
SCALE 1:50

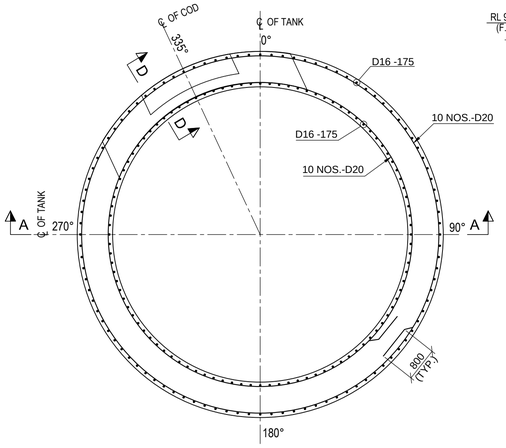

RCC. DETAIL OF WALL
SCALE 1:50

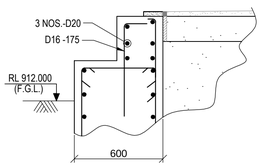

SECTION D-D
(SCALE 1:20)

LEGEND :-

R.L. - REDUCED LEVEL
℄ - CENTRE LINE
MM - MILLIMETRE
T.O.C. - TOP OF CONCRETE
TYP. - TYPICAL
R - RADIUS
R.C.C - REINFORCED CEMENT CONCRETE
F.G.L. - FINISHED GROUND LEVEL
F.F.L. - FINISHED FLOOR LEVEL
B.O.F. - BOTTOM OF FOUNDATION
P.C.D. - PITCH CIRCLE DIAMETER
Ø - DIAMETER
I.D. - INTERNAL DIAMETER
P.C.C - PLAIN CEMENT CONCRETE
MKD. - MARKED
THK. - THICK
COD - CLEAN OUT DOOR
EQV - EQUIVALENT
BOTTOM REINFORCEMENT (B) - - - - -
TOP REINFORCEMENT (T) - ———
DIA. - DIAMETER

NOTES:-

1. ALL DIMENSIONS ARE IN MILLIMETRES AND LEVELS AND CO-ORDINATES ARE IN METRES UNLESS OTHERWISE STATED.
2. GRADE OF CONCRETE SHALL BE 35 MPa FOR FOUNDATION, 30 MPa FOR GRADE SLAB & 15 MPa FOR BLINDING CONCRETE.
3. GRADE OF REINFORCEMENT SHALL BE DEFORMED BAR 420 MPa (GRADE 60) - ASTM A615/A615M.
4. NET SAFE BEARING CAPACITY OF SOIL AT BOTTOM OF FOUNDATION IS CONSIDERED 450KN/ SQ. M
5. GRADE OF WELDED WIRE FABRIC ASTM A185 (PLAIN)/A497 (DEFORMED)
6. CLEAR COVER TO MAIN REINFORCEMENT SHALL BE AS FOLLOWS:
   a) FOUNDATION : 50 mm. b) RING WALL : 50 mm. c) GRADE SLAB : 20 mm.
7. IF ANY PART OF FOUNDATION COMES ON BACKFILL ZONE OF ADJACENT FOUNDATION OR ANY LOOSE SOIL ARE ENCOUNTERED BELOW FOUNDATION LEVEL THE SAME SHALL BE REMOVED AND FILLED WITH PCC.
8. FOR DETAIL OF ANCHOR BOLTS, REFER DRAWING NO. MD-216-1000-EG-CV-DED-1003.
9. THIS DRAWING SHALL BE READ IN CONJUNCTION WITH GENERAL NOTES DRAWING NO. MD-216-1000-EG-CV-DED-1001.
10. THIS DRAWING SHALL BE READ IN CONJUNCTION WITH STANDARD REINFORCEMENT DETAILS DRAWING NO. MD-216-1000-EG-CV-DED-1005.
11. 100 MM GROUT TO BE PLACED FOR PLACEMENT OF SEALANT.

DOCUMENT NUMBER	REFERENCE DOCUMENTS	REV	DATE	REVISION DESCRIPTION	DRN	CHK	ENG	APP	EMP
		D01	16/03/2023	AS-BUILT	AUD	SJM	SOR	AG	
MD-216-3750-EG-ST-GAD-1003	ROOF SYSTEM OF TANK 3750-TNK-001	C03	10/11/2020	ISSUED FOR CONSTRUCTION & REVISED AS MKD C03	AUD	SJM	SOR	AG	
MD-216-3750-EG-ST-GAD-1002	SHELL PLT DETAIL OF TANK 3750-TNK-001	C02	27/10/2020	ISSUED FOR CONSTRUCTION & REVISED AS MKD C02	AUD	SJM	SOR	AG	
MD-216-3750-EG-ST-GAD-1001	PLAN, ELVN, DETAIL OF TANK 3750-TNK-001	C01	20/06/2020	ISSUED FOR CONSTRUCTION	AUD	SJM	SOR	AG	
MD-216-3750-EG-ME-GAD-1001	CIL PROCESS WATER TANK 3750-TNK-001	A01	25/05/2020	ISSUED FOR REFERENCE	AUD	SJM	SOR	AG	

RESERVED FOR VENDOR LOGO AND DRAWING NUMBER

LARSEN & TOUBRO DRAWING NUMBER: 019045_450_C_G_24135_001 — REVISION: 4
OUTOTEC DRAWING NUMBER: 900707 __GAU01 __AG03__MTL01 __37505 — DOCUMENT ID: OU100675357 — REVISION: 4

LARSEN & TOUBRO
This drawing is the property of LARSEN & TOUBRO and must not be passed on to any person or body not authorized by us to receive it nor be copied or otherwise made use either in full or in part by such person or body without our prior permission in writing.

Outotec
The content of these documents are the sole property of Outotec Oyj. Any rights not expressly granted herein are reserved. Reproduction, transfer or distribution of part or all of the contents in any form without prior written permission of Outotec is prohibited.

MA'ADEN معادن
Saudi Arabian Mining Company شركة معادن العربية السعودية
This document and the information contained herein is Ma'aden proprietary know-how. This document or any part thereof should not be reproduced, stored in a retrieval system or transmitted by any means, electronic or otherwise, or divulged without prior written permission of Ma'aden.

DRAWN	AUD	20/05/2020
CHECKED	SJM	22/05/2020
ENGINEER	SOR	20/05/2020
APPROVED	AG	25/05/2020
EMPLOYER		
SCALE	1:25, 1:50, 1:100	A1

MANSOURAH - MASSARAH GOLD PROJECT
GENERAL ARRANGEMENT DRAWING
TAILING & CIL WATER PROCESS STORAGE
DETAIL OF TANK FOUNDATION 3750-TNK-001

DRAWING NUMBER: MD - 216 - 3750 - EG - CV - GAD - 1310 — REV: D01