

DRAWING NUMBER: MD-216-3750-EG-CV-GAD-1311
REV: D01

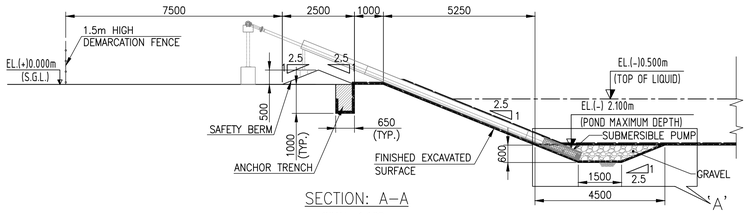



SECTION: A–A
SCALE–1:100

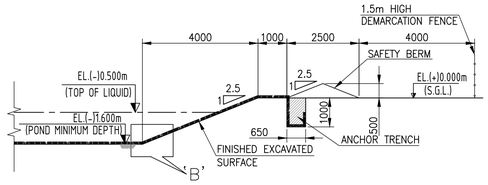


SECTION: B–B
SCALE–1:100

KEYPLAN

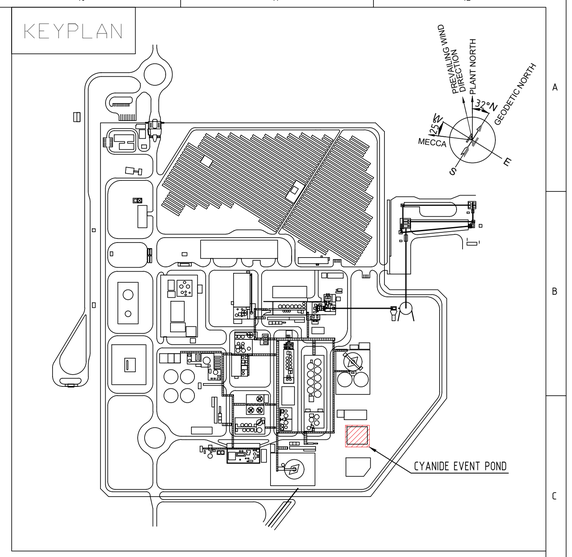


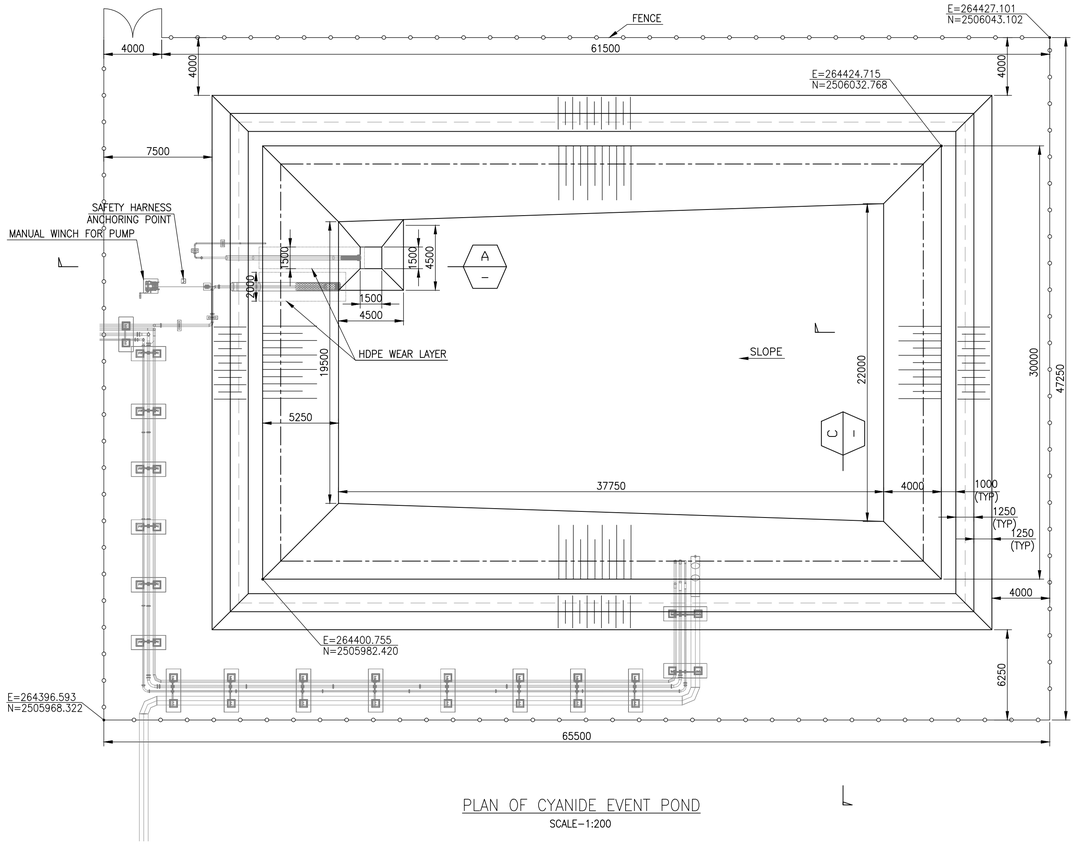


PLAN OF CYANIDE EVENT POND
SCALE–1:200

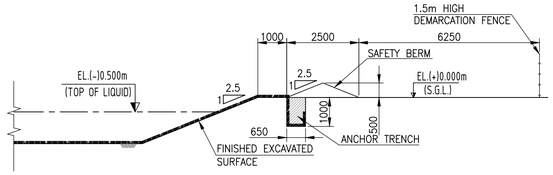

SECTION: C–C
SCALE–1:100

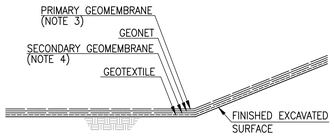

DETAIL–B
LINER SUBGRADE
SCALE–1:30

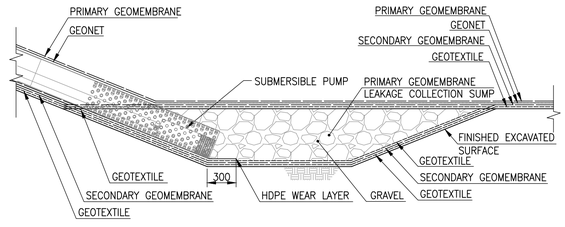

DETAIL–A
LINER SUBGRADE
SCALE–1:30

LEGENDS:

TYP - TYPICAL
SGL - STRIPPED GROUND LEVEL
EL - ELEVATION LEVEL
MKD. - MARKED

NOTES:

1. ALL DIMENSIONS ARE IN MILLIMETRES.
2. CO-ORDINATES AND LEVELS ARE IN METRES.
3. ROWED HDPE DOUBLE ENHANCED TEXTURED BLACK (HDE)(ETEX): Model: HDE 2.00 mm FOR PRIMARY GEOMEMBRANE.
4. ROWED HDPE DOUBLE SMOOTH BLACK (HDS): Model: HDS 2.00 mm FOR SECONDARY GEOMEMBRANE.
5. GEOTEXTILE IS A NON-WOVEN GEOTEXTILE WITH A MINIMUM MASS OF 700g/m2.
6. GEONET SHALL BE A BI-AXIAL GEOGRID. 80kN/m BY 30kN/m (MINIMUM).
7. GRAVEL SHALL COMPRISE 3 LAYERS OF 200mm COMPACTED THICKNESS OF CRUSHED ROCK COMPACTED TO A MINIMUM OF 95% STANDARD (PROCTOR) MDD OR APPROVED BY ENGINEER.
8. ANCHOR TRENCH AND SAFETY BERM SHALL BE GENERAL EARTH FILL (FINE) SOURCED FROM EXCAVATION OF THE POND AT DEPTH LESS THAN 1.5-2m APPROVED BY ENGINEER.

DOCUMENT NUMBER	REFERENCE DOCUMENTS	REV	DATE	REVISION DESCRIPTION	DRN	CHK	ENG	APP	EMP
		D01	17/03/2023	AS-BUILT	APEX	BJB	APEX	SJM	
		C01	17/04/2021	ISSUED FOR CONSTRUCTION	APEX	BJB	APEX	SJM	
		A02	13/03/2021	REVISED AS PER EMPLOYER'S COMMENTS ON 02/03/2021 & AS MKD. A02	APEX	BJB	APEX	SJM	
MD-216-3750-EG-ME-GAD-1029	CYANIDE EVENT POND	A01	05/02/2021	ISSUED FOR REVIEW	APEX	BJB	APEX	SJM	

RESERVED FOR VENDOR LOGO AND DRAWING NUMBER

LARSEN & TOUBRO

This drawing is the property of LARSEN & TOUBRO and must not be passed on to any person or body not authorized by us to receive it nor be copied or otherwise made use either in full or in part by such person or body without our prior permission in writing.

Outotec

The content of these documents are the sole property of Outotec Oyj. Any rights not expressly granted herein are reserved. Reproduction, transfer or distribution of part or all of the contents in any form without prior written permission of Outotec is prohibited.

MA'ADEN معادن
Saudi Arabian Mining Company شركة معادن العربية السعودية

This document and the information contained herein is Ma'aden proprietary know-how. This document or any part thereof should not be reproduced, stored in a retrieval system or transmitted by any means, electronic or otherwise, or divulged without prior written permission of Ma'aden.

LARSEN & TOUBRO DRAWING NUMBER	019045_450_C_G_24587_001		REVISION 3
OUTOTEC DRAWING NUMBER	900707__GAU01__AG03__MTL01__37510	DOCUMENT ID OU100712115	REVISION 3
DRAWN	APEX	12/01/2021	
CHECKED	BJB	03/02/2021	
ENGINEER	APEX	12/01/2021	
APPROVED	SJM	30/01/2021	
EMPLOYER			
SCALE	1:200,100,30	A1	

MANSOURAH - MASSARAH GOLD PROJECT
GENERAL ARRANGEMENT DRAWING
CIL PROCESS WATER STORAGE
LAYOUT & DETAILS OF CYANIDE EVENT POND

DRAWING NUMBER: MD-216-3750-EG-CV-GAD-1311
REV: D01