

DRAWING NUMBER: MD-216-3750-EG-CV-GAD-1312 | REV: D01

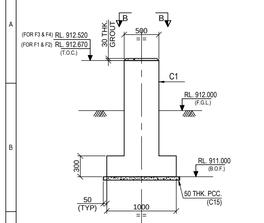


SECTION : A-A

SCALE 1:30

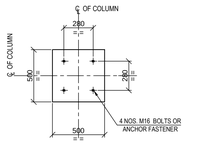

VIEW : B-B


SCALE 1:20

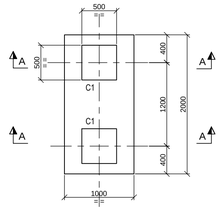


DETAIL OF FDN MKD. F4

(7 NOS. REQD.)

SCALE 1:30

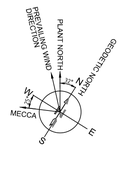


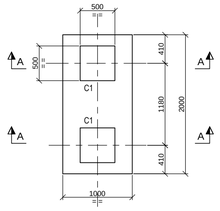

DETAIL OF FDN MKD. F2 & F3


(10 + 3 NOS. REQD.)

SCALE 1:30

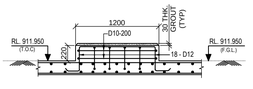


SECTION 1-1

(SCALE 1:30)

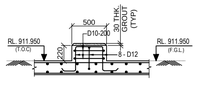


SECTION 2-2

(SCALE 1:30)

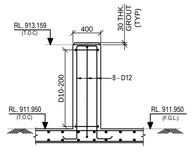


SECTION 3-3

(SCALE 1:30)

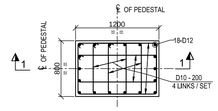


RC DETAIL OF PEDESTAL MKD. P1

(SCALE 1:30)

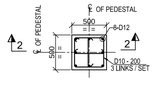


RC DETAIL OF PEDESTAL MKD. P2

(SCALE 1:30)

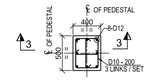

RC DETAIL OF PEDESTAL MKD. P3


(SCALE 1:30)

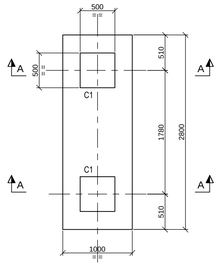

DETAIL OF FDN MKD. F1


(10 NOS. REQD.)

SCALE 1:30

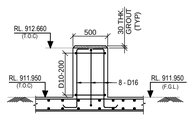


SECTION 4-4

(SCALE 1:30)

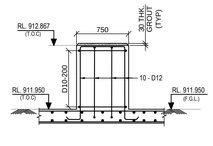


SECTION 5-5

(SCALE 1:30)

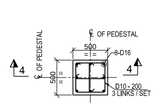


RC DETAIL OF PEDESTAL MKD. P4

(SCALE 1:30)

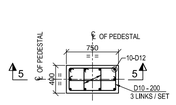


RC DETAIL OF PEDESTAL MKD. P5

(SCALE 1:30)

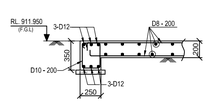

SECTION Y-Y


(SCALE 1:25)

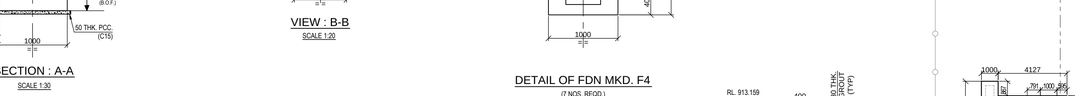

SECTION 6A-6A


RC DETAIL OF PEDESTAL MKD. P6


(SCALE 1:30)

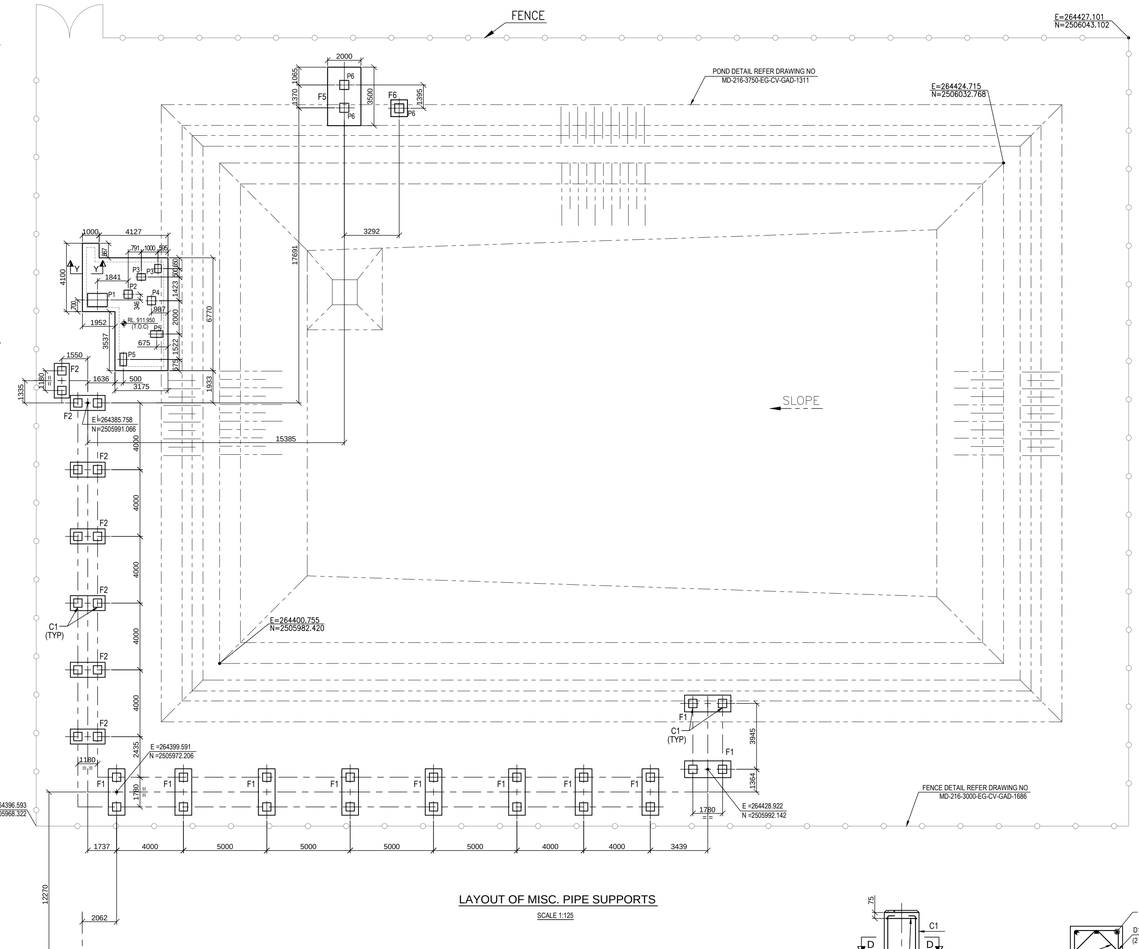

LAYOUT OF MISC. PIPE SUPPORTS


SCALE 1:125

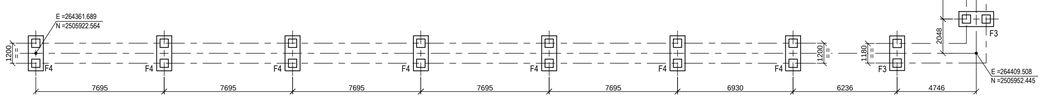

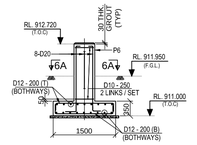


SECTION 6-6

(SCALE 1:50)

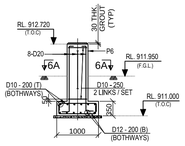


SECTION 6-6

(SCALE 1:50)

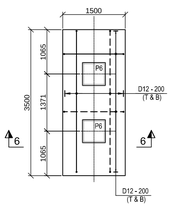


RC DETAIL OF FOOTING MKD. F5

(SCALE 1:50)

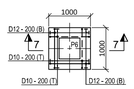


RC. DETAIL OF FOOTING MKD. F6

SCALE 1:50

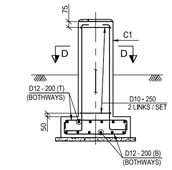


SECTION : C-C

SCALE 1:30

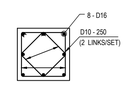

SECTION : D-D

SCALE 1:20

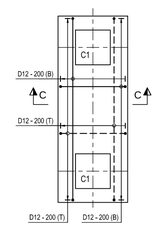

RC. DETAIL OF FOUNDATION MKD. F1,F2, F3 & F4

SCALE 1:30

LEGEND :-

R.L. - REDUCED LEVEL
THK. - THICK
TYP. - TYPICAL.
MKD. - MARKED
T.O.C - TOP OF CONCRETE
T.O.G - TOP OF GROUT
℄ - CENTRE LINE
P.C.C - PLAIN CEMENT CONCRETE
F.G.L. - FINISHED GROUND LEVEL.
GA - GENERAL ARRANGEMENT
B.O.F. - BOTTOM OF FOUNDATION
DIA - DIAMETER
FDN. - FOUNDATION
STR. - STRUCTURAL
REQD. - REQUIRED
REF. - REFER
DRG. - DRAWING
PL. - PLATE

NOTES:-

1. ALL DIMENSIONS ARE IN MILLIMETRES AND LEVELS AND CO-ORDINATES ARE IN METRES UNLESS OTHERWISE STATED.
2. GRADE OF CONCRETE SHALL BE C35 (50Mpa) FOR FOUNDATION, C30 (30Mpa) FOR GRADE SLAB & C15 (15Mpa) FOR BLINDING CONCRETE.
3. GRADE OF REINFORCEMENT SHALL BE DEFORMED BAR 420 MPa (GRADE 60) - ASTM A615/A615M.
4. CLEAR COVER TO REINFORCEMENT SHALL BE FOUNDATIONS = 50 MM., COLUMNS = 50 MM.
5. THE NET SOIL BEARING CAPACITY CONSIDERED IN FOUNDATION DESIGN IS 250 KPA(REFER DOC.216-3000-EG-CV-CAL-1008-A02).
6. WATER PROOFING INSULATION SHALL BE AS PER PROJECT SPECIFICATION AND ITS MATERIAL TO BE APPROVED BY ENGINEER AT SITE.
7. FOR STANDARD REINFORCEMENT DETAIL & GENERAL NOTES FOR CIVIL WORKS REFER DRAWING NO. MD-216-1000-EG-CV-DED-1005 &1001.

DOCUMENT NUMBER	REFERENCE DOCUMENTS	REV	DATE	REVISION DESCRIPTION	DRN	CHK	ENG	APP	EMP
MD-216-3000-EG-CV-GAD-1686	DEMARCATION FENCE LAYOUT								
MD-216-3750-EG-CV-GAD-1311	LAYOUT & DETAILS OF CYANIDE EVENT POND								
		D01	16/03/2023	AS-BUILT	AMJ	SJM	AVG	AG	
		C02	17/03/2022	ISSUED FOR CONSTRUCTION AND REVISED AS MKD. △A	AMJ	SJM	AVG	AG	
		C01	17/09/2021	ISSUED FOR CONSTRUCTION AND REVISED AS PER EMPLOYER COMMENTS ON 01/09/2021 AND REVISED AS MARKED △A	PML	SJM	AVG	AG	
		A01	27/07/2021	ISSUED FOR REVIEW	PML	SJM	AVG	AG	

RESERVED FOR VENDOR LOGO AND DRAWING NUMBER

LARSEN & TOUBRO

This drawing is the property of LARSEN & TOUBRO and must not be passed on to any person or body not authorized by us to receive it nor be copied or otherwise made use either in full or in part by such person or body without our prior permission in writing.

Outotec

The content of these documents are the sole property of Outotec Oyj. Any rights not expressly granted herein are reserved. Reproduction, transfer or distribution of part or all of the contents in any form without prior written permission of Outotec is prohibited.

MA'ADEN معادن
Saudi Arabian Mining Company شركة المعادن العربية السعودية

This document and the information contained herein is Ma'aden proprietary know-how. This document or any part thereof should not be reproduced, stored in a retrieval system or transmitted by any means, electronic or otherwise, or divulged without prior written permission of Ma'aden.

LARSEN & TOUBRO DRAWING NUMBER			REVISION
019045_450_C_G_24699_001			3
OUTOTEC DRAWING NUMBER		DOCUMENT ID	REVISION
900707__GAU01__AG03__MTL01__37511		OU100728682	3
DRAWN	PML	20/07/2021	MANSOURAH - MASSARAH GOLD PROJECT
CHECKED	SJM	22/07/2021	GENERAL ARRANGEMENT DRAWING
ENGINEER	AVG	20/07/2021	CYANIDE EVENT POND
APPROVED	AG	23/07/2021	LAYOUT & DETAILS OF PIPE SUPPORTS
EMPLOYER			
SCALE 1:100, 1:50, 1:25, 1:20	A0	DRAWING NUMBER: MD - 216 - 3750 - EG - CV - GAD - 1312	REV: D01