


DRAWING NUMBER: MD-216-3810-EG-CV-DED-1401 | REV: D01

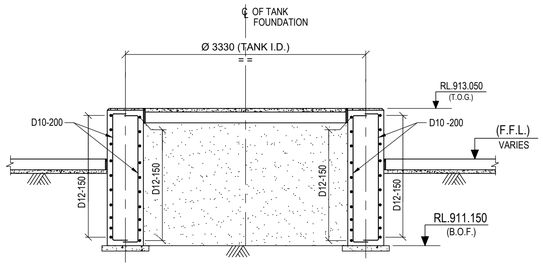


SECTION : A-A
SCALE 1:40

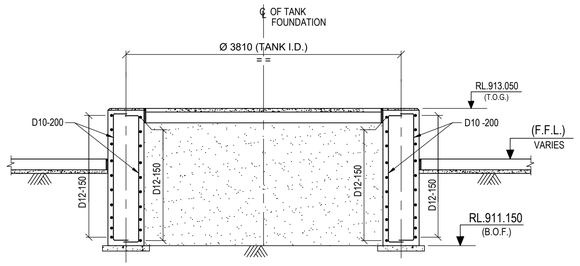


SECTION : B-B
SCALE 1:40

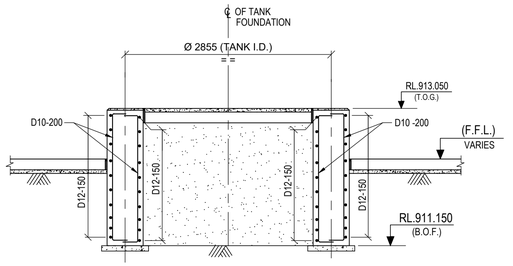


SECTION : C-C
SCALE 1:40

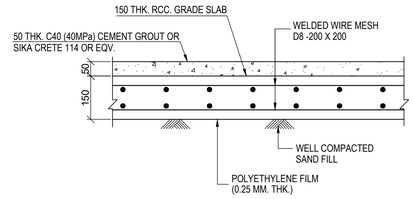


TYP. DET. OF 150 THK. GRADE SLAB
SCALE 1:10

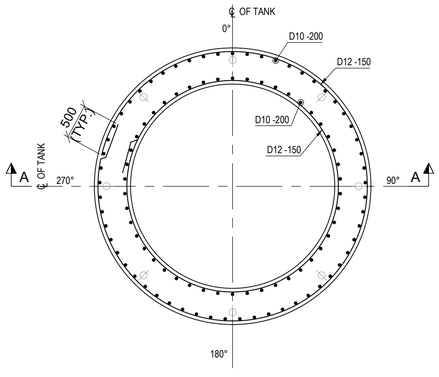

RCC. DETAIL OF TANK FOUNDATION MKD. F1
(FOR 3810-REA-001)
SCALE 1:40

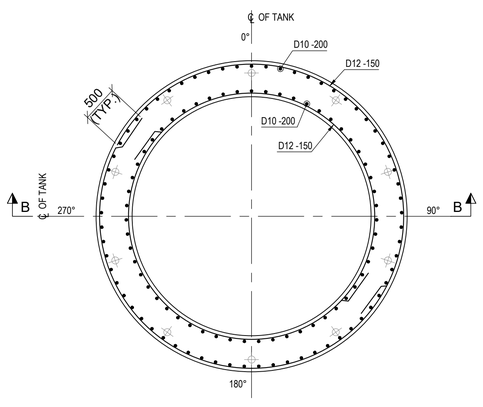

RCC. DETAIL OF TANK FOUNDATION MKD. F2
(FOR 3810-TNK-002)
SCALE 1:40

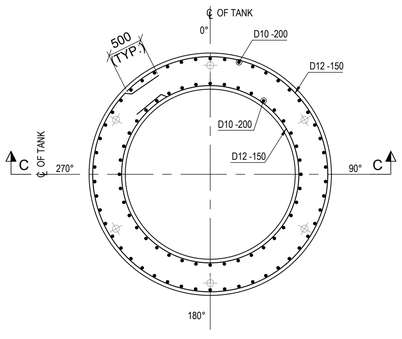

RCC. DETAIL OF TANK FOUNDATION MKD. F3
(FOR 3810-TNK-001)
SCALE 1:40

LEGEND :-
R.L. - REDUCED LEVEL
℄ - CENTRE LINE
T.O.C. - TOP OF CONCRETE
F.G.L. - FINISHED GROUND LEVEL
F.F.L. - FINISHED FLOOR LEVEL
B.O.F. - BOTTOM OF FOUNDATION
TYP. - TYPICAL
R.C.C - REINFORCED CEMENT CONCRETE
P.C.C - PLAIN CEMENT CONCRETE
MKD. - MARKED
I.D. - INTERNAL DIAMETER
THK. - THICK
T.O.G. - TOP OF GROUT
EQV. - EQUIVALENT
DET. - DETAIL
FDN. - FOUNDATION
Ø - DIAMETER

NOTES:-
1. ALL DIMENSIONS ARE IN MILLIMETRES AND LEVELS AND CO-ORDINATES ARE IN METRES UNLESS OTHERWISE STATED.
2. GRADE OF CONCRETE SHALL BE C35 (35MPa) FOR FOUNDATION, C30 (30MPa) FOR GRADE SLAB & C15 (15MPa) FOR BLINDING CONCRETE.
3. GRADE OF REINFORCEMENT SHALL BE DEFORMED BAR 420 MPa (GRADE 60) - ASTM A615/A615M.
4. GRADE OF WELDED WIRE MESH SHALL BE GRADE 60 (fy = 420 MPa) ACCORDING TO A1064.
5. NET SAFE BEARING CAPACITY OF SOIL AT BOTTOM OF FOUNDATION IS CONSIDERED AS 350KN/ SQ. M.
6. CLEAR COVER TO REINFORCEMENT SHALL BE AS FOLLOWS
   a) FOUNDATION = 50 mm
   b) WALLS = 50mm
   c) SLAB = 20mm
7. FOR STANDARD REINFORCEMENT DETAIL & GENERAL NOTES FOR CIVIL WORKS REFER DRAWING NO. MD-216-1000-EG-CV-DED-1005 & 1001.

DOCUMENT NUMBER	REFERENCE DOCUMENTS	REV	DATE	REVISION DESCRIPTION	DRN	CHK	ENG	APP	EMP
MD-216-3810-EG-CV-GAD-1400	REAGENTS - CAUSTIC SODA AND CYANIDE EQUIPMENT								
	LAYOUT & DETAILS OF TANK FOUNDATION								
MD-216-3810-EG-ME-GAD-1011	REAGENTS - CAUSTIC AND CYANIDE								
	PLAN VIEW	D01	13/03/2023	AS-BUILT	PML	SJM	SOR	AG	
MD-216-3810-EG-ME-GAD-1002	REAGENTS - CAUSTIC AND CYANIDE	C02	21/09/2020	ISSUED FOR CONSTRUCTION & REVISED AS MARKED △C02	PML	SJM	SOR	AG	
	SECTION A-A & B-B	C01	08/07/2020	ISSUED FOR CONSTRUCTION & REVISED AS PER EMPLOYER					
MD-216-3810-EG-ME-GAD-1001	REAGENTS - CAUSTIC AND CYANIDE			COMMENTS ON 03/07/2020	PML	SJM	SOR	AG	
	PLAN VIEW	A01	05/06/2020	ISSUED FOR REFERENCE	PML	SJM	SOR	AG	

RESERVED FOR VENDOR LOGO AND DRAWING NUMBER

LARSEN & TOUBRO

This drawing is the property of *LARSEN & TOUBRO* and must not be passed on to any person or body not authorized by us to receive it nor be copied or otherwise made use either in full or in part by such person or body without our prior permission in writing.

Outotec

The content of these documents are the sole property of Outotec Oyj. Any rights not expressly granted herein are reserved. Reproduction, transfer or distribution of part or all of the contents in any form without prior written permission of Outotec is prohibited.

MA'ADEN معادن
Saudi Arabian Mining Company شركة معادن العربية السعودية

This document and the information contained herein is Ma'aden proprietary know-how. This document or any part thereof should not be reproduced, stored in a retrieval system or transmitted by any means, electronic or otherwise, or divulged without prior written permission of Ma'aden.

LARSEN & TOUBRO DRAWING NUMBER			REVISION
019045_450_C_D_24153_001			3
OUTOTEC DRAWING NUMBER		DOCUMENT ID	REVISION
900707 __GAU01 __AA24__CTB17 __38101		OU100687810	3
DRAWN	PML	01/06/2020	MANSOURAH - MASSARAH GOLD PROJECT
CHECKED	SJM	02/06/2020	DETAIL DRAWING
ENGINEER	SOR	01/06/2020	REAGENTS - CAUSTIC SODA AND CYANIDE EQUIPMENT
APPROVED	AG	05/06/2020	RCC DETAILS OF TANK FOUNDATION
EMPLOYER			
SCALE 1:75, 1:50, 1;20	A1		DRAWING NUMBER: MD-216-3810-EG-CV-DED-1401 / REV: D01