

DRAWING NUMBER MD - 216 - 3810 - EG - CV - DED - 2001 REV D01

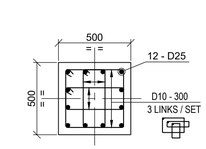


RC DETAIL OF COLUMN MKD. C1 & C3

(C1 - 4 NOS. REQUIRED)
(C3 - 6 NOS. REQUIRED)
(SCALE- 1:20)

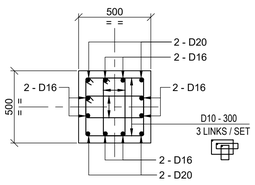


RC DETAIL OF COLUMN MKD. C2

(C2 - 6 NOS. REQUIRED)
(SCALE- 1:20)

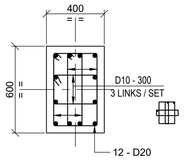


RC DETAIL OF COLUMN MKD. C4

(C4 - 4 NOS. REQUIRED)
(SCALE- 1:20)

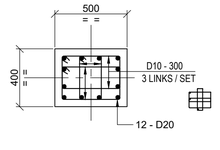


RC DETAIL OF COLUMN MKD. C5 & C7

(C5 - 6 NOS. REQUIRED)
(C7 - 4 NOS. REQUIRED)
(SCALE- 1:20)

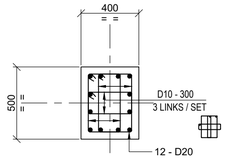


RC DETAIL OF COLUMN MKD. C6

(C6 - 5 NOS. REQUIRED)
(SCALE- 1:20)

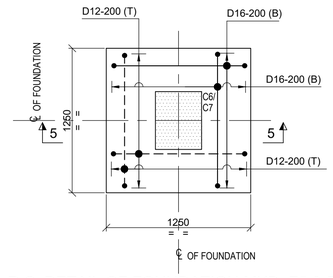


R.C. DETAIL OF FOUNDATION MKD. F5 & F8

(F5 - 1 NO. REQUIRED)
(F8 - 4 NOS. REQUIRED)
(SCALE - 1:25)

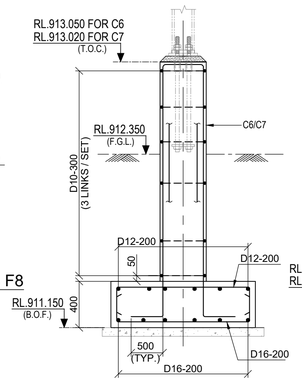


SECTION 5-5

(SCALE - 1:25)

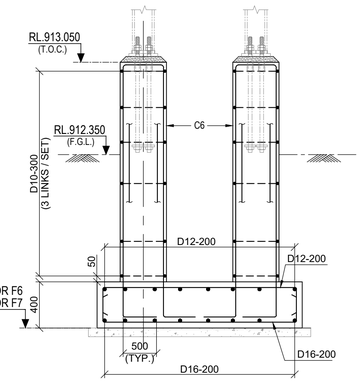


SECTION 6-6

(SCALE - 1:25)

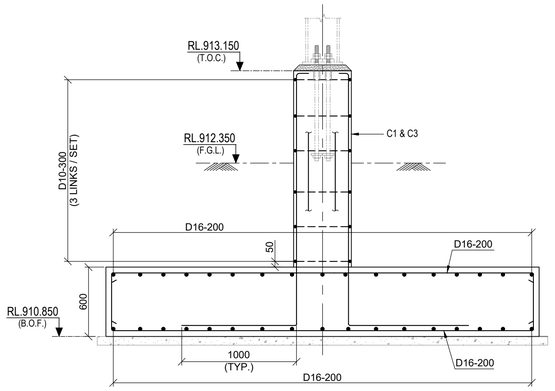


SECTION 1-1

(SCALE - 1:25)

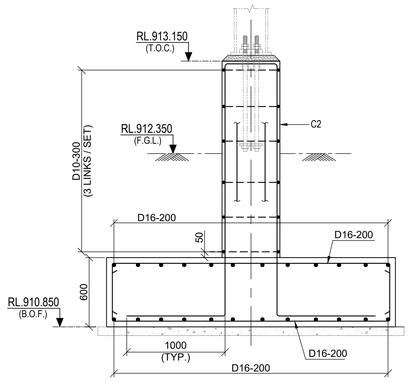


SECTION 2-2

(SCALE - 1:25)

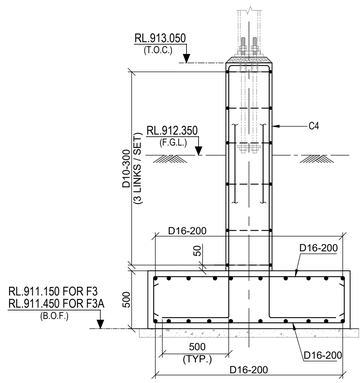


SECTION 3-3

(SCALE - 1:25)

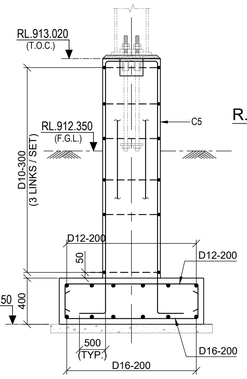


SECTION 4-4

(SCALE - 1:25)

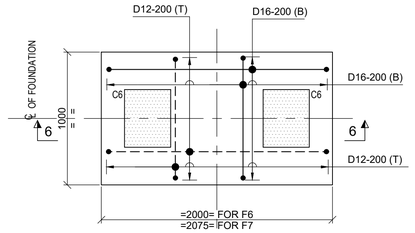


R.C. DETAIL OF FOUNDATION MKD. F6 & F7

(1+1 NOS. REQUIRED)
(SCALE - 1:25)

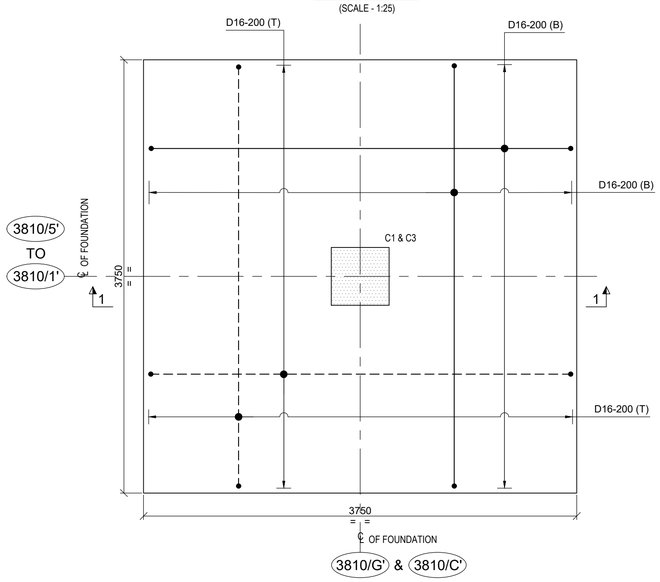


R.C. DETAIL OF FOUNDATION MKD. F1

(10 NOS. REQUIRED)
(SCALE - 1:25)

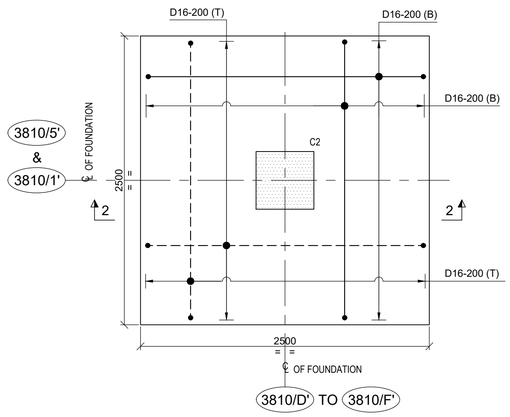


R.C. DETAIL OF FOUNDATION MKD. F2

(6 NOS. REQUIRED)
(SCALE - 1:25)

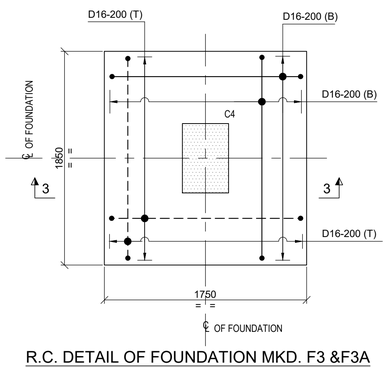

R.C. DETAIL OF FOUNDATION MKD. F3 &F3A

(2+2 NOS. REQUIRED)
(SCALE - 1:25)

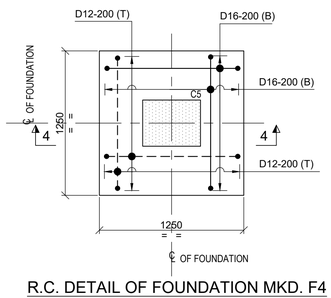

R.C. DETAIL OF FOUNDATION MKD. F4

(6 NOS. REQUIRED)
(SCALE - 1:25)

LEGEND :-

R.L. - REDUCED LEVEL
T.O.C. - TOP OF CONCRETE.
F.G.L. - FINISHED GROUND LEVEL.
TYP. - TYPICAL.
P.C.C - PLAIN CEMENT CONCRETE
BOTTOM REINFORCEMENT (B) - ————
TOP REINFORCEMENT (T) - – – – – –
MKD. - MARKED
℄ - CENTRE LINE
B.O.F. - BOTTOM OF FOUNDATION
THK. - THICK
FDN. - FOUNDATION
RC - REINFORCED CONCRETE

NOTES :-

1. ALL DIMENSIONS ARE IN MILLIMETRES AND LEVELS AND CO-ORDINATES ARE IN METRES. UNLESS OTHERWISE STATED.
2. GRADE OF CONCRETE SHALL BE C35 (35MPa) FOR FOUNDATION & COLUMN.
3. GRADE OF REINFORCEMENT SHALL BE DEFORMED BAR ASTM A615 - GRADE 60 (fy = 420 MPa).
4. NET SAFE BEARING CAPACITY OF SOIL AT BOTTOM OF FOUNDATION IS CONSIDERED AS 350KN/SQ.M.
5. CLEAR COVER TO MAIN REINFORCEMENT SHALL BE AS
   a) FOUNDATION = 50 mm (BOTTOM & SIDE) 50 mm. (TOP)
   b) COLUMN = 50mm
6. IF ANY PART OF FOUNDATION COMES ON BACKFILL ZONE OF ADJACENT FOUNDATION OR ANY LOOSE SOIL ARE ENCOUNTERED BELOW FOUNDATION LEVEL THE SAME SHALL BE REMOVED AND FILLED WITH PCC.
7. FOR STANDARD REINFORCEMENT DETAIL & GENERAL NOTES FOR CIVIL WORKS REFER DRAWING NO. MD-216-1000-EG-CV-DED-1005 &1001.

DOCUMENT NUMBER	REFERENCE DOCUMENTS			REVISION DESCRIPTION	DRN	CHK	ENG	APP	EMP
MD-216-3810-EG-CV-GAD-2001	REAGENTS - CAUSTIC SODA & CYANIDE MIXING STATION	D01	13/03/2023	AS-BUILT	SYA	SJM	SOR	AG	
	GA & DETAILS OF FOUNDATION	C02	30/10/2020	ISSUED FOR CONSTRUCTION & REVISED AS MARKED C02	SYA	SJM	SOR	AG	
MD-216-3810-EG-ST-GAD-2343	CAUSTIC & CYAN. STORG. & MIXING STN.	C01	20/08/2020	ISSUED FOR CONSTRUCTION	AMJ	SJM	SOR	AG	
	ANCHOR BOLT PLAN AND DETAILS	A01	20/07/2020	ISSUED FOR REFERENCE	AMJ	SJM	SOR	AG	

RESERVED FOR VENDOR LOGO AND DRAWING NUMBER

LARSEN & TOUBRO

This drawing is the property of LARSEN & TOUBRO and must not be passed on to any person or body not authorized by us to receive it nor be copied or otherwise made use either in full or in part by such person or body without our prior permission in writing.

Outotec

The content of these documents are the sole property of Outotec Oyj. Any rights not expressly granted herein are reserved. Reproduction, transfer or distribution of part or all of the contents in any form without prior written permission of Outotec is prohibited.

MA'ADEN معادن
Saudi Arabian Mining Company شركة معادن العربية السعودية

This document and the information contained herein is Ma'aden proprietary know-how. This document or any part thereof should not be reproduced, stored in a retrieval system or transmitted by any means, electronic or otherwise, or divulged without prior written permission of Ma'aden.

LARSEN & TOUBRO DRAWING NUMBER	O19045_450_C_D_24408_001	REVISION 3
OUTOTEC DRAWING NUMBER	900707__GAU01__AA24__CTB17__38102	DOCUMENT ID OU100690672 / REVISION 3

DRAWN	AMJ	16/07/2020
CHECKED	SJM	17/07/2020
ENGINEER	SOR	07/07/2020
APPROVED	AG	20/07/2020
EMPLOYER		
SCALE	1:75, 1:25 & 1:15	A1

MANSOURAH - MASSARAH GOLD PROJECT
DETAIL DRAWING
REAGENTS-CAUSTIC SODA & CYANIDE MIXING STATION
RCC DETAILS OF FOUNDATION

DRAWING NUMBER MD - 216 - 3810 - EG - CV - DED - 2001 REV D01