


DRAWING NUMBER MD-216-3810-EG-CV-GAD-1400 REV D01

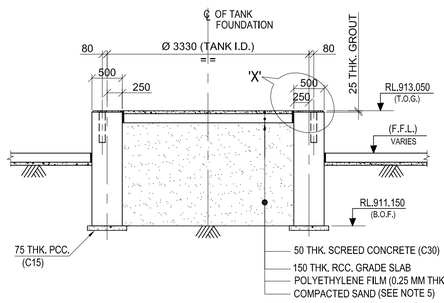


SECTION : A-A
SCALE 1:50

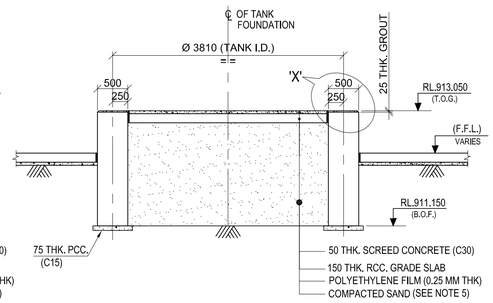


SECTION : B-B
SCALE 1:50

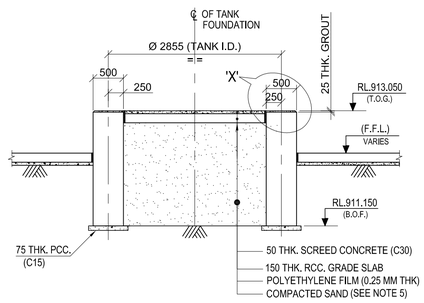


SECTION : C-C
SCALE 1:50

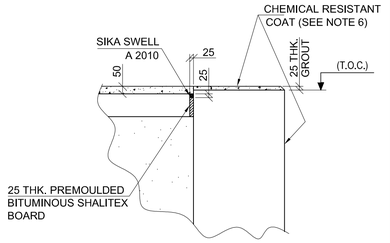


DETAIL - 'X'
SCALE 1:20

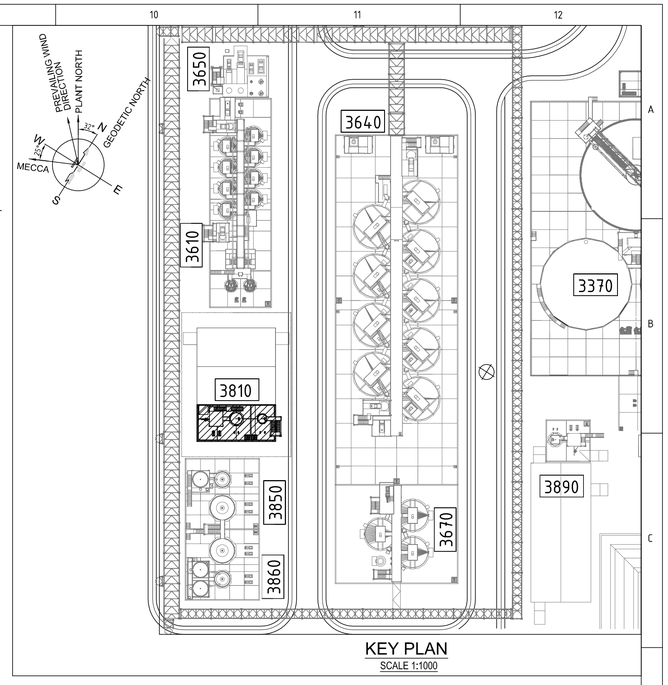


KEY PLAN
SCALE 1:1000

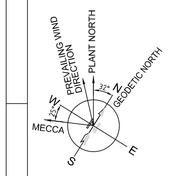


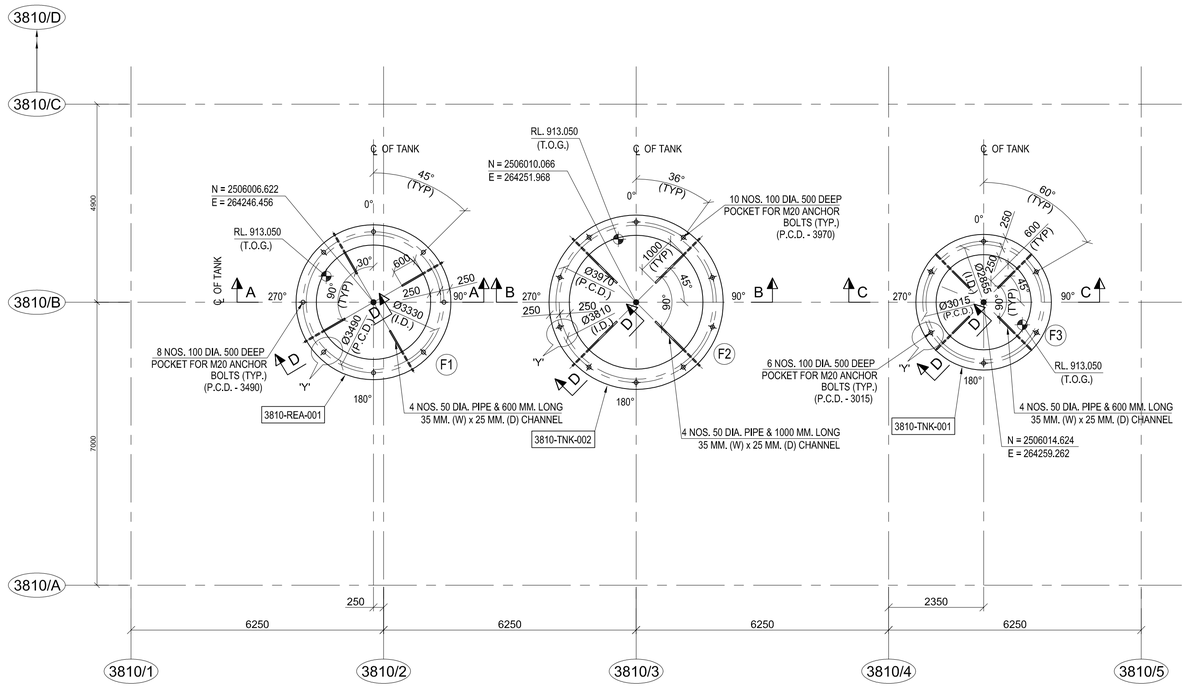


LAYOUT OF FOUNDATION
SCALE 1:75

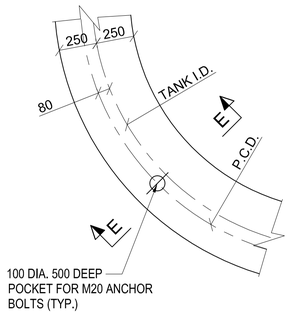

DETAIL : 'Y'
SCALE 1:25

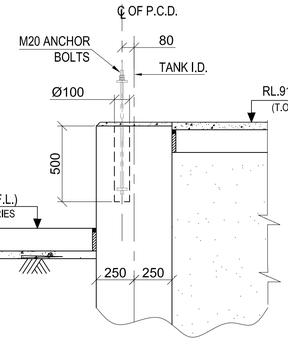

SECTION : E-E
SCALE 1:25

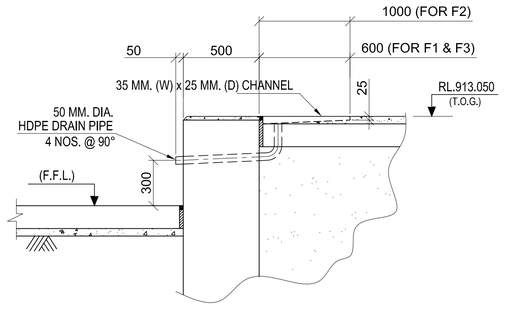

SECTION : D-D
SCALE 1:25

LEGEND :-

R.L. - REDUCED LEVEL
℄ - CENTRE LINE
T.O.C. - TOP OF CONCRETE
TYP. - TYPICAL
I.D. - INTERNAL DIAMETER
T.O.G. - TOP OF GROUT
B.O.F. - BOTTOM OF FOUNDATION
F.G.L. - FINISHED GROUND LEVEL.
EQV. - EQUIVALENT
F.F.L. - FINISHED FLOOR LEVEL
P.C.C - PLAIN CEMENT CONCRETE
DET. - DETAIL
FDN. - FOUNDATION
DIA. - DIAMETER
THK. - THICK
C/C - CENTRE TO CENTRE
R.C.C - REINFORCED CEMENT CONCRETE
P.C.D. - PITCH CIRCLE DIAMETER
MKD. - MARKED
Ø - DIAMETER
W - WIDTH
D - DEPTH

NOTES:-

1. ALL DIMENSIONS ARE IN MILLIMETRES AND LEVELS AND CO-ORDINATES ARE IN METRES UNLESS OTHERWISE STATED.
2. GRADE OF CONCRETE SHALL BE C35 (35MPa) FOR FOUNDATION, C30 C30 (30MPa) FOR GRADE SLAB & C15 (15MPa) FOR BLINDING CONCRETE.
3. NET SAFE BEARING CAPACITY OF SOIL AT BOTTOM OF FOUNDATION CONSIDER 350KN/ SQ. M
4. IF ANY PART OF FOUNDATION COMES ON BACKFILL ZONE OF ADJACENT FOUNDATION OR ANY LOOSE SOIL ARE ENCOUNTERED BELOW FOUNDATION LEVEL THE SAME SHALL BE REMOVED AND FILLED WITH PCC.
5. SAND SHALL BE COMPACTED TO A MAXIMUM DEPTH OF 300MM AND SHALL BE COMPACTED TO 80% RELATIVE DENSITY AS DETERMINED BY ASTM D4253 AND ASTM D4254.
6. CHEMICAL RESISTANT COATING SHALL BE APPLIED FOR PROTECTING CONCRETE AGAINST CYANIDE, ACID AND ALKALI.

DOCUMENT NUMBER	REFERENCE DOCUMENTS	REV	DATE	REVISION DESCRIPTION	DRN	CHK	ENG	APP	EMP
MD-216-3810-EG-CV-DED-1401	REAGENTS - CAUSTIC SODA AND CYANIDE EQUIPMENT								
	RCC DETAILS OF TANK FOUNDATION								
MD-216-3810-EG-ME-GAD-1011	REAGENTS - CAUSTIC AND CYANIDE								
	PLAN VIEW	D01	21/7/2023	AS BUILT	PML	SJM	SOR	AG	
MD-216-3810-EG-ME-GAD-1002	REAGENTS - CAUSTIC AND CYANIDE	C02	21/09/2020	ISSUED FOR CONSTRUCTION & REVISED AS MARKED △C02	PML	SJM	SOR	AG	
	SECTION A-A & B-B	C01	08/07/2020	ISSUED FOR CONSTRUCTION & REVISED AS PER EMPLOYER					
MD-216-3810-EG-ME-GAD-1001	REAGENTS - CAUSTIC AND CYANIDE			COMMENTS ON 03/07/2020	PML	SJM	SOR	AG	
	PLAN VIEW	A01	05/06/2020	ISSUED FOR REFERENCE	PML	SJM	SOR	AG	

RESERVED FOR VENDOR LOGO AND DRAWING NUMBER

LARSEN & TOUBRO
This drawing is the property of LARSEN & TOUBRO and must not be passed on to any person or body not authorized by us to receive it nor be copied or otherwise made use either in full or in part by such person or body without our prior permission in writing.

Outotec
The content of these documents are the sole property of Outotec Oyj. Any rights not expressly granted herein are reserved. Reproduction, transfer or distribution of part or all of the contents in any form without prior written permission of Outotec is prohibited.

MA'ADEN معادن
Saudi Arabian Mining Company شركة معادن العربية السعودية
This document and the information contained herein is Ma'aden proprietary know-how. This document or any part thereof should not be reproduced, stored in a retrieval system or transmitted by any means, electronic or otherwise, or divulged without prior written permission of Ma'aden.

LARSEN & TOUBRO DRAWING NUMBER	019045_450_C_G_24152_001		REVISION 3
OUTOTEC DRAWING NUMBER	900707 __GAU01 __AA24__MTL01 __38105	DOCUMENT ID OU100687741	REVISION 3

DRAWN	PML	01/06/2020
CHECKED	SJM	02/06/2020
ENGINEER	SOR	01/06/2020
APPROVED	AG	05/06/2020
EMPLOYER		

MANSOURAH - MASSARAH GOLD PROJECT
GENERAL ARRANGEMENT DRAWING
REAGENTS - CAUSTIC SODA AND CYANIDE EQUIPMENT
LAYOUT & DETAILS OF TANK FOUNDATION

SCALE 1:75, 1:50, 1:20 | A1

DRAWING NUMBER MD-216-3810-EG-CV-GAD-1400 | REV D01