


DRAWING NUMBER: MD-216-3810-EG-CV-GAD-2001 REV D01

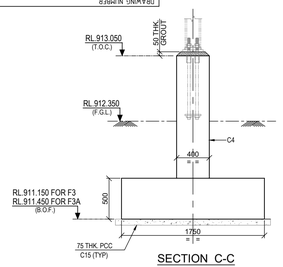


SECTION C-C
(SCALE - 1:25)

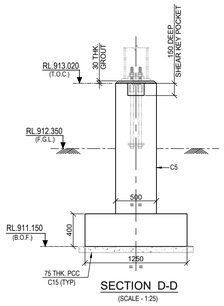


SECTION D-D
(SCALE - 1:25)

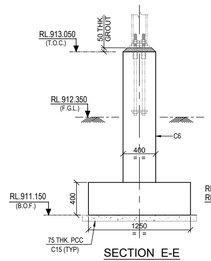


SECTION E-E
(SCALE - 1:25)

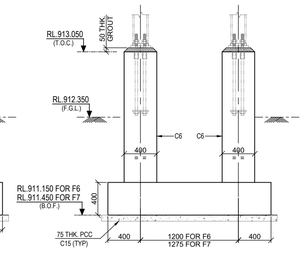

SECTION F-F
(SCALE - 1:25)

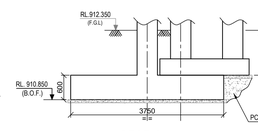


SECTION : A'-A'
(TYP. ARRANGEMENT FOR OVERLAPPING FOUNDATIONS)
SCALE 1:50

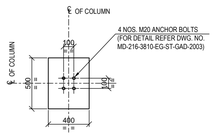


TYP. DETAIL OF COLUMN MKD. C6
(SCALE- 1:20)


TYP. DETAIL OF COLUMN MKD. C4
(SCALE- 1:20)

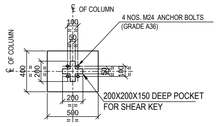


TYP. DETAIL OF COLUMN MKD. C5
(SCALE- 1:20)

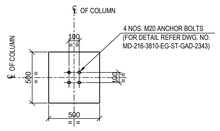


TYP. DETAIL OF COLUMN MKD. C1 & C2
(SCALE- 1:20)

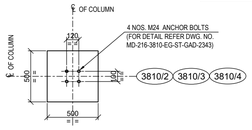


TYP. DETAIL OF COLUMN MKD. C3
(SCALE- 1:20)

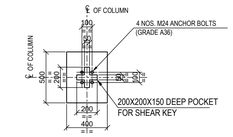


TYP. DETAIL OF COLUMN MKD. C7
(SCALE- 1:20)

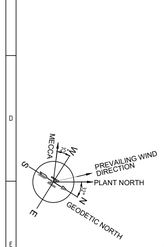


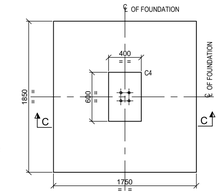


DETAIL OF FOUNDATION MKD. F3 & F3A
(SCALE - 1:25)

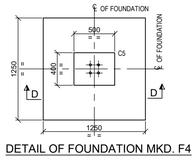


DETAIL OF FOUNDATION MKD. F4
(SCALE - 1:25)

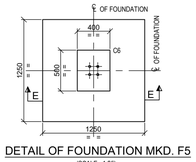


DETAIL OF FOUNDATION MKD. F5
(SCALE - 1:25)

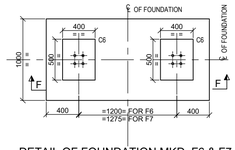


DETAIL OF FOUNDATION MKD. F6 & F7
(SCALE - 1:25)

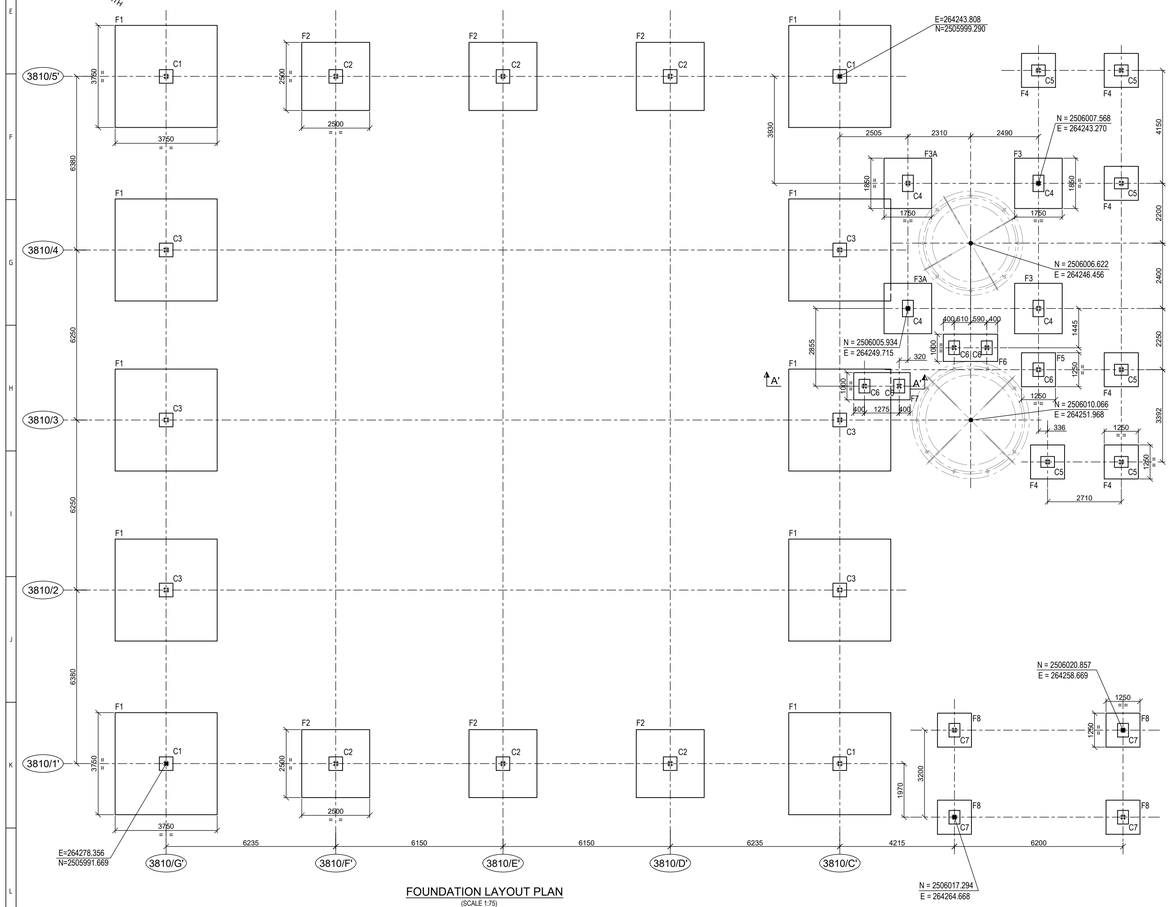


FOUNDATION LAYOUT PLAN
(SCALE 1:75)

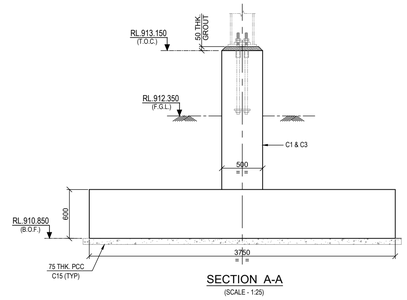


SECTION A-A
(SCALE - 1:25)

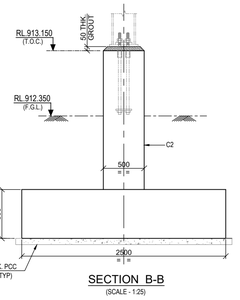


SECTION B-B
(SCALE - 1:25)

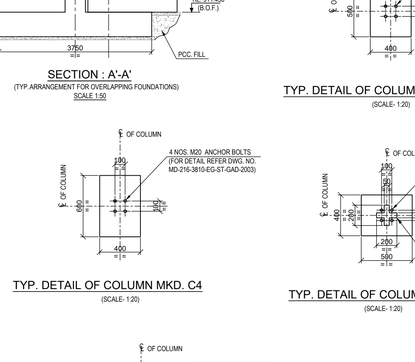

DETAIL OF FOUNDATION MKD. F1
(SCALE - 1:25)

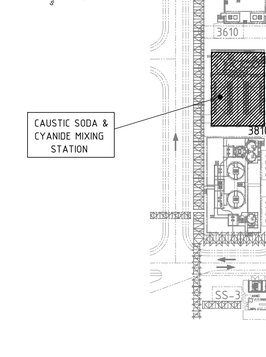


DETAIL OF FOUNDATION MKD. F2
(SCALE - 1:25)

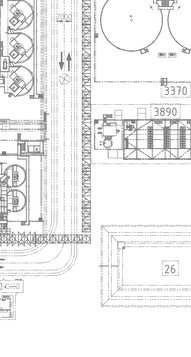

DETAIL OF FOUNDATION MKD. F8
(SCALE - 1:25)

KEY PLAN
(SCALE 1:1000)

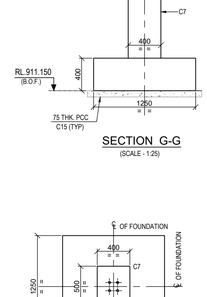

SECTION G-G
(SCALE - 1:25)

LEGEND :-

RL - REDUCED LEVEL
T.O.C. - TOP OF CONCRETE
F.G.L. - FINISHED GROUND LEVEL
TYP. - TYPICAL
P.C.C. - PLAIN CEMENT CONCRETE
℄ - CENTRE LINE
MKD. - MARKED
B.O.F. - BOTTOM OF FOUNDATION
THK. - THICK
FDN. - FOUNDATION
DIA - DIAMETER
DWG. - DRAWING
C/C- CENTRE TO CENTRE

NOTES :-

1. ALL DIMENSIONS ARE IN MILLIMETRES AND LEVELS AND CO-ORDINATES ARE IN METRES. UNLESS OTHERWISE STATED.
2. GRADE OF CONCRETE SHALL BE C35 (35MPa) FOR FOUNDATION & COLUMN.
3. GRADE OF REINFORCEMENT SHALL BE DEFORMED BAR ASTM A615 - GRADE 60 (fy = 420 MPa).
4. NET SAFE BEARING CAPACITY OF SOIL AT BOTTOM OF FOUNDATION IS CONSIDERED AS 350KN/SQ.M.
5. IF ANY PART OF FOUNDATION COMES ON BACKFILL ZONE OF ADJACENT FOUNDATION OR ANY LOOSE SOIL ARE ENCOUNTERED BELOW FOUNDATION LEVEL THE SAME SHALL BE REMOVED AND FILLED WITH PCC.
6. FOR DETAILS OF ANCHOR BOLTS REFER DRAWING NO. MD-216-3810-EG-ST-GAD-2343.
7. FOR STANDARD REINFORCEMENT DETAIL & GENERAL NOTES FOR CIVIL WORKS REFER DRAWING NO. MD-216-1000-EG-CV-DED-1005 &1001.

DOCUMENT NUMBER	REFERENCE DOCUMENTS	REV	DATE	REVISION DESCRIPTION	DRN	CHK	ENG	APP	EMP
MD-216-3810-EG-ST-GAD-2003	CAUSTIC & CYN STORAGE & MIXING STN.	D01	13/03/2023	AS-BUILT	SYA	SJM	SOR	AG	
MD-216-3810-EG-ST-GAD-2353	CYN REAGENT AREA ON GRND. PLTF & STAIR TOWER	C03	30/12/2020	ISSUED FOR CONSTRUCTION & REVISED AS MARKED 03	SYA	SJM	SOR	AG	
MD-216-3810-EG-ST-GAD-2352	CYN REAGENT AREA ON GRND. PLTF & STAIR TOWER	C02	30/10/2020	ISSUED FOR CONSTRUCTION & REVISED AS MARKED 02	SYA	SJM	SOR	AG	
MD-216-3810-EG-ST-GAD-2343	CAUSTIC & CYAN. STORG & MIXING STN.	C01	20/08/2020	ISSUED FOR CONSTRUCTION	AMJ	SJM	SOR	AG	
	ANCHOR BOLT PLAN AND DETAILS	A01	20/07/2020	ISSUED FOR REFERENCE	AMJ	SJM	SOR	AG	

RESERVED FOR VENDOR LOGO AND DRAWING NUMBER

LARSEN & TOUBRO

This drawing is the property of LARSEN & TOUBRO and must not be passed on to any person or body not authorized by us to receive it nor be copied or otherwise made use either in full or in part by such person or body without our prior permission in writing.

Outotec

The content of these documents are the sole property of Outotec Oyj. Any rights not expressly granted herein are reserved. Reproduction, transfer or distribution of part or all of the contents in any form without prior written permission of Outotec is prohibited.

MA'ADEN معادن Saudi Arabian Mining Company شركة معادن السعودية

This document and the information contained herein is Ma'aden proprietary know-how. This document or any part thereof should not be reproduced, stored in a retrieval system or transmitted by any means, electronic or otherwise, or divulged without prior written permission of Ma'aden.

LARSEN & TOUBRO DRAWING NUMBER	019045_450_C_G_24407_001
REVISION	4
OUTOTEC DRAWING NUMBER	900707 _ GAU01 _ AA24_ MTL01 _ 38116
DOCUMENT ID	OU100690671
REVISION	4
DRAWN	AMJ 16/07/2020
CHECKED	SJM 17/07/2020
ENGINEER	SOR 07/07/2020
APPROVED	AG 20/07/2020
EMPLOYER	
SCALE	1:100, 75, 25
	A0

MANSOURAH - MASSARAH GOLD PROJECT
GENERAL ARRANGEMENT DRAWING
REAGENTS - CAUSTIC SODA & CYANIDE MIXING STATION
GA & DETAILS OF FOUNDATION

DRAWING NUMBER: MD - 216 - 3810 - EG - CV - GAD - 2001
REV: D01