


DRAWING NUMBER: MD-216-3810-EG-CV-GAD-2003 REV D01

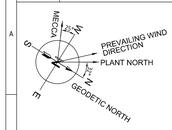

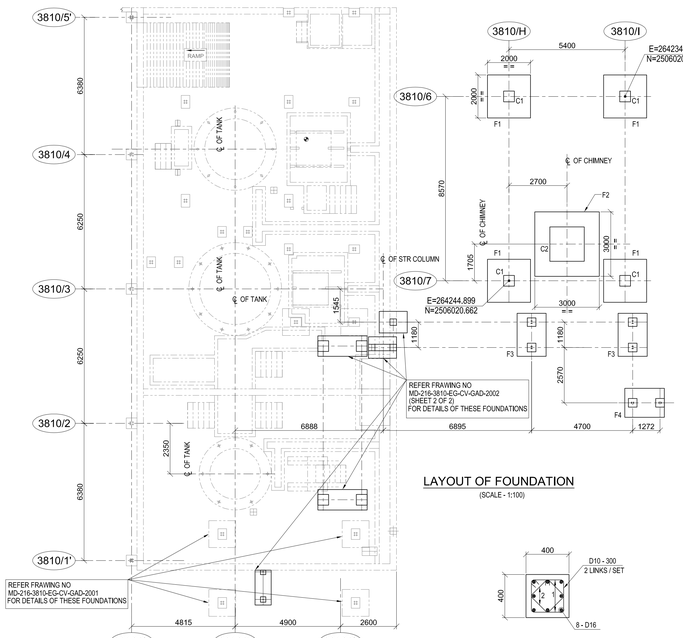


LAYOUT OF FOUNDATION
(SCALE - 1:100)

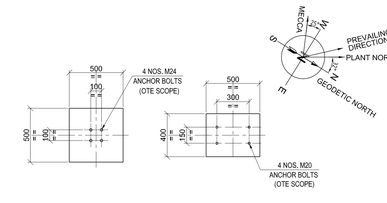


SECTION : A1-A1
SCALE 1:20

SECTION : B1-B1
SCALE 1:20

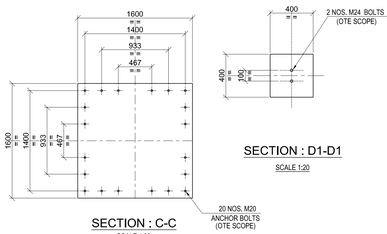


SECTION : D1-D1
SCALE 1:20

SECTION : C-C
SCALE 1:30

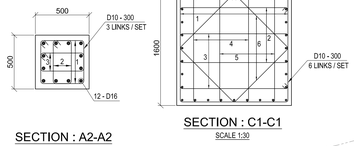


SECTION : A2-A2
SCALE 1:20

SECTION : C1-C1
SCALE 1:30

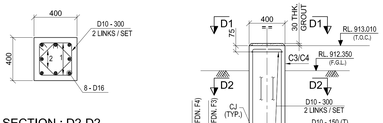


SECTION : D2-D2
SCALE 1:20


SECTION : D-D
SCALE 1:30

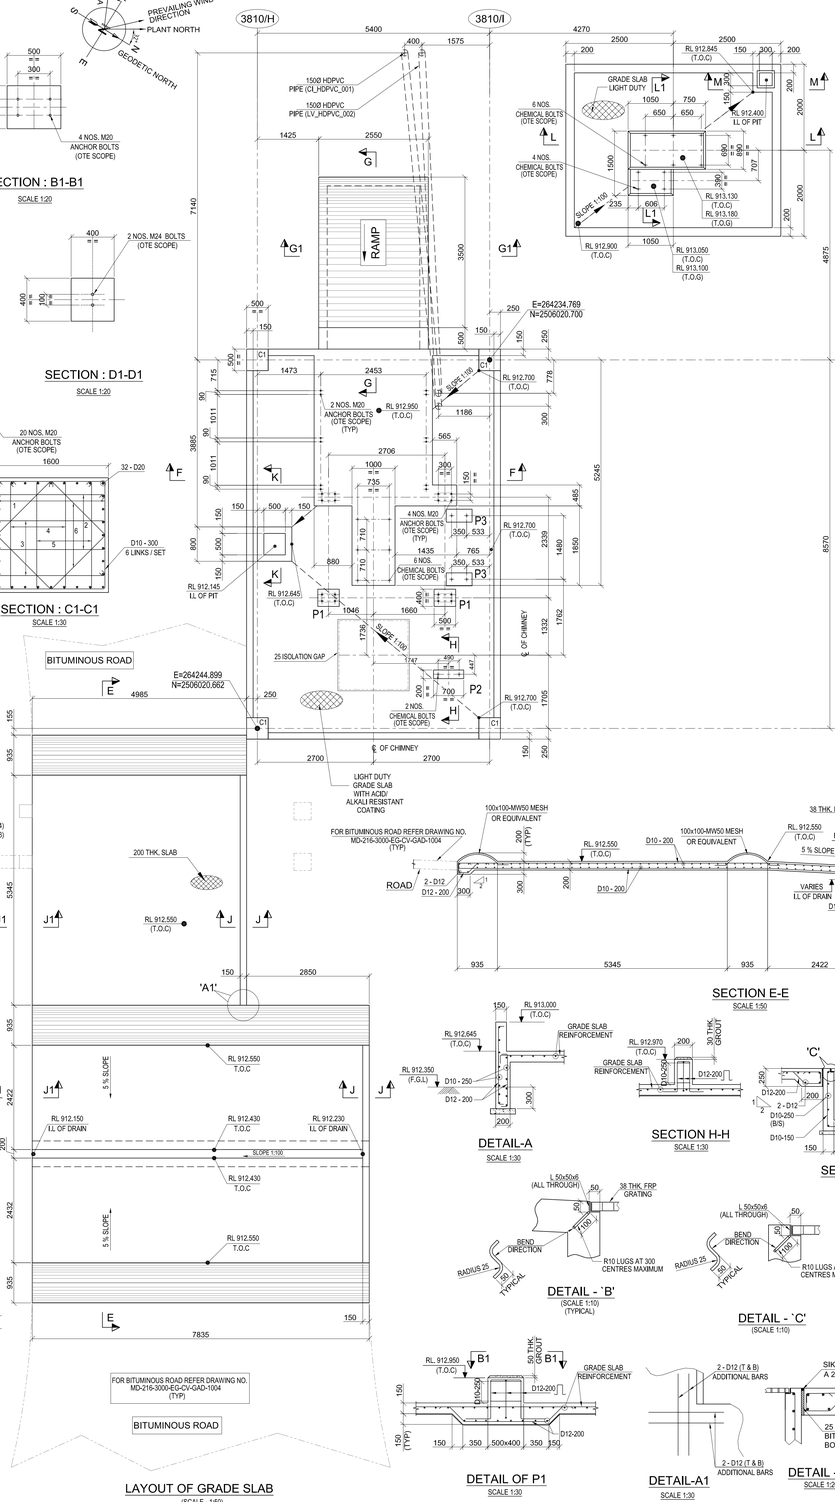

LAYOUT OF GRADE SLAB
(SCALE - 1:50)

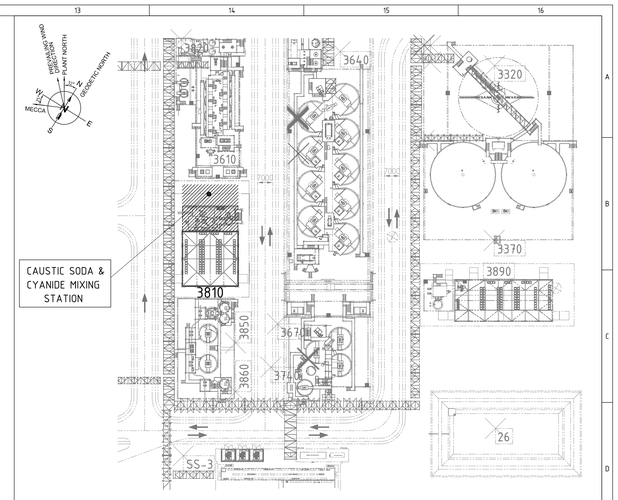


KEY PLAN
(SCALE- 1:750)

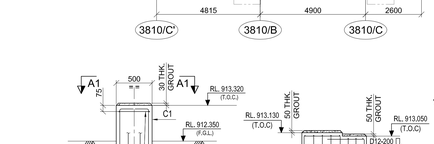


SECTION : A-A
SCALE 1:30


SECTION L1-L1
SCALE 1:50

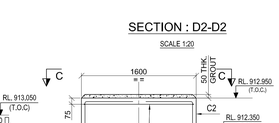


SECTION : B-B
SCALE 1:30

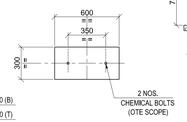


SECTION : B2-B2
SCALE 1:20

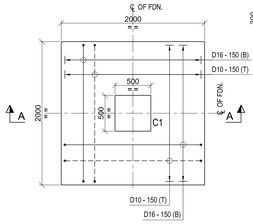


DETAIL OF FOUNDATION MKD. F1
(4 NOS. REQD.)
SCALE 1:30

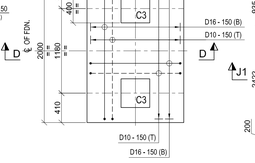


DETAIL OF FOUNDATION MKD. F3
(2 NOS. REQD.)
SCALE 1:30

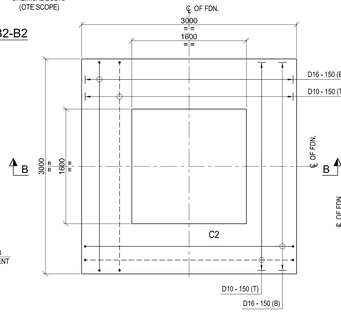

DETAIL OF FOUNDATION MKD. F2
(1 NO. REQD.)
SCALE 1:30

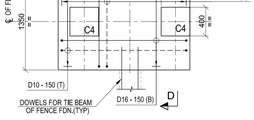

DETAIL OF FOUNDATION MKD. F4
(1 NO. REQD.)
SCALE 1:30

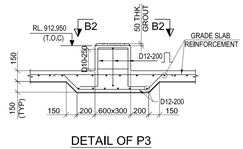


DETAIL OF P3
SCALE 1:30


SECTION E-E
SCALE 1:50

DETAIL-A
SCALE 1:30


SECTION H-H
SCALE 1:30

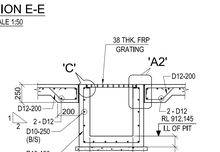

SECTION K-K
SCALE 1:30

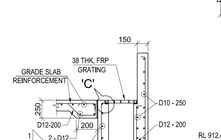


SECTION M-M
SCALE 1:30

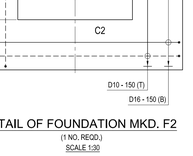

DETAIL OF P1
SCALE 1:30


DETAIL - 'B'
(SCALE 1:10) (TYPICAL)

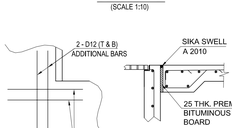

DETAIL - 'C'
(SCALE 1:10)


DETAIL-A1
SCALE 1:30

DETAIL - 'A2'
SCALE 1:20

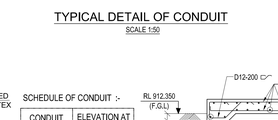


TYPICAL DETAIL OF CONDUIT
SCALE 1:50


SECTION G-G
SCALE 1:50

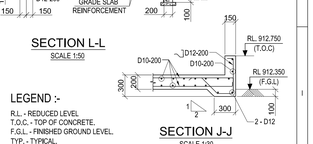

SECTION G1-G1
SCALE 1:50

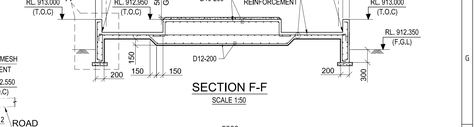

SECTION F-F
SCALE 1:50

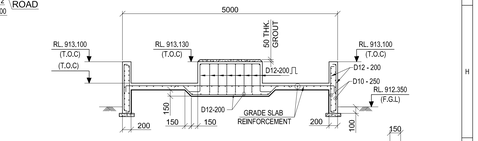

SECTION L-L
SCALE 1:50

SECTION J-J
SCALE 1:30

LEGEND :-
R.L - REDUCED LEVEL
T.O.C - TOP OF CONCRETE
F.G.L - FINISHED GROUND LEVEL
TYP. - TYPICAL
P.C.C - PLAIN CEMENT CONCRETE
BOTTOM REINF.(B) - ———
TOP REINF.(T) - - - - - - -
MKD. - MARKED
℄ - CENTRE LINE
B.O.F. - BOTTOM OF FOUNDATION
THK. - THICK
FDN. - FOUNDATION
RCC - REINFORCED CEMENT CONCRETE
IL - INVERT LEVEL
FDN. - FOUNDATION
CJ - CONSTRUCTION JOINT
T.O.GRADE SLAB - TOP OF GRADE SLAB
Ø - DIAMETER
R - RADIUS
T.O.G. - TOP OF GROUT

NOTES:-
1. ALL DIMENSIONS ARE IN MILLIMETRES AND LEVELS AND CO-ORDINATES ARE IN METRES UNLESS OTHERWISE STATED.
2. FOR DETAILS OF GRADE SLAB REFER DRAWING NO. MD-216-1000-EG-CV-DED-1002.
3. GRADE OF CONCRETE SHALL BE C35 (35MPa) FOR FOUNDATION & COLUMN.
4. GRADE OF REINFORCEMENT SHALL BE DEFORMED BAR ASTM A615 - GRADE 60 (fy = 420 MPa).
5. CLEAR COVER TO MAIN REINFORCEMENT SHALL BE AS
   a) FOUNDATION = 50 mm (BOTTOM & SIDE) 50 mm. (TOP)
   b) COLUMN = 50mm
6. IF ANY PART OF FOUNDATION COMES ON BACKFILL ZONE OF ADJACENT FOUNDATION OR ANY LOOSE SOIL ARE ENCOUNTERED BELOW FOUNDATION LEVEL THE SAME SHALL BE REMOVED AND FILLED WITH PCC.
7. FOR STANDARD REINFORCEMENT DETAIL & GENERAL NOTES FOR CIVIL WORKS REFER DRAWING NO. MD-216-1000-EG-CV-DED-1005 &1001.
8. FOR STANDARD DETAILS FOR PAVING REFER DRAWING NO MD-216-1000-EG-CV-DED-1002

SCHEDULE OF CONDUIT :-

CONDUIT MKD.	ELEVATION AT ℄ OF CONDUIT
CI_HDPVC_001	RL 911.895
LV_HDPVC_002	RL 911.645

DOCUMENT NUMBER	REFERENCE DOCUMENTS	REV	DATE	REVISION DESCRIPTION	DRN	CHK	ENG	APP	EMP
MD-216-3000-EG-CV-GAD-1004	PROCESS PLANT ROADS								
	PLAN & SECTIONS (SHEET 4)								
MD-216-3000-EG-CV-GAD-1004	PROCESS PLANT ROADS								
	PLAN & SECTIONS (SHEET 3)								
MD-216-3000-EG-CV-GAD-1004	PROCESS PLANT ROADS								
	PLAN & SECTIONS (SHEET 2)								
MD-216-3000-EG-CV-GAD-1004	PROCESS PLANT ROADS								
	PLAN & SECTIONS (SHEET 1)								
MD-216-3810-EG-CV-GAD-2002	REAGENTS - CAUSTIC SODA & CYANIDE EQUIPMENT								
	GA & DETAILS OF GRADE SLAB								

DOCUMENT NUMBER	REFERENCE DOCUMENTS	REV	DATE	REVISION DESCRIPTION	DRN	CHK	ENG	APP	EMP
MD-216-3810-EG-CV-GAD-1002	GUIDE DRAWING CAUSTIC SODA AND CYANIDE PLAN AT EL +912.350 AND SECTIONS								
MD-216-3810-EG-ST-GAD-V069-1008	CAUSTIC SODA AND CYANIDE SCC ACCESS PLATFORM								
MD-216-3810-EG-ST-GAD-V069-1007	CAUSTIC SODA AND CYANIDE GANTRY SUPPORT FRAME	D01	21/1/2023	AS BUILT	PML	SJM	SOR	AG	
MD-216-3810-EG-ST-GAD-V069-1006	CAUSTIC SODA AND CYANIDE CHIMNEY ASSEMBLY	C03	14/09/2021	ISSUED FOR CONSTRUCTION AND REVISED AS MARKED (03)	PML	SJM	SOR	AG	
MD-216-3810-EG-ST-GAD-V069-1005	CAUSTIC SODA AND CYANIDE SECONDARY CHAMBER	C02	08/09/2021	ISSUED FOR CONSTRUCTION AND REVISED AS MARKED (02)	PML	SJM	SOR	AG	
MD-216-3810-EG-ST-GAD-V069-1004	CAUSTIC SODA AND CYANIDE PRIMARY CHAMBER	C01	29/05/2021	ISSUED FOR CONSTRUCTION AND REVISED AS PER EMPLOYER COMMENTS ON 26/05/2021 AND REVISED AS MARKED (01)	PML	SJM	SOR	AG	
MD-216-3810-EG-ST-GAD-V069-1003	CAUSTIC SODA AND CYANIDE PLANT GA								
MD-216-3810-EG-ST-GAD-V069-1002	CAUSTIC SODA AND CYANIDE CHIMNEY PLATFORM	A02	26/04/2021	REVISED AS PER EMPLOYER COMMENTS ON 30/03/2021 AND REVISED AS MARKED (02)	PML	SJM	SOR	AG	
MD-216-3810-EG-ST-GAD-V069-1001	CAUSTIC SODA AND CYANIDE GANTRY ASSEMBLY								
		A01	03/03/2021	ISSUED FOR REVIEW	PML	SJM	SOR	AG	

RESERVED FOR VENDOR LOGO AND DRAWING NUMBER

LARSEN & TOUBRO
This drawing is the property of LARSEN & TOUBRO and must not be passed on to any person or body not authorized by us to receive it nor be copied or otherwise made use either in full or in part by such person or body without our prior permission in writing.

Outotec
The content of these documents are the sole property of Outotec Oy. Any rights not expressly granted herein are reserved. Reproduction, transfer or distribution of part or all of the contents in any form without prior written permission of Outotec is prohibited.

MA'ADEN معادن
Saudi Arabian Mining Company شركة المعادن العربية السعودية
This document and the information contained herein is Ma'aden proprietary know-how. This document or any part thereof should not be reproduced, stored in a retrieval system or transmitted by any means, electronic or otherwise, or divulged without prior written permission of Ma'aden.

LARSEN & TOUBRO DRAWING NUMBER	01905_450_C_G_24496_002		REVISION 5
OUTOTEC DRAWING NUMBER	900707 _ GAU01 _ AA24_ MTL01 _ 38129	DOCUMENT ID OU100704670	REVISION 5
DRAWN	PML	20/02/2021	
CHECKED	SJM	23/02/2021	
ENGINEER	SOR	20/02/2021	
APPROVED	AG	03/03/2021	
EMPLOYER	-	-	
SCALE	1:100, 1:50, 1:25, 1:20	A0	

MANSOURAH - MASSARAH GOLD PROJECT
GENERAL ARRANGEMENT DRAWING
REAGENTS - CAUSTIC SODA & CYANIDE EQUIPMENT
GA & DETAILS OF INCINERATOR BUILDING

DRAWING NUMBER: MD - 216 - 3810 - EG - CV - GAD - 2003 REV D01