




SECTION J-J
SECTION J'-J' (OPP. HAND)
(R.C DETAIL)
SCALE 1:10

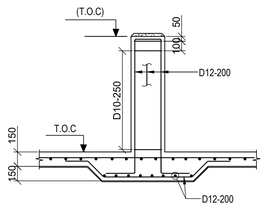


TYP. RC DETAIL OF PEDESTALS
SCALE 1:30

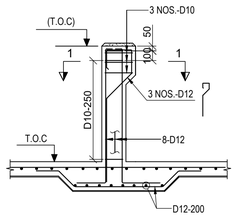


DETAIL - P2g,P2j,P1t,P2h
(R.C DETAIL)
SCALE 1:30

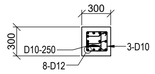


SECTION 1-1
SCALE 1:30

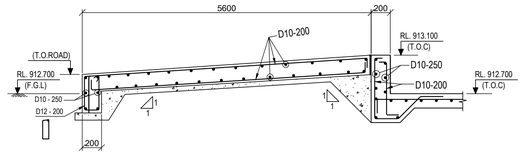


SECTION W-W
(RCC DETAIL)
SCALE 1:30

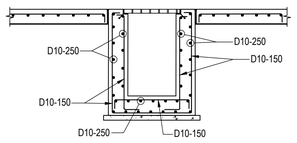


SECTION A'-A'
(R.C DETAIL)
SCALE 1:30

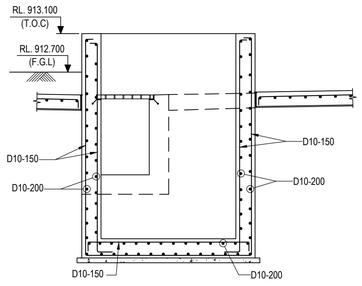

SECTION B1-B1
(R.C DETAIL)
SCALE 1:30

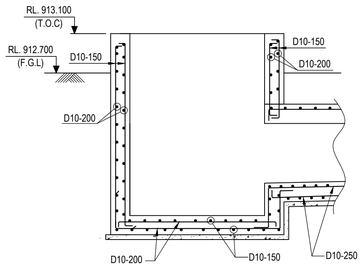

SECTION B-B
(R.C DETAIL)
SCALE 1:30

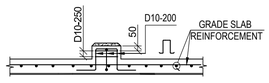

DETAIL - P1a
SCALE 1:30

LEGEND :-

R.L. - REDUCED LEVEL
I.L - INVERT LEVEL
THK. - THICKNESS
T.O.C - TOP OF CONCRETE
HYDROCL. - HYDROCHLORIC
EQUIP.-EQUIPMENT
RC.-REINFORCED CONCRETE

NOTES:-

1. ALL DIMENSIONS ARE IN MILLIMETRES AND LEVELS AND CO-ORDINATES ARE IN METRES UNLESS OTHERWISE STATED.
2. FOR DETAILS OF GRADE SLAB REFER DRG. NO. MD-216-1000-EG-CV-DED-1002.
3. THIS DRAWING IS TO BE READ IN CONJUNCTION WITH DRAWING NO. MD-216-3820-EG-CV-GAD-1404 & MD-216-3650-EG-CV-GAD-1335.

DOCUMENT NUMBER	REFERENCE DOCUMENTS	REV	DATE	REVISION DESCRIPTION	DRN	CHK	ENG	APP	EMP
MD-216-3650-EG-CV-GAD-1002	CIVIL WORKS GUIDE DRAWINGS POX ACID WASH ELUTION								
	& CARBON GENERATION PLAN AT EL. +912.700 SECTIONS								
MD-216-3650-EG-CV-GAD-1001	CIVIL WORKS GUIDE DRAWINGS POX ACID WASH								
	ELUTION & CARBON GENERATION PLAN AT EL. +912.700	D01	16/03/2023	AS-BUILT	SYA	SJM	SOR	AG	
MD-216-3820-EG-ST-GAD-2346	REAGENTS-HYDROCHLORIC ACID	C03	17/05/2021	ISSUED FOR CONSTRUCTION & REVISED AS MRKED (3)	SYA	SJM	SOR	AG	
	PLAN, ELEVATIONS & DETAILS	C02	13/02/2021	ISSUED FOR CONSTRUCTION & REVISED AS MRKED (2)	SYA	SJM	SOR	AG	
MD-216-3650-EG-ME-GAD-1015	POX ACID WASH/ELUTION/CARBON GENERATION	C01	07/07/2020	ISSUED FOR CONSTRUCTION	SYA	SJM	SOR	AG	
	PLAN AT EL. +912.700	A01	05/06/2020	ISSUED FOR REFERENCE	SYA	SJM	SOR	AG	

RESERVED FOR VENDOR LOGO AND DRAWING NUMBER

LARSEN & TOUBRO

This drawing is the property of LARSEN & TOUBRO and must not be passed on to any person or body not authorized by us to receive it nor be copied or otherwise made use either in full or in part by such person or body without our prior permission in writing.

Outotec

The content of these documents are the sole property of Outotec Oyj. Any rights not expressly granted herein are reserved. Reproduction, transfer or distribution of part or all of the contents in any form without prior written permission of Outotec is prohibited.

MA'ADEN معادن
Saudi Arabian Mining Company شركة التعدين العربية السعودية

This document and the information contained herein is Ma'aden proprietary know-how. This document or any part thereof should not be reproduced, stored in a retrieval system or transmitted by any means, electronic or otherwise, or divulged without prior written permission of Ma'aden.

LARSEN & TOUBRO DRAWING NUMBER: 019045_450_C_D_24156_002 — REVISION: 4
OUTOTEC DRAWING NUMBER: 900707__GAU01__AA05__CTB17__38202 — DOCUMENT ID: OU100687734 — REVISION: 4

DRAWN	SYA	03/06/2020
CHECKED	SJM	04/06/2020
ENGINEER	SOR	03/06/2020
APPROVED	AG	05/06/2020
EMPLOYER		
SCALE 1:30, 1:25, 1:10	A1	

MANSOURAH - MASSARAH GOLD PROJECT
DETAIL DRAWING
REAGENTS-HYDROCL. AND SULPHAMIC ACID EQUIP.
RCC DETAILS OF GRADE SLAB & SECTIONS

DRAWING NUMBER: MD-216-3820-EG-CV-DED-1410 — REV: D01