


DRAWING NUMBER: MD-216-3820-EG-CV-GAD-1403
REV: D01

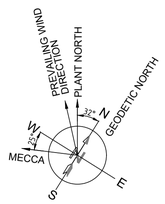


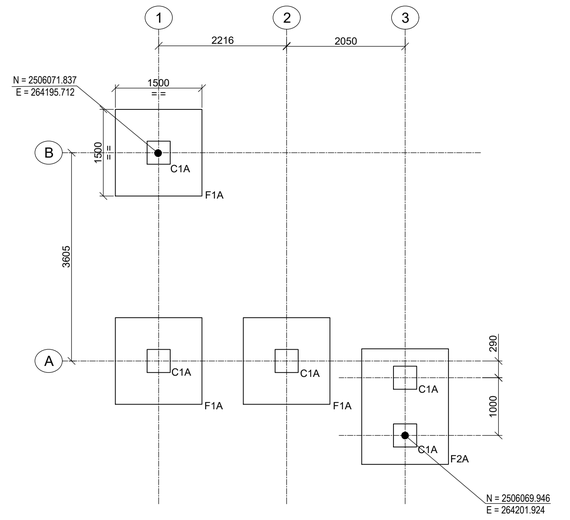


LAYOUT OF STAIR FOUNDATION
SCALE 1:50

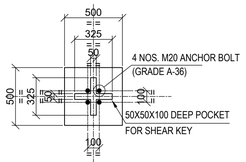


VIEW : A1-A1
SCALE 1:25

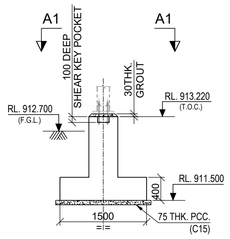


SECTION : A-A
SCALE 1:50

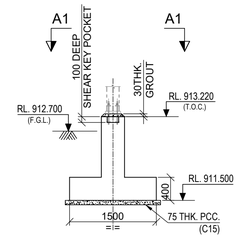


SECTION : B-B
SCALE 1:50

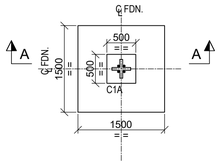

DETAIL OF FOUNDATION
MKD. F1A
SCALE 1:50

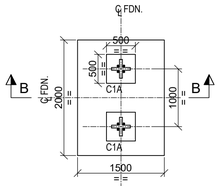

DETAIL OF FOUNDATION
MKD. F2A
SCALE 1:50

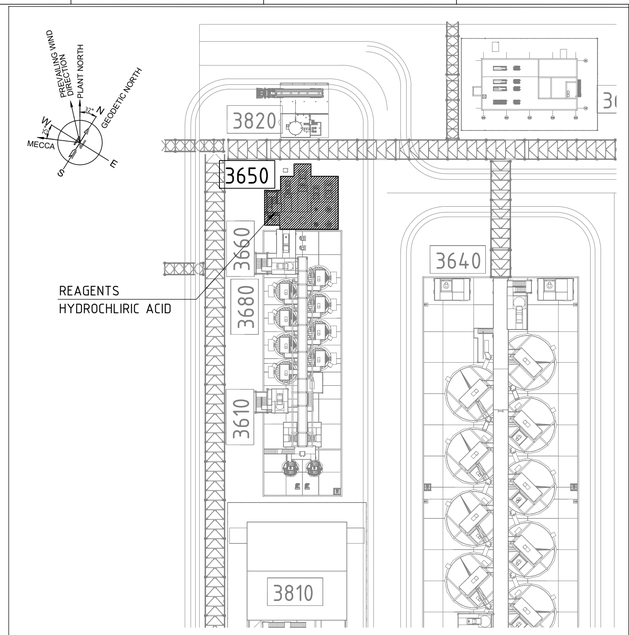

KEY PLAN
(SCALE- 1:750)

LEGEND :-

R.L. - REDUCED LEVEL
℄ - CENTRE LINE
T.O.C. - TOP OF CONCRETE
F.G.L. - FINISHED GROUND LEVEL
F.F.L. - FINISHED FLOOR LEVEL
B.O.F. - BOTTOM OF FOUNDATION
MKD. - MARKED
GA - GENERAL ARRANGEMENT
TYP. - TYPICAL
P.C.C - PLAIN CEMENT CONCRETE
THK. - THICK
T.O.G. - TOP OF GROUT
DET. - DETAIL
DRG. - DRAWING
FDN. - FOUNDATION
R.C.C - REINFORCED CEMENT CONCRETE
EQUIP. - EQUIPMENT
HYDROCL. - HYDROCHLORIC

NOTES :-

1. ALL DIMENSIONS ARE IN MILLIMETRES AND LEVELS AND CO-ORDINATES ARE IN METRES. UNLESS OTHERWISE STATED.
2. GRADE OF CONCRETE SHALL BE C35 (35MPa) FOR FOUNDATION & COLUMN.
3. GRADE OF REINFORCEMENT SHALL BE DEFORMED BAR ASTM A615 - GRADE 60 (fy = 420 MPa).
4. NET SAFE BEARING CAPACITY OF SOIL AT BOTTOM OF FOUNDATION IS CONSIDERED AS 350KN/SQ.M.
5. IF ANY PART OF FOUNDATION COMES ON BACKFILL ZONE OF ADJACENT FOUNDATION OR ANY LOOSE SOIL ARE ENCOUNTERED BELOW FOUNDATION LEVEL THE SAME SHALL BE REMOVED AND FILLED WITH PCC.
6. FOR STANDARD DETAILS OF ANCHOR BOLTS REFER DRG. NO MD-216-1000-EG-CV-DED-1003.
7. FOR STANDARD REINFORCEMENT DETAIL & GENERAL NOTES FOR CIVIL WORKS REFER DRG. NO. MD-216-1000-EG-CV-DED-1005 &1001.
8. READ THIS DRAWING IN CONJUNCTION WITH DRAWING NO MD-216-3820-EG-CV-DED-1409.

DOCUMENT NUMBER	REFERENCE DOCUMENTS	REV	DATE	REVISION DESCRIPTION	DRN	CHK	ENG	APP	EMP
MD-216-3820-EG-ST-GAD-2346	REAGENTS-HYDROCHLORIC ACID	D01	16/03/2023	AS-BUILT	SYA	SJM	SOR	AG	
	PLAN, ELEVATIONS & DETAILS	C02	05/12/2020	ISSUED FOR CONSTRUCTION & REVISED AS MRKED C02	SYA	SJM	SOR	AG	
MD-216-3650-EG-ME-GAD-1015	POX ACID WASH/ELUTION/CARBON GENERATION	C01	07/07/2020	ISSUED FOR CONSTRUCTION	SYA	SJM	SOR	AG	
	PLAN AT EL. +912.700	A01	05/06/2020	ISSUED FOR REFERENCE	SYA	SJM	SOR	AG	

RESERVED FOR VENDOR LOGO AND DRAWING NUMBER

LARSEN & TOUBRO

This drawing is the property of LARSEN & TOUBRO and must not be passed on to any person or body not authorized by us to receive it nor be copied or otherwise made use either in full or in part by such person or body without our prior permission in writing.

Outotec

The content of these documents are the sole property of Outotec Oyj. Any rights not expressly granted herein are reserved. Reproduction, transfer or distribution of part or all of the contents in any form without prior written permission of Outotec is prohibited.

MA'ADEN معادن
Saudi Arabian Mining Company شركة معادن العربية السعودية

This document and the information contained herein is Ma'aden proprietary know-how. This document or any part thereof should not be reproduced, stored in a retrieval system or transmitted by any means, electronic or otherwise, or divulged without prior written permission of Ma'aden.

LARSEN & TOUBRO DRAWING NUMBER: 019045_450_C_G_24155_001 — REVISION: 3
OUTOTEC DRAWING NUMBER: 900707__GAU01__AA05__MTL01__38205 — DOCUMENT ID: 0U100687744 — REVISION: 3

DRAWN	SYA	03/06/2020
CHECKED	2	04/06/2020
ENGINEER	SOR	03/06/2020
APPROVED	AG	05/06/2020
EMPLOYER		
SCALE	1:75, 1:25	A1

MANSOURAH - MASSARAH GOLD PROJECT
GENERAL ARRANGEMENT DRAWING
REAGENTS-HYDROCL. AND SULPHAMIC ACID EQUIP.
GA & DETAILS OF STAIR & PLATFORM FOUNDATION

DRAWING NUMBER: MD-216-3820-EG-CV-GAD-1403 — REV: D01