


DRAWING NUMBER: MD-216-3820-EG-CV-GAD-1404 | REV: D01

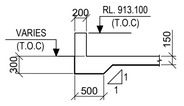


SECTION J-J
SCALE 1:50

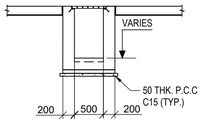


SECTION A'-A'
SCALE 1:50

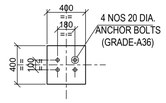


VIEW : X-X
(PEDESTAL ORIENTATION TREATED AS PER LAYOUT PLAN)
SCALE 1:30

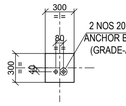


VIEW : N-N
(FOR P1v, P1n, P1p, P1t, P2h & P2k)
SCALE 1:30

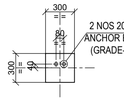


VIEW : M-M
SCALE 1:30

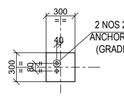


VIEW : P-P
VIEW : Q-Q (OPP. HAND)
SCALE 1:30

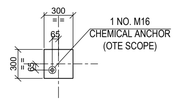


VIEW : R-R
SCALE 1:30

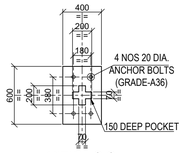


VIEW : S-S
SCALE 1:30

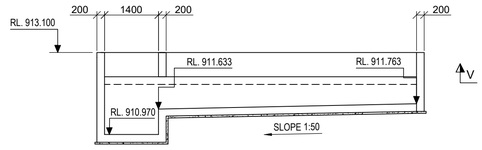


SECTION 1-1
SCALE 1:75

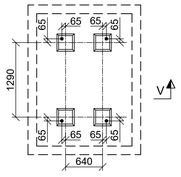


DETAIL-D5
SCALE 1:50

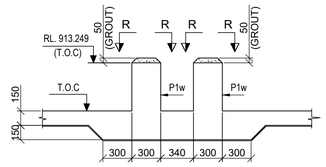


SECTION V-V
SCALE 1:30

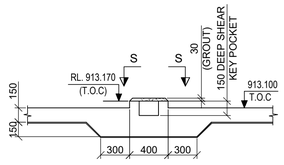


DETAIL - P14
SCALE 1:30

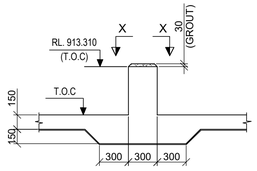

DETAIL - P4a
SCALE 1:30

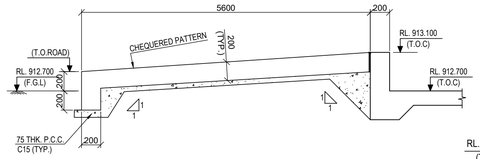


SECTION W-W
SCALE 1:30

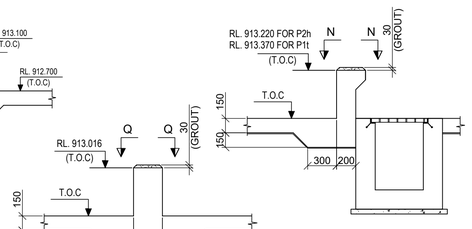


DETAIL - P1j & P1h
SCALE 1:30


DETAIL - P1t & P2h
SCALE 1:30

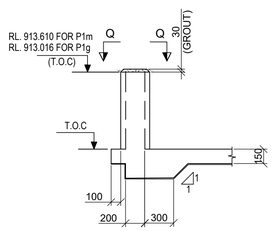


DETAIL - P1g & P1m
SCALE 1:30

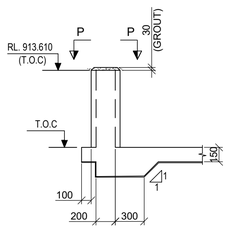


DETAIL - P1k
SCALE 1:30

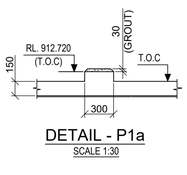


DETAIL - P1a
SCALE 1:30

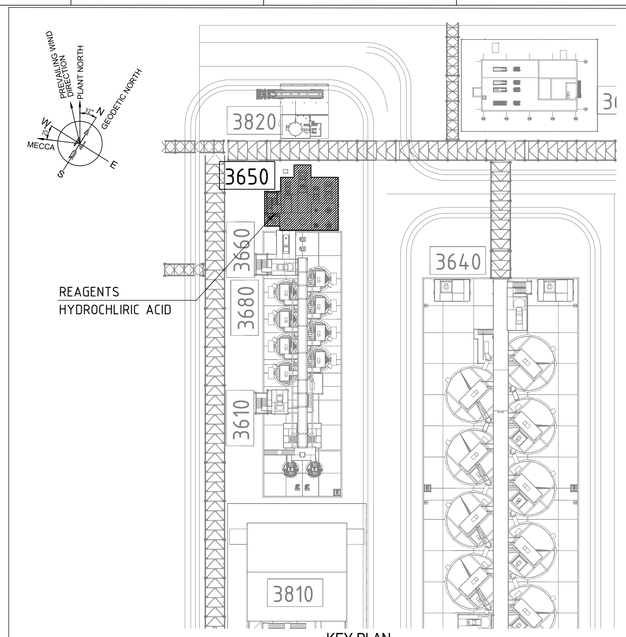


KEY PLAN
(SCALE- 1:750)

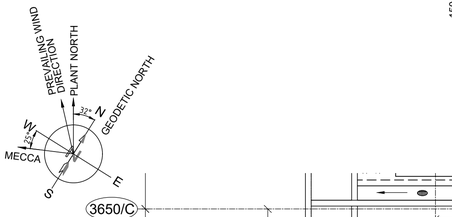

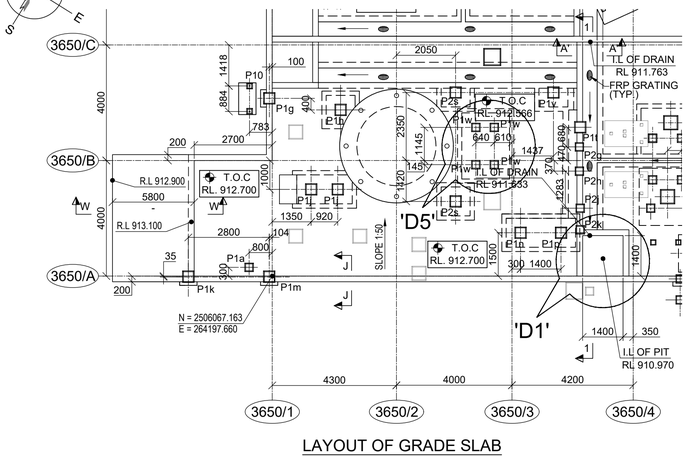


LAYOUT OF GRADE SLAB
SCALE 1:100

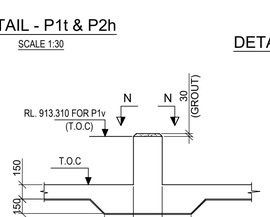


DETAIL - P2g & P2j
SCALE 1:30

DETAIL - P1n & P1p
SCALE 1:30


DETAIL - P1v
SCALE 1:30

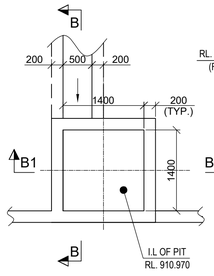


DETAIL-D1
SCALE 1:50

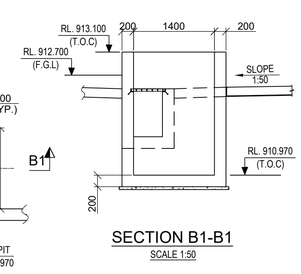


SECTION B1-B1
SCALE 1:50

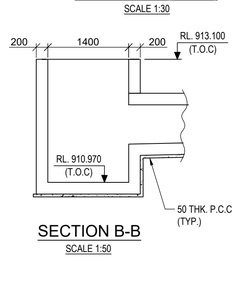


SECTION B-B
SCALE 1:50

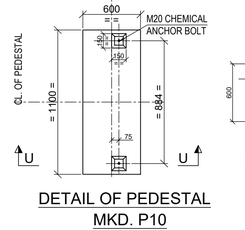

DETAIL OF PEDESTAL
MKD. P10
(PEDESTAL ORIENTATION TREATED AS PER LAYOUT PLAN)
(SCALE - 1:30)

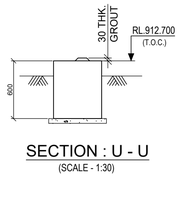

SECTION : U - U
(SCALE - 1:30)

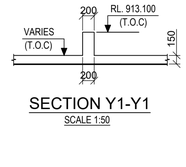

SECTION Y1-Y1
SCALE 1:50

LEGEND :-

R.L. - REDUCED LEVEL
I.L - INVERT LEVEL
THK. - THICKNESS
TYP. - TYPICAL.
T.O.C - TOP OF CONCRETE
HYDROCL. - HYDROCHLORIC
EQUIP.-EQUIPMENT

NOTES:-

1. ALL DIMENSIONS ARE IN MILLIMETRES AND LEVELS AND CO-ORDINATES ARE IN METRES UNLESS OTHERWISE STATED.
2. FOR DETAILS OF GRADE SLAB REFER DRG. NO. MD-216-1000-EG-CV-DED-1002.
3. THIS DRAWING IS TO BE READ IN CONJUNCTION WITH DRAWING NO.
   MD-216-3650-EG-CV-GAD-1335.
   MD-216-3820-EG-CV-DED-1410.
4. FOR EMBEDED ELECTRICAL CONDUITS REFER SEPERATE DRAWING.

DOCUMENT NUMBER	REFERENCE DOCUMENTS	REV	DATE	REVISION DESCRIPTION	DRN	CHK	ENG	APP	EMP
MD-216-3650-EG-CV-GAD-1002	CIVIL WORKS GUIDE DRAWINGS POX ACID WASH ELUTION								
	& CARBON GENERATION PLAN AT EL. +912.700 SECTIONS								
MD-216-3650-EG-CV-GAD-1001	CIVIL WORKS GUIDE DRAWINGS POX ACID WASH								
	ELUTION & CARBON GENERATION PLAN AT EL. +912.700	D01	16/03/2023	AS-BUILT	SYA	SJM	SOR	AG	
MD-216-3820-EG-ST-GAD-2346	REAGENTS-HYDROCHLORIC ACID	C03	17/05/2021	ISSUED FOR CONSTRUCTION & REVISED AS MRKED △C03	SYA	SJM	SOR	AG	
	PLAN, ELEVATIONS & DETAILS	C02	13/02/2021	ISSUED FOR CONSTRUCTION & REVISED AS MRKED △C02	SYA	SJM	SOR	AG	
MD-216-3650-EG-ME-GAD-1015	POX ACID WASH/ELUTION/CARBON GENERATION	C01	07/07/2020	ISSUED FOR CONSTRUCTION	SYA	SJM	SOR	AG	
	PLAN AT EL. +912.700	A01	05/06/2020	ISSUED FOR REFERENCE	SYA	SJM	SOR	AG	

RESERVED FOR VENDOR LOGO AND DRAWING NUMBER

LARSEN & TOUBRO

This drawing is the property of LARSEN & TOUBRO and must not be passed on to any person or body not authorized by us to receive it nor be copied or otherwise made use either in full or in part by such person or body without our prior permission in writing.

Outotec

The content of these documents are the sole property of Outotec Oyj. Any rights not expressly granted herein are reserved. Reproduction, transfer or distribution of part or all of the contents in any form without prior written permission of Outotec is prohibited.

MA'ADEN معادن
Saudi Arabian Mining Company شركة معادن العربية السعودية

This document and the information contained herein is Ma'aden proprietary know-how. This document or any part thereof should not be reproduced, stored in a retrieval system or transmitted by any means, electronic or otherwise, or divulged without prior written permission of Ma'aden.

LARSEN & TOUBRO DRAWING NUMBER: 019045_450_C_G_24155_002 | REVISION: 4
OUTOTEC DRAWING NUMBER: 900707__GAU01__AA05__MTL01__38206 | DOCUMENT ID: OU100687745 | REVISION: 4

DRAWN	SYA	03/06/2020
CHECKED	SJM	04/06/2020
ENGINEER	SOR	03/06/2020
APPROVED	AG	05/06/2020
EMPLOYER		

MANSOURAH - MASSARAH GOLD PROJECT
GENERAL ARRANGEMENT DRAWING
REAGENTS-HYDROCL. AND SULPHAMIC ACID EQUIP.
GA & DETAILS OF GRADE SLAB

SCALE: 1:75, 1:50, 1:25 | A1
DRAWING NUMBER: MD-216-3820-EG-CV-GAD-1404 | REV: D01