


DRAWING NUMBER: MD-216-49PR-EG-CV-GAD-1594 REV D01

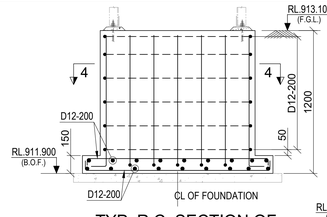


TYP. R.C. SECTION OF FOUNDATION MKD. SF1
(SCALE - 1:25)

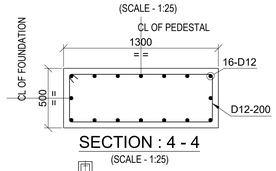


SECTION : 4 - 4
(SCALE - 1:25)

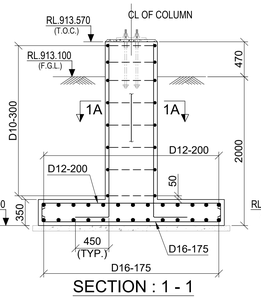


SECTION : 1 - 1
(SCALE - 1:40)

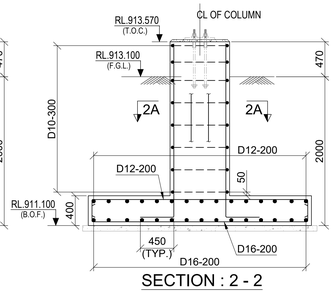


SECTION : 2 - 2
(SCALE - 1:40)

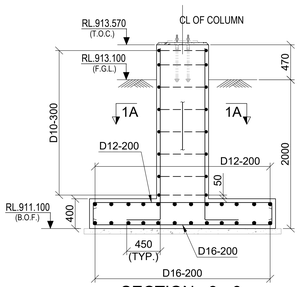


SECTION : 3 - 3
(SCALE - 1:40)

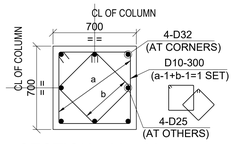


SECTION : 1A - 1A
TYP. R.C. DETAIL OF COLUMN MKD. C1, C1A & C3
(SCALE- 1:25)

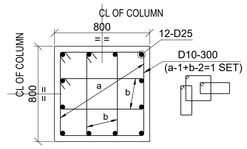

SECTION : 2A - 2A
TYP. R.C. DETAIL OF COLUMN MKD. C2
(SCALE- 1:25)

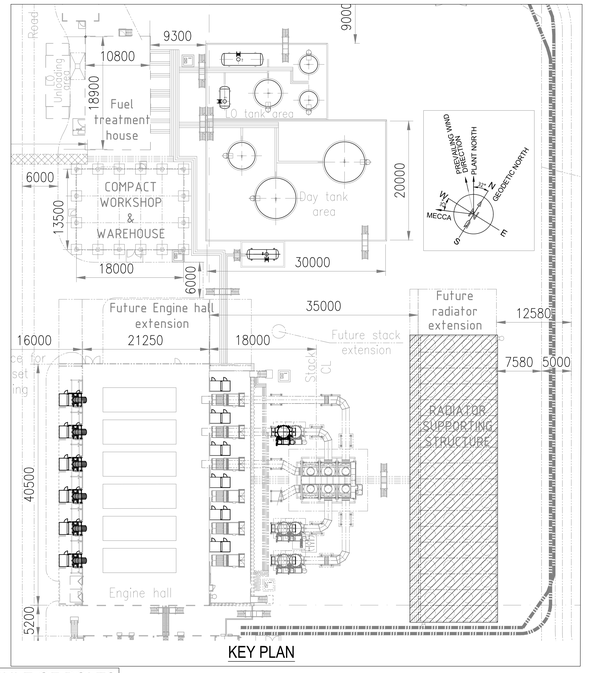


KEY PLAN

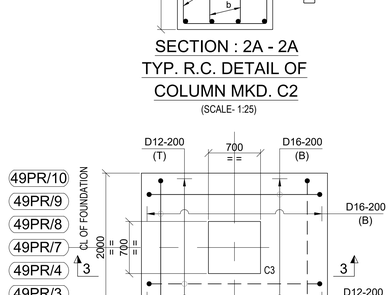

49PR/A 49PR/B

DETAIL OF FOUNDATION MKD. F2
(4 NOS. REQUIRED)
(SCALE - 1:40)

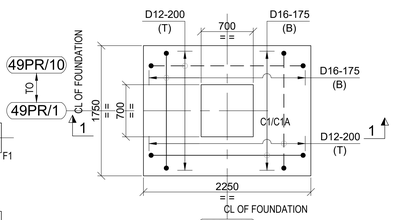

49PR/C


DETAIL OF FOUNDATION MKD. F1
(10 NOS. REQUIRED)
(SCALE - 1:40)

49PR/A 49PR/B


R.C. DETAIL OF FOUNDATION MKD. F3
(16 NOS. REQUIRED)
(SCALE - 1:40)

SCHEDULE OF BOLTS


BOLT DIA. (MM)	BOLT NUMBERS REQUIRED
20	100
M24	24

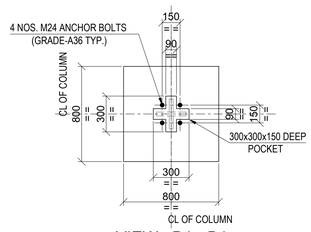

VIEW : B1 - B1
(FOR C2 COLUMN)
(SCALE- 1:25)

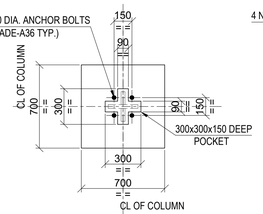

VIEW : A1 - A1
(FOR C1 & C3 COLUMN)
(SCALE- 1:25)

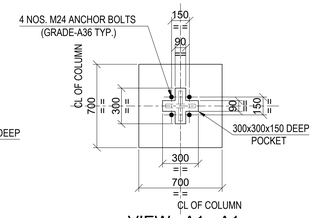


VIEW : A1 - A1
(FOR C1A COLUMN)
(SCALE- 1:25)

LEGEND :-


RL. - REDUCED LEVEL.
T.O.C. - TOP OF CONCRETE.
F.G.L. - FINISHED GROUND LEVEL.
B.O.F. - BOTTOM OF FOOTING.
CL - CENTRE LINE.
TYP. - TYPICAL.
THK. - THICK.
MKD. - MARKED.
G.A. - GENERAL ARRANGEMENT.
DIA - DIAMETER.

NOTES :-


1. ALL DIMENSIONS ARE IN MILLIMETERS AND LEVELS AND CO-ORDINATES ARE IN METERS. UNLESS OTHERWISE STATED.
2. GRADE OF CONCRETE SHALL BE 35 MPa FOR FOUNDATION & 15 MPa FOR BLINDING CONCRETE.
3. GRADE OF REINFORCEMENT SHALL BE DEFORMED BAR 420 MPa (GRADE 60) - ASTM A615/A615M.
4. NET SAFE BEARING CAPACITY OF SOIL AT BOTTOM OF FOUNDATION CONSIDER 450KN/ SQ. M.
5. CLEAR COVER TO MAIN REINFORCEMENT SHALL BE 75 mm FOR RAFT & 50 mm FOR COLUMN.
6. IF ANY PART OF FOUNDATION COMES ON BACKFILL ZONE OF ADJACENT FOUNDATION OR ANY LOOSE SOIL ARE ENCOUNTERED BELOW FOUNDATION LEVEL THE SAME SHALL BE REMOVED AND FILLED WITH PCC.
7. THIS DRAWING SHALL BE READ IN CONJUNCTION WITH DRAWING NO. MD-216-49PR-EG-ST-GAD-2292 & 2393.
8. ALL OTHER NOTES REFER DRAWING NO. MD-101-SMEM-EG-ST-DST-0001 TO 0008.
9. GENERAL NOTES FOR CIVIL WORKS & STANDARD REINFORCEMENT DETAIL REFER DRAWING NO. MD-216-1000-EG-CV-DED-1001 & 1005.

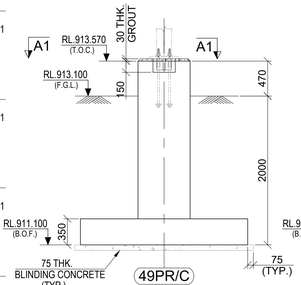


SECTION : A - A
(SCALE - 1:40)

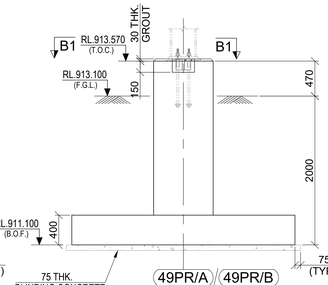

SECTION : B - B
(SCALE - 1:40)

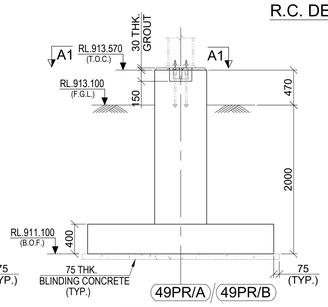


SECTION : C - C
(SCALE - 1:40)

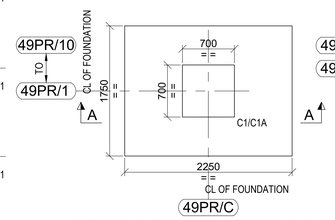


49PR/C

DETAIL OF FOUNDATION MKD. F1
(SCALE - 1:40)

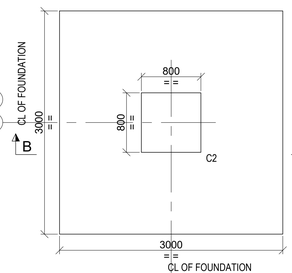


49PR/A 49PR/B

DETAIL OF FOUNDATION MKD. F2
(SCALE - 1:40)

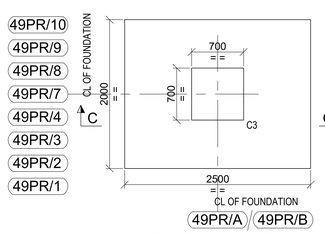


49PR/A 49PR/B

DETAIL OF FOUNDATION MKD. F3
(SCALE - 1:40)

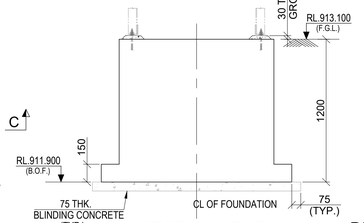

SECTION : D - D
(SCALE - 1:25)

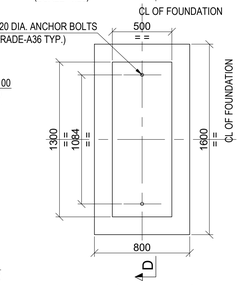

DETAIL OF FOUNDATION MKD. SF1
(SCALE - 1:25)

FOUNDATION LAYOUT PLAN
(SCALE 1:175)

DOCUMENT NUMBER	REFERENCE DOCUMENTS	REV	DATE	REVISION DESCRIPTION	DRN	CHK	ENG	APP	EMP
		D01	16/02/2023	AS-BUILT	AMJ	SGC	SHD	PRI	
		C02	17/12/2020	ISSUED FOR CONSTRUCTION & REVISED AS MKD. C02	AMJ	SGC	SHD	PRI	
MD-216-1000-EG-ST-CRT-1001	CIVIL, STRUCTURAL & ARCHITECTURAL-	C01	03/07/2020	ISSUED FOR CONSTRUCTION & REVISED AS MKD. C01	PDK	SGC	SHD	PRI	
	DESIGN CRITERIA	A02	05/06/2020	REVISED AS PER EMPLOYER COMMENTS	PDK	SGC	SHD	PRI	
MD-216-1000-EG-CV-DED-1003	ANCHOR BOLTS STANDARD DETAILS.			ON DTD. 03/06/2020 & REVISED AS MKD. A02					
MD-216-49PR-EG-ME-LAD-V553-1004	POWER GENERATION FLOOR PLANS - RADIATOR AREA	A01	08/05/2020	ISSUED FOR REFERENCE	PDK	SGC	SHD	PRI	

RESERVED FOR VENDOR LOGO AND DRAWING NUMBER

LARSEN & TOUBRO

This drawing is the property of LARSEN & TOUBRO and must not be passed on to any person or body not authorized by us to receive it nor be copied or otherwise made use either in full or in part by such person or body without our prior permission in writing.

Outotec

The content of these documents are the sole property of Outotec Oyj. Any rights not expressly granted herein are reserved. Reproduction, transfer or distribution of part or all of the contents in any form without prior written permission of Outotec is prohibited.

MA'ADEN معادن
Saudi Arabian Mining Company شركة معادن العربية السعودية

This document and the information contained herein is Ma'aden proprietary know-how. This document or any part thereof should not be reproduced, stored in a retrieval system or transmitted by any means, electronic or otherwise, or divulged without prior written permission of Ma'aden.

LARSEN & TOUBRO DRAWING NUMBER: 019045_008_C_G_24290_001 — REVISION: 4
OUTOTEC DRAWING NUMBER: 900707__GAU01__WG01__MTL01__45053 — DOCUMENT ID: OU100682329 — REVISION: 4

DRAWN	PDK	23/04/2020
CHECKED	SGC	27/04/2020
ENGINEER	SHD	20/04/2020
APPROVED	PRI	08/05/2020
EMPLOYER		

SCALE: 1:175, 1:40 & 1:25 — A1

MANSOURAH - MASSARAH GOLD PROJECT
GENERAL ARRANGEMENT
RADIATOR SUPPORTING STRUCTURE
G.A. AND DETAIL OF FOUNDATION

DRAWING NUMBER: MD - 216 - 49PR - EG - CV - GAD - 1594 — REV: D01