


DRAWING NUMBER: MD-216-49PR-EG-CV-GAD-1599 REV D01

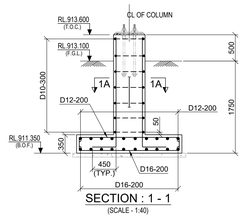


SECTION : 1 - 1
(SCALE - 1:40)

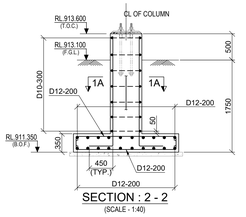


SECTION : 2 - 2
(SCALE - 1:40)

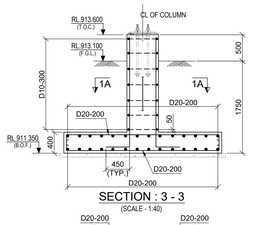


SECTION : 3 - 3
(SCALE - 1:40)

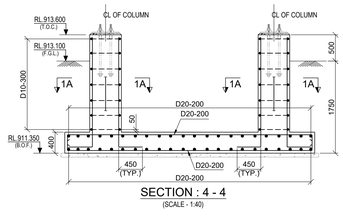


SECTION : 4 - 4
(SCALE - 1:40)

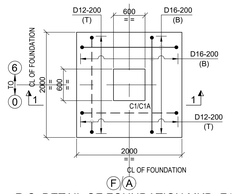


R.C. DETAIL OF FOUNDATION MKD. F1
(14 NOS. REQUIRED)
(SCALE - 1:40)

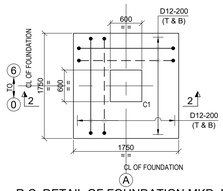


R.C. DETAIL OF FOUNDATION MKD. F2
(7 NOS. REQUIRED)
(SCALE - 1:40)

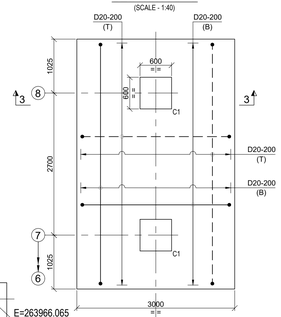


R.C. DETAIL OF FOUNDATION MKD. F3
(1 NO. REQUIRED)
(SCALE - 1:40)

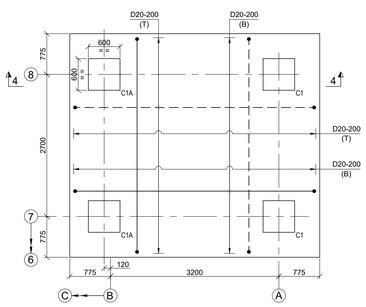


R.C. DETAIL OF FOUNDATION MKD. F4
(1 NO. REQUIRED)
(SCALE - 1:40)

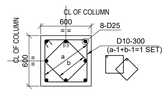


SECTION : 1A - 1A
TYP. R.C. CROSS SECTION OF
COLUMN MKD. C1 & C2
(SCALE- 1:25)

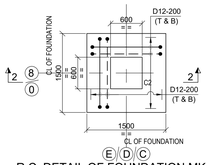


R.C. DETAIL OF FOUNDATION MKD. F5
(6 NOS. REQUIRED)
(SCALE - 1:40)

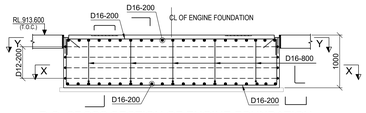


R.C. CROSS SECTION OF ENGINE FOUNDATION
(SCALE - 1:40)

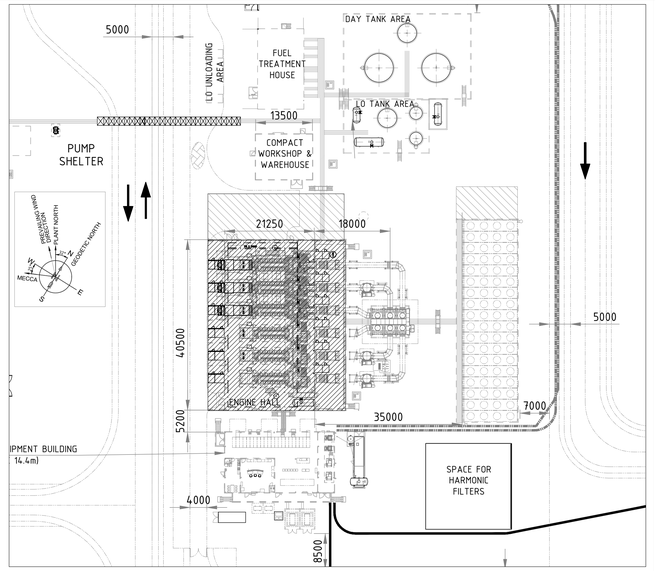


KEY PLAN
(SCALE- 1:500)

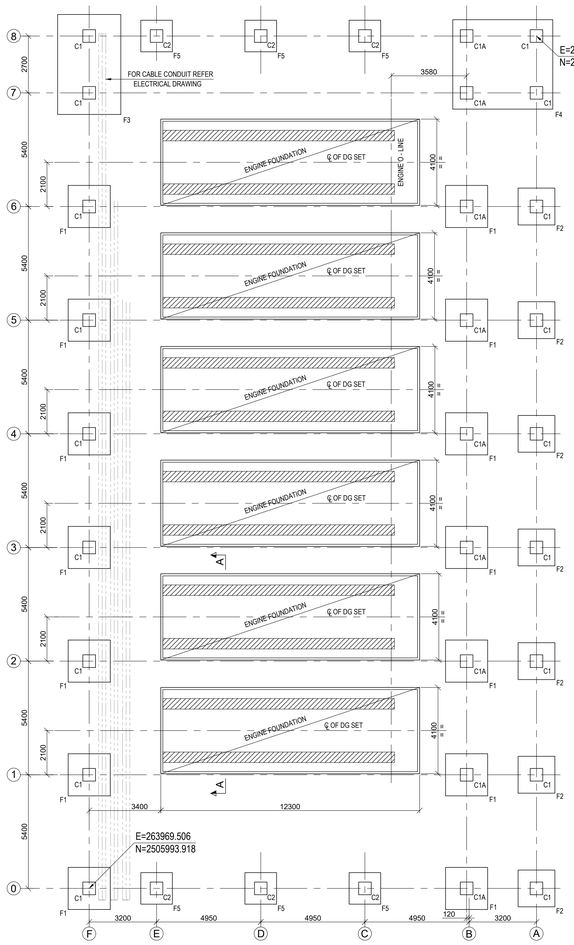


FOUNDATION LAYOUT PLAN
(SCALE 1:100)

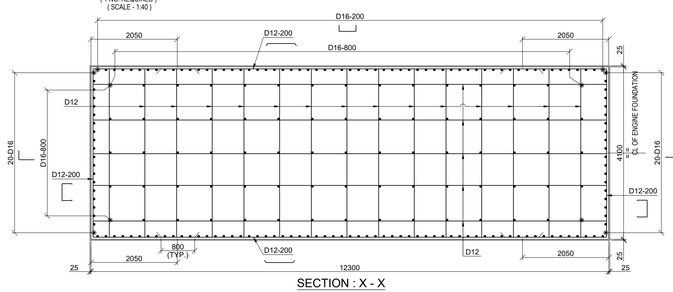


SECTION : X - X
(SCALE - 1:50)

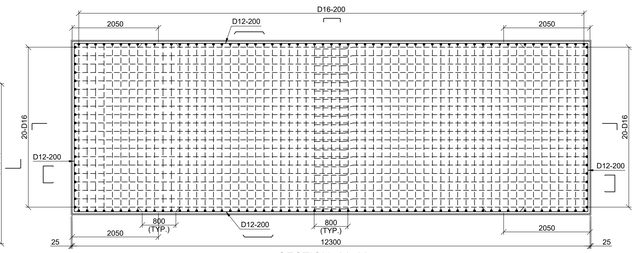


SECTION : Y - Y
(SCALE - 1:50)

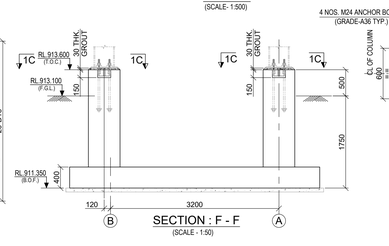


SECTION : F - F
(SCALE - 1:50)

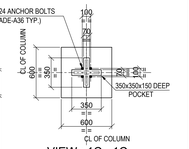


VIEW : 1C - 1C
(FOR C1A COLUMN)
(SCALE- 1:25)

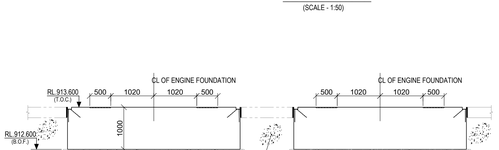


SECTION : A - A
(SCALE - 1:50)

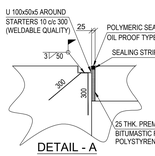


DETAIL - A
(SCALE - 1:15)

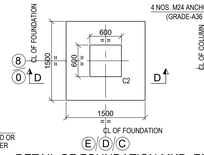


DETAIL OF FOUNDATION MKD. F5
(SCALE - 1:40)

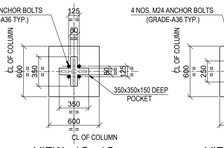

VIEW : 1C - 1C
(FOR C1 COLUMN)
(SCALE- 1:25)

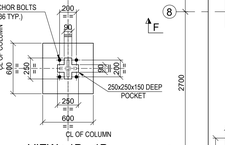

VIEW : 1D - 1D
(FOR C2 COLUMN)
(SCALE- 1:25)

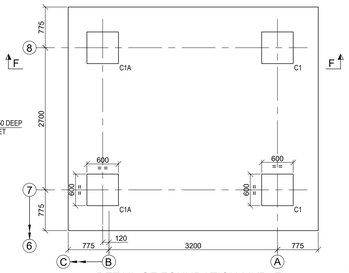

DETAIL OF FOUNDATION MKD. F4
(SCALE - 1:40)

GENERAL TOLERANCE :-


FOR LINE AND LEVEL IN GENERAL : +5/-5 mm
FOR DIMENSIONS IN GENERAL : +10/-5 mm


SPECIAL TOLERANCE :-

TOLERANCE FOR INCLINATION ON THE HATCHED AREA : (BOTH DIRECTIONS)




SURFACE LEVEL DIFFERENCE BETWEEN ANY TWO POINTS : (INSIDE ONE AREA OR BETWEEN THE TWO HATCHED AREAS)

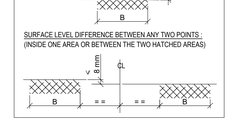


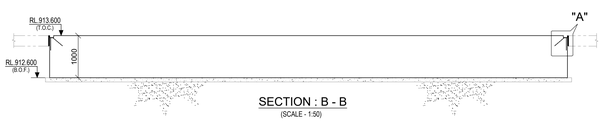


SECTION : B - B
(SCALE - 1:50)

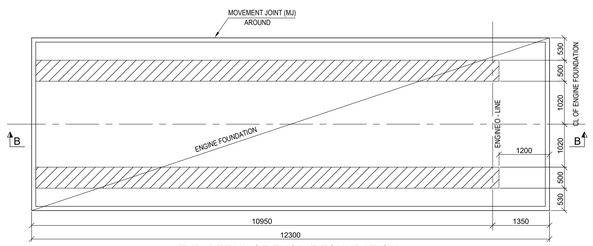


TYP. DETAIL OF ENGINE FOUNDATION
(SCALE - 1:50)

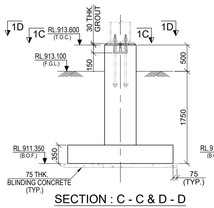


SECTION : C - C & D - D
(SCALE - 1:40)

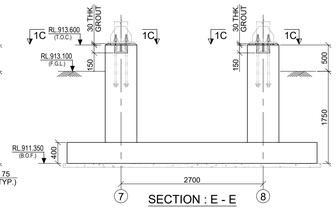


SECTION : E - E
(SCALE - 1:50)

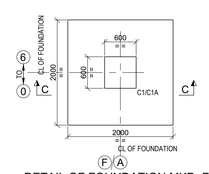

DETAIL OF FOUNDATION MKD. F1
(SCALE - 1:40)

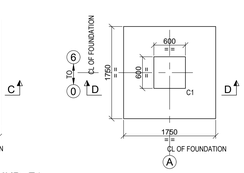

DETAIL OF FOUNDATION MKD. F2
(SCALE - 1:40)

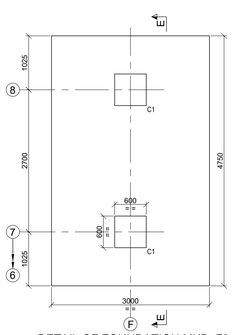

DETAIL OF FOUNDATION MKD. F3
(SCALE - 1:40)

LEGEND :-

RL - REDUCED LEVEL.
T.O.C. - TOP OF CONCRETE.
F.G.L. - FINISHED GROUND LEVEL.
B.O.F. - BOTTOM OF FOOTING.
CL - CENTRE LINE.
TYP. - TYPICAL.
THK. - THICK.
MKD. - MARKED.
C/C - CENTER TO CENTER.
DIA. - DIAMETER.
B - BOTTOM REINFORCEMENT
T - TOP REINFORCEMENT
R.C. - REINFORCED CONCRETE

NOTES :-

1. ALL DIMENSIONS ARE IN MILLIMETERS AND LEVELS AND CO-ORDINATES ARE IN METERS. UNLESS OTHERWISE STATED.
2. GRADE OF CONCRETE SHALL BE 35 MPa FOR FOUNDATION & 15 MPa FOR BLINDING CONCRETE.
3. GRADE OF REINFORCEMENT SHALL BE DEFORMED BAR 420 MPa (GRADE 60) - ASTM A615/A615M.
4. NET SAFE BEARING CAPACITY OF SOIL AT BOTTOM OF FOUNDATION CONSIDER 450kN/ SQ. M.
5. CLEAR COVER TO MAIN REINFORCEMENT SHALL BE 75 mm FOR RAFT & 50 mm FOR COLUMN.
6. IF ANY PART OF FOUNDATION COMES ON BACKFILL ZONE OF ADJACENT FOUNDATION OR ANY LOOSE SOIL ARE ENCOUNTERED BELOW FOUNDATION LEVEL THE SAME SHALL BE REMOVED AND FILLED WITH PCC.
7. BACKFILLING FROM (-)1.2M TO (-)0.6M SHALL BE DONE WITH SAND. SAND FILLING SHALL BE DONE IN LAYERS OF COMPACTED THICKNESS OF 200MM. EACH LAYER SHALL BE COMPACTED TO 95% OF PROCTOR DENSITY
8. THIS DRAWING SHALL BE READ IN CONJUNCTION WITH DRAWING NO. MD-216-49PR-EG-ST-GAD-2408 & 2409.
9. ALL OTHER NOTES REFER DRAWING NO. MD-101-SMEM-EG-ST-DST-0001 TO 0008.
10. GENERAL NOTES FOR CIVIL WORKS & STANDARD REINFORCEMENT DETAIL REFER DRAWING NO: MD-216-1000-EG-CV-DED-1001 & 1005.

DOCUMENT NUMBER	REFERENCE DOCUMENTS	REV	DATE	REVISION DESCRIPTION	DRN	CHK	ENG	APP	EMP
		D01	17/02/2023	AS-BUILT	AMJ	SGC	SHD	PRI	
MD-216-1000-EG-CV-DED-1003	ANCHOR BOLTS STANDARD DETAILS.	C04	11/12/2020	ISSUED FOR CONSTRUCTION AND REVISED AS MKD. C03	AMJ	SGC	SHD	PRI	
MD-216-1000-EG-ST-CRT-1001	CIVIL, STRUCTURAL & ARCHITECTURAL- DESIGN CRITERIA	C03	09/10/2020	ISSUED FOR CONSTRUCTION & REVISED AS MKD. C02	AMJ	SGC	SHD	PRI	
		C02	29/06/2020	ISSUED FOR CONSTRUCTION & REVISED AS MKD. C02	PDK	SGC	SHD	PRI	
MD-216-49PR-EG-ME-LAD-V553-1003	POWER GENERATION, ENGINE HALL PLAN	C01	11/06/2020	ISSUED FOR CONSTRUCTION & REVISED AS MKD. C01	PDK	SGC	SHD	PRI	
MD-216-49PR-EG-ME-LAD-V553-1002	POWER GENERATION, CROSS SECTION	A01	29/04/2020	ISSUED FOR REFERENCE	PDK	SGC	SHD	PRI	

RESERVED FOR VENDOR LOGO AND DRAWING NUMBER

LARSEN & TOUBRO

This drawing is the property of LARSEN & TOUBRO and must not be passed on to any person or body not authorized by us to receive it nor be copied or otherwise made use either in full or in part by such person or body without our prior permission in writing.

Outotec

The content of these documents are the sole property of Outotec Oyj. Any rights not expressly granted herein are reserved. Reproduction, transfer or distribution of part or all of the contents in any form without prior written permission of Outotec is prohibited.

MA'ADEN معادن
Saudi Arabian Mining Company شركة المعادن العربية السعودية

This document and the information contained herein is Ma'aden proprietary know-how. This document or any part thereof should not be reproduced, stored in a retrieval system or transmitted by any means, electronic or otherwise, or divulged without prior written permission of Ma'aden.

LARSEN & TOUBRO DRAWING NUMBER	019045_008_C_G_24295_001	REVISION 5
OUTOTEC DRAWING NUMBER	900707__GAU01__WG01_MTL01__45038	DOCUMENT ID OU100681406 REVISION 5
DRAWN	PDK	08/04/2020
CHECKED	SGC	20/04/2020
ENGINEER	SHD	06/04/2020
APPROVED	PRI	29/04/2020
EMPLOYER		
SCALE	1:200,100,20	A0

MANSOURAH - MASSARAH GOLD PROJECT
GENERAL ARRANGEMENT
POWER GENERATION : ENGINE HALL
PLAN, SECTION & DETAILS OF FOUNDATION

DRAWING NUMBER: MD - 216 - 49PR - EG - CV - GAD - 1599 REV: D01