


DRAWING NUMBER MD-216-49PR-EG-CV-GAD-1601 REV D01

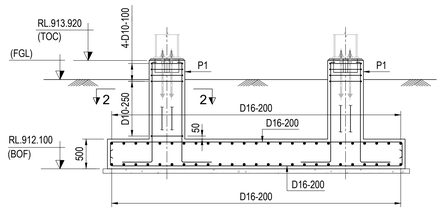


SECTION 1-1
(SCALE - 1:50)

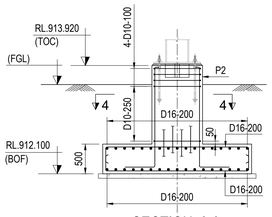


SECTION 3-3
(SCALE - 1:50)

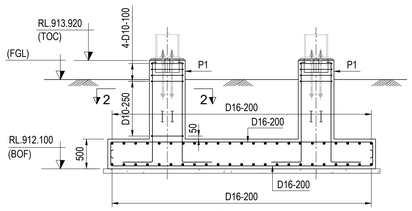


SECTION 5-5
(SCALE - 1:50)

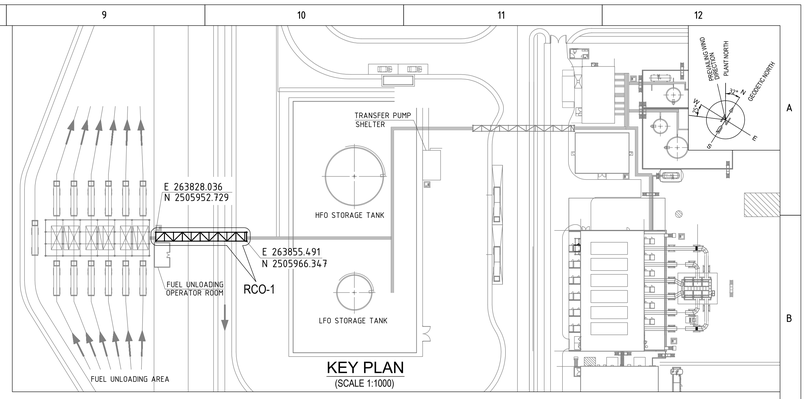


KEY PLAN
(SCALE 1:1000)

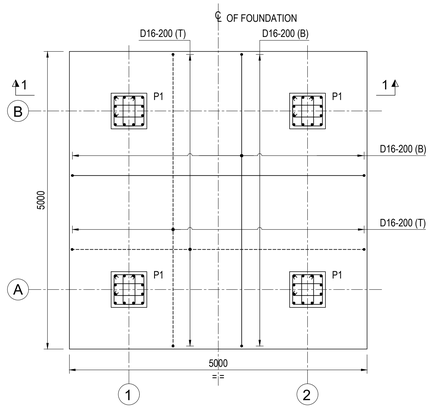


DETAIL OF FOUNDATION MKD. F1
(SCALE - 1:50)

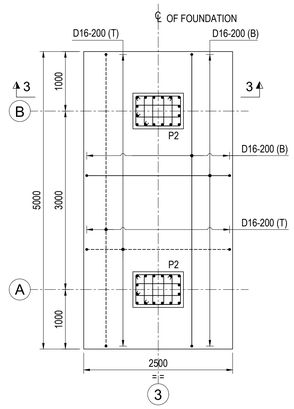


DETAIL OF FOUNDATION MKD. F2
(SCALE - 1:50)

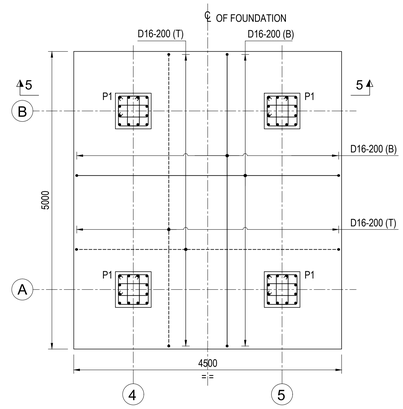


DETAIL OF FOUNDATION MKD. F3
(SCALE - 1:50)

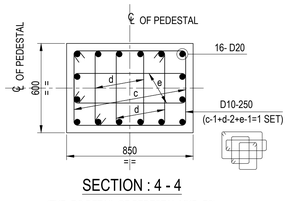


SECTION : 4 - 4
(TYP. RC DETAIL OF PEDESTAL MKD. P2)
(SCALE- 1:20)

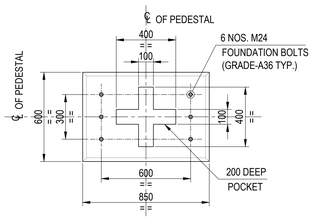


SECTION : 1B - 1B
(TYP. DETAIL OF PEDESTAL MKD. P2)
(SCALE- 1:20)

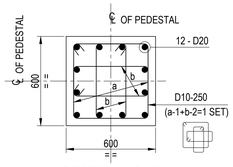


SECTION : 2 - 2
(TYP. RC DETAIL OF PEDESTAL MKD. P1)
(SCALE- 1:20)

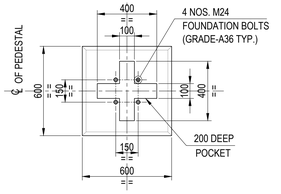


SECTION : 1A - 1A
(TYP. DETAIL OF PEDESTAL MKD. P1)
(SCALE- 1:20)

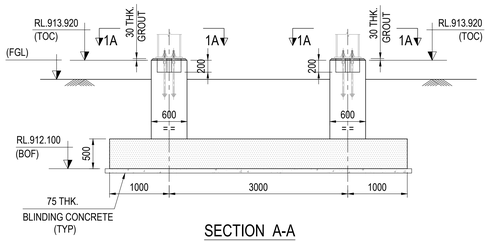


SECTION A-A
(SCALE - 1:50)

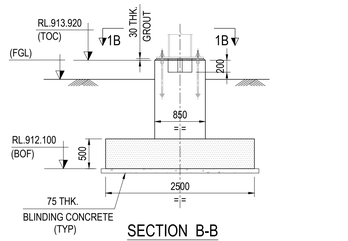

SECTION B-B
(SCALE - 1:50)

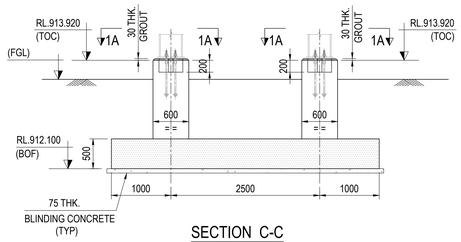

SECTION C-C
(SCALE - 1:50)

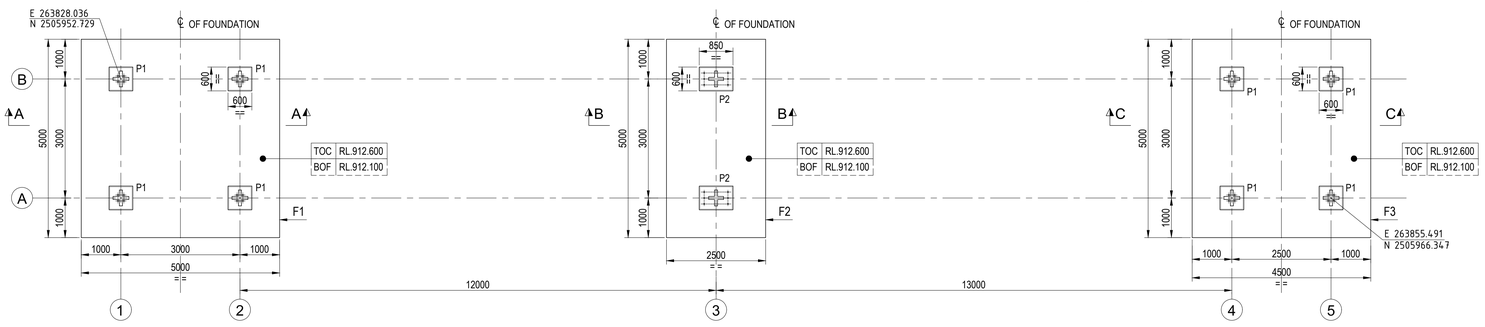

FOUNDATION LAYOUT PLAN FOR DUCT SUPPORT
(SCALE 1:75)

LEGEND :-

TOC = TOP OF CONCRETE
BOC = BOTTOM OF CONCRETE
FGL = FINISHED GROUND LEVEL
BOF = BOTTOM OF FOUNDATION
TYP = TYPICAL
MKD = MARKED
℄ = CENTRE LINE
THK = THICK
GA = GENERAL ARRANGEMENT.
RC = REINFORCED CONCRETE
PCC = PLAIN CEMENT CONCRETE
DIA = DIAMETER
T = TOP
B = BOTTOM
RL = REDUCED LEVEL
– – – – = TOP REINFORCEMENT
——— = BOTTOM REINFORCEMENT

NOTES :-

1. ALL DIMENSIONS ARE IN MILLIMETRES AND LEVELS AND CO-ORDINATES ARE IN METRES. UNLESS OTHERWISE STATED.
2. GRADE OF CONCRETE SHALL BE 35 MPa FOR FOUNDATION & 15 MPa FOR BLINDING CONCRETE.
3. GRADE OF REINFORCEMENT SHALL BE DEFORMED BAR 420 MPa (GRADE 60) - ASTM A615/A615M.
4. NET SAFE BEARING CAPACITY OF SOIL AT BOTTOM OF FOUNDATION CONSIDER 450KN/ SQ. M.
5. REINFORCEMENT SHALL BE SUITABLY ADJUSTED AT SITE TO CLEAR POCKETS, BOLTS ETC.
6. IF ANY PART OF FOUNDATION COMES ON BACKFILL ZONE OF ADJACENT FOUNDATION OR ANY LOOSE SOIL ARE ENCOUNTERED BELOW FOUNDATION LEVEL THE SAME SHALL BE REMOVED AND FILLED WITH PCC.
7. FOR ALL OTHER NOTES REFER DRAWING NO. MD-101-SMEM-EG-ST-DST-0001 TO 0008.
8. FOR GENERAL NOTES OF CIVIL WORKS & STANDARD REINFORCEMENT DETAIL REFER DRAWING NO. MD-216-1000-EG-CV-DED-1001 & 1005.

SCHEDULE OF BOLTS

BOLT DIA. (MM)	BOLT NUMBERS REQUIRED
M24	44

DOCUMENT NUMBER	REFERENCE DOCUMENTS	REV	DATE	REVISION DESCRIPTION	DRN	CHK	ENG	APP	EMP
		D01	17/02/2023	AS-BUILT	ABH	UR	SVK	AG	
		C04	05/01/2021	ISSUED FOR CONSTRUCTION & REVISED AS MARKED C04	ABH	UR	SVK	AG	
		C03	20/11/2020	ISSUED FOR CONSTRUCTION & REVISED AS MARKED C03	ABH	UR	SVK	AG	
		C02	20/10/2020	ISSUED FOR CONSTRUCTION & REVISED AS MARKED C02	ABH	UR	SVK	AG	
MD-216-49PR-EG-EL-LAD-V553-1002	POWER GENERATION - PLAN	C01	13/08/2020	ISSUED FOR CONSTRUCTION	ABH	UR	SVK	AG	
MD-216-49PR-EG-ST-GAD-2401	PLAN, ELEVATION & DETAILS OF PIPE RACK IN RCO-1	A01	17/07/2020	ISSUED FOR REFERENCE	ABH	UR	SVK	AG	

RESERVED FOR VENDOR LOGO AND DRAWING NUMBER

LARSEN & TOUBRO
This drawing is the property of LARSEN & TOUBRO and must not be passed on to any person or body not authorized by us to receive it nor be copied or otherwise made use either in full or in part by such person or body without our prior permission in writing.

Outotec
The content of these documents are the sole property of Outotec Oyj. Any rights not expressly granted herein are reserved. Reproduction, transfer or distribution of part or all of the contents in any form without prior written permission of Outotec is prohibited.

MA'ADEN معادن
Saudi Arabian Mining Company شركة التعدين العربية السعودية
This document and the information contained herein is Ma'aden proprietary know-how. This document or any part thereof should not be reproduced, stored in a retrieval system or transmitted by any means, electronic or otherwise, or divulged without prior written permission of Ma'aden.

LARSEN & TOUBRO DRAWING NUMBER: 019045_008_C_G_24290_008 — REVISION: 5
OUTOTEC DRAWING NUMBER: 900707__GAU01__WG01_MTL01__45057 — DOCUMENT ID: OU100682333 — REVISION: 5

DRAWN	ABH	07/07/2020
CHECKED	UR	09/07/2020
ENGINEER	SVK	07/07/2020
APPROVED	AG	17/07/2020
EMPLOYER		
SCALE	1:75, 50, 20	A1

MANSOURAH - MASSARAH GOLD PROJECT
GENERAL ARRANGEMENT
POWER PLANT PIPE RACK
G.A. AND DETAIL OF FOUNDATION FOR RCO-1

DRAWING NUMBER: MD-216-49PR-EG-CV-GAD-1601 — REV: D01