


DRAWING NUMBER: MD-216-49PR-EG-CV-GAD-1602 | REV: D01

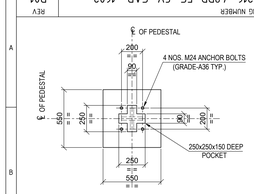


VIEW : 1A - 1A
(TYP. DETAIL OF PEDESTAL MKD. P1)
(SCALE- 1:20)

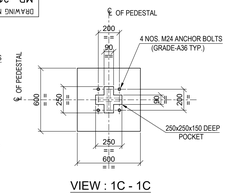


VIEW : 1C - 1C
(TYP. DETAIL OF PEDESTAL MKD. P2)
(SCALE- 1:20)

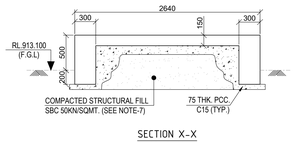


SECTION X-X
SCALE 1:30

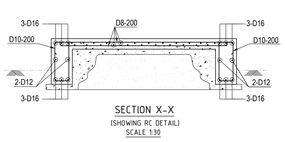


SECTION X-X
(SHOWING RC DETAIL)
SCALE 1:30

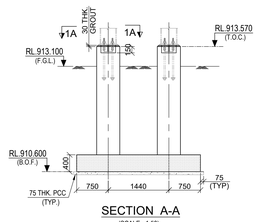


SECTION A-A
(SCALE - 1:50)

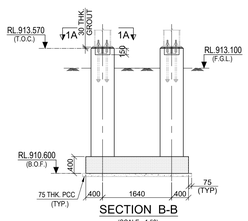


SECTION B-B
(SCALE - 1:50)

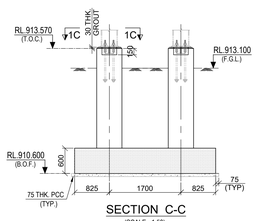


SECTION C-C
(SCALE - 1:50)

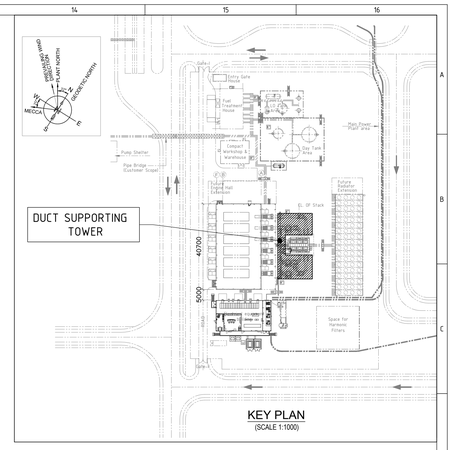


KEY PLAN
(SCALE 1:1000)

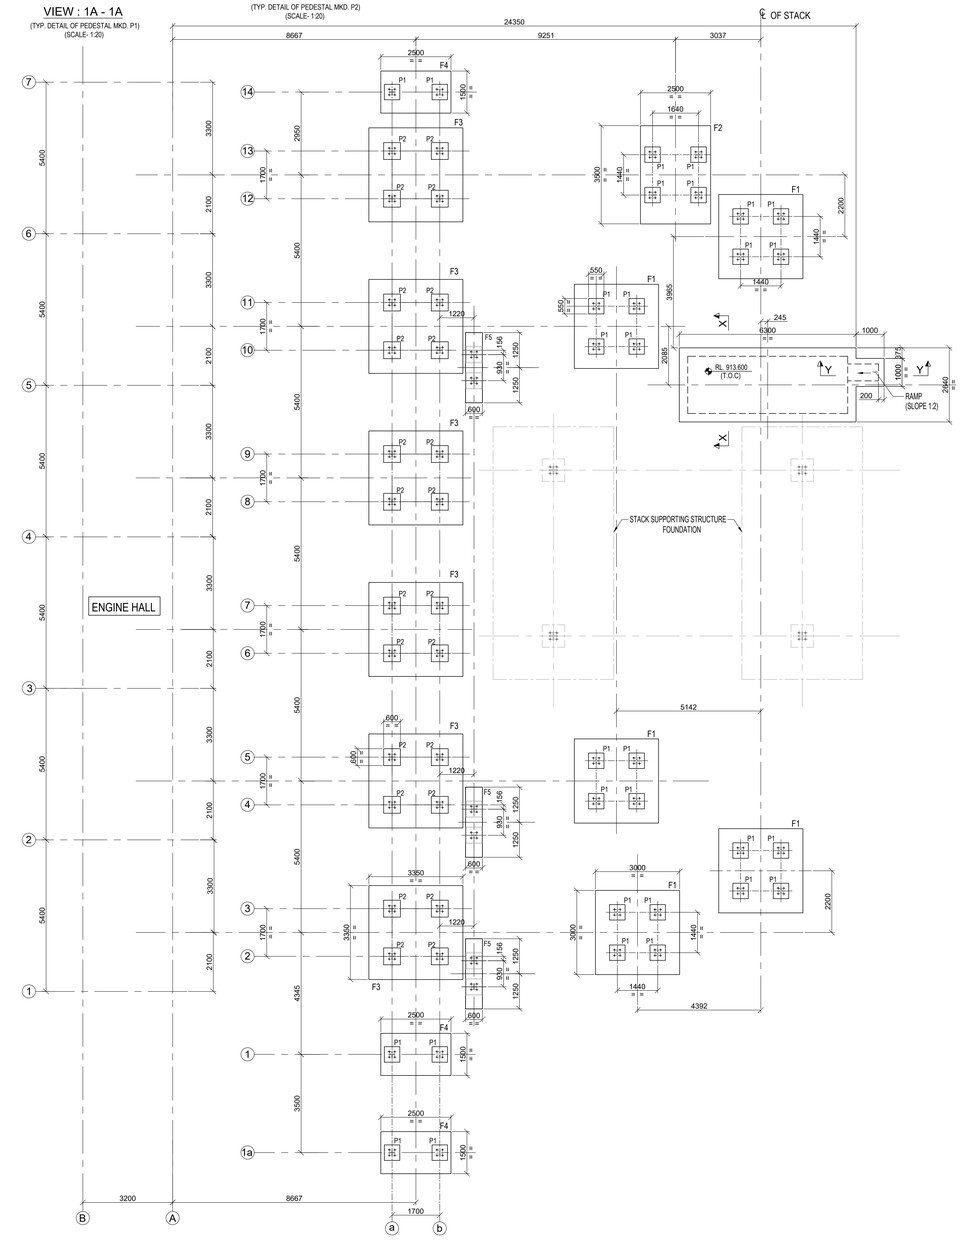


FOUNDATION LAYOUT FOR DUCT SUPPORT
(SCALE 1:75)

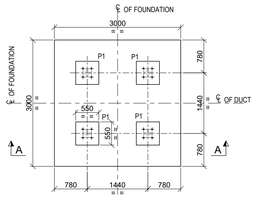

FOUNDATION MKD. F1
(SCALE - 1:50)

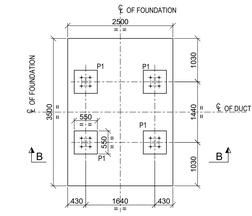


FOUNDATION MKD. F2
(SCALE - 1:50)

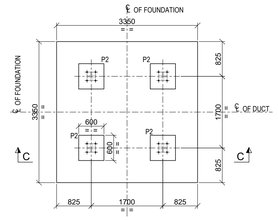


FOUNDATION MKD. F3
(SCALE - 1:50)


SCHEDULE OF BOLTS	
BOLT DIA. (MM)	BOLT NUMBERS REQUIRED
M24	240

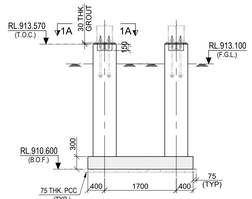


SECTION D-D
(SCALE - 1:50)

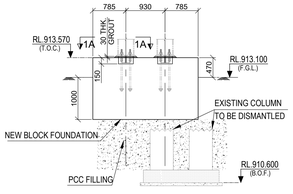


SECTION E-E
(SCALE - 1:50)

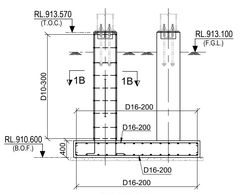


SECTION 1-1
(SCALE - 1:50)

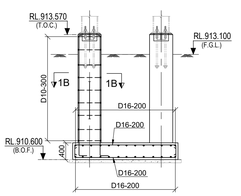


SECTION 2-2
(SCALE - 1:50)

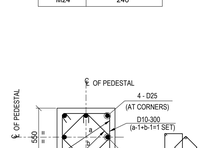


SECTION : 1B - 1B
(TYP. RC DETAIL OF PEDESTAL MKD. P1)
(SCALE- 1:20)

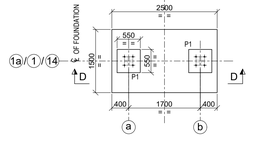


FOUNDATION MKD. F4
(SCALE - 1:50)

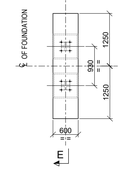


FOUNDATION MKD. F5
(SCALE - 1:50)

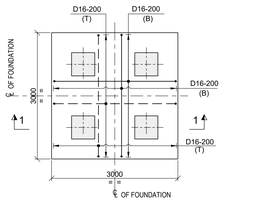


RC DETAIL OF FOUNDATION MKD. F1
(5 NOS. REQUIRED)
(SCALE - 1:50)

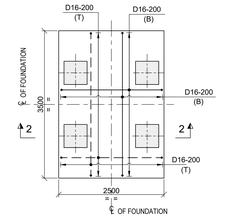


RC DETAIL OF FOUNDATION MKD. F2
(1 NO. REQUIRED)
(SCALE - 1:50)

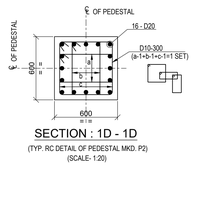


SECTION : 1D - 1D
(TYP. RC DETAIL OF PEDESTAL MKD. P2)
(SCALE- 1:20)

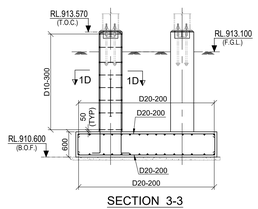


SECTION 3-3
(SCALE - 1:50)

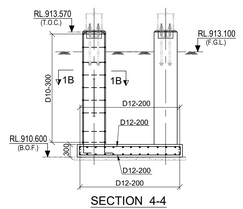


SECTION 4-4
(SCALE - 1:50)

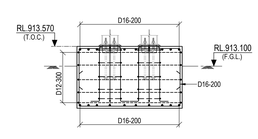


SECTION 5-5
(SCALE - 1:50)

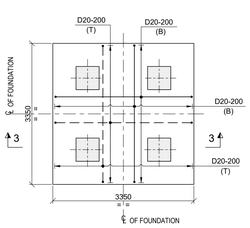


RC DETAIL OF FOUNDATION MKD. F3
(6 NO. REQUIRED)
(SCALE - 1:50)

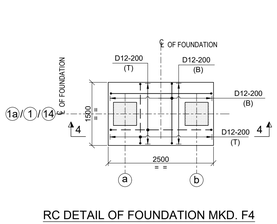

RC DETAIL OF FOUNDATION MKD. F4
(3 NO. REQUIRED)
(SCALE - 1:50)

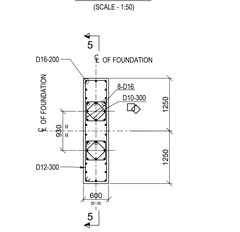

RC DETAIL OF FOUNDATION MKD. F5
(3 NO. REQUIRED)
(SCALE - 1:50)

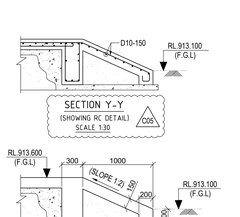

SECTION Y-Y
SCALE 1:30

LEGEND :-

RL - REDUCED LEVEL.
T.O.C. - TOP OF CONCRETE.
F.G.L - FINISHED GROUND LEVEL.
B.O.F - BOTTOM OF FOOTING.
℄ - CENTRE LINE.
TYP - TYPICAL.
THK - THICK.
MKD. - MARKED.
G.A - GENERAL ARRANGEMENT.
R.C. - REINFORCED CONCRETE.
P.C.C. - PLAIN CEMENT CONCRETE.
T - TOP.
B - BOTTOM.
— — — - TOP REINFORCEMENT.
——— - BOTTOM REINFORCEMENT.

NOTES :-

1. ALL DIMENSIONS ARE IN MILLIMETRES AND LEVELS AND CO-ORDINATES ARE IN METRES, UNLESS OTHERWISE STATED.
2. GRADE OF CONCRETE SHALL BE 35 MPa FOR FOUNDATION & 15 MPa FOR BLINDING CONCRETE.
3. GRADE OF REINFORCEMENT SHALL BE DEFORMED BAR 420 MPa (GRADE 60) - ASTM A615/A615M.
4. NET SAFE BEARING CAPACITY OF SOIL AT BOTTOM OF FOUNDATION CONSIDER 500kN/ SQ. M.
5. CLEAR COVER TO MAIN REINFORCEMENT SHALL BE 75 mm FOR RAFT & 50 mm FOR COLUMN.
6. IF ANY PART OF FOUNDATION COMES ON BACKFILL ZONE OF ADJACENT FOUNDATION OR ANY LOOSE SOIL ARE ENCOUNTERED BELOW FOUNDATION LEVEL THE SAME SHALL BE REMOVED AND FILLED WITH PCC.
7. THIS DRAWING SHALL BE READ IN CONJUNCTION WITH DRAWING NO. MD-216-49PR-EG-ST-GAD-2406, MD- 216-49PR-EG-ST-GAD-2416, MD-216-49PR-EG-ST-GAD-2003 & MD- 216-49PR-EG-ST-GAD-2004
8. ALL OTHER NOTES REFER DRAWING NO. MD-101-SMEM-EG-ST-DST-0001 TO 0008.
9. GENERAL NOTES FOR CIVIL WORKS & STANDARD REINFORCEMENT DETAIL REFER DRAWING NO. MD-216-1000-EG-CV-DED-1001 & 1005.

DOCUMENT NUMBER	REFERENCE DOCUMENTS	REV	DATE	REVISION DESCRIPTION	DRN	CHK	ENG	APP	EMP
		D01	17/02/2023	AS-BUILT	SYA	SJM	SVG	SG	
		C05	08/09/2021	ISSUED FOR CONSTRUCTION AND REVISED AS MKD. C05	SYA	SJM	AVG	AG	
		C04	11/12/2020	ISSUED FOR CONSTRUCTION AND REVISED AS MKD. C04	AMJ	SGC	SHD	PRI	
MD-216-49PR-EG-ME-GAD-V553-1049	EXHAUST GAS & CHARGE AIR SYSTEM-LOAD DRAWING	C03	30/11/2020	ISSUED FOR CONSTRUCTION AND REVISED AS MKD. C03	PDK	SGC	SHD	PRI	
MD-216-1000-EG-CV-DED-1003	ANCHOR BOLTS STANDARD DETAILS.	C02	25/09/2020	ISSUED FOR CONSTRUCTION AND REVISED AS MKD. C02	AMJ	SGC	SHD	PRI	
MD-216-1000-EG-ST-CRT-1001	CIVIL, STRUCTURAL & ARCHITECTURAL - DESIGN CRITERIA	C01	07/08/2020	ISSUED FOR CONSTRUCTION AND REVISED AS MKD. C01	AMJ	SGC	SHD	PRI	
MD-216-49PR-EG-ME-LAD-V553-1002	LAYOUT OF POWER GENERATION	A01	06/06/2020	ISSUED FOR REFERENCE	AMJ	SGC	SHD	PRI	

RESERVED FOR VENDOR LOGO AND DRAWING NUMBER

LARSEN & TOUBRO
This drawing is the property of LARSEN & TOUBRO and must not be passed on to any person or body not authorized by us to receive it nor be copied or otherwise made use either in full or in part by such person or body without our prior permission in writing.

Outotec
The content of these documents are the sole property of Outotec Oyj. Any rights not expressly granted herein are reserved. Reproduction, transfer or distribution of part or all of the contents in any form without prior written permission of Outotec is prohibited.

MA'ADEN معادن Saudi Arabian Mining Company شركة معادن العربية السعودية
This document and the information contained herein is Ma'aden proprietary know-how. This document or any part thereof should not be reproduced, stored in a retrieval system or transmitted by any means, electronic or otherwise, or divulged without prior written permission of Ma'aden.

LARSEN & TOUBRO DRAWING NUMBER			REVISION
O19045_008_C_G_24290_009			6
OUTOTEC DRAWING NUMBER		DOCUMENT ID	REVISION
900707__GAU01__WG01_MTL01__45058		OU100682334	6
DRAWN	AMJ	02/06/2020	MANSOURAH - MASSARAH GOLD PROJECT
CHECKED	SGC	03/06/2020	GENERAL ARRANGEMENT
ENGINEER	SHD	01/06/2020	POWER PLANT DUCT SUPPORT
APPROVED	PRI	06/06/2020	G.A. AND DETAIL OF FOUNDATION
EMPLOYER			
SCALE	1:200,100,20	A0	DRAWING NUMBER: MD - 216 - 49PR - EG - CV - GAD - 1602
			REV: D01