

DRAWING NUMBER MD-216-49PR-EG-CV-GAD-1623 REV D01

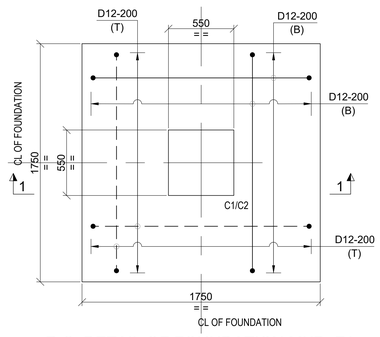

R.C. DETAIL OF FOUNDATION MKD. F1


(16 NOS. REQUIRED)

(SCALE - 1:25)

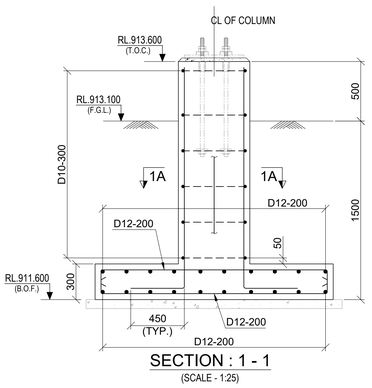

SECTION : 1 - 1


(SCALE - 1:25)

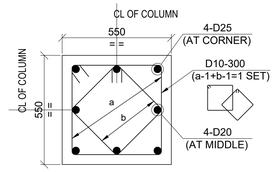


SECTION : 1A - 1A

TYP. CROSS SECTION OF COLUMN MKD. C1 & C2

(SCALE- 1:15)

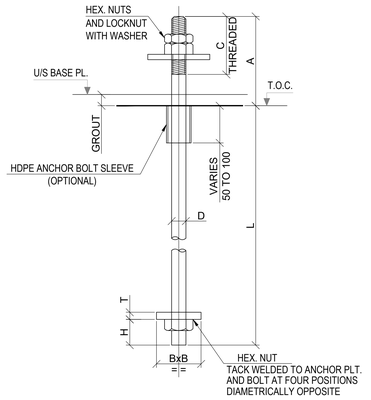


TYP. DETAIL OF BOLT

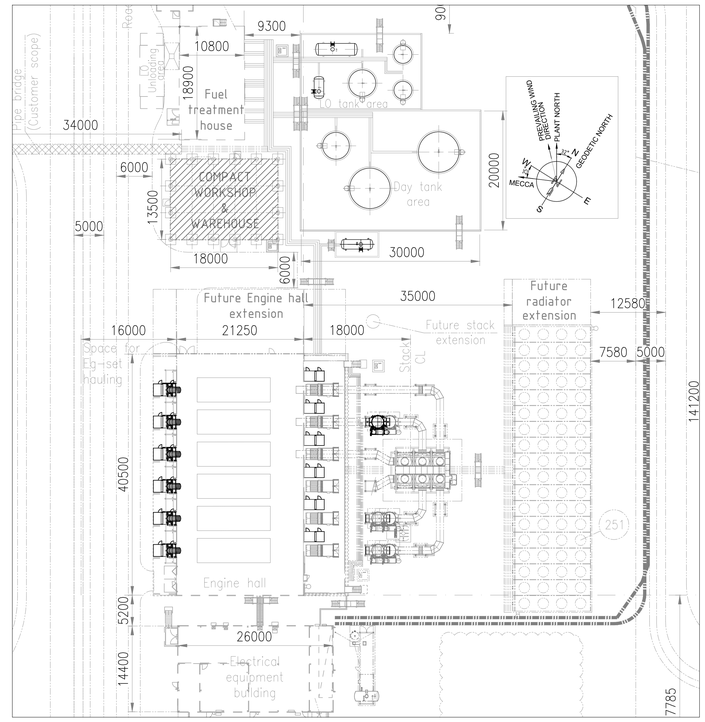


KEY PLAN

(SCALE- 1:500)

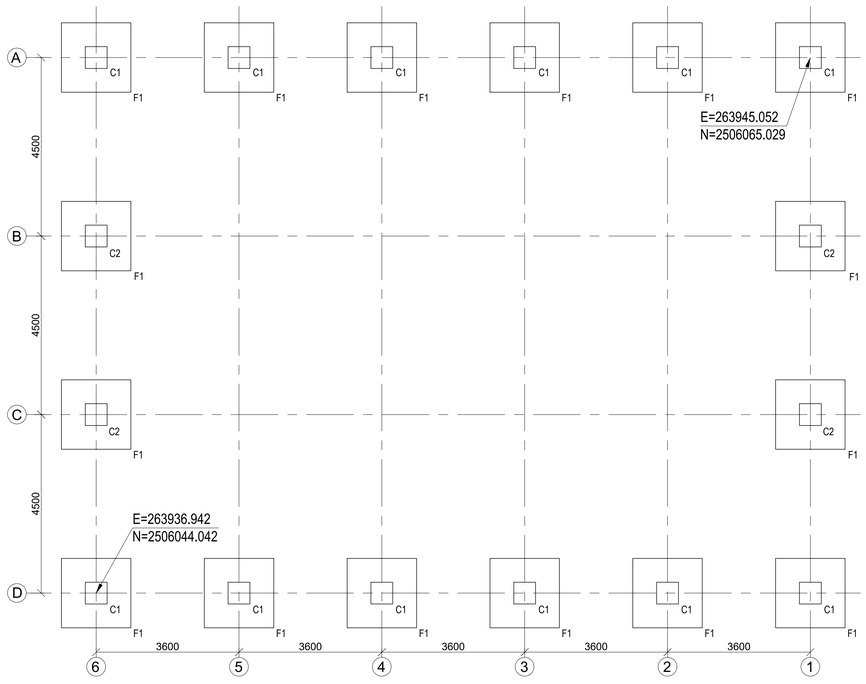


FOUNDATION LAYOUT PLAN

(SCALE 1:75)

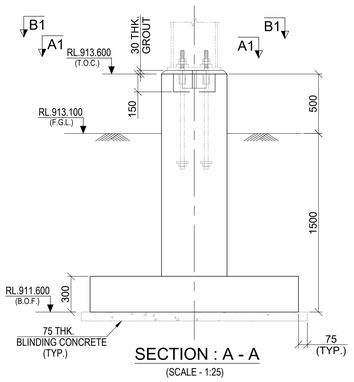

SECTION : A - A


(SCALE - 1:25)

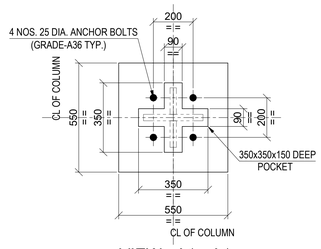

VIEW : A1 - A1


(FOR C1 COLUMN)

(SCALE- 1:15)

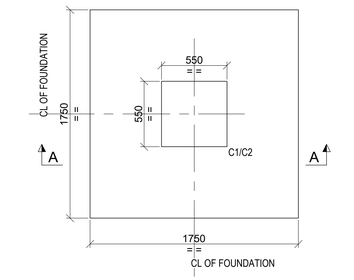

DETAIL OF FOUNDATION MKD. F1

(SCALE - 1:25)

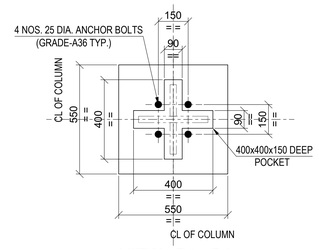

VIEW : B1 - B1

(FOR C2 COLUMN)

(SCALE- 1:15)

SCHEDULE OF BOLTS (ASTM 1554)

D BOLT DIA. MM	BxB BOTTOM PLATE (SQUARE) SQ MM	DIMENSIONS (MM)				
		L	A	C	T	H
25	75x75	600	175	125	12	30

LEGEND :-

RL. - REDUCED LEVEL.
T.O.C. - TOP OF CONCRETE.
F.G.L. - FINISHED GROUND LEVEL.
B.O.F. - BOTTOM OF FOOTING.
CL - CENTRE LINE.
TYP. - TYPICAL.
THK. - THICK.
MKD. - MARKED.
G.A. - GENERAL ARRANGEMENT.

NOTES :-

1. ALL DIMENSIONS ARE IN MILLIMETERS AND LEVELS AND CO-ORDINATES ARE IN METERS. UNLESS OTHERWISE STATED.
2. GRADE OF CONCRETE SHALL BE 35 MPa FOR FOUNDATION & 15 MPa FOR BLINDING CONCRETE.
3. GRADE OF REINFORCEMENT SHALL BE DEFORMED BAR 420 MPa (GRADE 60) - ASTM A615/A615M.
4. NET SAFE BEARING CAPACITY OF SOIL AT BOTTOM OF FOUNDATION CONSIDER 450KN/ SQ. M.
5. CLEAR COVER TO MAIN REINFORCEMENT SHALL BE 75 mm FOR RAFT & 50 mm FOR COLUMN.
6. IF ANY PART OF FOUNDATION COMES ON BACKFILL ZONE OF ADJACENT FOUNDATION OR ANY LOOSE SOIL ARE ENCOUNTERED BELOW FOUNDATION LEVEL THE SAME SHALL BE REMOVED AND FILLED WITH PCC.
7. THIS DRAWING SHALL BE READ IN CONJUNCTION WITH DRAWING NO. MD-216-49PR-EG-ST-GAD-2419.
8. ALL OTHER NOTES REFER DRAWING NO. MD-101-SMEM-EG-ST-DST-0001 TO 0008.
9. GENERAL NOTES FOR CIVIL WORKS & STANDARD REINFORCEMENT DETAIL REFER DRAWING NO. MD-216-1000-EG-CV-DED-1001 & 1005.

DOCUMENT NUMBER	REFERENCE DOCUMENTS			REVISION DESCRIPTION	DRN	CHK	ENG	APP	EMP
		D01	17/02/2023	AS-BUILT	AMJ	SGC	SHD	PRI	
		C02	01/10/2020	ISSUED FOR CONSTRUCTION AND REVISED AS MKD. /C02	AMJ	SGC	SHD	PRI	
		C01	01/06/2020	ISSUED FOR CONSTRUCTION	PDK	SGC	SHD	PRI	
MD-216-49PR-EG-ME-GAD-V553-1048	COMPACT WORKSHOP & WAREHOUSE,	A01	07/05/2020	ISSUED FOR REFERENCE	PDK	SGC	SHD	PRI	
	PLAN, SECTION & ELEVATIONS								

RESERVED FOR VENDOR LOGO AND DRAWING NUMBER

LARSEN & TOUBRO

This drawing is the property of LARSEN & TOUBRO and must not be passed on to any person or body not authorized by us to receive it nor be copied or otherwise made use either in full or in part by such person or body without our prior permission in writing.

Outotec

The content of these documents are the sole property of Outotec Oyj. Any rights not expressly granted herein are reserved. Reproduction, transfer or distribution of part or all of the contents in any form without prior written permission of Outotec is prohibited.

MA'ADEN معادن Saudi Arabian Mining Company شركة معادن العربية السعودية

This document and the information contained herein is Ma'aden proprietary know-how. This document or any part thereof should not be reproduced, stored in a retrieval system or transmitted by any means, electronic or otherwise, or divulged without prior written permission of Ma'aden.

LARSEN & TOUBRO DRAWING NUMBER: O19045_008_C_G_24290_006 — REVISION: 3

OUTOTEC DRAWING NUMBER: 900707__GAU01__WG01__MTL01__45052 — DOCUMENT ID: OU100682328 — REVISION: 3

DRAWN	PDK	22/04/2020
CHECKED	SGC	24/04/2020
ENGINEER	SHD	20/04/2020
APPROVED	PRI	07/05/2020
EMPLOYER		

SCALE 1:75, 1:25 & 1:15 — A1

MANSOURAH - MASSARAH GOLD PROJECT

GENERAL ARRANGEMENT

COMPACT WORKSHOP & WAREHOUSE

G.A. AND DETAIL OF FOUNDATION

DRAWING NUMBER: MD-216-49PR-EG-CV-GAD-1623 — REV: D01