
DRAWING NUMBER: MD-216-39WL-EG-CV-GAD-1698 | REV: D01

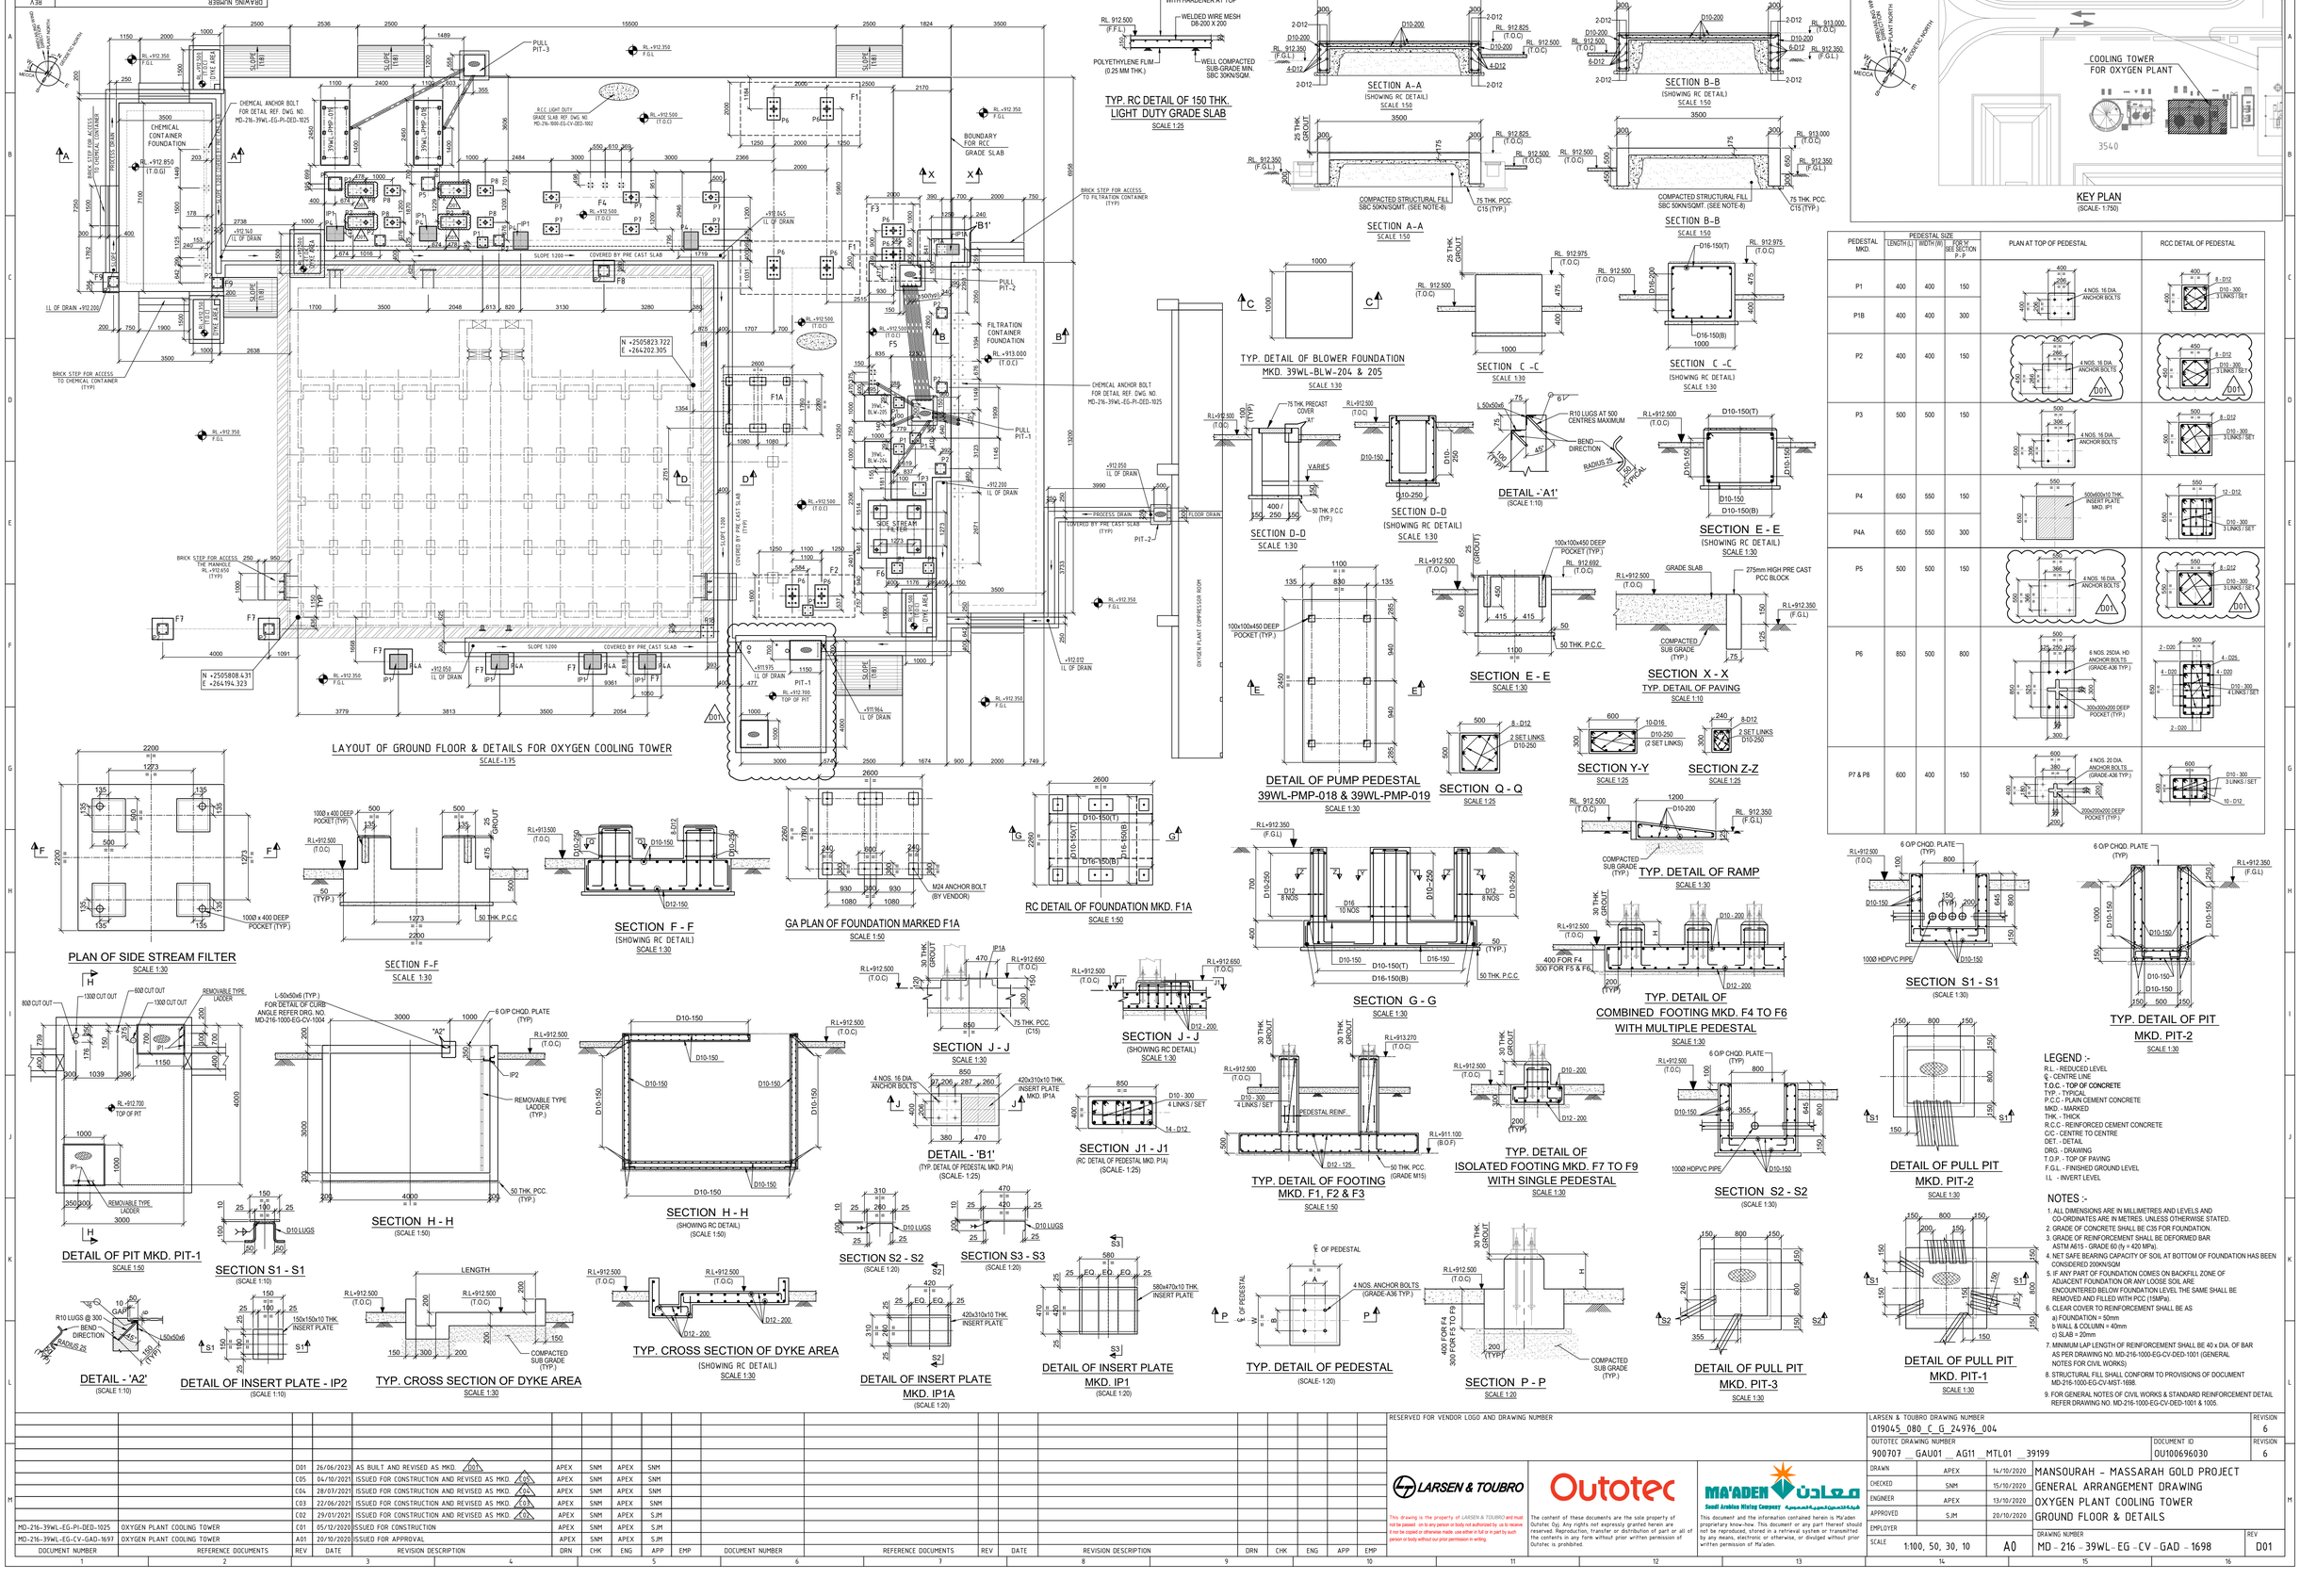

PEDESTAL MKD.	PEDESTAL SIZE LENGTH (L)	WIDTH (W)	FOR 'H' SEE SECTION P-P	PLAN AT TOP OF PEDESTAL	RCC DETAIL OF PEDESTAL
P1	400	400	150	4 NOS. 16 DIA. ANCHOR BOLTS	8 - D12; D10 - 300 3 LINKS / SET
P1B	400	400	300	4 NOS. 16 DIA. ANCHOR BOLTS	8 - D12; D10 - 300 3 LINKS / SET
P2	400	400	150	4 NOS. 16 DIA. ANCHOR BOLTS	8 - D12; D10 - 300 3 LINKS / SET
P3	500	500	150	4 NOS. 16 DIA. ANCHOR BOLTS	8 - D12; D10 - 300 3 LINKS / SET
P4	650	550	150	500x600x10 THK. INSERT PLATE MKD. IP1	12 - D12; D10 - 300 3 LINKS / SET
P4A	650	550	300		
P5	500	500	150	4 NOS. 16 DIA. ANCHOR BOLTS	8 - D12; D10 - 300 3 LINKS / SET
P6	850	500	800	6 NOS. 25DIA. HD ANCHOR BOLTS (GRADE-A36 TYP.); 300x300x200 DEEP POCKET (TYP.)	4 - D25; 8 - D20; D10 - 300 4 LINKS / SET
P7 & P8	600	400	150	4 NOS. 20 DIA. ANCHOR BOLTS (GRADE-A36 TYP.); 200x200x200 DEEP POCKET (TYP.)	D10 - 300 3 LINKS / SET; 10 - D12

LEGEND :-
RL - REDUCED LEVEL
℄ - CENTRE LINE
T.O.C - TOP OF CONCRETE
TYP. - TYPICAL
P.C.C - PLAIN CEMENT CONCRETE
MKD. - MARKED
THK. - THICK
R.C.C. - REINFORCED CEMENT CONCRETE
C/C - CENTRE TO CENTRE
DET. - DETAIL
DRG. - DRAWING
T.O.P. - TOP OF PAVING
F.G.L. - FINISHED GROUND LEVEL
I.L. - INVERT LEVEL

NOTES :-
1. ALL DIMENSIONS ARE IN MILLIMETRES AND LEVELS AND CO-ORDINATES ARE IN METRES. UNLESS OTHERWISE STATED.
2. GRADE OF CONCRETE SHALL BE C35 FOR FOUNDATION.
3. GRADE OF REINFORCEMENT SHALL BE DEFORMED BAR ASTM A615 - GRADE 60 (fy = 420 MPa).
4. NET SAFE BEARING CAPACITY OF SOIL AT BOTTOM OF FOUNDATION HAS BEEN CONSIDERED 200KN/SQM
5. IF ANY PART OF FOUNDATION COMES ON BACKFILL ZONE OF ADJACENT FOUNDATION OR ANY LOOSE SOIL ARE ENCOUNTERED BELOW FOUNDATION LEVEL THE SAME SHALL BE REMOVED AND FILLED WITH PCC (15MPa).
6. CLEAR COVER TO REINFORCEMENT SHALL BE AS
a) FOUNDATION = 50mm
b) WALL & COLUMN = 40mm
c) SLAB = 20mm
7. MINIMUM LAP LENGTH OF REINFORCEMENT SHALL BE 40 x DIA. OF BAR AS PER DRAWING NO. MD-216-1000-EG-CV-DED-1001 (GENERAL NOTES FOR CIVIL WORKS)
8. STRUCTURAL FILL SHALL CONFORM TO PROVISIONS OF DOCUMENT MD-216-1000-EG-CV-MST-1698.
9. FOR GENERAL NOTES OF CIVIL WORKS & STANDARD REINFORCEMENT DETAIL REFER DRAWING NO. MD-216-1000-EG-CV-DED-1001 & 1005.

REV	DATE	REVISION DESCRIPTION	DRN	CHK	ENG	APP	EMP
D01	26/06/2023	AS BUILT AND REVISED AS MKD. (D01)	APEX	SNM	APEX	SNM	
C05	04/10/2021	ISSUED FOR CONSTRUCTION AND REVISED AS MKD. (C05)	APEX	SNM	APEX	SNM	
C04	28/07/2021	ISSUED FOR CONSTRUCTION AND REVISED AS MKD. (C04)	APEX	SNM	APEX	SNM	
C03	22/06/2021	ISSUED FOR CONSTRUCTION AND REVISED AS MKD. (C03)	APEX	SNM	APEX	SNM	
C02	29/01/2021	ISSUED FOR CONSTRUCTION AND REVISED AS MKD. (C02)	APEX	SNM	APEX	SJM	
C01	05/12/2020	ISSUED FOR CONSTRUCTION	APEX	SNM	APEX	SJM	
A01	20/10/2020	ISSUED FOR APPROVAL	APEX	SNM	APEX	SJM	

DOCUMENT NUMBER	REFERENCE DOCUMENTS
MD-216-39WL-EG-PI-DED-1025	OXYGEN PLANT COOLING TOWER
MD-216-39WL-EG-CV-GAD-1697	OXYGEN PLANT COOLING TOWER

RESERVED FOR VENDOR LOGO AND DRAWING NUMBER

LARSEN & TOUBRO DRAWING NUMBER: 019045_080_C_G_24976_004 | REVISION: 6
OUTOTEC DRAWING NUMBER: 900707__GAU01__AG11__MTL01__39199 | DOCUMENT ID: OU100696030 | REVISION: 6

DRAWN	APEX	14/10/2020	MANSOURAH - MASSARAH GOLD PROJECT
CHECKED	SNM	15/10/2020	GENERAL ARRANGEMENT DRAWING
ENGINEER	APEX	13/10/2020	OXYGEN PLANT COOLING TOWER
APPROVED	SJM	20/10/2020	GROUND FLOOR & DETAILS
EMPLOYER			
SCALE	1:100, 50, 30, 10	A0	DRAWING NUMBER: MD-216-39WL-EG-CV-GAD-1698	REV: D01

LARSEN & TOUBRO
This drawing is the property of LARSEN & TOUBRO and must not be passed on to any person or body not authorized by us to receive it nor be copied or otherwise made use either in full or in part by such person or body without our prior permission in writing.
Outotec
The content of these documents are the sole property of Outotec Oy. Any rights not expressly granted herein are reserved. Reproduction, transfer or distribution of part or all of the contents in any form without prior written permission of Outotec is prohibited.
MA'ADEN
Saudi Arabian Mining Company
This document and the information contained herein is Ma'aden proprietary know-how. This document or any part thereof should not be reproduced, stored in a retrieval system or transmitted by any means, electronic or otherwise, or divulged without prior written permission of Ma'aden.