


DRAWING NUMBER: MD-216-39WL-EG-CV-GAD-1699 | REV: D01

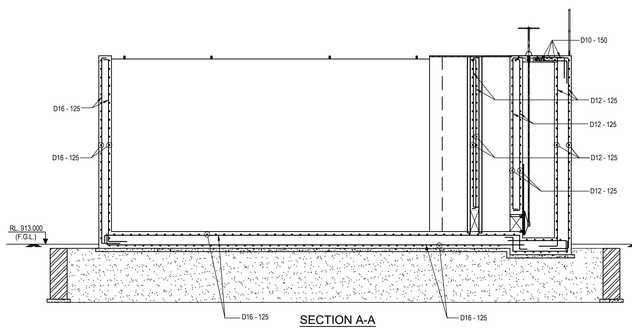

SECTION A-A
R.C.C DETAILS
SCALE 1:50

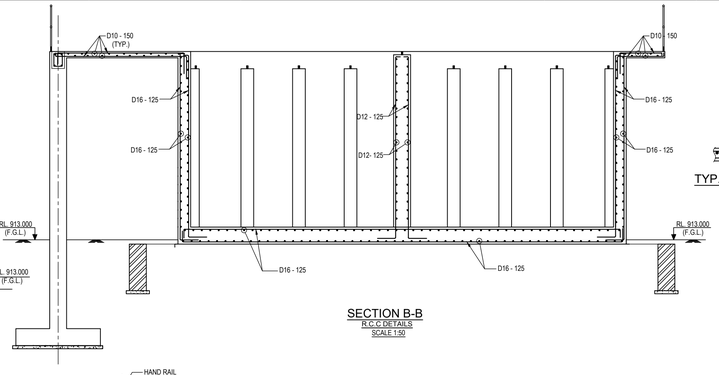


SECTION B-B
R.C.C DETAILS
SCALE 1:50

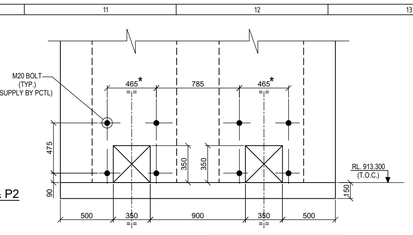


VIEW F-F
SCALE 1:20


* TO BE CHECKED WITH SLUICE GATE ITEM AT SITE DUE TO TOLERANCE OF BOLT POSITION

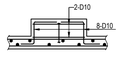


TYP. SECTION OF P1 & P2
R.C.C DETAILS
SCALE 1:25

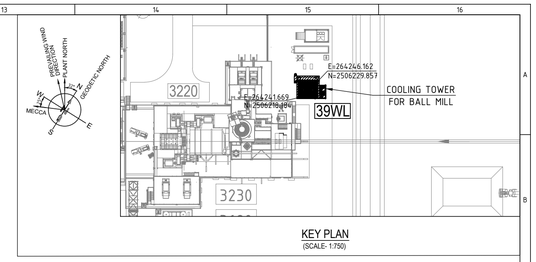


KEY PLAN
(SCALE- 1:750)

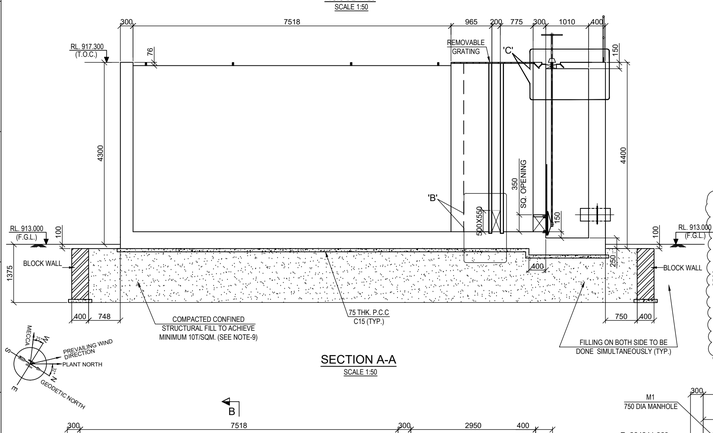


SECTION A-A
SCALE 1:50

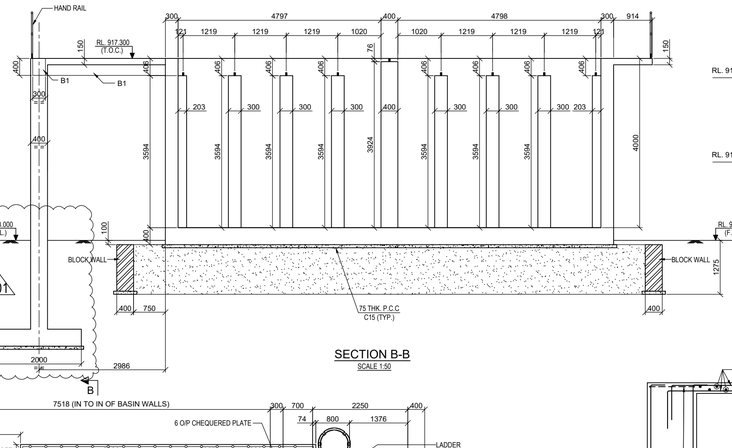


SECTION B-B
SCALE 1:50

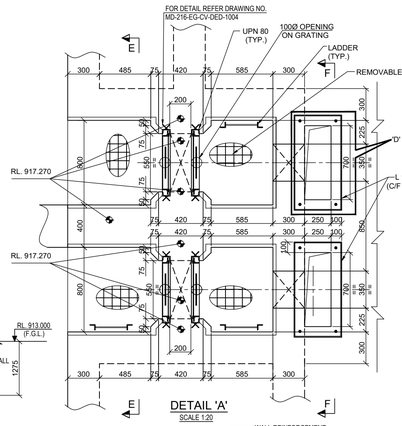


DETAIL 'A'
SCALE 1:20

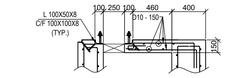


DETAIL 'C'
R.C.C DETAILS
SCALE 1:25

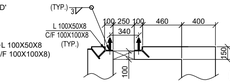


DETAIL 'C'
SCALE 1:25

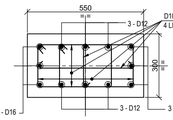


R.C DETAILS OF P4
SCALE 1:10

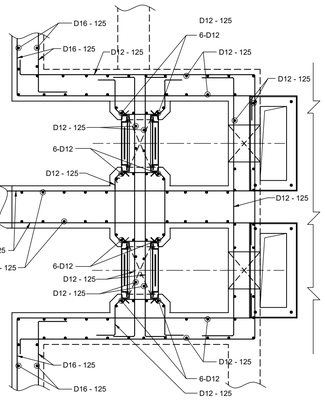


DETAIL 'A'
SCALE 1:20

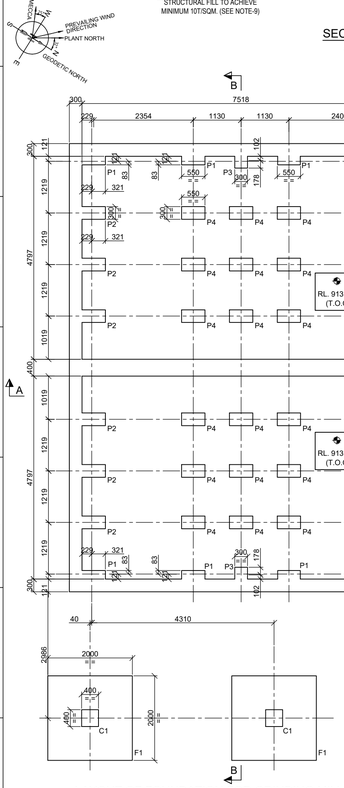


LAYOUT OF FOUNDATION FOR GRINDING MILL COOLING TOWER
SCALE 1:50

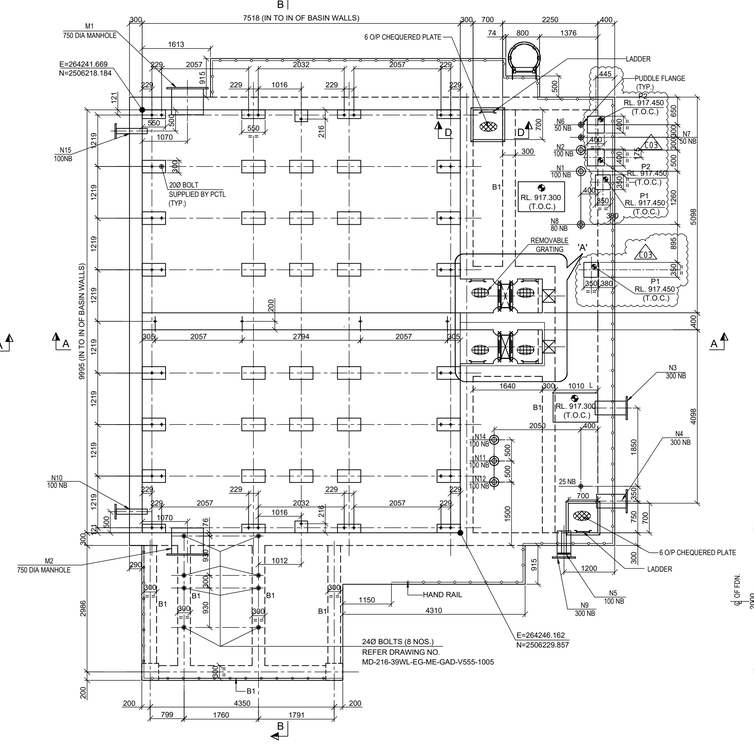


PLAN OF GRINDING MILL COOLING TOWER AT RL. 917.450
SCALE 1:50

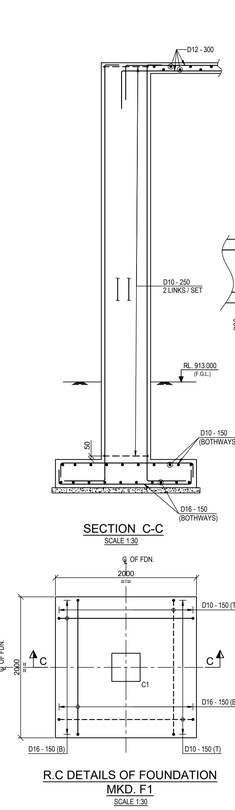


SECTION C-C
SCALE 1:30

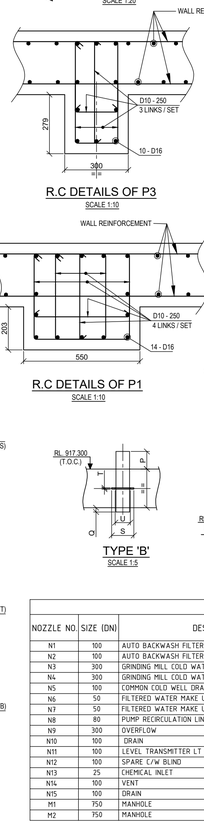


R.C DETAILS OF P3
SCALE 1:10

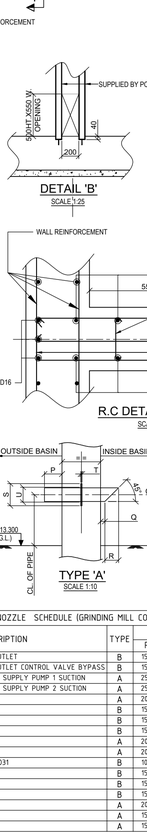


DETAIL 'B'
SCALE 1:25

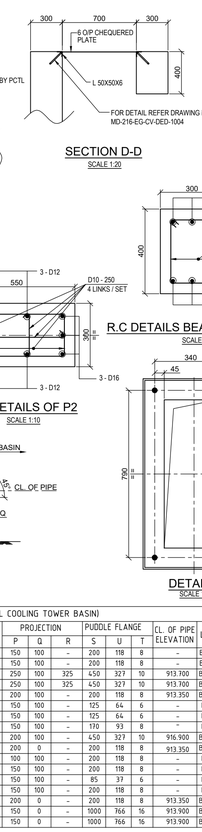

SECTION D-D
SCALE 1:20

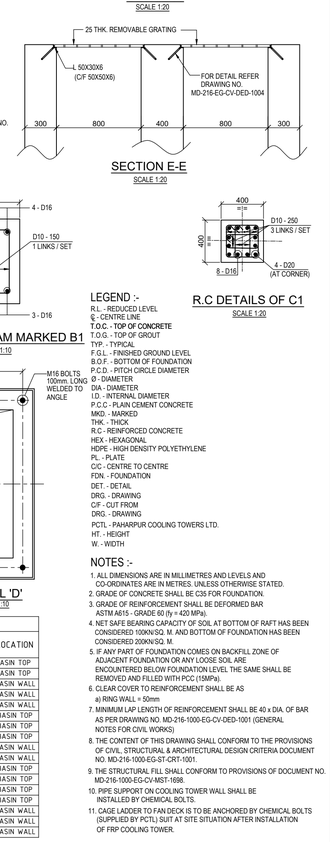


SECTION E-E
SCALE 1:20

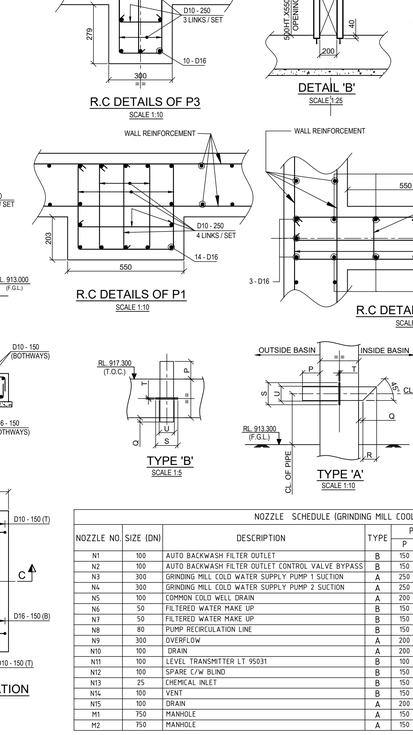

R.C DETAILS OF P1
SCALE 1:10

R.C DETAILS OF P2
SCALE 1:10

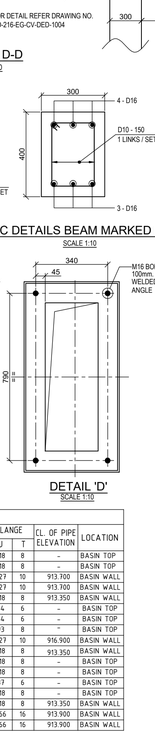

R.C DETAILS BEAM MARKED B1
SCALE 1:10

R.C DETAILS OF C1
SCALE 1:20

TYPE 'B'
SCALE 1:5

TYPE 'A'
SCALE 1:10

DETAIL 'D'
SCALE 1:10

R.C DETAILS OF FOUNDATION MKD. F1
SCALE 1:30

NOZZLE SCHEDULE (GRINDING MILL COOLING TOWER BASIN)

NOZZLE NO.	SIZE (DN)	DESCRIPTION	TYPE	PROJECTION P	PROJECTION Q	PROJECTION R	PUDDLE FLANGE S	PUDDLE FLANGE U	PUDDLE FLANGE T	CL OF PIPE ELEVATION	LOCATION
N1	100	AUTO BACKWASH FILTER OUTLET	B	150	100	-	200	118	8	-	BASIN TOP
N2	100	AUTO BACKWASH FILTER OUTLET CONTROL VALVE BYPASS	B	150	100	-	200	118	8	-	BASIN WALL
N3	300	GRINDING MILL COLD WATER SUPPLY PUMP 1 SUCTION	A	250	100	325	450	327	10	913.700	BASIN WALL
N4	300	GRINDING MILL COLD WATER SUPPLY PUMP 2 SUCTION	A	250	100	325	450	327	10	913.700	BASIN WALL
N5	100	COMMON COLD WELL DRAIN	A	200	100	-	200	118	8	913.350	BASIN WALL
N6	50	FILTERED WATER MAKE UP	B	150	100	-	125	64	6	-	BASIN TOP
N7	50	FILTERED WATER MAKE UP	B	150	100	-	125	64	6	-	BASIN TOP
N8	80	PUMP RECIRCULATION LINE	B	150	100	-	170	93	8	-	BASIN TOP
N9	300	OVERFLOW	A	200	100	-	450	327	10	916.900	BASIN WALL
N10	100	DRAIN	A	200	0	-	200	118	8	913.350	BASIN WALL
N11	100	LEVEL TRANSMITTER LT 95031	B	100	100	-	200	118	8	-	BASIN TOP
N12	100	SPARE C/W BLIND	B	150	100	-	200	118	8	-	BASIN TOP
N13	25	CHEMICAL INLET	B	150	100	-	85	37	6	-	BASIN TOP
N14	100	VENT	B	150	100	-	200	118	8	-	BASIN TOP
N15	100	DRAIN	A	200	0	-	200	118	8	913.350	BASIN WALL
M1	750	MANHOLE	A	150	0	-	1000	766	16	913.900	BASIN WALL
M2	750	MANHOLE	A	150	0	-	1000	766	16	913.900	BASIN WALL

LEGEND :-

R.L. - REDUCED LEVEL
℄ - CENTRE LINE
T.O.C. - TOP OF CONCRETE
T.O.G. - TOP OF GROUT
TYP. - TYPICAL
F.G.L. - FINISHED GROUND LEVEL
B.O.F. - BOTTOM OF FOUNDATION
P.C.D. - PITCH CIRCLE DIAMETER
Ø - DIAMETER
DIA - DIAMETER
I.D. - INTERNAL DIAMETER
P.C.C. - PLAIN CEMENT CONCRETE
MKD. - MARKED
THK. - THICK
R.C - REINFORCED CONCRETE
HEX - HEXAGONAL
HDPE - HIGH DENSITY POLYETHYLENE
PL. - PLATE
C/C - CENTRE TO CENTRE
FDN. - FOUNDATION
DET. - DETAIL
DRG. - DRAWING
C/F - CUT FROM
DRG. - DRAWING
PCTL - PAHARPUR COOLING TOWERS LTD.
HT. - HEIGHT
W. - WIDTH

NOTES :-

1. ALL DIMENSIONS ARE IN MILLIMETRES AND LEVELS AND CO-ORDINATES ARE IN METRES, UNLESS OTHERWISE STATED.
2. GRADE OF CONCRETE SHALL BE C35 FOR FOUNDATION.
3. GRADE OF REINFORCEMENT SHALL BE DEFORMED BAR ASTM A615 - GRADE 60 (fy = 420 MPa).
4. NET SAFE BEARING CAPACITY OF SOIL AT BOTTOM OF RAFT HAS BEEN CONSIDERED 100KN/SQ. M. AND BOTTOM OF FOUNDATION HAS BEEN CONSIDERED 200KN/SQ. M.
5. IF ANY PART OF FOUNDATION COMES ON BACKFILL ZONE OF ADJACENT FOUNDATION OR ANY LOOSE SOIL ARE ENCOUNTERED BELOW FOUNDATION LEVEL THE SAME SHALL BE REMOVED AND FILLED WITH PCC (15MPa).
6. CLEAR COVER TO REINFORCEMENT SHALL BE AS
   a) RING WALL = 50mm
7. MINIMUM LAP LENGTH OF REINFORCEMENT SHALL BE 40 x DIA. OF BAR AS PER DRAWING NO. MD-216-1000-EG-CV-DED-1001 (GENERAL NOTES FOR CIVIL WORKS)
8. THE CONTENT OF THIS DRAWING SHALL CONFORM TO THE PROVISIONS OF CIVIL, STRUCTURAL & ARCHITECTURAL DESIGN CRITERIA DOCUMENT NO. MD-216-1000-EG-ST-CRT-1001.
9. THE STRUCTURAL FILL SHALL CONFORM TO PROVISIONS OF DOCUMENT NO. MD-216-1000-EG-CV-MST-1698.
10. PIPE SUPPORT ON COOLING TOWER WALL SHALL BE INSTALLED BY CHEMICAL BOLTS.
11. CAGE LADDER TO FAN DECK IS TO BE ANCHORED BY CHEMICAL BOLTS (SUPPLIED BY PCTL) SUIT AT SITE SITUATION AFTER INSTALLATION OF FRP COOLING TOWER.

DOCUMENT NUMBER	REFERENCE DOCUMENTS	REV	DATE	REVISION DESCRIPTION	DRN	CHK	ENG	APP	EMP
		D01	26/06/2023	AS-BUILT AND REVISED AS MARKED (20)	AUD	SJM	SNM	AG	
		C03	06/04/2021	ISSUED FOR CONSTRUCTION & REVISED AS MARKED (20)	AUD	SJM	SNM	AG	
MD-216-39WL-EG-ME-GAD-V555-1019	SLUICE GATE FOR GRINDING MILL COOLING TOWER	C02	30/12/2020	ISSUED FOR CONSTRUCTION & REVISED AS MARKED (20)	SYA	SJM	SNM	AG	
MD-216-39WL-EG-ME-GAD-V555-1004	GRINDING MILL COOLING TOWER	C01	09/10/2020	ISSUED FOR CONSTRUCTION & REVISED AS MARKED (20)	SYA	SJM	SNM	AG	
MD-216-39WL-EG-ME-GAD-V555-1001	GRINDING MILL COOLING TOWER	A01	10/09/2020	ISSUED FOR APPROVAL	SYA	SJM	SNM	AG	

RESERVED FOR VENDOR LOGO AND DRAWING NUMBER

LARSEN & TOUBRO

This drawing is the property of LARSEN & TOUBRO and must not be passed on to any person or body not authorized by us to receive it nor be copied or otherwise made use either in full or in part by such person or body without our prior permission in writing.

Outotec

The content of these documents are the sole property of Outotec Oy. Any rights not expressly granted herein are reserved. Reproduction, transfer or distribution of part or all of the contents in any form without prior written permission of Outotec is prohibited.

MA'ADEN معادن
Saudi Arabian Mining Company

This document and the information contained herein is Ma'aden proprietary know-how. This document or any part thereof should not be reproduced, stored in a retrieval system or transmitted by any means, electronic or otherwise, or divulged without prior written permission of Ma'aden.

LARSEN & TOUBRO DRAWING NUMBER	REVISION 4
019045_080_C_G_24976_005	
OUTOTEC DRAWING NUMBER	DOCUMENT ID / REVISION
900707__GAU01__AG11__MTL01__39200	0U100696031 / 4
DRAWN SYA 07/09/2020	MANSOURAH - MASSARAH GOLD PROJECT
CHECKED SJM 09/09/2020	GENERAL ARRANGEMENT DRAWING
ENGINEER SNM 07/09/2020	BALL MILL COOLING TOWER
APPROVED AG 10/09/2020	PLAN, ELEVATION AND DETAILS
EMPLOYER	
SCALE 1:50, 25, 20, 10 A0	DRAWING NUMBER: MD-216-39WL-EG-CV-GAD-1699 REV: D01