

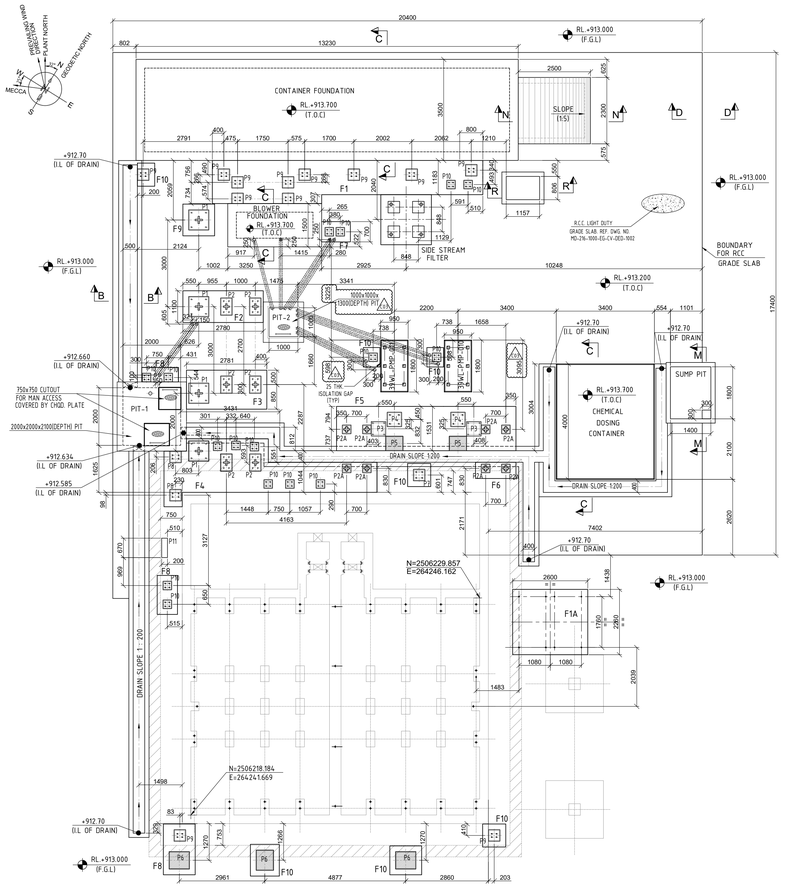



LAYOUT OF BALL MILL COOLING TOWER GROUND FLOOR
SCALE-1:75

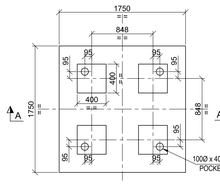


PLAN OF SIDE STREAM FILTER
SCALE 1:30

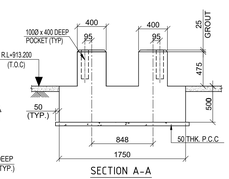


SECTION A-A
SCALE 1:30

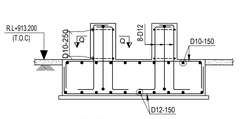


SECTION A - A
(SHOWING RC DETAIL)
SCALE 1:30

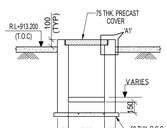


SECTION B-B
SCALE 1:30

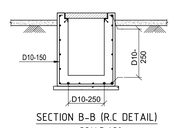


SECTION B-B (R.C DETAIL)
SCALE 1:30

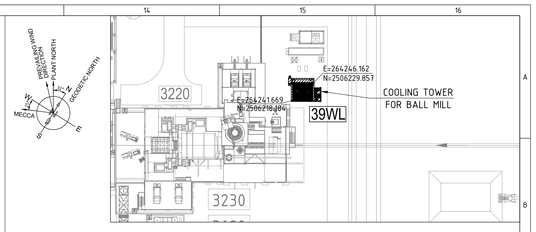


KEY PLAN
(SCALE- 1:750)

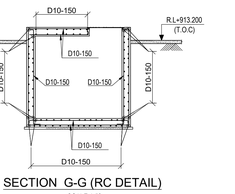

GA PLAN OF FOUNDATION MARKED F1A
SCALE 1:50

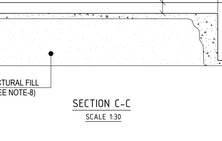


RC DETAIL OF FOUNDATION MKD. F1A
SCALE 1:50

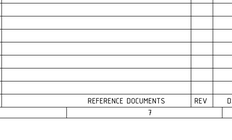


DETAIL OF PIT MKD. PIT-1
SCALE 1:50


SECTION G-G (RC DETAIL)
SCALE 1:50

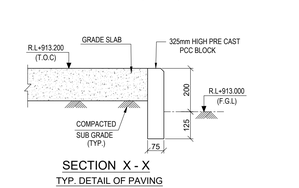


SECTION X - X
TYP. DETAIL OF PAVING
SCALE 1:10

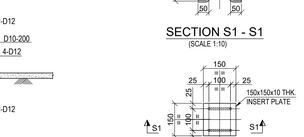


SECTION X-X
SCALE 1:30

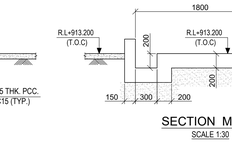


DETAIL OF PEDESTAL
39WL-PMP-010 & 39WL-PMP-011
SCALE 1:30

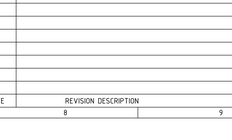


SECTION G-G
(SCALE 1:50)

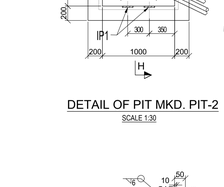


G.A SECTION E-E
SCALE 1:30

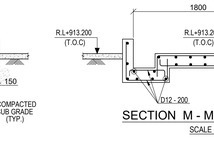


SECTION E-E (RC DETAIL)
SCALE 1:30

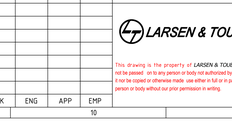

DETAIL OF PIT MKD. PIT-2
SCALE 1:30

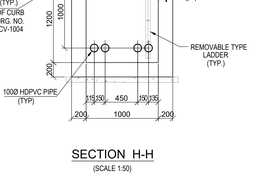

SECTION H-H
(SCALE 1:50)

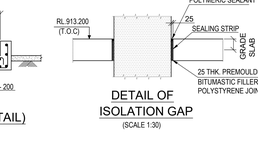

SECTION H1-H1
(SCALE 1:50)




SECTION P - P
SCALE 1:20

DETAIL 'A1'
(SCALE 1:10)


TYP. DETAIL OF PEDESTAL
(SCALE- 1:20)

SCHEDULE OF PEDESTAL


PEDESTAL MKD.	PEDESTAL SIZE LENGTH (L)	WIDTH (W)	FOR 'H' SEE SECTION P - P	PLAN AT TOP OF PEDESTAL	RCC DETAIL OF PEDESTAL
P1	700	700	150	4 NOS. 32 DIA. ANCHOR BOLTS (GRADE-A36 TYP.) 250x250x200 DEEP POCKET (TYP.)	12 - D12; D10 - 300 3 LINKS / SET
P2	600	400	150	4 NOS. 20 DIA. ANCHOR BOLTS (GRADE-A36 TYP.) 200x200x200 DEEP POCKET (TYP.)	D10 - 300 3 LINKS / SET; 10 - D12
P2A	300	300	150	4 NOS. 20 DIA. ANCHOR BOLTS (GRADE-A36 TYP.) 200x200x200 DEEP POCKET (TYP.)	4 - D12; D10 - 300 1 LINKS / SET
P3	500	500	150	4 NOS. 16 DIA. BOLT	8 - D12; D10 - 300 3 LINKS / SET
P4	500	500	150	4 NOS. 20 DIA. BOLT	8 - D12; D10 - 300 3 LINKS / SET
P5	600	500	150	550x450x10 THK. INSERT PLATE MKD. IP2	D10 - 300 3 LINKS / SET; 10 - D12
P6	700	600	150	650x550x10 THK. INSERT PLATE MKD. IP3	12 - D12; D10 - 300 3 LINKS / SET
P7	400	400	150	4 NOS. 16 DIA. BOLT	8 - D12; D10 - 300 3 LINKS / SET
P8	400	400	150	4 NOS. 16 DIA. BOLT	8 - D12; D10 - 300 3 LINKS / SET
P9	400	400	150	4 NOS. 16 DIA. BOLT	8 - D12; D10 - 300 3 LINKS / SET
P10	300	300	150	4 NOS. 16 DIA. BOLT	4 - D12; D10 - 300 3 LINKS / SET

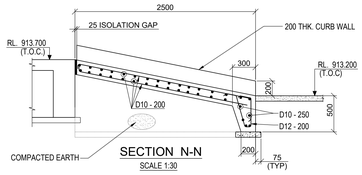


SECTION N-N
SCALE 1:30

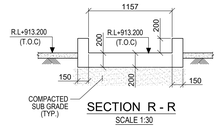


SECTION R - R
SCALE 1:30

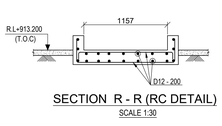


SECTION R - R (RC DETAIL)
SCALE 1:30

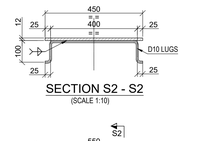


SECTION S2 - S2
(SCALE 1:10)

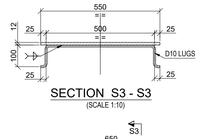


SECTION S3 - S3
(SCALE 1:10)

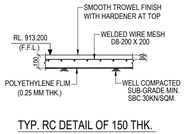


TYP. RC DETAIL OF 150 THK. LIGHT DUTY GRADE SLAB
SCALE 1:25

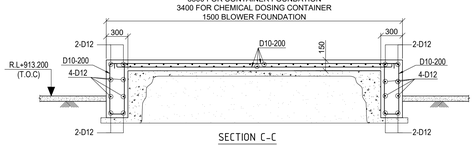


SECTION C-C
SHOWING RC DETAIL)
SCALE 1:30

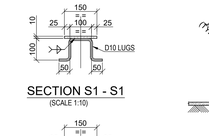

DETAIL OF INSERT PLATE - IP1
(SCALE 1:10)

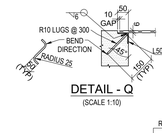


DETAIL - Q
(SCALE 1:10)

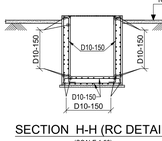


SECTION H-H (RC DETAIL)
(SCALE 1:50)


TYP. DETAIL OF ISOLATED FOOTING MKD. F9 & F10 WITH SINGLE PEDESTAL
SCALE 1:30

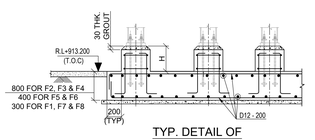


TYP. DETAIL OF COMBINED FOOTING MKD. F1 TO F8 WITH MULTIPLE PEDESTAL
SCALE 1:30

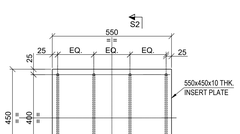

DETAIL OF INSERT PLATE - IP2
(SCALE 1:10)

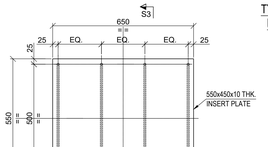

DETAIL OF INSERT PLATE - IP3
(SCALE 1:10)

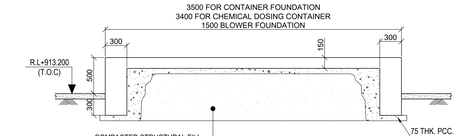


SECTION C-C
SCALE 1:30

SECTION M - M
SCALE 1:30

SECTION M - M (RC DETAIL)
SCALE 1:30

DETAIL OF ISOLATION GAP
(SCALE 1:30)

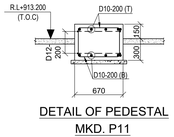

DETAIL OF PEDESTAL MKD. P11
SCALE 1:30

LEGEND :-
R.L - REDUCED LEVEL
℄ - CENTRE LINE
T.O.C - TOP OF CONCRETE
TYP - TYPICAL
P.C.C - PLAIN CEMENT CONCRETE
MKD - MARKED
THK - THICK
R.C.C - REINFORCED CEMENT CONCRETE
C/C - CENTRE TO CENTRE
DET. - DETAIL
DRG. - DRAWING
T.O.P - TOP OF PAVING
F.G.L - FINISHED GROUND LEVEL
I.L - INVERT LEVEL

NOTES :-
1. ALL DIMENSIONS ARE IN MILLIMETRES AND LEVELS AND CO-ORDINATES ARE IN METRES. UNLESS OTHERWISE STATED.
2. GRADE OF CONCRETE SHALL BE C35 FOR FOUNDATION.
3. GRADE OF REINFORCEMENT SHALL BE DEFORMED BAR ASTM A615 - GRADE 60 (fy = 420 MPa).
4. NET SAFE BEARING CAPACITY OF SOIL AT BOTTOM OF FOUNDATION HAS BEEN CONSIDERED 200KN/SQM
5. IF ANY PART OF FOUNDATION COMES ON BACKFILL ZONE OF ADJACENT FOUNDATION OR ANY LOOSE SOIL ARE ENCOUNTERED BELOW FOUNDATION LEVEL THE SAME SHALL BE REMOVED AND FILLED WITH PCC (15MPa).
6. CLEAR COVER TO REINFORCEMENT SHALL BE AS
   a) FOUNDATION = 50mm
   b WALL & COLUMN = 40mm
   c) SLAB = 20mm
7. MINIMUM LAP LENGTH OF REINFORCEMENT SHALL BE 40 x DIA. OF BAR AS PER DRAWING NO. MD-216-1000-EG-CV-DED-1001 (GENERAL NOTES FOR CIVIL WORKS)
8. STRUCTURAL FILL SHALL CONFORM TO PROVISIONS OF DOCUMENT MD-216-1000-EG-CV-MST-1698.
9. FOR GENERAL NOTES OF CIVIL WORKS & STANDARD REINFORCEMENT DETAIL REFER DRAWING NO. MD-216-1000-EG-CV-DED-1001 & 1005.

DOCUMENT NUMBER	REFERENCE DOCUMENTS	REV	DATE	REVISION DESCRIPTION	DRN	CHK	ENG	APP	EMP
		D01	09/03/2023	AS-BUILT	APEX	SNM	APEX	SJM	
		C03	04/10/2021	ISSUED FOR CONSTRUCTION AND REVISED AS MKD. (C02)	APEX	SNM	APEX	SJM	
MD-216-39WL-EG-ME-GAD-V563-1022	GRINDING MILL COOLING WATER PUMP	C02	02/02/2021	ISSUED FOR CONSTRUCTION AND REVISED AS MKD. (C01)	APEX	SNM	APEX	SJM	
MD-216-39WL-EG-ME-GAD-V555-1005	STAIRCASE, PLATFORMS & LADDER FOR GRINDING MILL COOLING TOWER	C01	15/01/2021	ISSUED FOR CONSTRUCTION AND REVISED AS MKD. (C01)	APEX	SNM	APEX	SJM	
MD-216-39WL-EG-CV-GAD-1699	BALL MILL COOLING TOWER PLAN, ELEV. AND DETAIL	A01	20/10/2020	ISSUED FOR APPROVAL	APEX	SNM	APEX	SJM	

RESERVED FOR VENDOR LOGO AND DRAWING NUMBER

LARSEN & TOUBRO
This drawing is the property of LARSEN & TOUBRO and must not be passed on to any person or body not authorized by us to receive it nor be copied or otherwise made use either in full or in part by such person or body without our prior permission in writing.

Outotec
The content of these documents are the sole property of Outotec Oyj. Any rights not expressly granted herein are reserved. Reproduction, transfer or distribution of part or all of the contents in any form without prior written permission of Outotec is prohibited.

MA'ADEN معادن
Saudi Arabian Mining Company
This document and the information contained herein is Ma'aden proprietary know-how. This document or any part thereof should not be reproduced, stored in a retrieval system or transmitted by any means, electronic or otherwise, or divulged without prior written permission of Ma'aden.

LARSEN & TOUBRO DRAWING NUMBER			REVISION
019045_080_C_G_24976_006			4
OUTOTEC DRAWING NUMBER		DOCUMENT ID	REVISION
900707 __ GAU01 __ AG11 __ MTL01 __ 39201		OU100696032	4
DRAWN	APEX	14/09/2020	MANSOURAH - MASSARAH GOLD PROJECT
CHECKED	SNM	17/09/2020	GENERAL ARRANGEMENT DRAWING
ENGINEER	APEX	13/09/2020	BALL MILL COOLING TOWER
APPROVED	SJM	19/09/2020	GROUND FLOOR & DETAILS
EMPLOYER			
SCALE 1:100, 50, 30, 10	A0	DRAWING NUMBER	REV
		MD - 216 - 39WL - EG - CV - GAD - 1700	D01