MA'ADEN معادن

Saudi Arabian Mining Company شركة التعدين العربية السعودية

**Project** **Mansourah Massarah Gold Project**

**Customer:** **MA'ADEN GOLD AND BASE METALS (MA'ADEN)**

**Title:** **GENERAL ARRANGEMENT DRAWING**
**RAW WATER**
**G.A & DETAILS OF FOUNDATION**


**Document Number:** **MD-216-39WL-EG-CV-GAD-1706**
**Revision:** D01
**Revision Date:** **26.05.2023**
**Status:** **AS-BUILT**


| | | | | | | | |
|---|---|---|---|---|---|---|---|
| Outotec Document Number: | 900707 | GAU01 | AG11 | MTL01 | 39232 | OU100704408 | 5 |
| L&T Document Number: | O19045 | 080 | C | G | 24436 | 001 | 5 |
| | | | | | | | |

**REVISION HISTORY**


| Rev | Date | Revision Text | Prepared By | Reviewed By | Approved By | Employer |
|---|---|---|---|---|---|---|
| A01 | 12.10.2020 | ISSUED FOR REFERENCE | SC | TG | AG | |
| C01 | 27.11.2020 | ISSUED FOR CONSTRUCTION | SC | TG | AG | |
| C02 | 17.02.2020 | ISSUED FOR CONSTRUCTION & REVISED AS MARKED C02 | ABS | SJM | AG | |
| C03 | 15.03.2021 | ISSUED FOR CONSTRUCTION & REVISED AS MARKED C03 | ABS | SJM | AG | |
| C04 | 25.05.2021 | ISSUED FOR CONSTRUCTION & REVISED AS MARKED C04 | SYA | SJM | AG | |
| D01 | 26.05.2023 | AS- BUILT | SYA | SJM | AG | |


DRAWING NUMBER MD-216-39WL-EG-CV-GAD-1706 REV D01

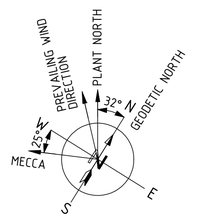

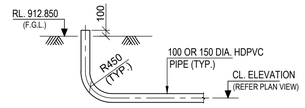


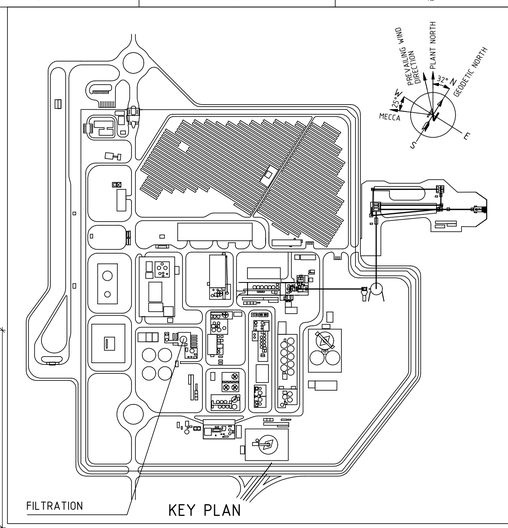

## TYP. DET. OF CONDUIT
SCALE 1:50

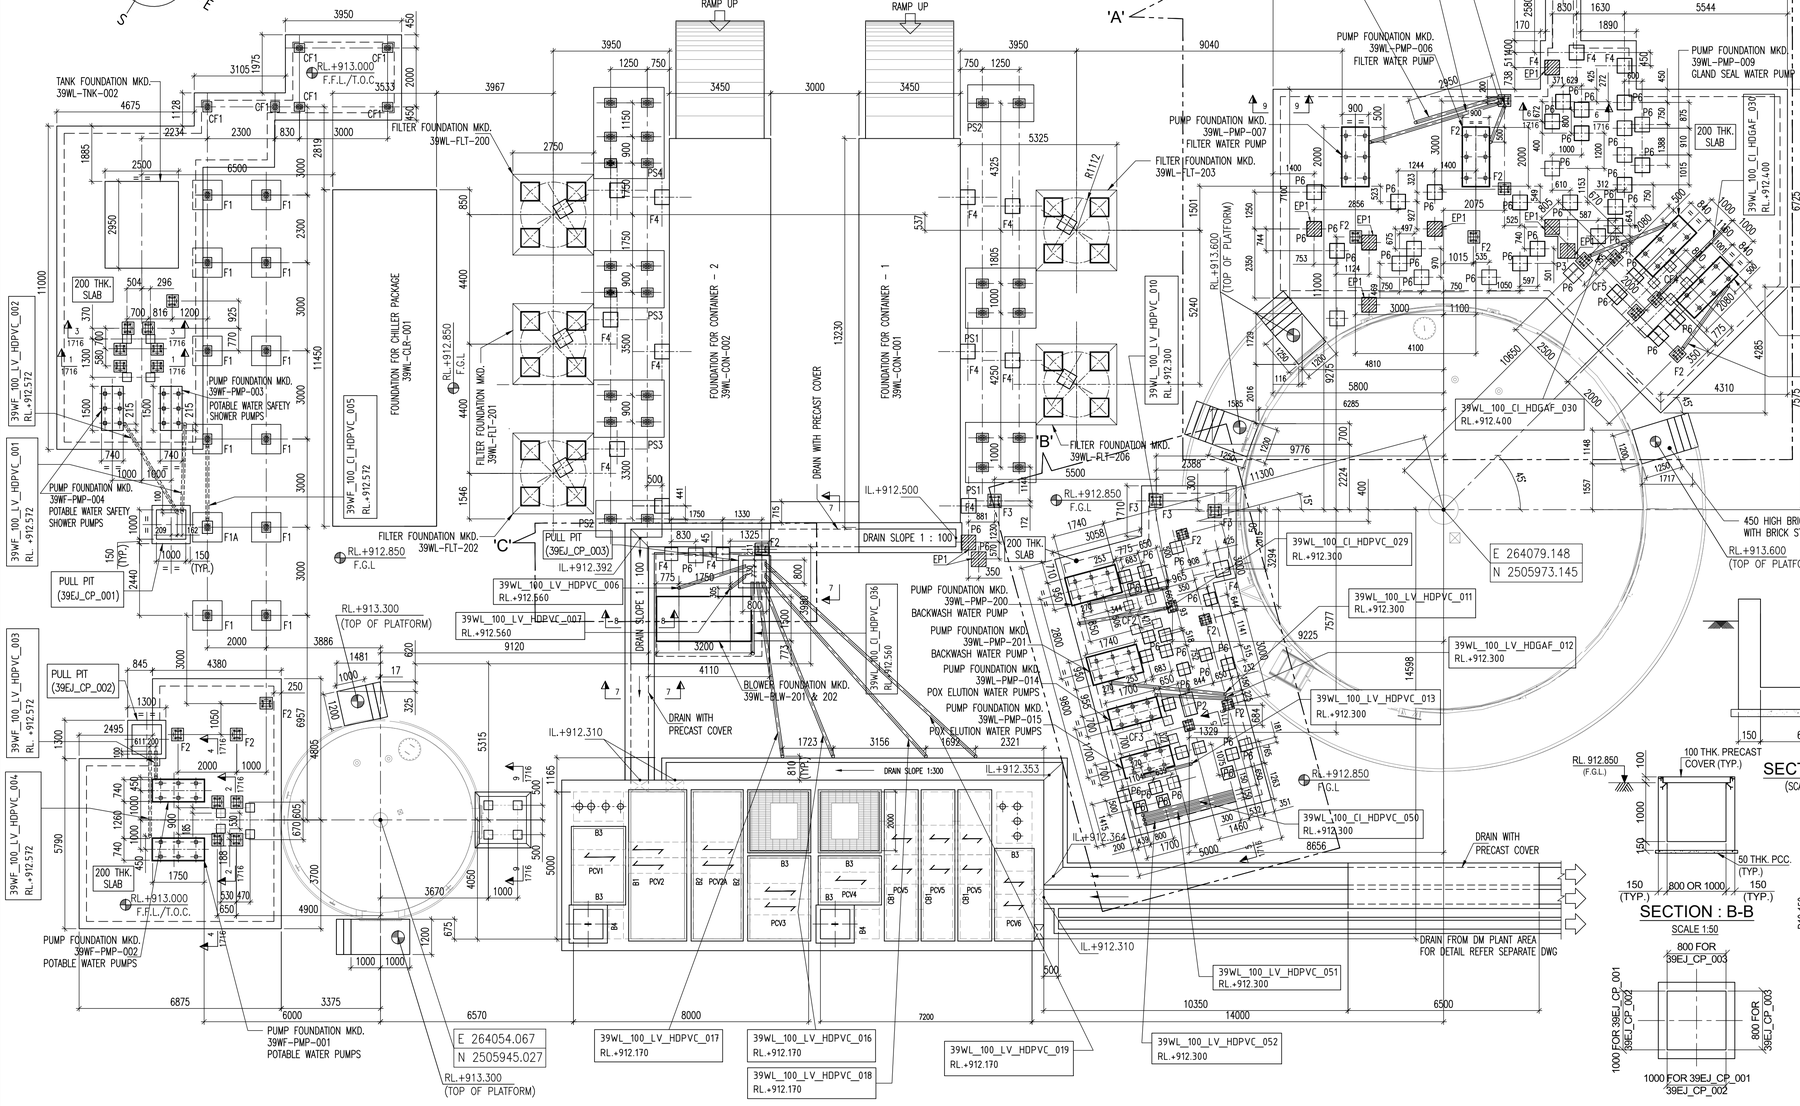



## LAYOUT OF FOUNDATIONS FOR AREA 39WL
(SCALE 1:100)

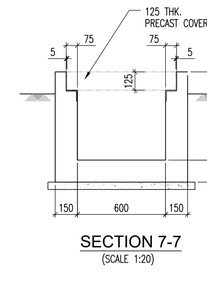



## SECTION 7-7
(SCALE 1:20)

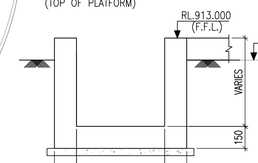


## SECTION 8-8
(SCALE 1:20)

ALL CABLE CONDUITS SHALL BE LAID AS PER ELECTRICAL DRG. MD-216-39EJ-EG-EL-LAD-1001

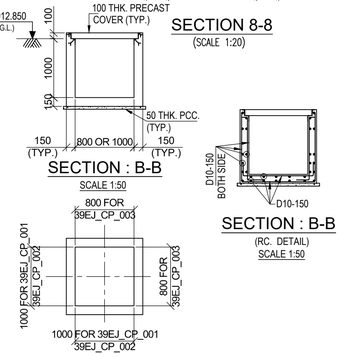


## SECTION : B-B
SCALE 1:50




## SECTION : B-B
(RC. DETAIL)
SCALE 1:50




## TYP. DET. OF PULL PIT MKD. 39EJ_CP_001,002 & 003
SCALE 1:50

## LEGEND :-

R.L. – REDUCED LEVEL
℄ – CENTRE LINE
T.O.C. – TOP OF CONCRETE
TYP. – TYPICAL
F.G.L. – FINISHED GROUND LEVEL
F.F.L. – FINISHED FLOOR LEVEL
B.O.F. – BOTTOM OF FOUNDATION
MKD. – MARKED
P.C.C – PLAIN CEMENT CONCRETE
DET. – DETAIL
SQ. – SQUARE
R.C. – REINFORCED CONCRETE
FDN. – FOUNDATION
THK. – THICK
GA. – GENERAL ARRNGEMENT
DWG. – DRAWING

## NOTES:-

1. ALL DIMENSIONS ARE IN MILLIMETRES AND LEVELS AND CO-ORDINATES ARE IN METRES UNLESS OTHERWISE STATED.
2. NET SAFE BEARING CAPACITY OF SOIL AT BOTTOM OF FOUNDATION CONSIDER 200KN/ SQ. M
3. GRADE OF CONCRETE SHALL BE C35 (35MPa) FOR FOUNDATION & C15 (15MPa) FOR BLINDING CONCRETE.
4. GRADE OF REINFORCEMENT SHALL BE DEFORMED BAR 420 MPa (GRADE 60) – ASTM A615/A615M.
5. IF ANY PART OF FOUNDATION COMES ON BACKFILL ZONE OF ADJACENT FOUNDATION OR ANY LOOSE SOIL ARE ENCOUNTERED BELOW FOUNDATION LEVEL THE SAME SHALL BE REMOVED AND FILLED WITH PCC (C15).
6. CLEAR COVER TO REINFORCEMENT SHALL BE a. FOUNDATIONS = 50 MM., b. COLUMNS = 50 MM.
7. FOR STANDARD REINFORCEMENT DETAIL & GENERAL NOTES FOR CIVIL WORKS REFER DRAWING NO. MD-216-1000-EG-CV-DED-1005 & 1001.
8. THIS DRAWING SHOULD BE READ IN CONJUNCTION WITH DRAWING NO. MD-216-39WL-EG-CV-GAD-1708, MD-216-39WL-EG-CV-GAD-1707, 1709 ,1710, 1716, 1717 &, 1551

SHEET 1 OF 3

| DOCUMENT NUMBER | REFERENCE DOCUMENTS | REV | DATE | REVISION DESCRIPTION | DRN | CHK | ENG | APP | EMP |
|---|---|---|---|---|---|---|---|---|---|
| | | D01 | 26/05/2023 | AS-BUILT | SYA | SJM | AVG | AG | |
| MD-216-39WL-EG-CV-GAD-1708 | DETAIL OF FOUNDATION | C04 | 31/05/2021 | ISSUED FOR CONSTRUCTION AND REVISED AS MKD. C04 | SYA | SJM | AVG | AG | |
| MD-216-39WL-EG-CV-GAD-1708 | LAYOUT & DETAIL OF FOUNDATION | C03 | 15/03/2021 | ISSUED FOR CONSTRUCTION AND REVISED AS MKD. C03 | ABS | SJM | AVG | AG | |
| MD-216-1000-EG-ST-CRT-1001 | CIVIL, STRUCTURAL & ARCHITECTURAL-DESIGN CRITERIA | C02 | 17/02/2021 | ISSUED FOR CONSTRUCTION AND REVISED AS MKD. C02 | ABS | SJM | AVG | AG | |
| MD-216-3310-EG-ME-GAD-1055 | PLAN AT EL. +913.000 | C01 | 27/11/2020 | ISSUED FOR CONSTRUCTION | SC | TG | AVG | AG | |
| MD-216-3310-EG-CV-GAD-1177 | LAYOUT & DETAIL OF GRADE SLAB | A01 | 12/10/2020 | ISSUED FOR REFERENCE | SC | TG | AVG | AG | |

RESERVED FOR VENDOR LOGO AND DRAWING NUMBER

LARSEN & TOUBRO DRAWING NUMBER: 019045_080_C_G_24436_001 — REVISION: 5

OUTOTEC DRAWING NUMBER: 900707 _GAU01 _AG11 _MTL01 _39232 — DOCUMENT ID: OU100704408 — REVISION: 5


LARSEN & TOUBRO
This drawing is the property of LARSEN & TOUBRO and must not be passed on to any person or body not authorized by us to receive it nor be copied or otherwise made use either in full or in part by such person or body without our prior permission in writing.

Outotec
The content of these documents are the sole property of Outotec Oyj. Any rights not expressly granted herein are reserved. Reproduction, transfer or distribution of part or all of the contents in any form without prior written permission of Outotec is prohibited.

MA'ADEN معادن Saudi Arabian Mining Company شركة معادن العربية السعودية
This document and the information contained herein is Ma'aden proprietary know-how. This document or any part thereof should not be reproduced, stored in a retrieval system or transmitted by any means, electronic or otherwise, or divulged without prior written permission of Ma'aden.

| | | | |
|---|---|---|---|
| DRAWN | SC | 12/10/2020 | MANSOURAH - MASSARAH GOLD PROJECT |
| CHECKED | TG | 12/10/2020 | GENERAL ARRANGEMENT DRAWING |
| ENGINEER | AVG | 13/10/2020 | RAW WATER |
| APPROVED | AG | 13/10/2020 | G.A & DETAILS OF FOUNDATION |
| EMPLOYER | | | |
| SCALE 1:20, 1:50, 1:150 | | A1 | DRAWING NUMBER: MD-216-39WL-EG-CV-GAD-1706 — REV: D01 |

DRAWING NUMBER
MD-216-39WL-EG-CV-GAD-1706
REV
D01

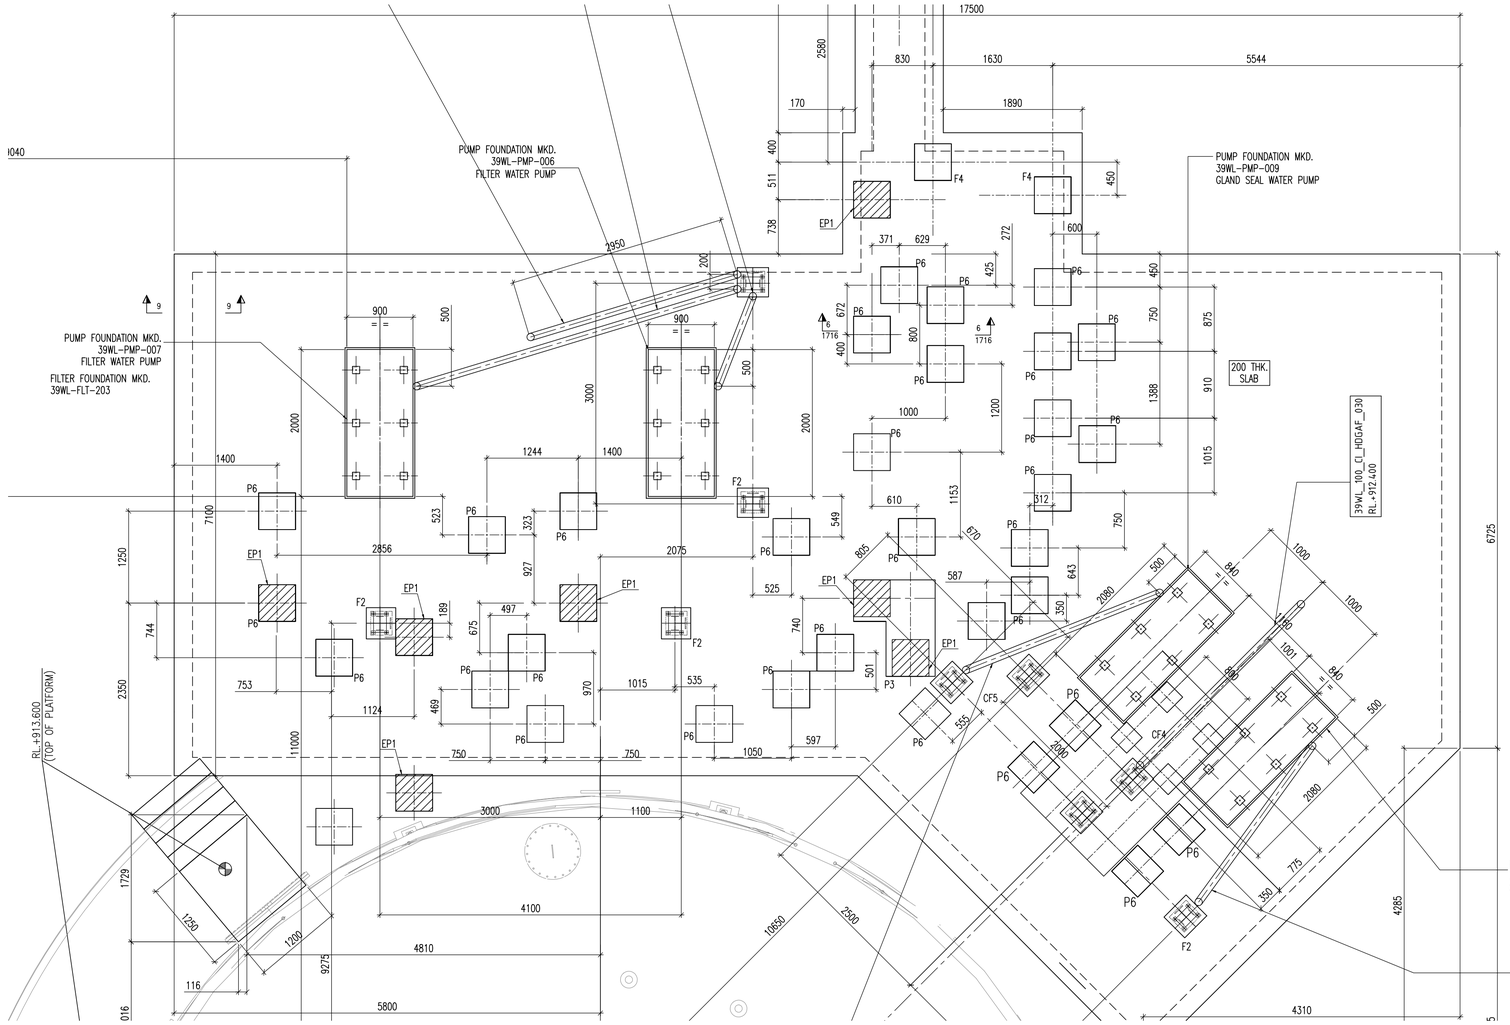


DETAIL- 'A'

## LEGEND :-

R.L. – REDUCED LEVEL
℄ – CENTRE LINE
T.O.C. – TOP OF CONCRETE
TYP. – TYPICAL
F.G.L. – FINISHED GROUND LEVEL
F.F.L. – FINISHED FLOOR LEVEL
B.O.F. – BOTTOM OF FOUNDATION
MKD. – MARKED
P.C.C – PLAIN CEMENT CONCRETE
DET. – DETAIL
SQ. – SQUARE
R.C. – REINFORCED CONCRETE
FDN. – FOUNDATION
THK. – THICK
GA. – GENERAL ARRNGEMENT
DWG. – DRAWING

## NOTES:-

1. ALL DIMENSIONS ARE IN MILLIMETRES AND LEVELS AND CO-ORDINATES ARE IN METRES UNLESS OTHERWISE STATED.
2. NET SAFE BEARING CAPACITY OF SOIL AT BOTTOM OF FOUNDATION CONSIDER 200KN/ SQ. M
3. GRADE OF CONCRETE SHALL BE C35 (35MPa) FOR FOUNDATION & C15 (15MPa) FOR BLINDING CONCRETE.
4. GRADE OF REINFORCEMENT SHALL BE DEFORMED BAR 420 MPa (GRADE 60) – ASTM A615/A615M.
5. IF ANY PART OF FOUNDATION COMES ON BACKFILL ZONE OF ADJACENT FOUNDATION OR ANY LOOSE SOIL ARE ENCOUNTERED BELOW FOUNDATION LEVEL THE SAME SHALL BE REMOVED AND FILLED WITH PCC (C15).
6. CLEAR COVER TO REINFORCEMENT SHALL BE a. FOUNDATIONS = 50 MM., b. COLUMNS = 50 MM.
7. FOR STANDARD REINFORCEMENT DETAIL & GENERAL NOTES FOR CIVIL WORKS REFER DRAWING NO. MD-216-1000-EG-CV-DED-1005 & 1001.
8. THIS DRAWING SHOULD BE READ IN CONJUNCTION WITH DRAWING NO. MD-216-39WL-EG-CV-GAD-1708, MD-216-39WL-EG-CV-GAD-1707, 1709 ,1710, 1716, 1717 &, 1551

SHEET 2 OF 3

| DOCUMENT NUMBER | REFERENCE DOCUMENTS | REV | DATE | REVISION DESCRIPTION | DRN | CHK | ENG | APP | EMP |
|---|---|---|---|---|---|---|---|---|---|
| | | D01 | 26/06/2023 | AS-BUILT | SYA | SJM | AVG | AG | |
| MD-216-39WL-EG-CV-GAD-1708 | DETAIL OF FOUNDATION | C04 | 31/05/2021 | ISSUED FOR CONSTRUCTION AND REVISED AS MKD. △C04 | SYA | SJM | AVG | AG | |
| MD-216-39WL-EG-CV-GAD-1708 | LAYOUT & DETAIL OF FOUNDATION | C03 | 15/03/2021 | ISSUED FOR CONSTRUCTION AND REVISED AS MKD. △C03 | ABS | SJM | AVG | AG | |
| MD-216-1000-EG-ST-CRT-1001 | CIVIL, STRUCTURAL & ARCHITECTURAL-DESIGN CRITERIA | C02 | 17/02/2021 | ISSUED FOR CONSTRUCTION AND REVISED AS MKD. △C02 | ABS | SJM | AVG | AG | |
| MD-216-3310-EG-ME-GAD-1055 | PLAN AT EL. +913.000 | C01 | 27/11/2020 | ISSUED FOR CONSTRUCTION | SC | TG | AVG | AG | |
| MD-216-3310-EG-CV-GAD-1177 | LAYOUT & DETAIL OF GRADE SLAB | A01 | 12/10/2020 | ISSUED FOR REFERENCE | SC | TG | AVG | AG | |

RESERVED FOR VENDOR LOGO AND DRAWING NUMBER

LARSEN & TOUBRO

This drawing is the property of LARSEN & TOUBRO and must not be passed on to any person or body not authorized by us to receive it nor be copied or otherwise made use either in full or in part by such person or body without our prior permission in writing.

Outotec

The content of these documents are the sole property of Outotec Oyj. Any rights not expressly granted herein are reserved. Reproduction, transfer or distribution of part or all of the contents in any form without prior written permission of Outotec is prohibited.

MA'ADEN معادن
Saudi Arabian Mining Company شركة المعادن العربية السعودية

This document and the information contained herein is Ma'aden proprietary know-how. This document or any part thereof should not be reproduced, stored in a retrieval system or transmitted by any means, electronic or otherwise, or divulged without prior written permission of Ma'aden.


LARSEN & TOUBRO DRAWING NUMBER: O19045_080_C_G_24436_001 — REVISION: 5
OUTOTEC DRAWING NUMBER: 900707__GAU01__AG11__MTL01__39232 — DOCUMENT ID: OU100704408 — REVISION: 5

| | | |
|---|---|---|
| DRAWN | SC | 12/10/2020 |
| CHECKED | TG | 12/10/2020 |
| ENGINEER | AVG | 13/10/2020 |
| APPROVED | AG | 13/10/2020 |
| EMPLOYER | | |
| SCALE | 1:20, 1:50, 1:150 | A1 |


MANSOURAH - MASSARAH GOLD PROJECT
GENERAL ARRANGEMENT DRAWING
RAW WATER
G.A & DETAILS OF FOUNDATION

DRAWING NUMBER: MD-216-39WL-EG-CV-GAD-1706 — REV: D01

DRAWING NUMBER MD-216-39WL-EG-CV-GAD-1706 REV D01

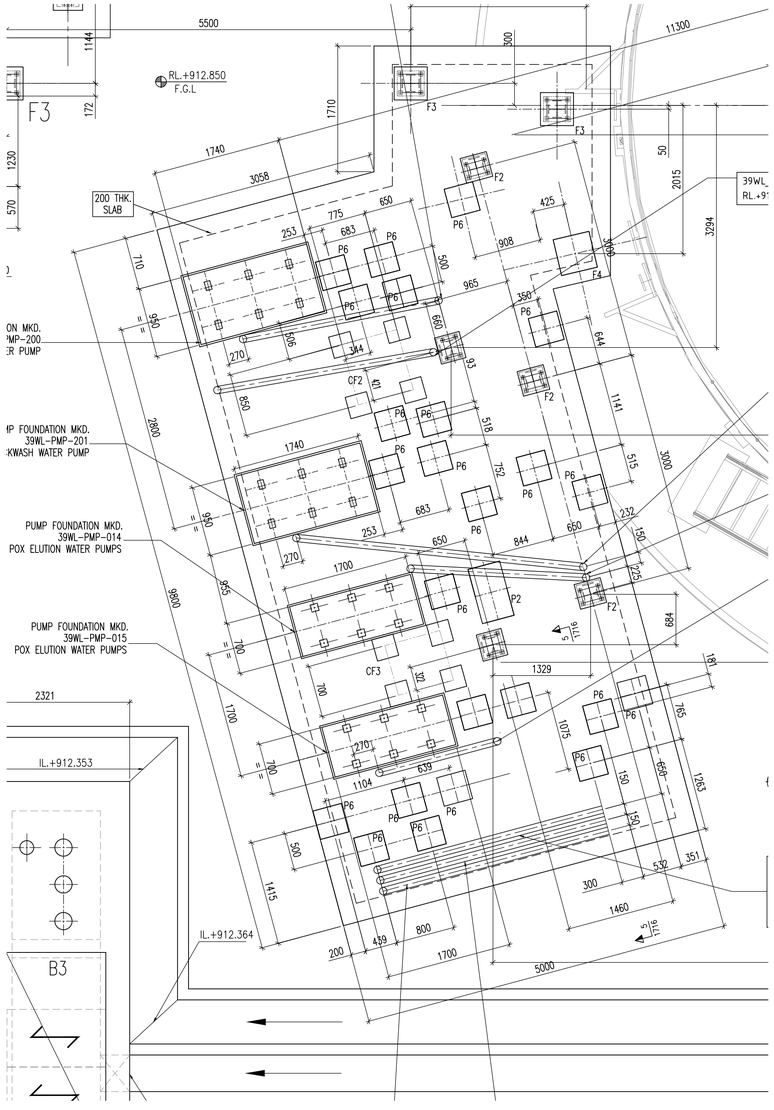


DETAIL- 'B'

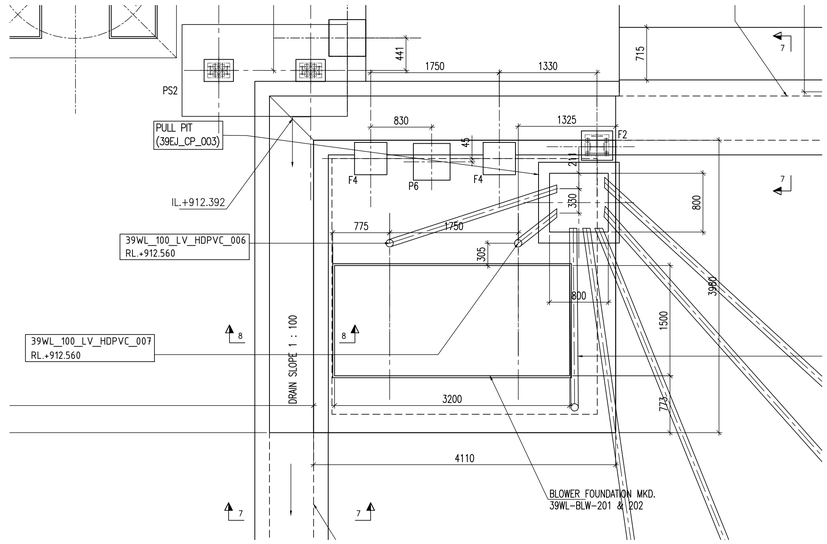


DETAIL- 'C'

## LEGEND :-

R.L. – REDUCED LEVEL
℄ – CENTRE LINE
T.O.C. – TOP OF CONCRETE
TYP. – TYPICAL
F.G.L. – FINISHED GROUND LEVEL
F.F.L. – FINISHED FLOOR LEVEL
B.O.F. – BOTTOM OF FOUNDATION
MKD. – MARKED
P.C.C – PLAIN CEMENT CONCRETE
DET. – DETAIL
SQ. – SQUARE
R.C. – REINFORCED CONCRETE
FDN. – FOUNDATION
THK. – THICK
GA. – GENERAL ARRNGEMENT
DWG. – DRAWING

## NOTES:-

1. ALL DIMENSIONS ARE IN MILLIMETRES AND LEVELS AND CO-ORDINATES ARE IN METRES UNLESS OTHERWISE STATED.
2. NET SAFE BEARING CAPACITY OF SOIL AT BOTTOM OF FOUNDATION CONSIDER 200KN/ SQ. M
3. GRADE OF CONCRETE SHALL BE C35 (35MPa) FOR FOUNDATION & C15 (15MPa) FOR BLINDING CONCRETE.
4. GRADE OF REINFORCEMENT SHALL BE DEFORMED BAR 420 MPa (GRADE 60) – ASTM A615/A615M.
5. IF ANY PART OF FOUNDATION COMES ON BACKFILL ZONE OF ADJACENT FOUNDATION OR ANY LOOSE SOIL ARE ENCOUNTERED BELOW FOUNDATION LEVEL THE SAME SHALL BE REMOVED AND FILLED WITH PCC (C15).
6. CLEAR COVER TO REINFORCEMENT SHALL BE a. FOUNDATIONS = 50 MM., b. COLUMNS = 50 MM.
7. FOR STANDARD REINFORCEMENT DETAIL & GENERAL NOTES FOR CIVIL WORKS REFER DRAWING NO. MD-216-1000-EG-CV-DED-1005 & 1001.
8. THIS DRAWING SHOULD BE READ IN CONJUNCTION WITH DRAWING NO. MD-216-39WL-EG-CV-GAD-1708, MD-216-39WL-EG-CV-GAD-1707, 1709 ,1710, 1716, 1717 &, 1551

SHEET 3 OF 3

| DOCUMENT NUMBER | REFERENCE DOCUMENTS | REV | DATE | REVISION DESCRIPTION | DRN | CHK | ENG | APP | EMP |
|---|---|---|---|---|---|---|---|---|---|
| | | D01 | 26/06/2023 | AS-BUILT | SYA | SJM | AVG | AG | |
| MD-216-39WL-EG-CV-GAD-1708 | DETAIL OF FOUNDATION | C04 | 31/05/2021 | ISSUED FOR CONSTRUCTION AND REVISED AS MKD. △C04 | SYA | SJM | AVG | AG | |
| MD-216-39WL-EG-CV-GAD-1708 | LAYOUT & DETAIL OF FOUNDATION | C03 | 15/03/2021 | ISSUED FOR CONSTRUCTION AND REVISED AS MKD. △C03 | ABS | SJM | AVG | AG | |
| MD-216-1000-EG-ST-CRT-1001 | CIVIL, STRUCTURAL & ARCHITECTURAL-DESIGN CRITERIA | C02 | 17/02/2021 | ISSUED FOR CONSTRUCTION AND REVISED AS MKD. △C02 | ABS | SJM | AVG | AG | |
| MD-216-3310-EG-ME-GAD-1055 | PLAN AT EL. +913.000 | C01 | 27/11/2020 | ISSUED FOR CONSTRUCTION | SC | TG | AVG | AG | |
| MD-216-3310-EG-CV-GAD-1177 | LAYOUT & DETAIL OF GRADE SLAB | A01 | 12/10/2020 | ISSUED FOR REFERENCE | SC | TG | AVG | AG | |

RESERVED FOR VENDOR LOGO AND DRAWING NUMBER

LARSEN & TOUBRO

This drawing is the property of LARSEN & TOUBRO and must not be passed on to any person or body not authorized by us to receive it nor be copied or otherwise made use either in full or in part by such person or body without our prior permission in writing.

Outotec

The content of these documents are the sole property of Outotec Oyj. Any rights not expressly granted herein are reserved. Reproduction, transfer or distribution of part or all of the contents in any form without prior written permission of Outotec is prohibited.

MA'ADEN معادن
Saudi Arabian Mining Company شركة المعادن العربية السعودية

This document and the information contained herein is Ma'aden proprietary know-how. This document or any part thereof should not be reproduced, stored in a retrieval system or transmitted by any means, electronic or otherwise, or divulged without prior written permission of Ma'aden.

LARSEN & TOUBRO DRAWING NUMBER: O19045_080_C_G_24436_001 — REVISION: 5
OUTOTEC DRAWING NUMBER: 900707 _GAU01 _AG11 _MTL01 _39232 — DOCUMENT ID: OU100704408 — REVISION: 5

| | | |
|---|---|---|
| DRAWN | SC | 12/10/2020 |
| CHECKED | TG | 12/10/2020 |
| ENGINEER | AVG | 13/10/2020 |
| APPROVED | AG | 13/10/2020 |
| EMPLOYER | | |
| SCALE | 1:20, 1:50, 1:150 | A1 |

MANSOURAH - MASSARAH GOLD PROJECT
GENERAL ARRANGEMENT DRAWING
RAW WATER
G.A & DETAILS OF FOUNDATION

DRAWING NUMBER: MD-216-39WL-EG-CV-GAD-1706 — REV: D01